




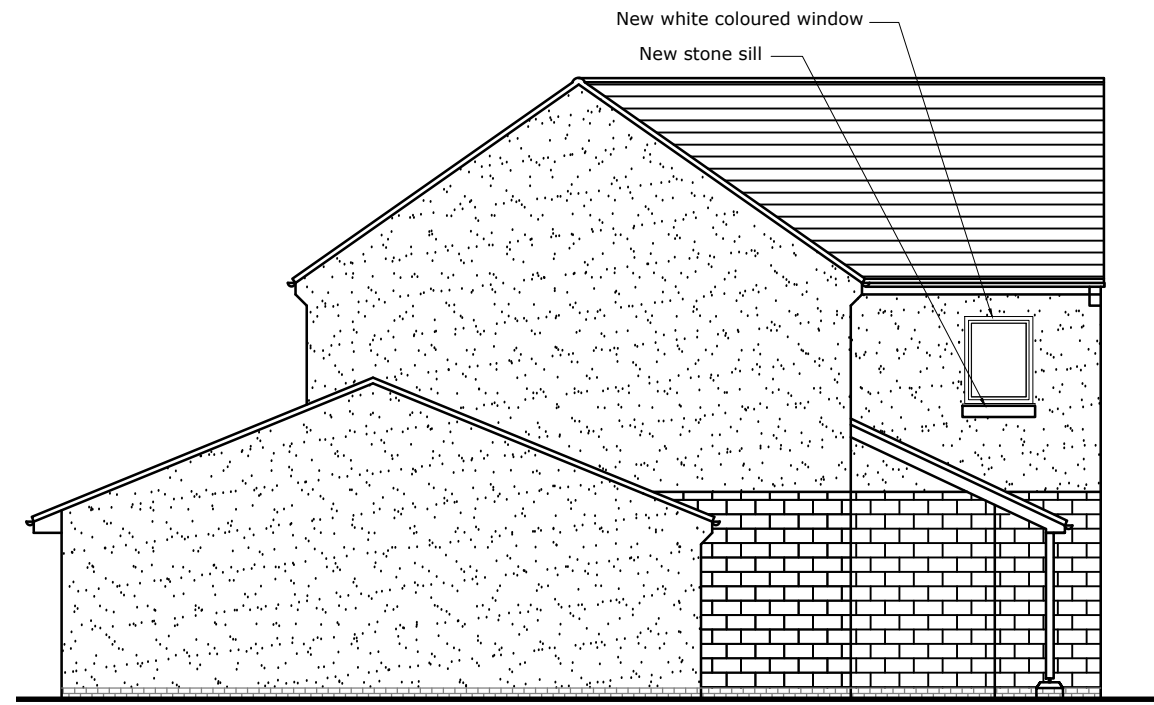

SIDE ELEVATION
SCALE 1:100

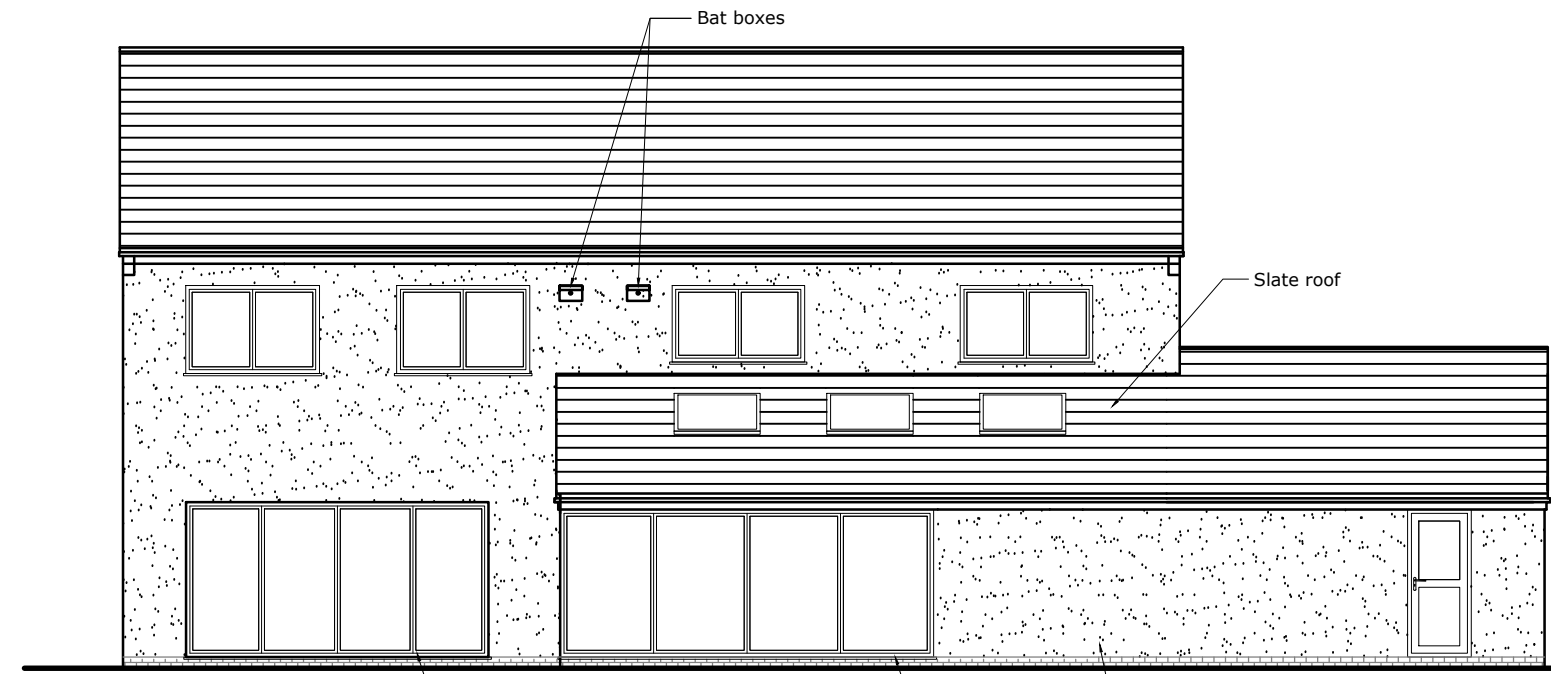

REAR ELEVATION
SCALE 1:100

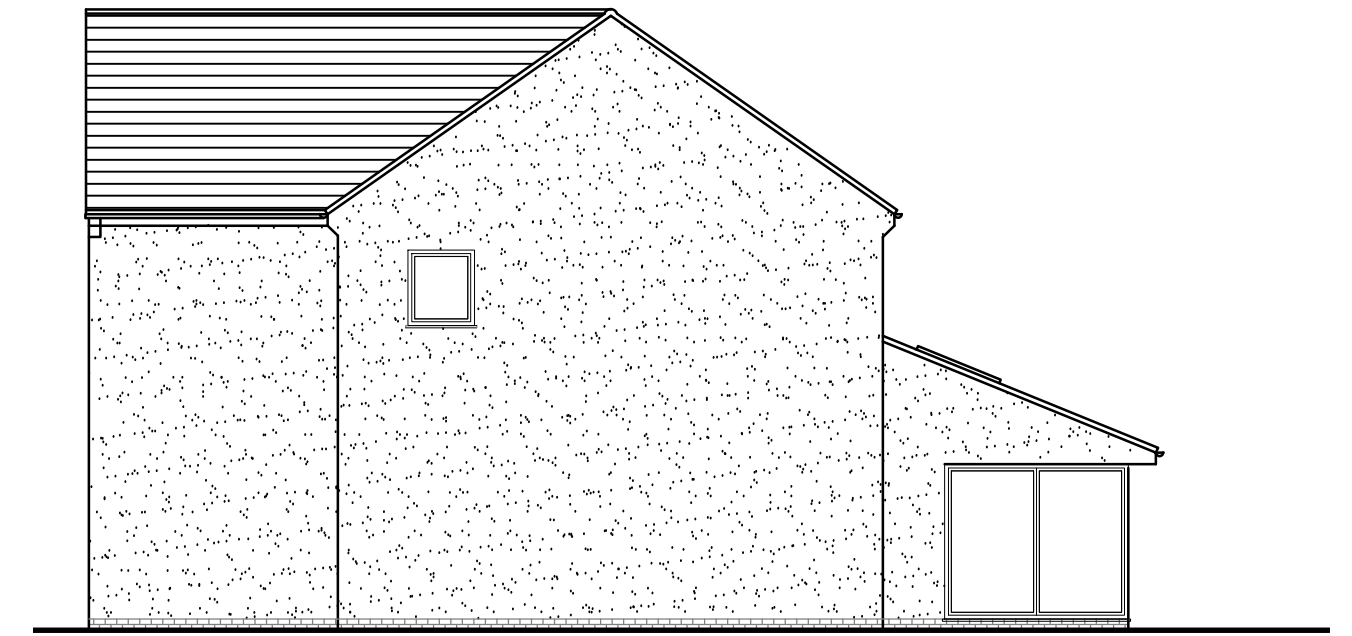


SIDE ELEVATION
SCALE 1:100



FRONT ELEVATION
SCALE 1:100

AS BUILT PLANS

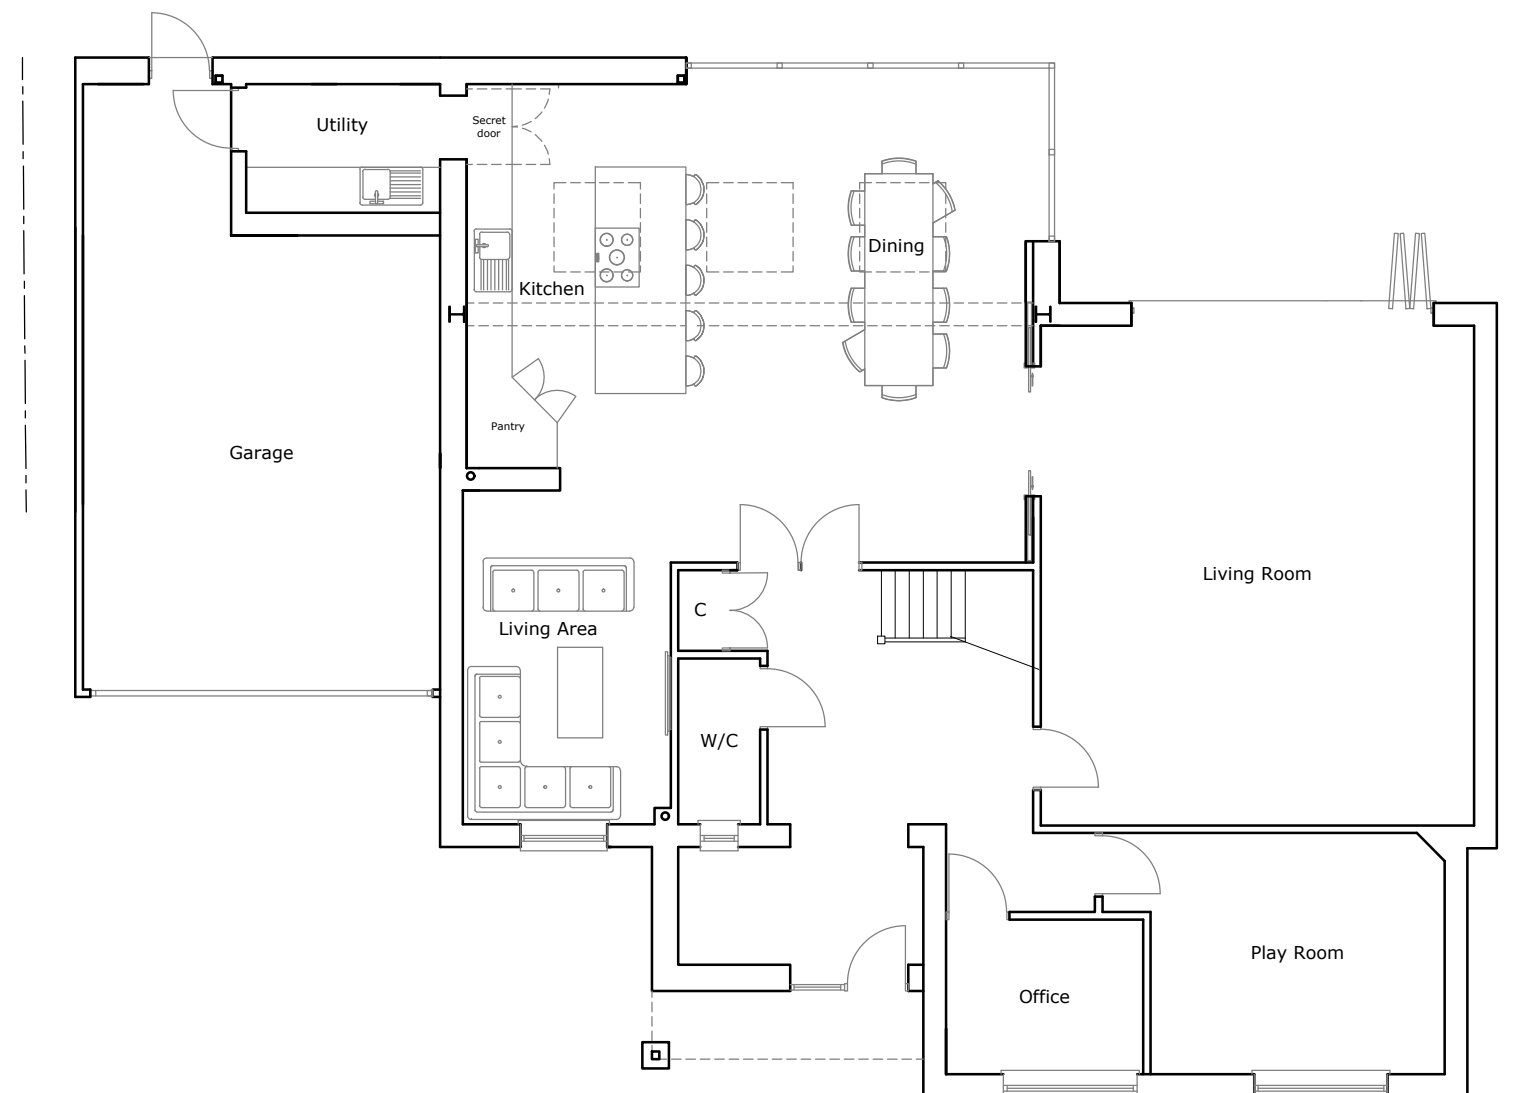

GROUND FLOOR PLAN
SCALE 1:100



FIRST FLOOR PLAN
SCALE 1:100

1 : 100 @ A2

JAKE UNDERWOOD
PLANNING & BUILDING DRAWINGS

PROJECT:
TWIGS, OLD FOREST ROAD,
WOKINGHAM RG41 1JA

DETAIL:
AS BUILT PLANS

PLANNING PERMISSION

JOB No: 2322	DRG No: 020
SCALE @ A2: 1:100	REV: A

CONTACT:
JAKE UNDERWOOD
Web: www.jakeunderwood.com
Email: info@jakeunderwood.com
Phone: 07784927778