



DISCLAIMER:
ALL DIMENSIONS SUBJECT TO
MEASUREMENTS ON SITE.
CONTRACTORS TO INFORM OF
ANY MAJOR DISCREPANCIES.

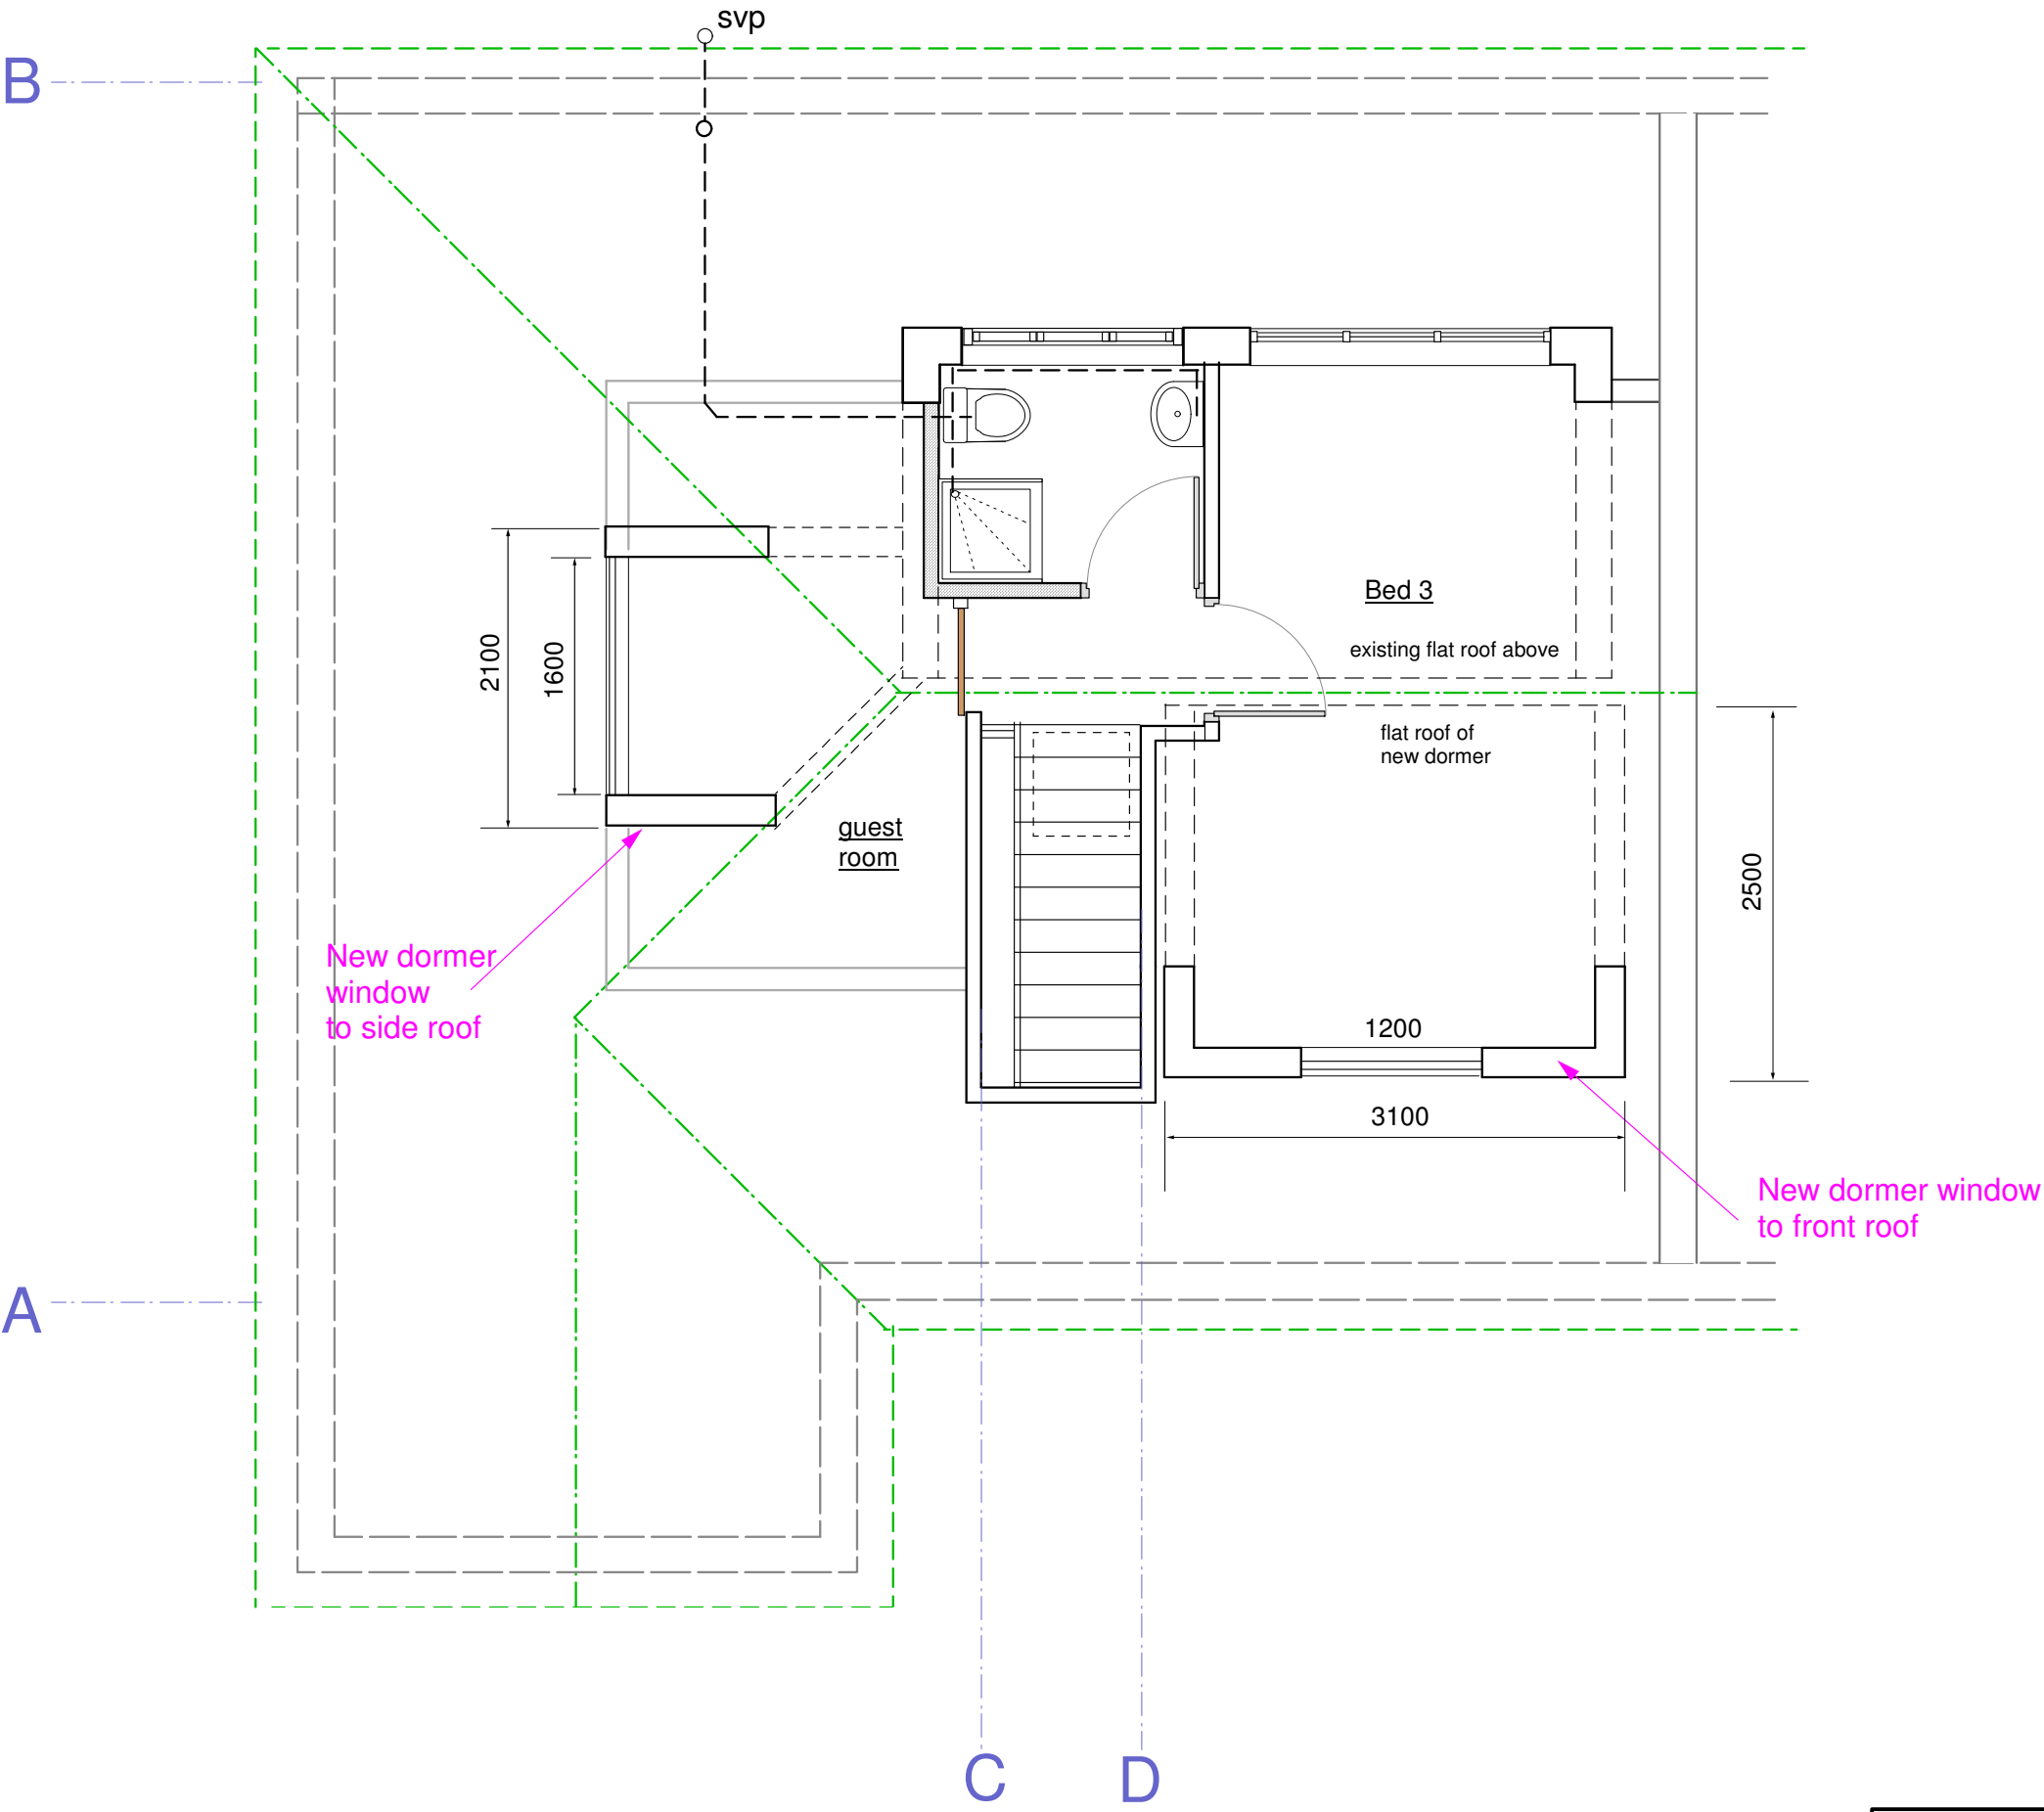

As Built Ground Floor & First Floor Plans

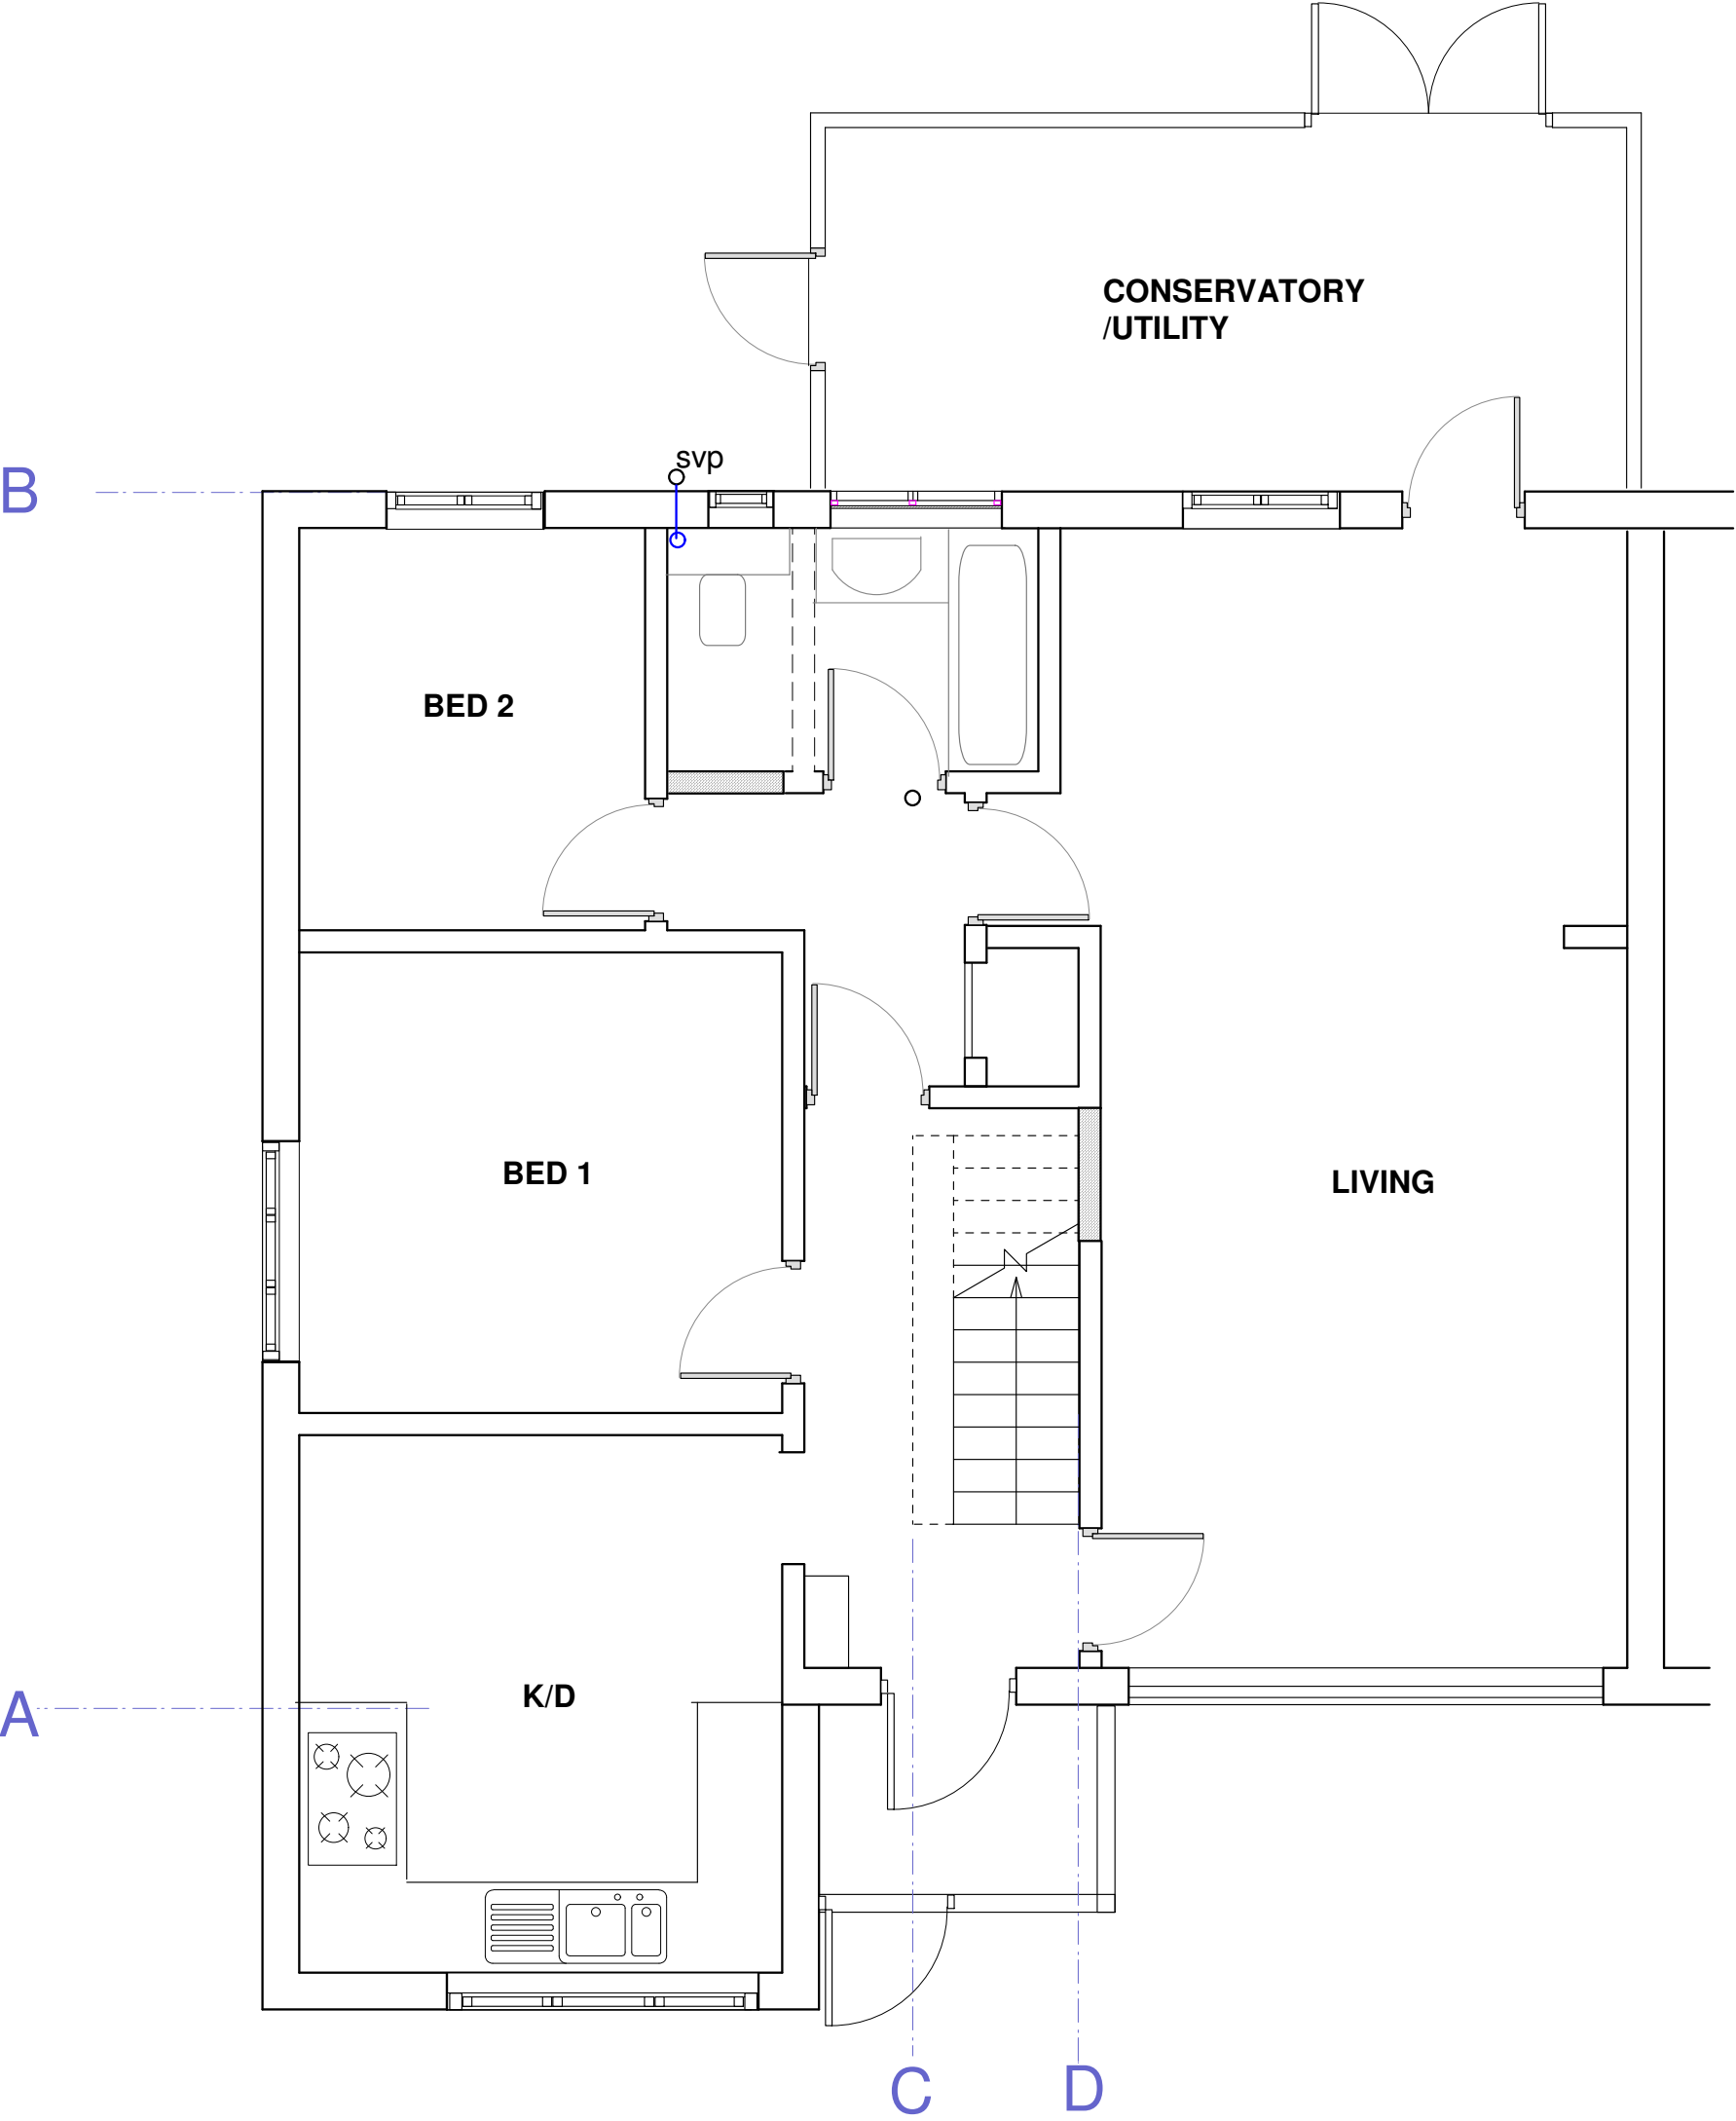

NEW IMAGE DESIGN 2A Tiverton Road London N18 1DW Tel: 02083456883		
Project Site: 36 Malvern Way Reading. RG10 9PX		
Client: Ms L Yang		
Drawing Title: As Built Floor Plans		
Drawing No.: 645(a)/PL/02		
Date: Oct/2024	Scale: 1:50 @ A3	Rev: