



DISCLAIMER:
ALL DIMENSIONS SUBJECT TO
MEASUREMENTS ON SITE.
CONTRACTORS TO INFORM OF
ANY MAJOR DISCREPANCIES.



As Built Roof Plan & Side Elevation

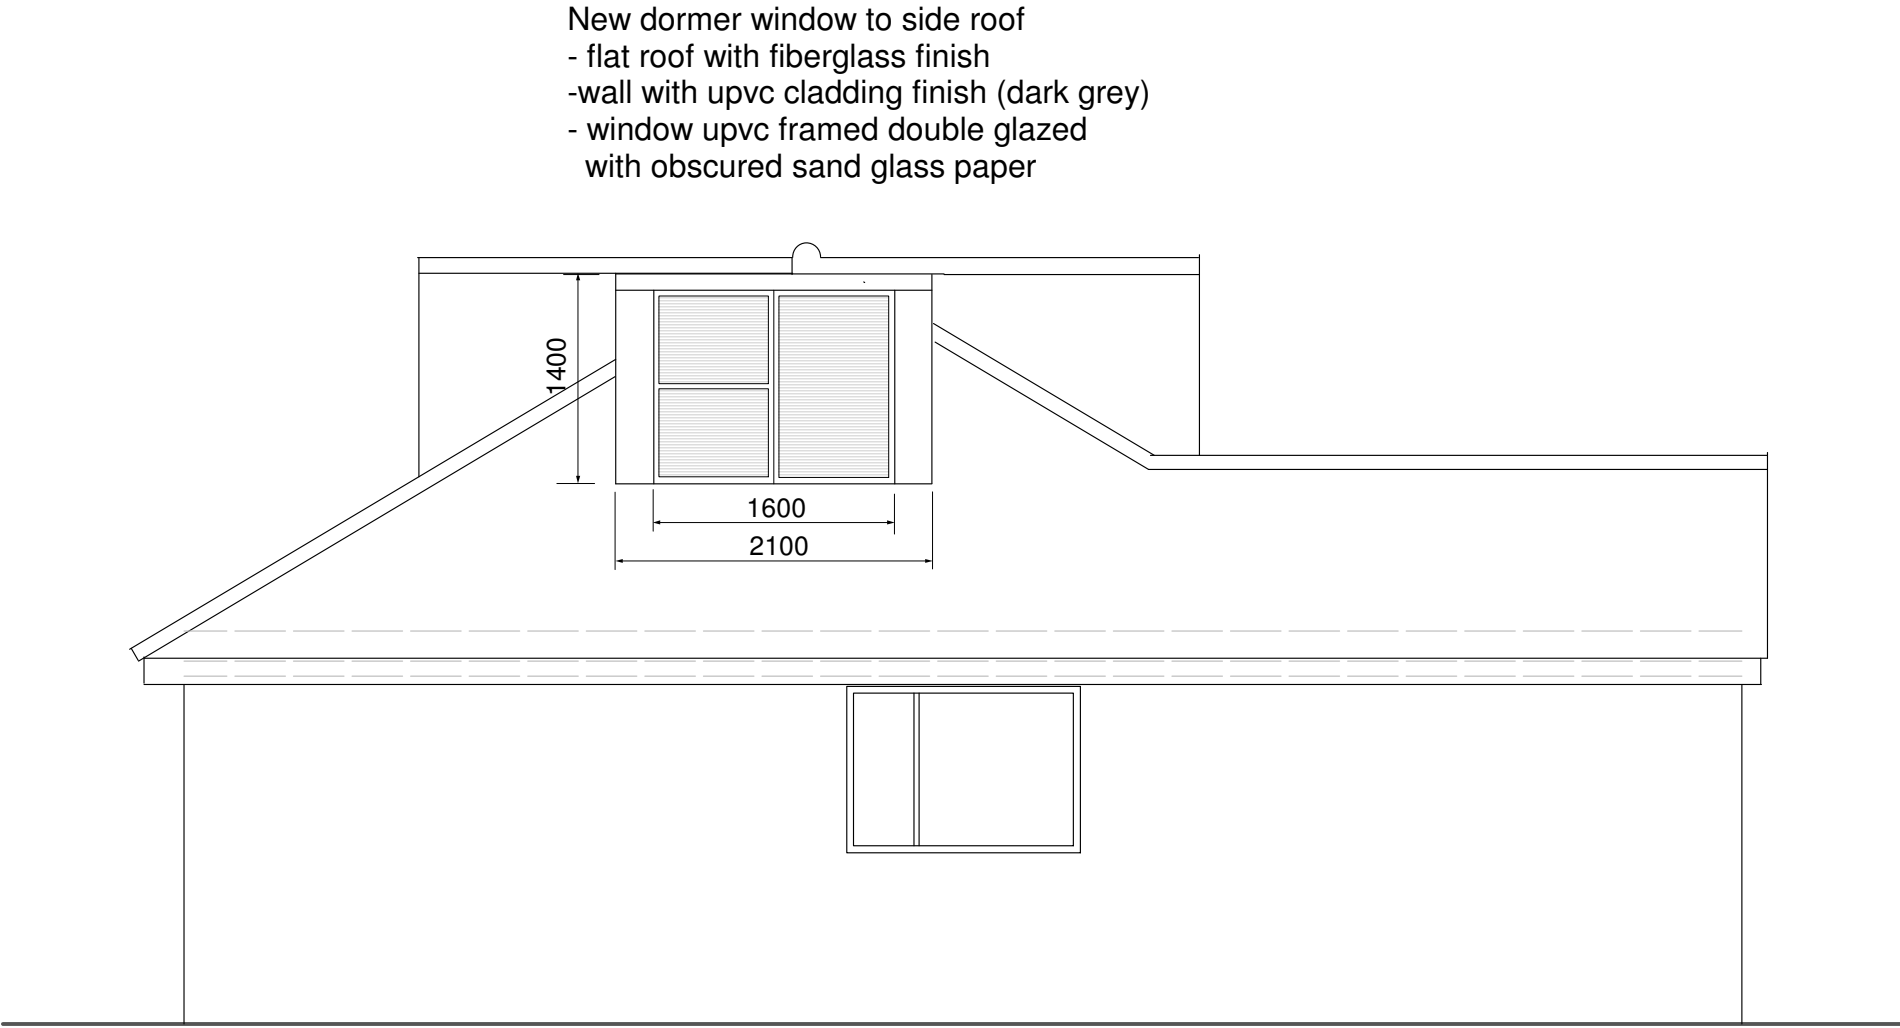

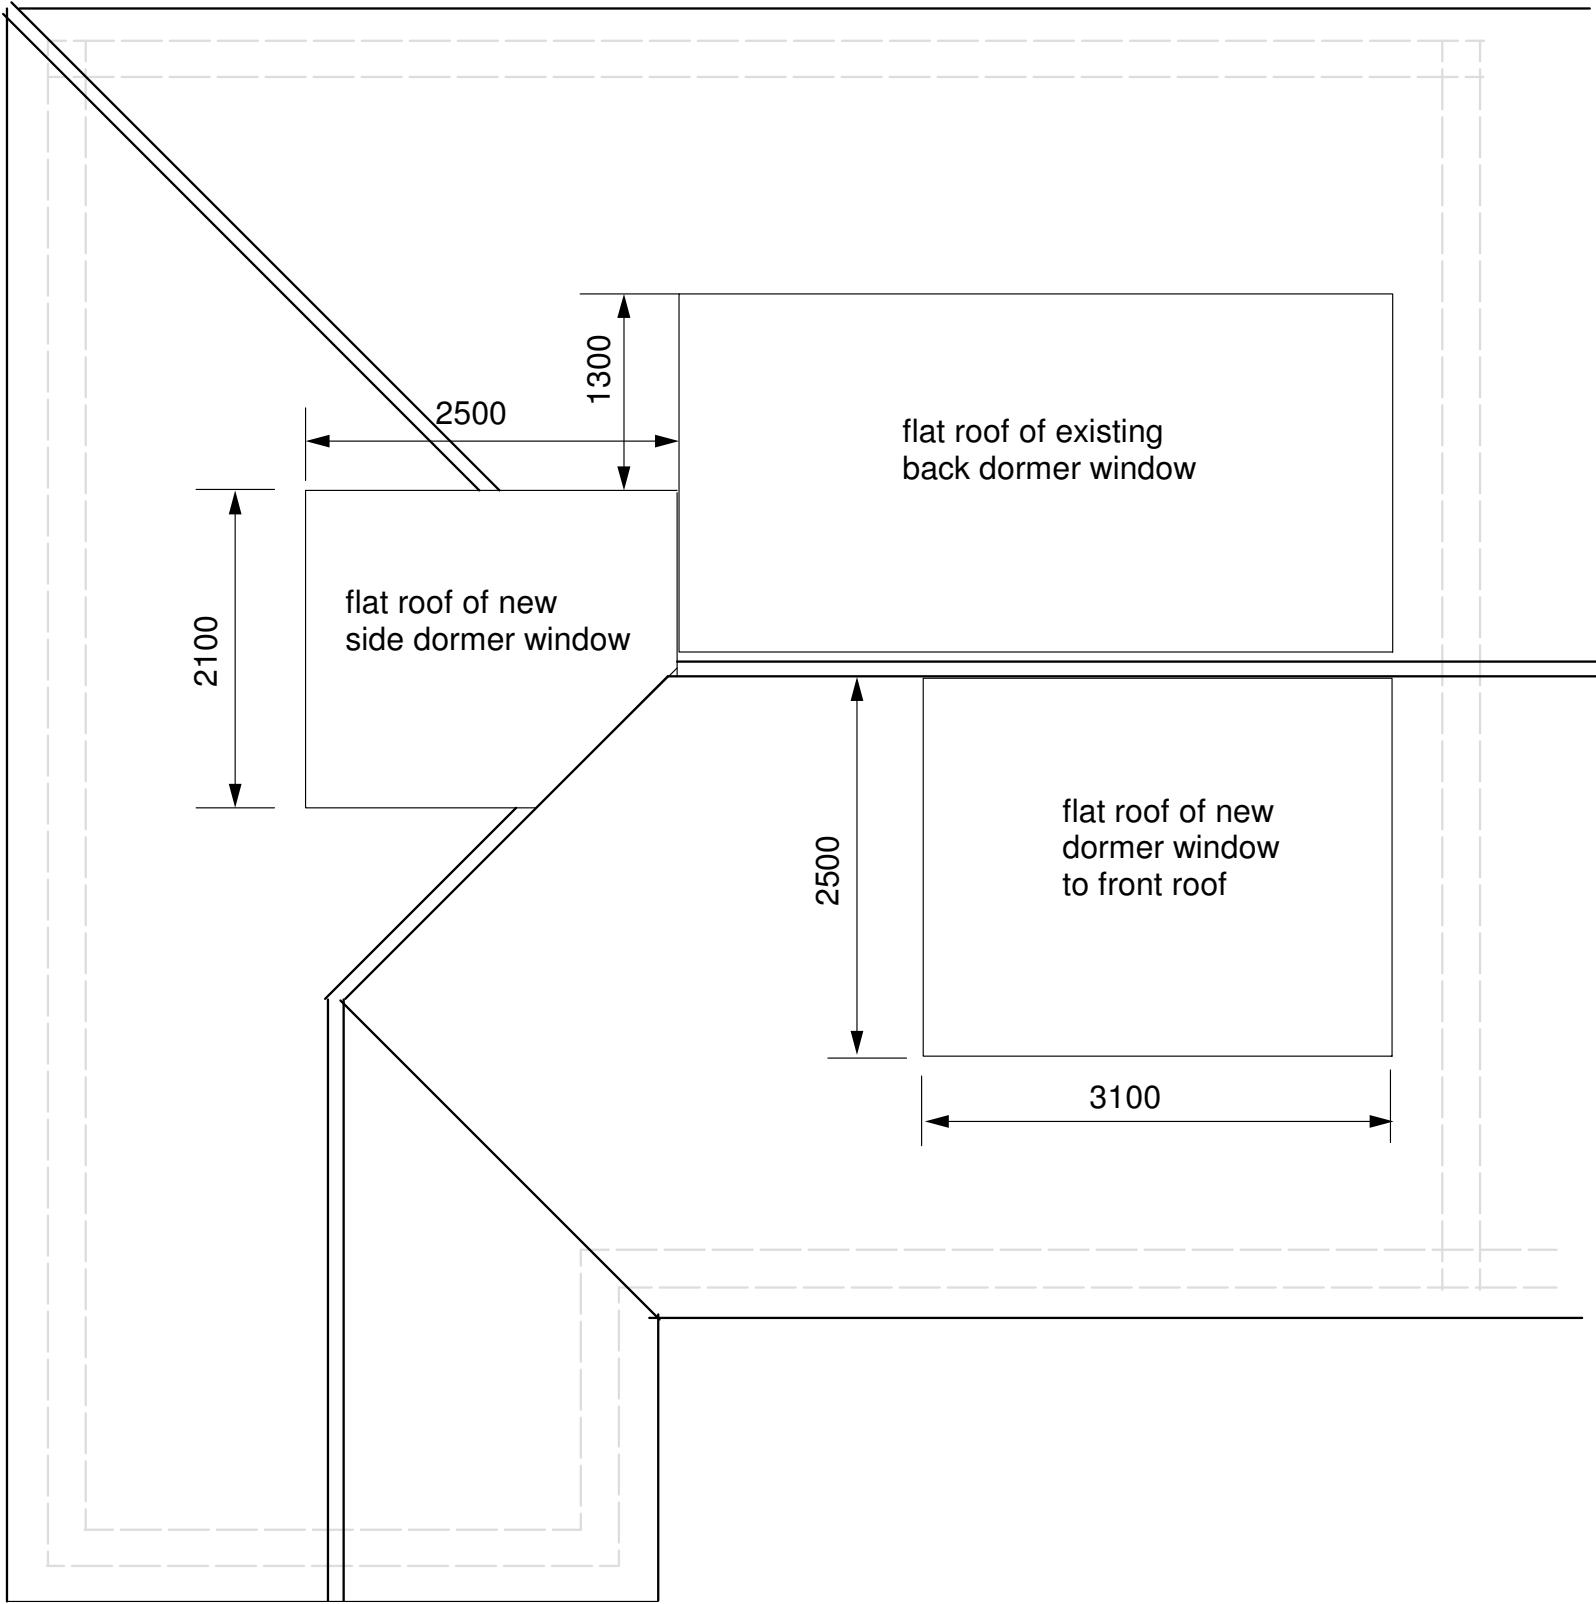

NEW IMAGE DESIGN
2A Tiverton Road
London N18 1DW
Tel: 02083456883

Project Site:
36 Malvern Way
Reading. RG10 9PX

Client:
Ms L Yang

Drawing Title:
As Built Roof Plan
& Side Elevation

Drawing No.:
645(a)/PL/04

Date:
Oct/2024

Scale:
1:50 @ A3

Rev: