


DISCLAIMER:
ALL DIMENSIONS SUBJECT TO
MEASUREMENTS ON SITE.
CONTRACTORS TO INFORM OF
ANY MAJOR DISCREPANCIES.



As Built Back Elevation

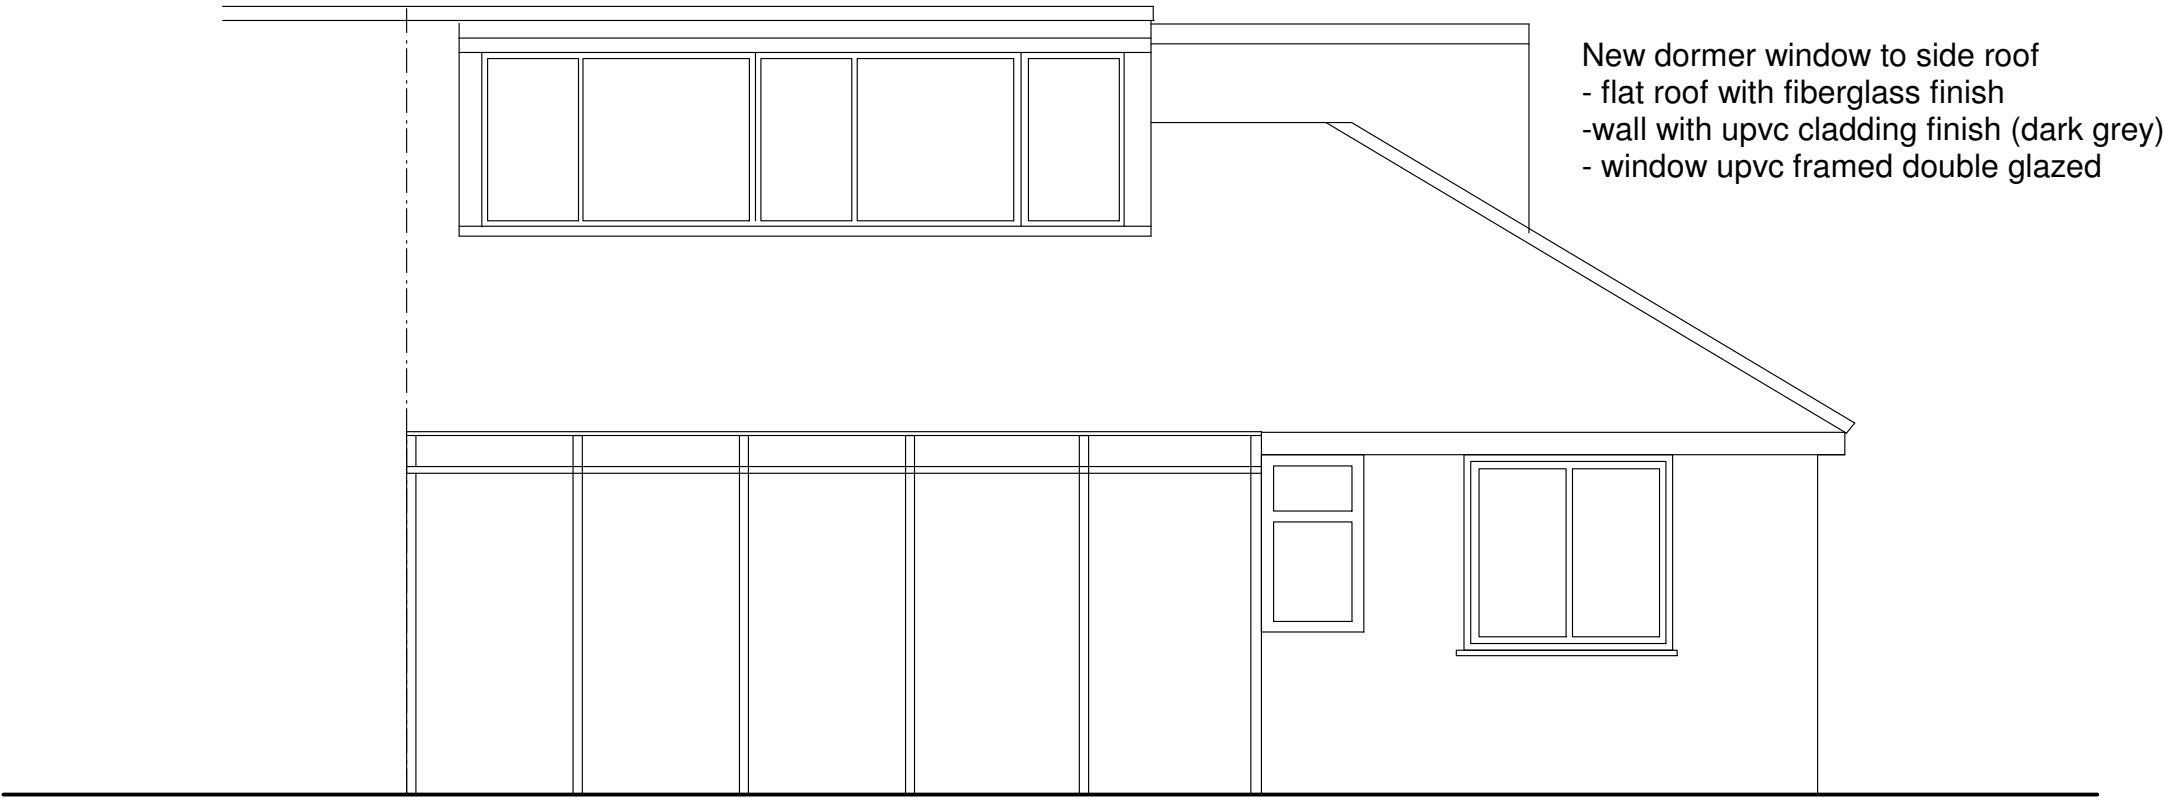

As Built Front Elevation

As Built Roof Plan & Side Elevation



NEW IMAGE DESIGN 2A Tiverton Road London N18 1DW Tel: 02083456883		
Project Site: 36 Malvern Way Reading. RG10 9PX		
Client: Ms L. Yang		
Drawing Title: As Built Front & Back Elevation		
Drawing No.: 645(a)/PL/06		
Date: Oct/2024	Scale: 1:50 @ A3	Rev: