



Notes:


1. THE COPYRIGHT OF THIS DRAWING IS VESTED IN ACN Structures

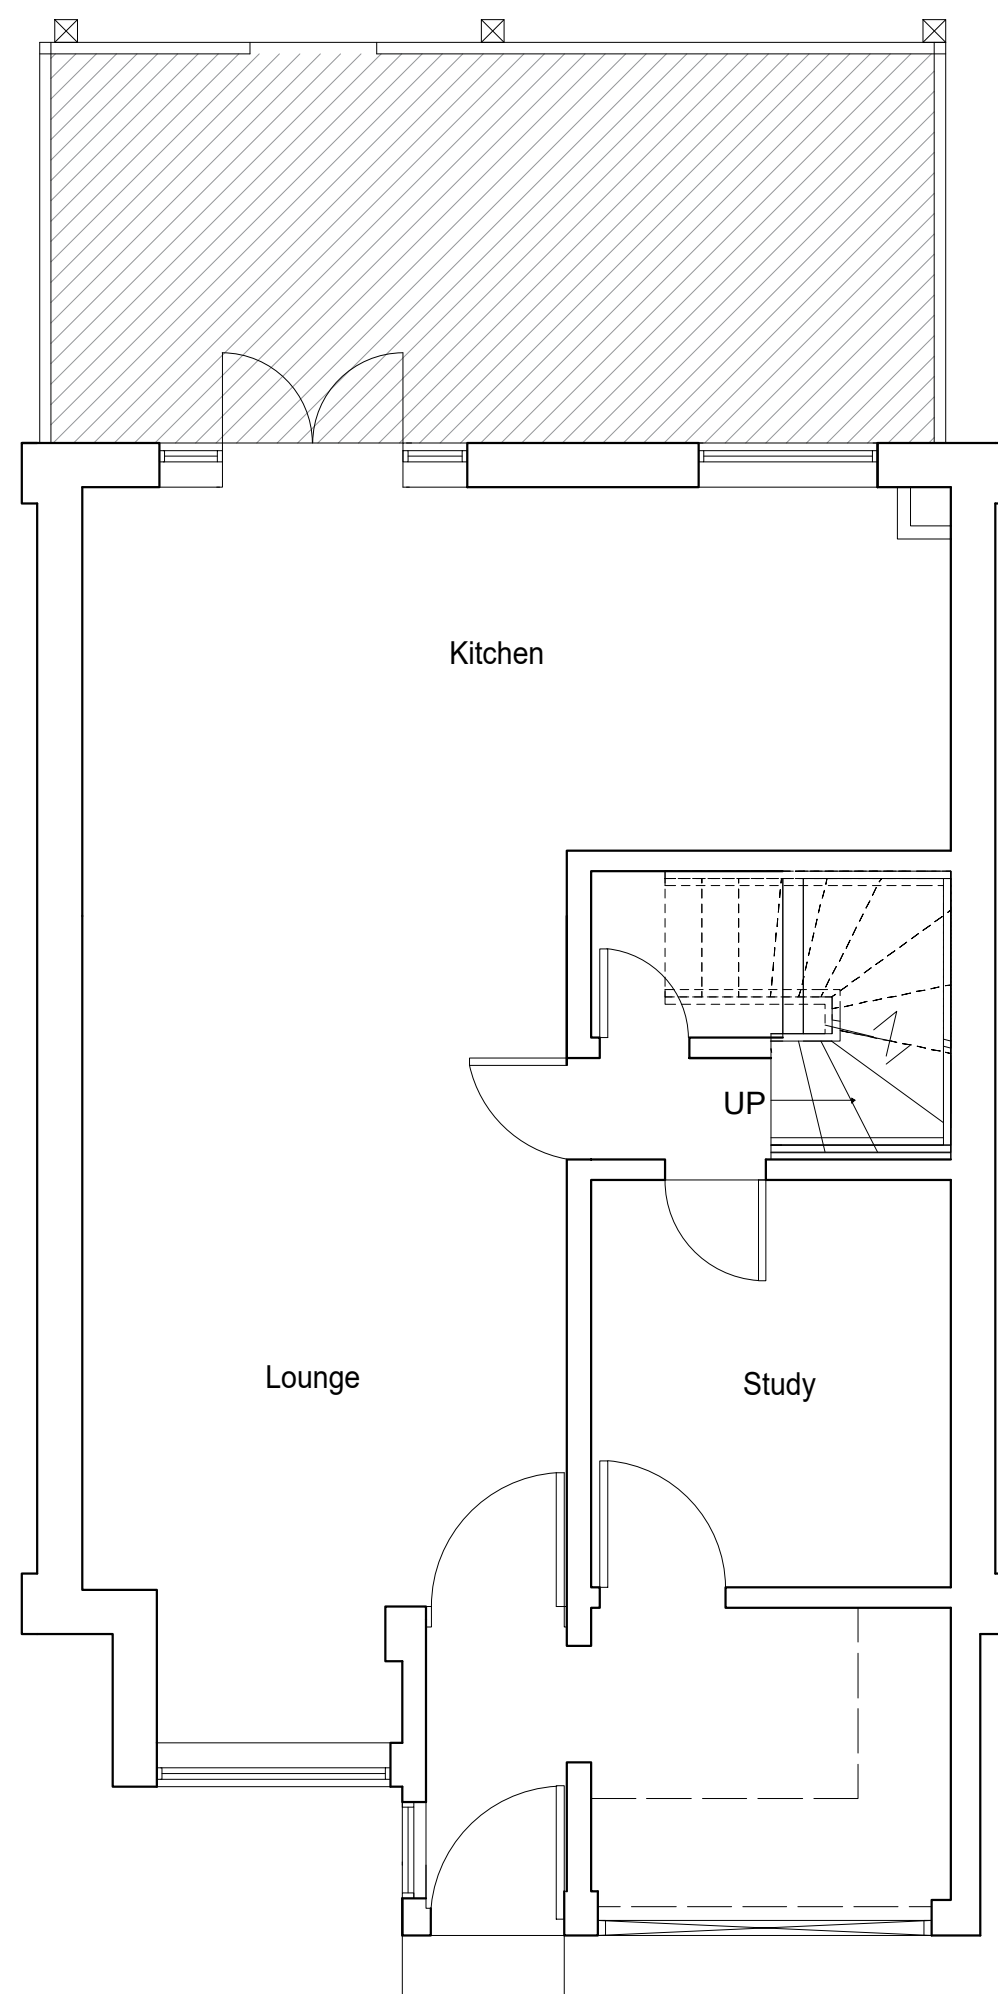


1 Existing Ground Floor Plan-As Built
Scale 1:50

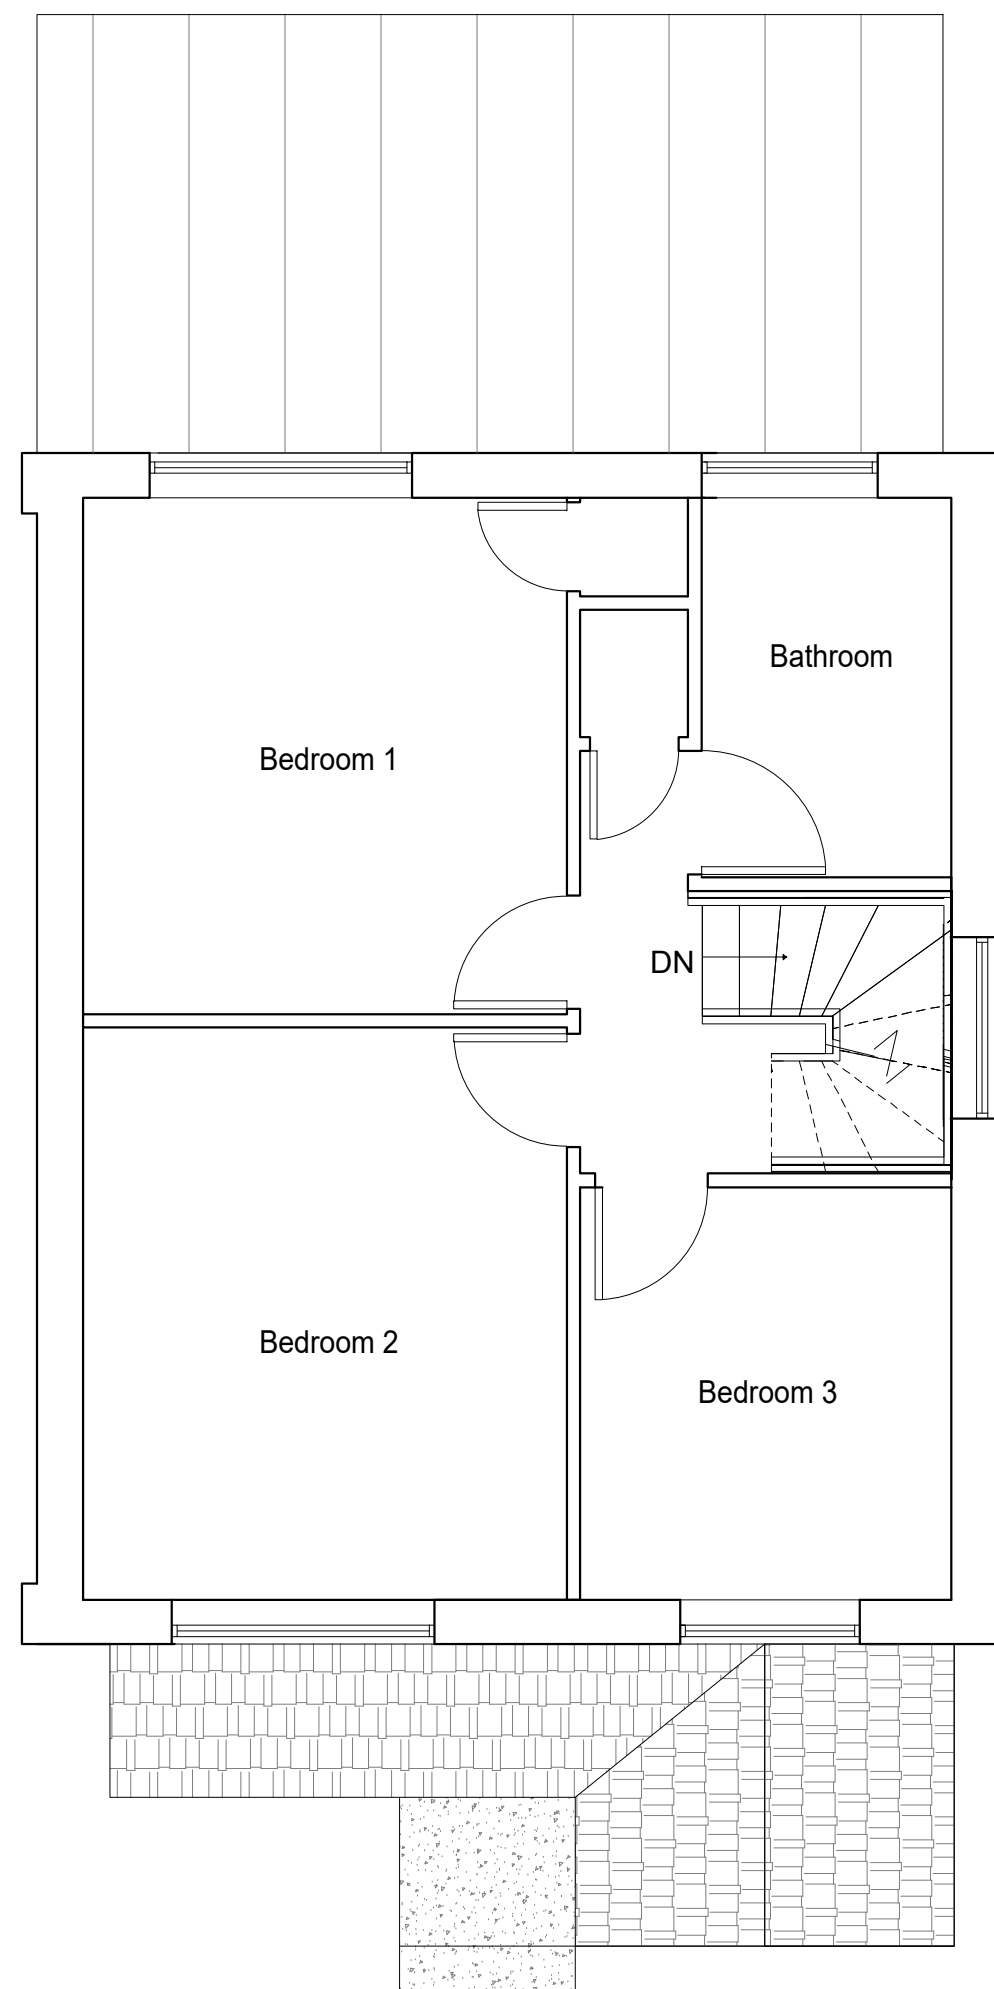

2 Existing First Floor Plan-As Built
Scale 1:50

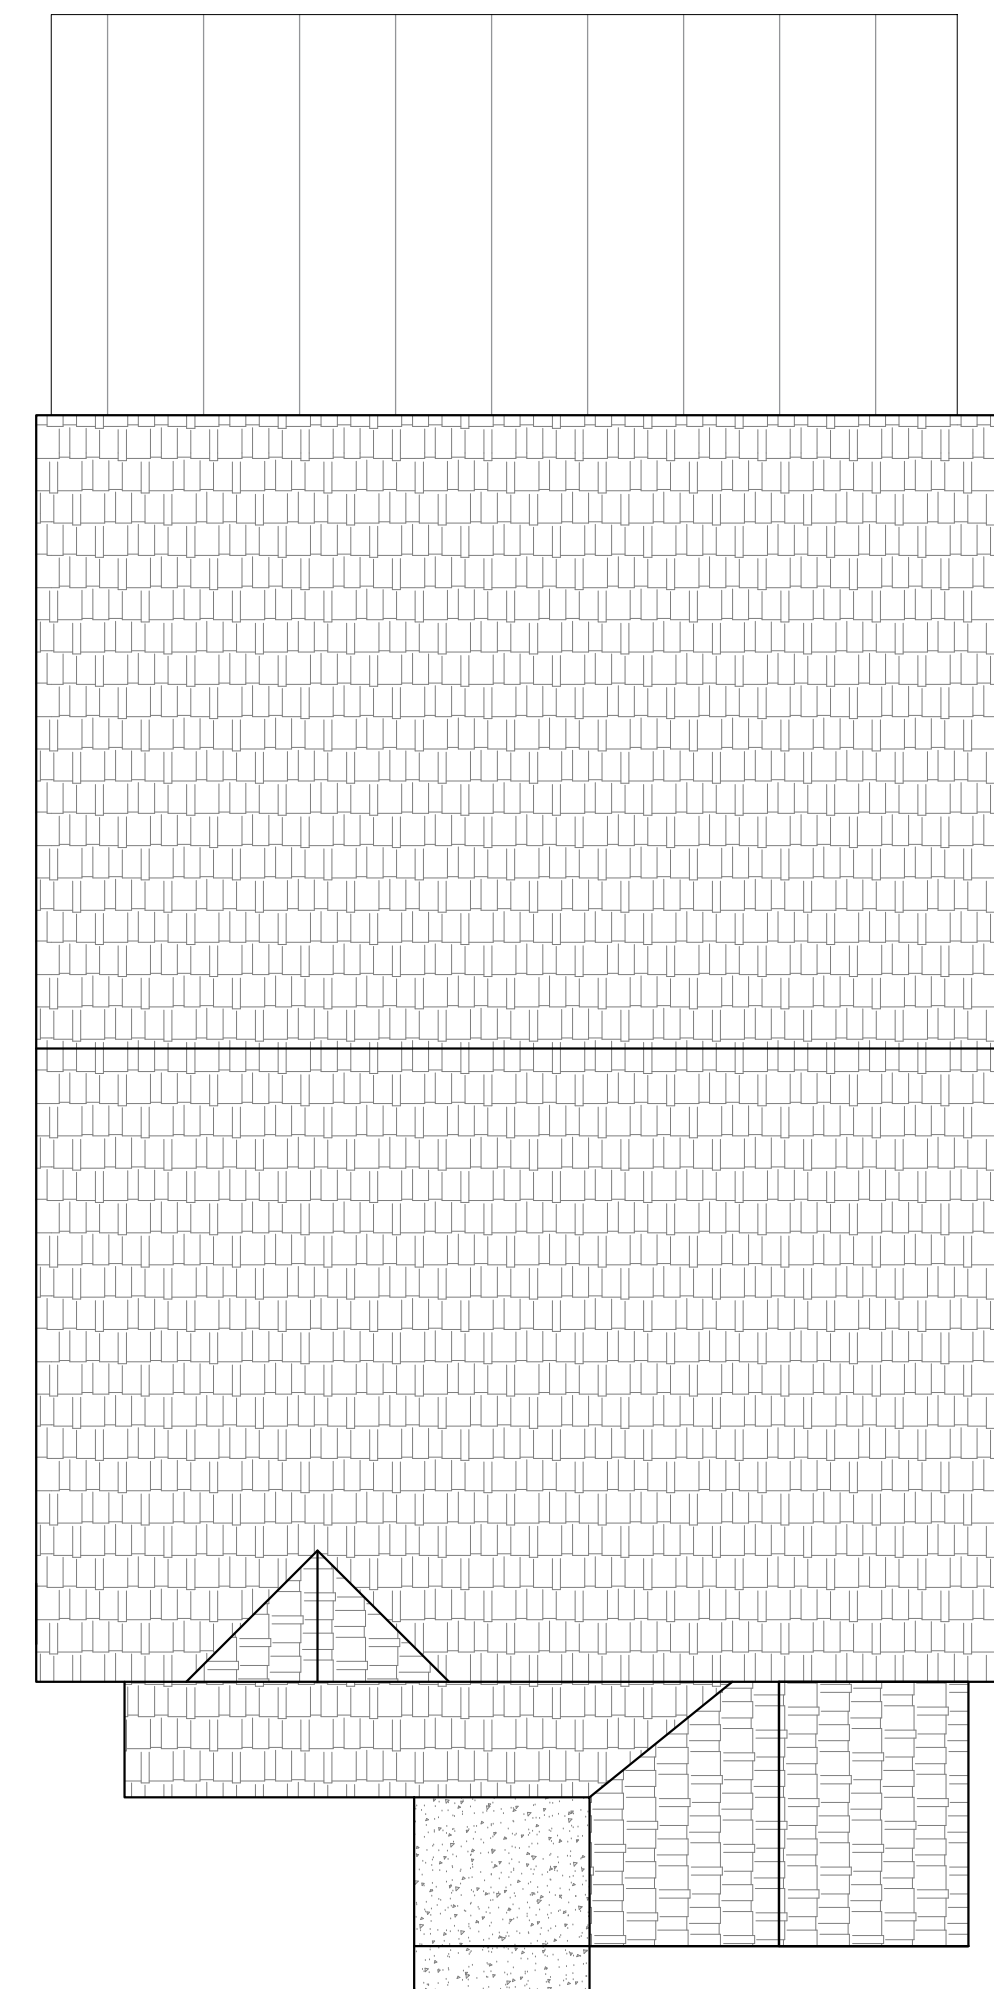

3 Existing Roof Plan
Scale 1:50

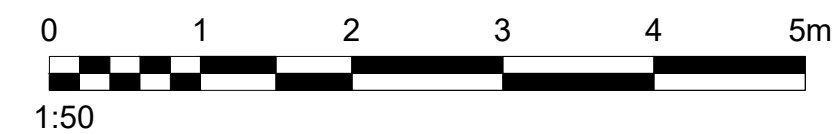

 ACN Structures 3 Argyle Road London W13 0LN 07835 148 268 acnstructures@gmail.com			
SITE: 14 Wimblington Drive RG6 4JG			
TITLE: Existing Plans - As Built			
SCALE AT A2: 1:50	DATE: July 2024	DRAWN: AC	CHECKED: -
PROJECT NO: 319	DRAWING NO: P200	REVISION: A	