


Notes:

1. THE COPYRIGHT OF THIS DRAWING IS VESTED IN ACN Structures




1 Existing Front Elevation-As Built
Scale 1:50

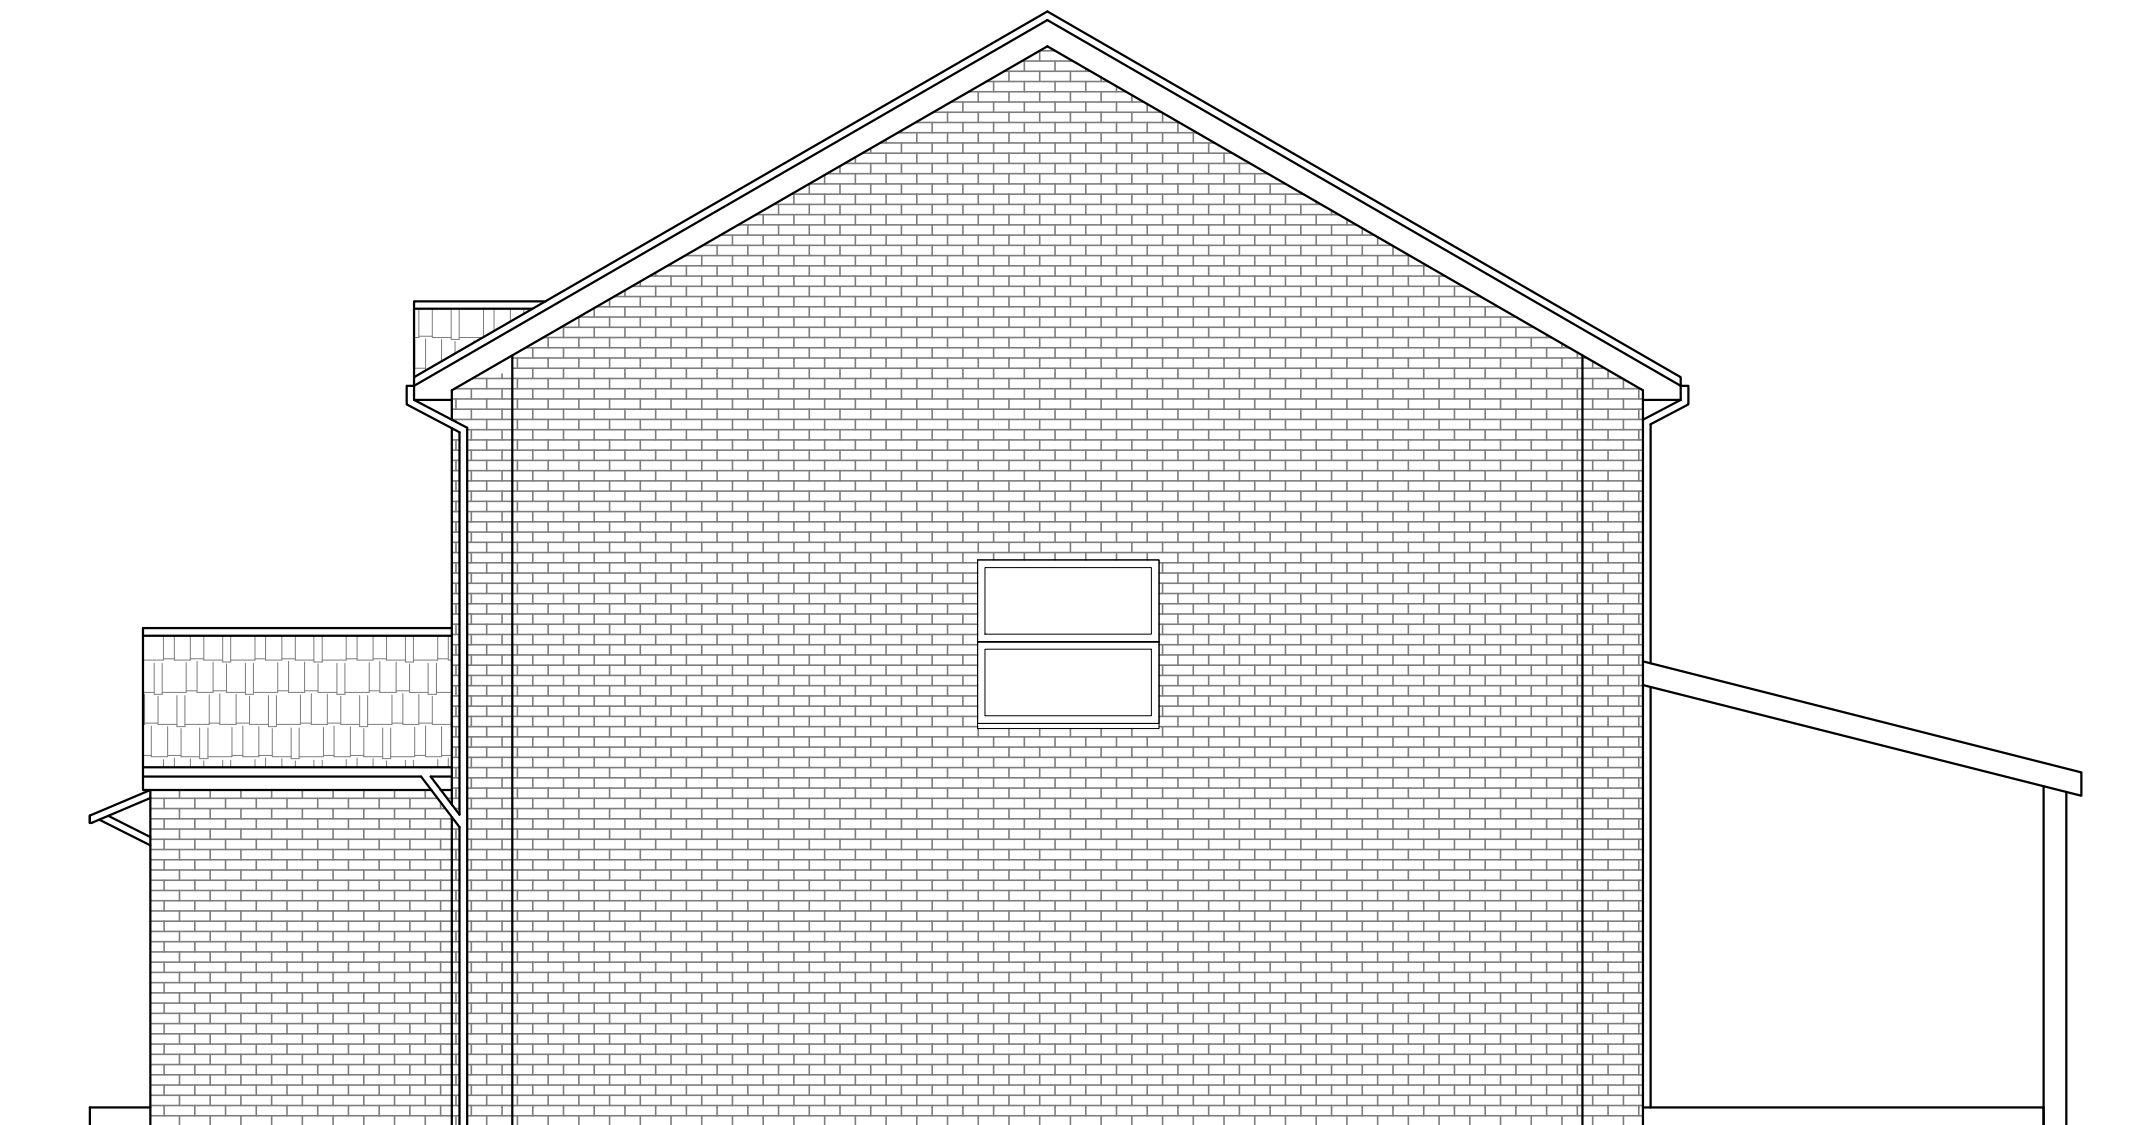


2 Existing Side Elevation - As Built
Scale 1:50



3 Existing Rear Elevation - As Built
Scale 1:50

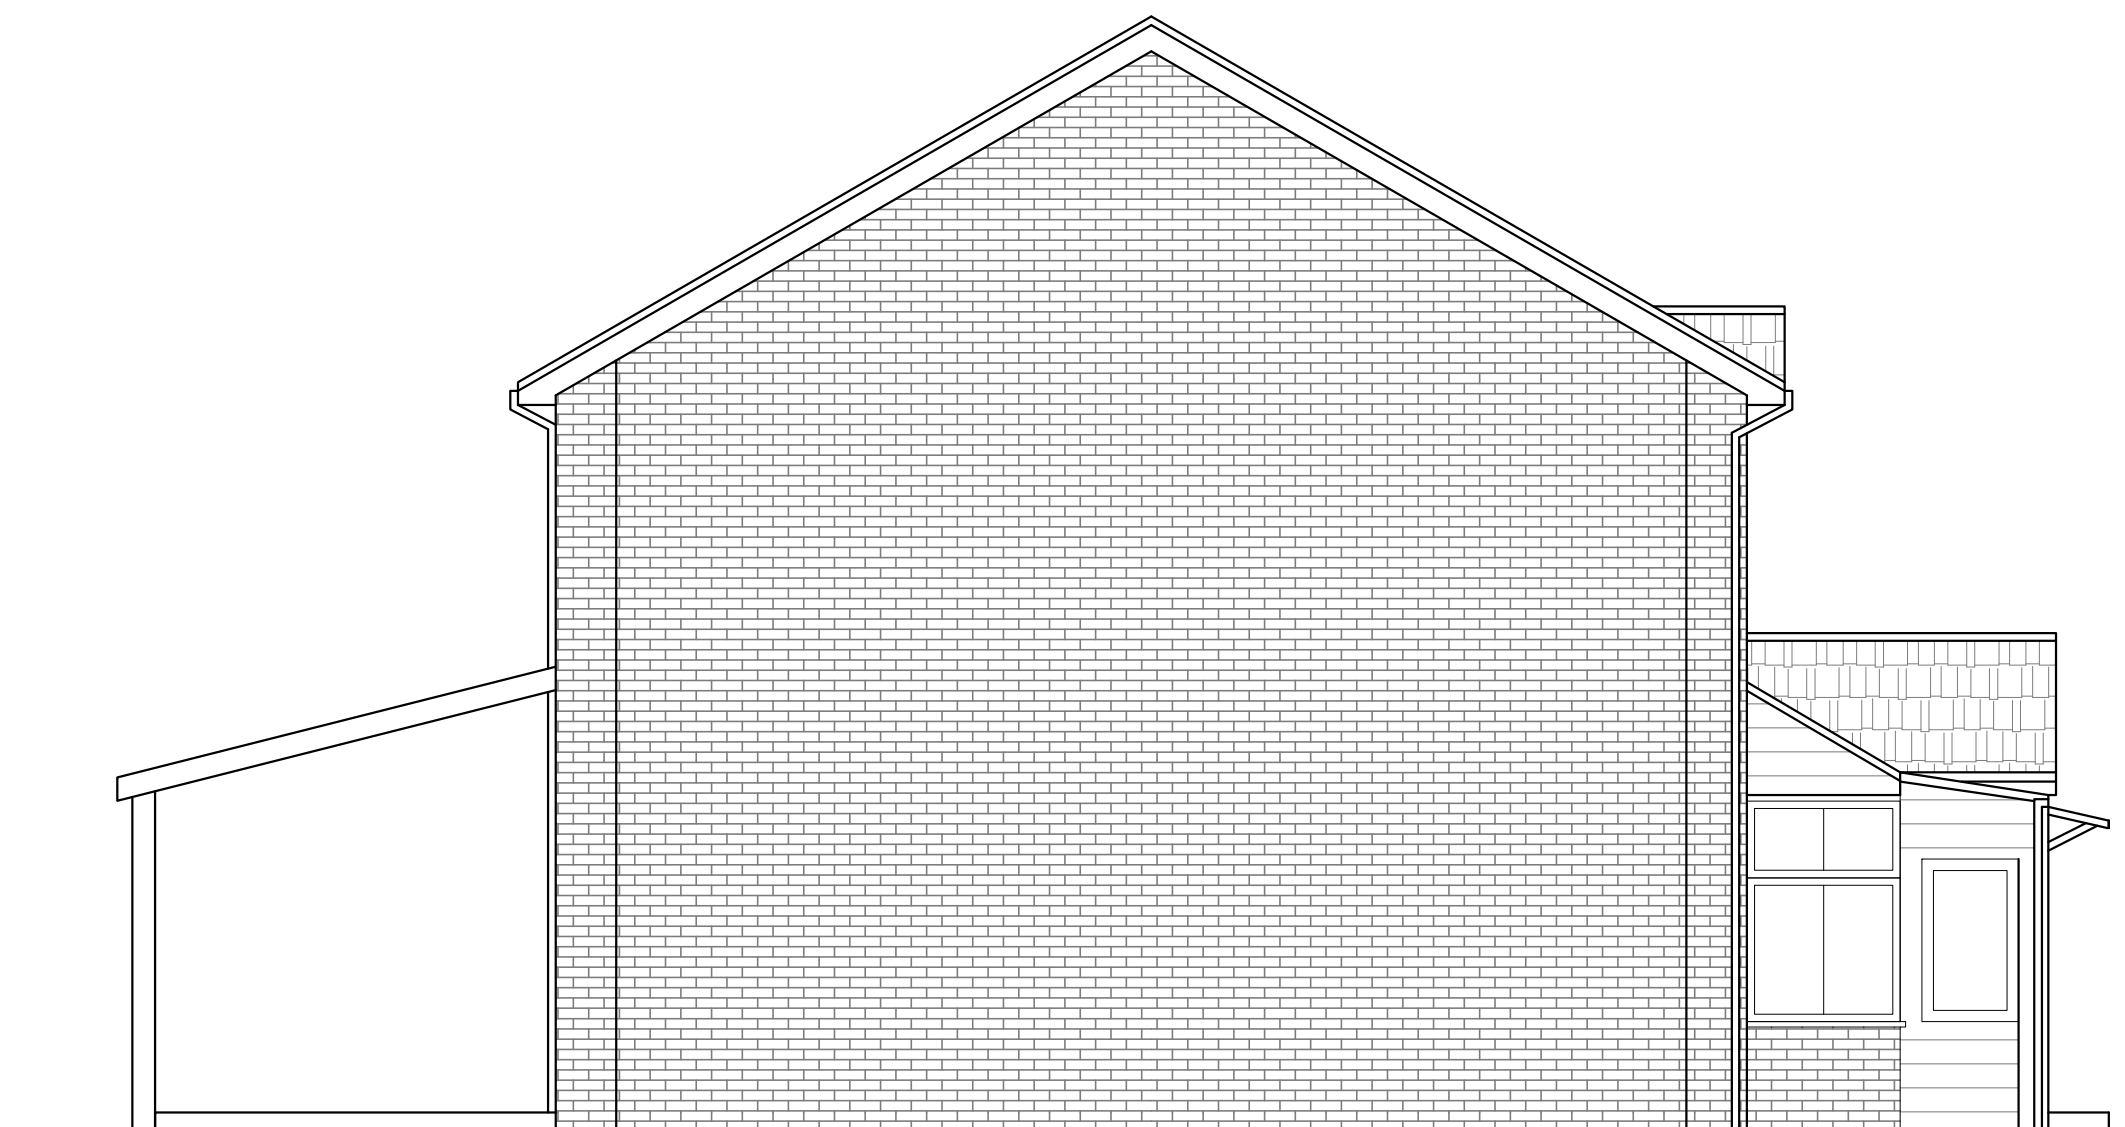

4 Existing Side Elevation - As Built
Scale 1:50

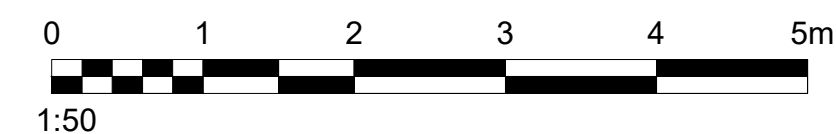

 ACN Structures 3 Argyle Road London W13 0LN 07835 148 268 acnstructures@gmail.com			
SITE: 14 Wimblington Drive RG6 4JG			
TITLE: Existing Elevations - As Built			
SCALE AT A2: 1:50	DATE: Jan 2024	DRAWN: AC	CHECKED: -
PROJECT NO: 319	DRAWING NO: P201	REVISION: A	