

SCALE DRAWINGS FOR PLANNING PURPOSES ONLY

ALL DIMENSIONS TO BE CHECKED ON SITE PRIOR  
TO COMMENCEMENT AND ANY DISCREPANCY REPORTED  
TO RCCA

THIS DRAWING IS COPYRIGHT AND CANNOT BE REPRODUCED  
IN PART OR WHOLE WITHOUT WRITTEN CONSENT OF RCCA



|        |   |      |    |      |    |      |
|--------|---|------|----|------|----|------|
| 1:100  | 0 | 1    | 2  | 3    | 4  | 5    |
| 1:200  | 0 | 2    | 4  | 6    | 8  | 10   |
| 1:1250 | 0 | 12.5 | 25 | 37.5 | 50 | 62.5 |




FRONT ELEVATION  
SCALE 1:100




SIDE ELEVATION TO SW  
SCALE 1:100




REAR ELEVATION  
SCALE 1:100

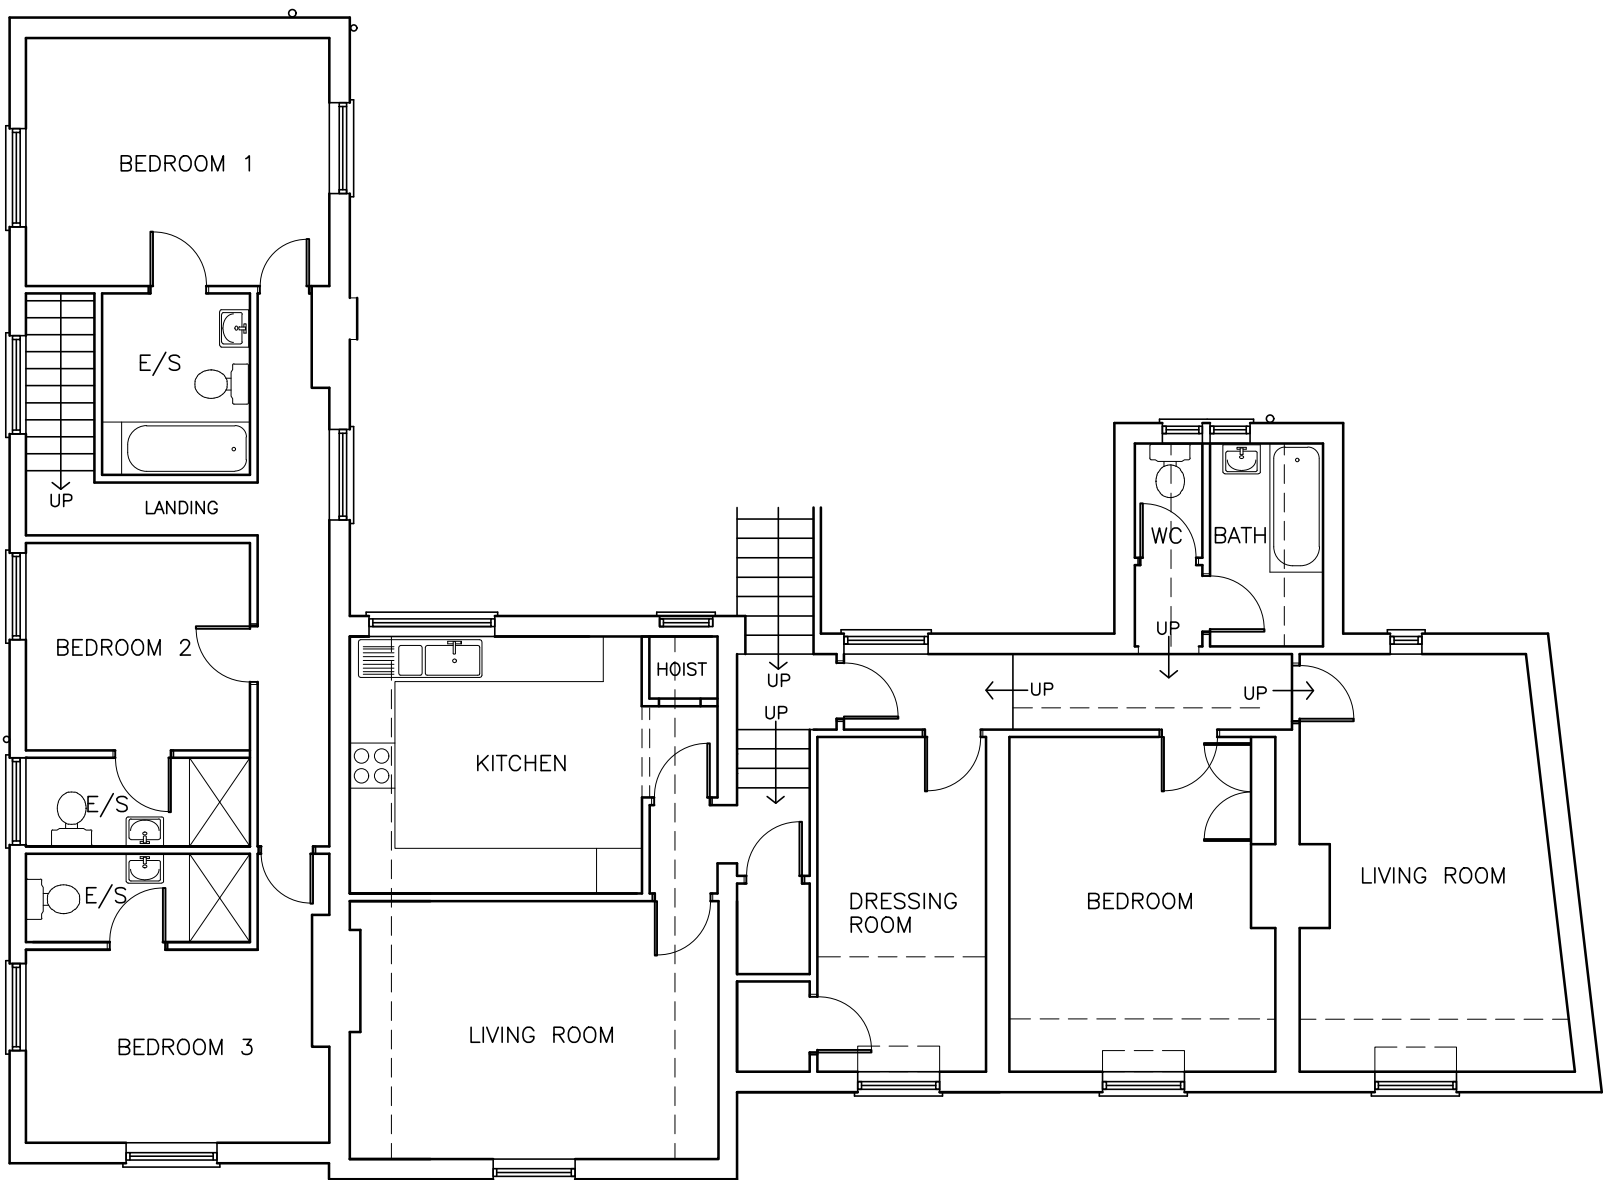


FIRST FLOOR PLAN  
SCALE 1:100

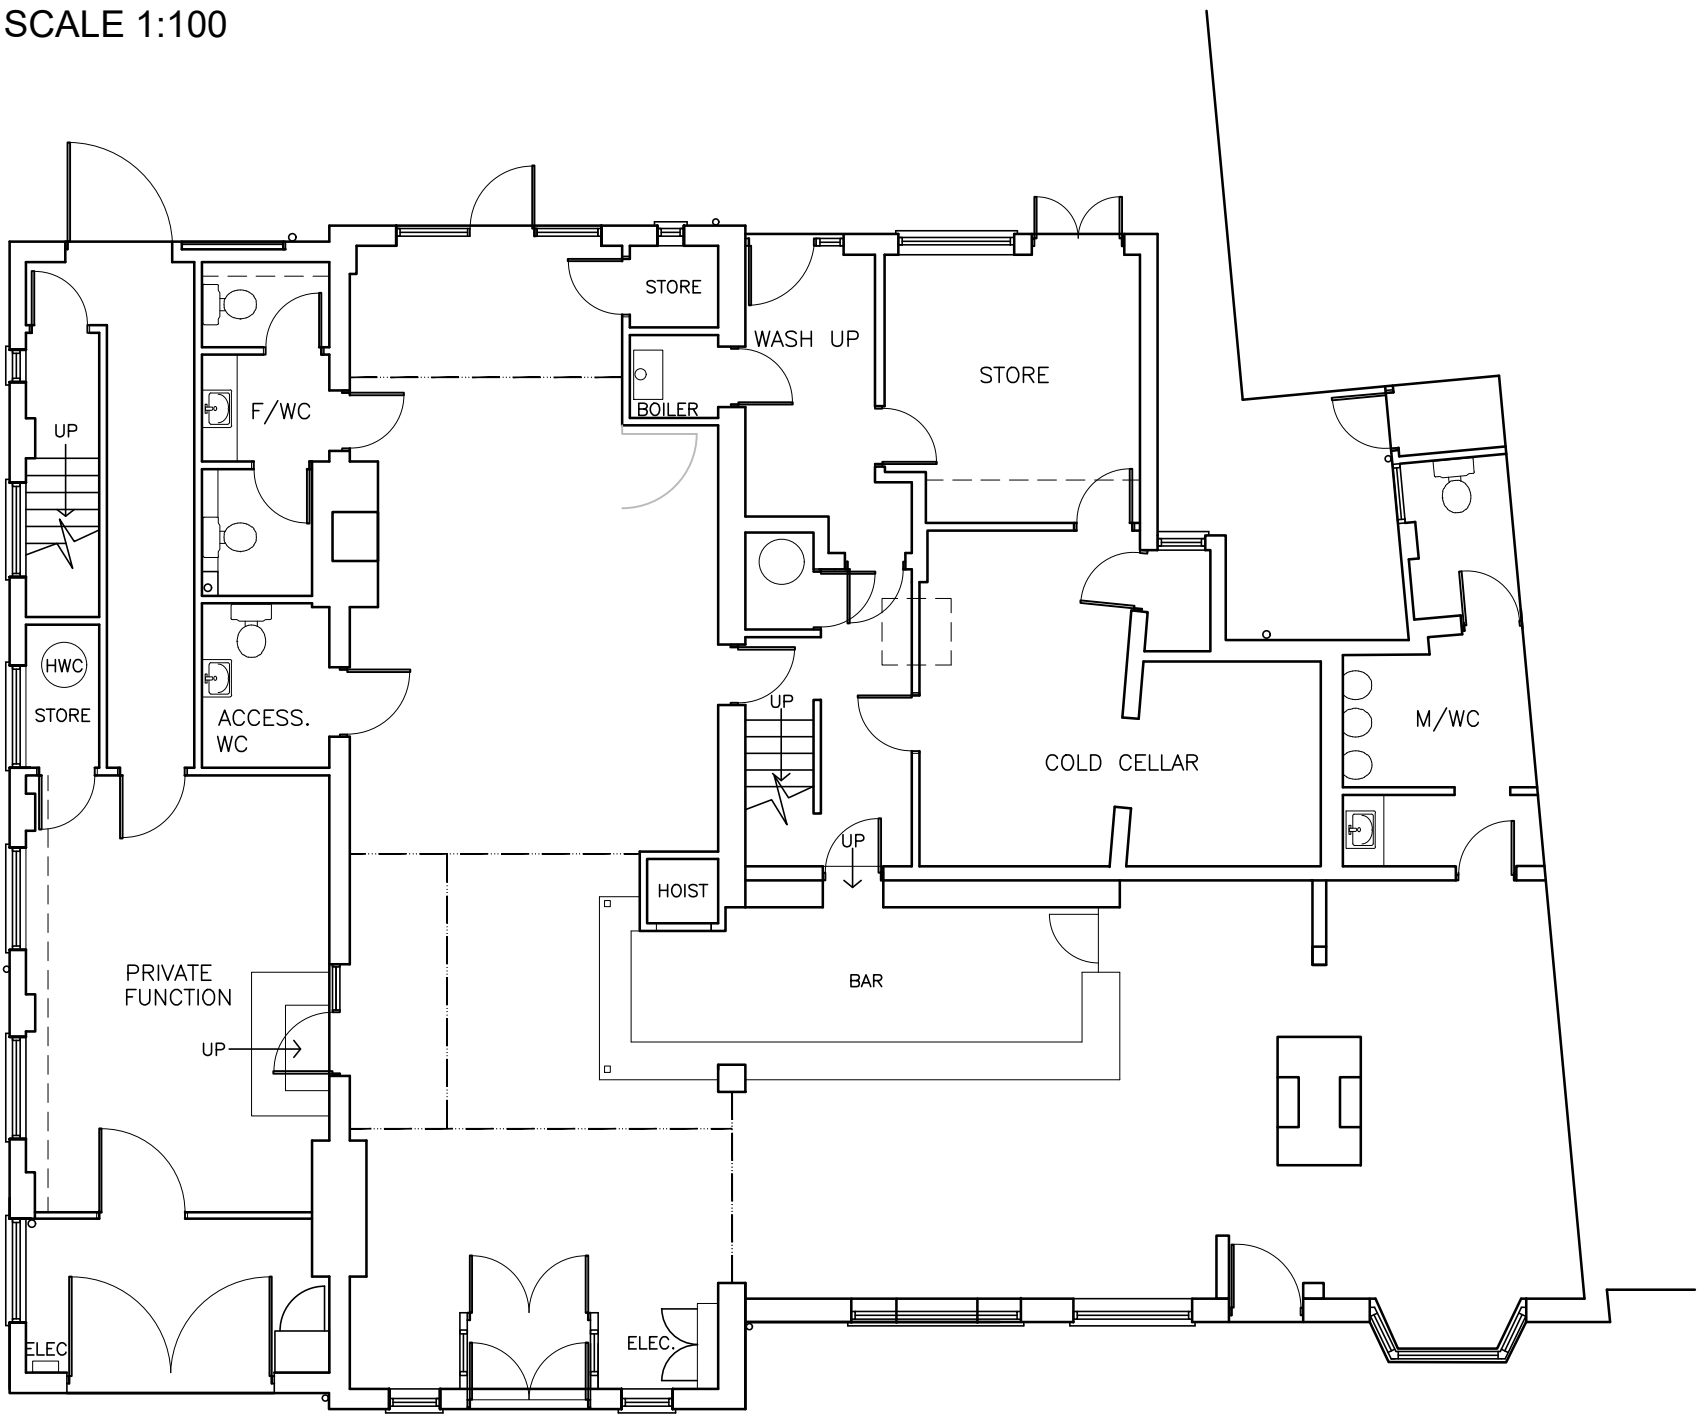


GROUND FLOOR PLAN  
SCALE 1:100

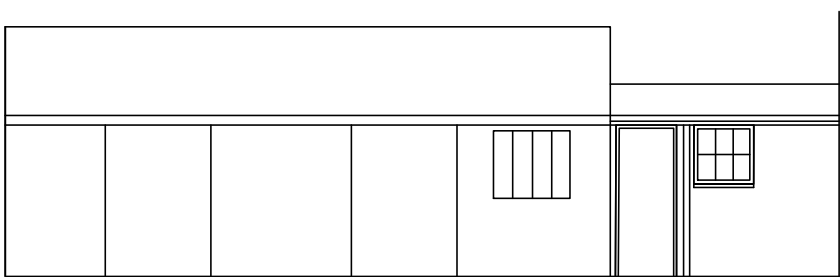


SIDE ELEVATION TO SW (STORE/WC)  
SCALE 1:100

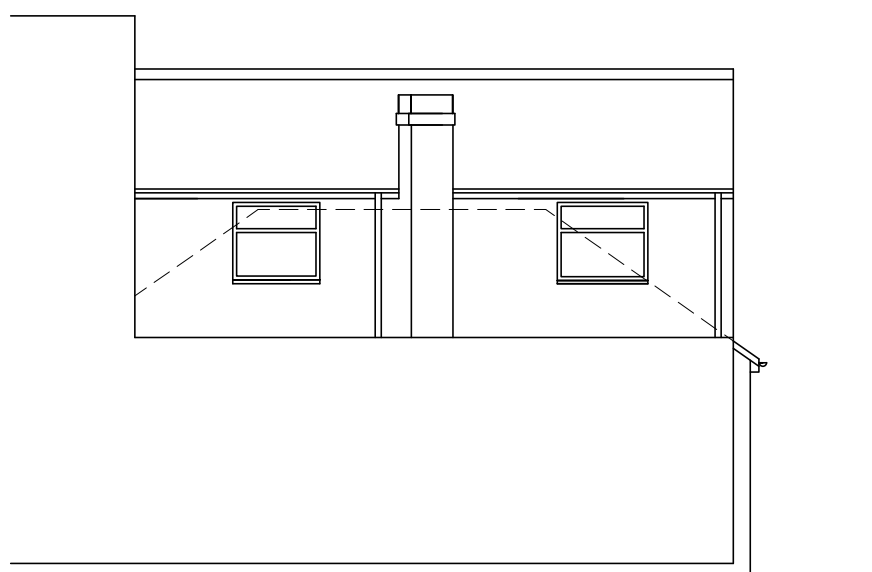

SIDE ELEVATION TO NE (BEHIND HIPPED ROOF)  
SCALE 1:100

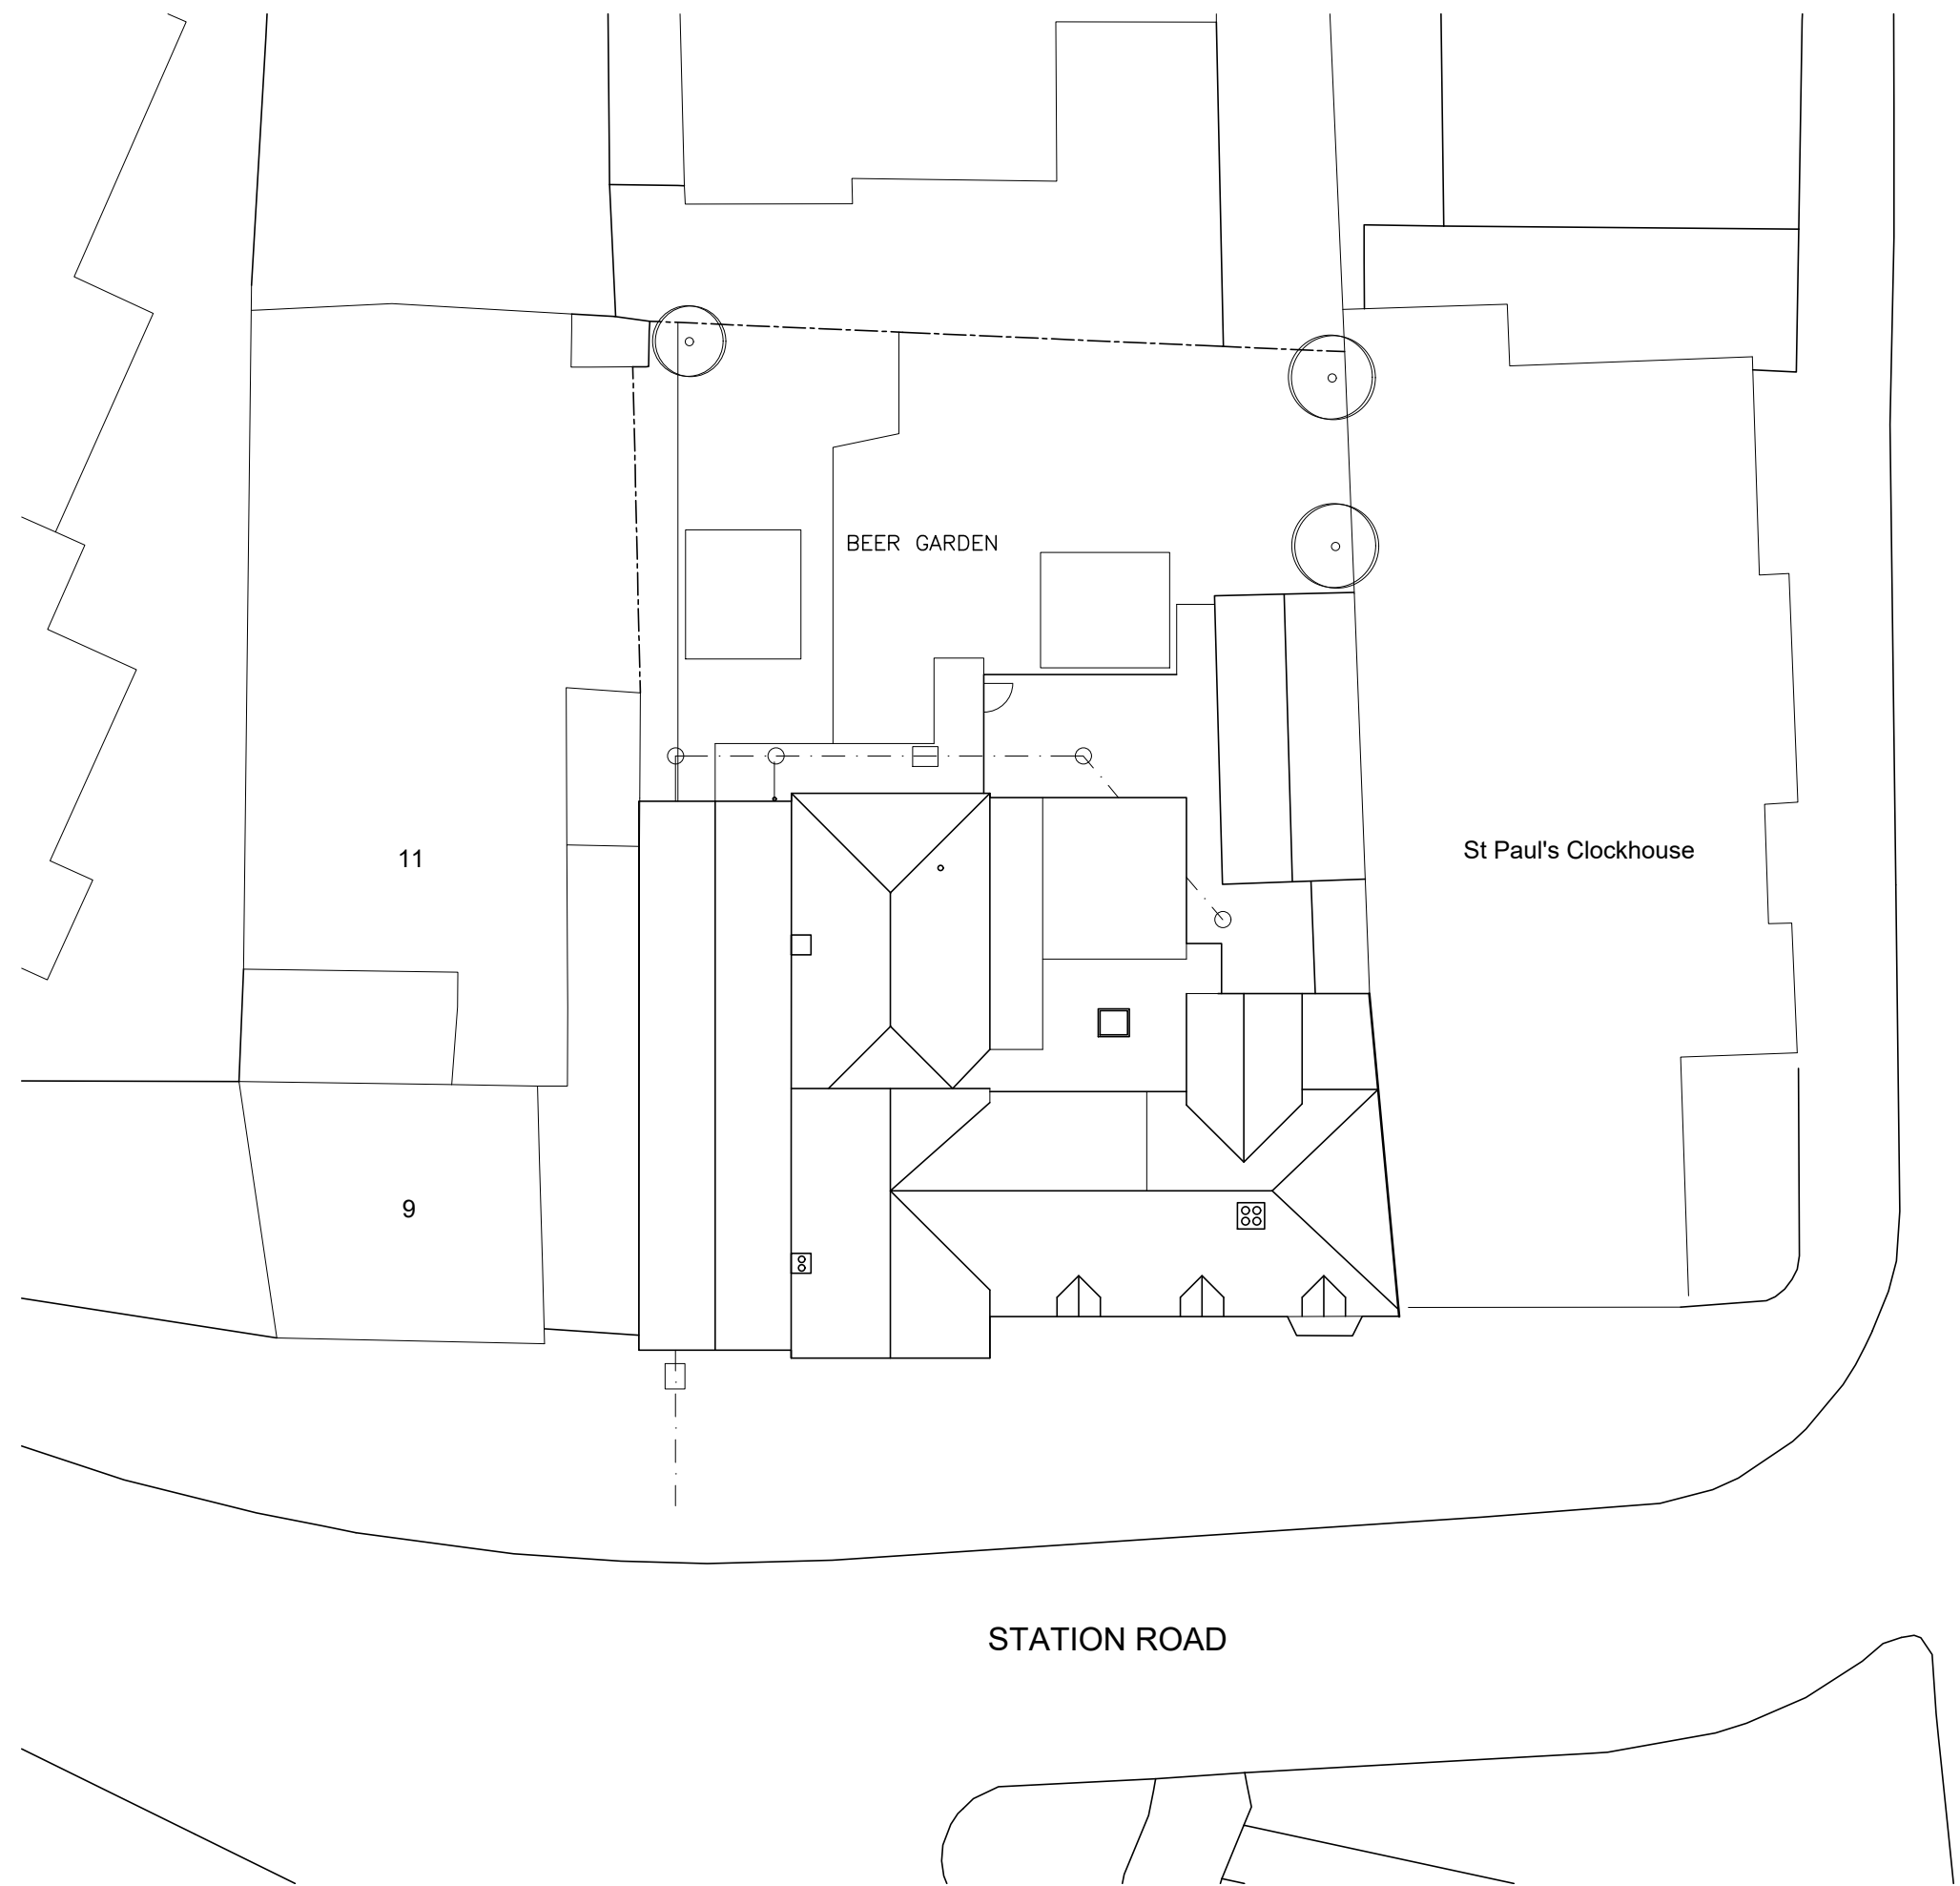

SITE PLAN  
SCALE 1:200

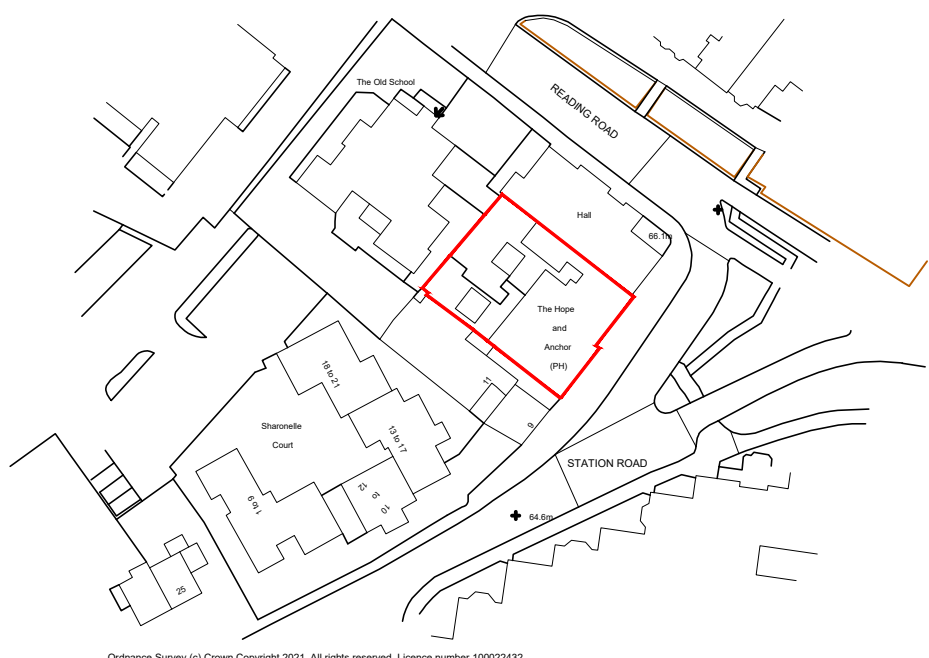

SITE LOCATION PLAN  
SCALE 1:1250

REVISIONS  
REV B AUG 22 ADDED DETAILS  
REV A JUN 22 MINOR ADDITIONS

**Richard Clark**  
CHARTERED ARCHITECTS

Clarks Barn, Bassetsbury Lane, High Wycombe, Bucks HP11 1QX  
T 01494 888000 F 01494 888008 E RICClark@richardclarkarchitects.co.uk

CONTRACT

'THE HOPE AND ANCHOR'  
STATION ROAD  
WOKINGHAM  
RG40 2AD

CLIENT  
W H BRAKSPEAR & SONS LTD

DRAWING  
RECORD SURVEY

DRAWN DATE  
JP OCT 21  
SCALE JOB / DRWG No  
as shown @ A1 1899-SUR B

BUILDING  
FOR LIFE  
AWARD  
WINNER

