


Appendix C – Overland flow Routes for Exceedance Events Plan

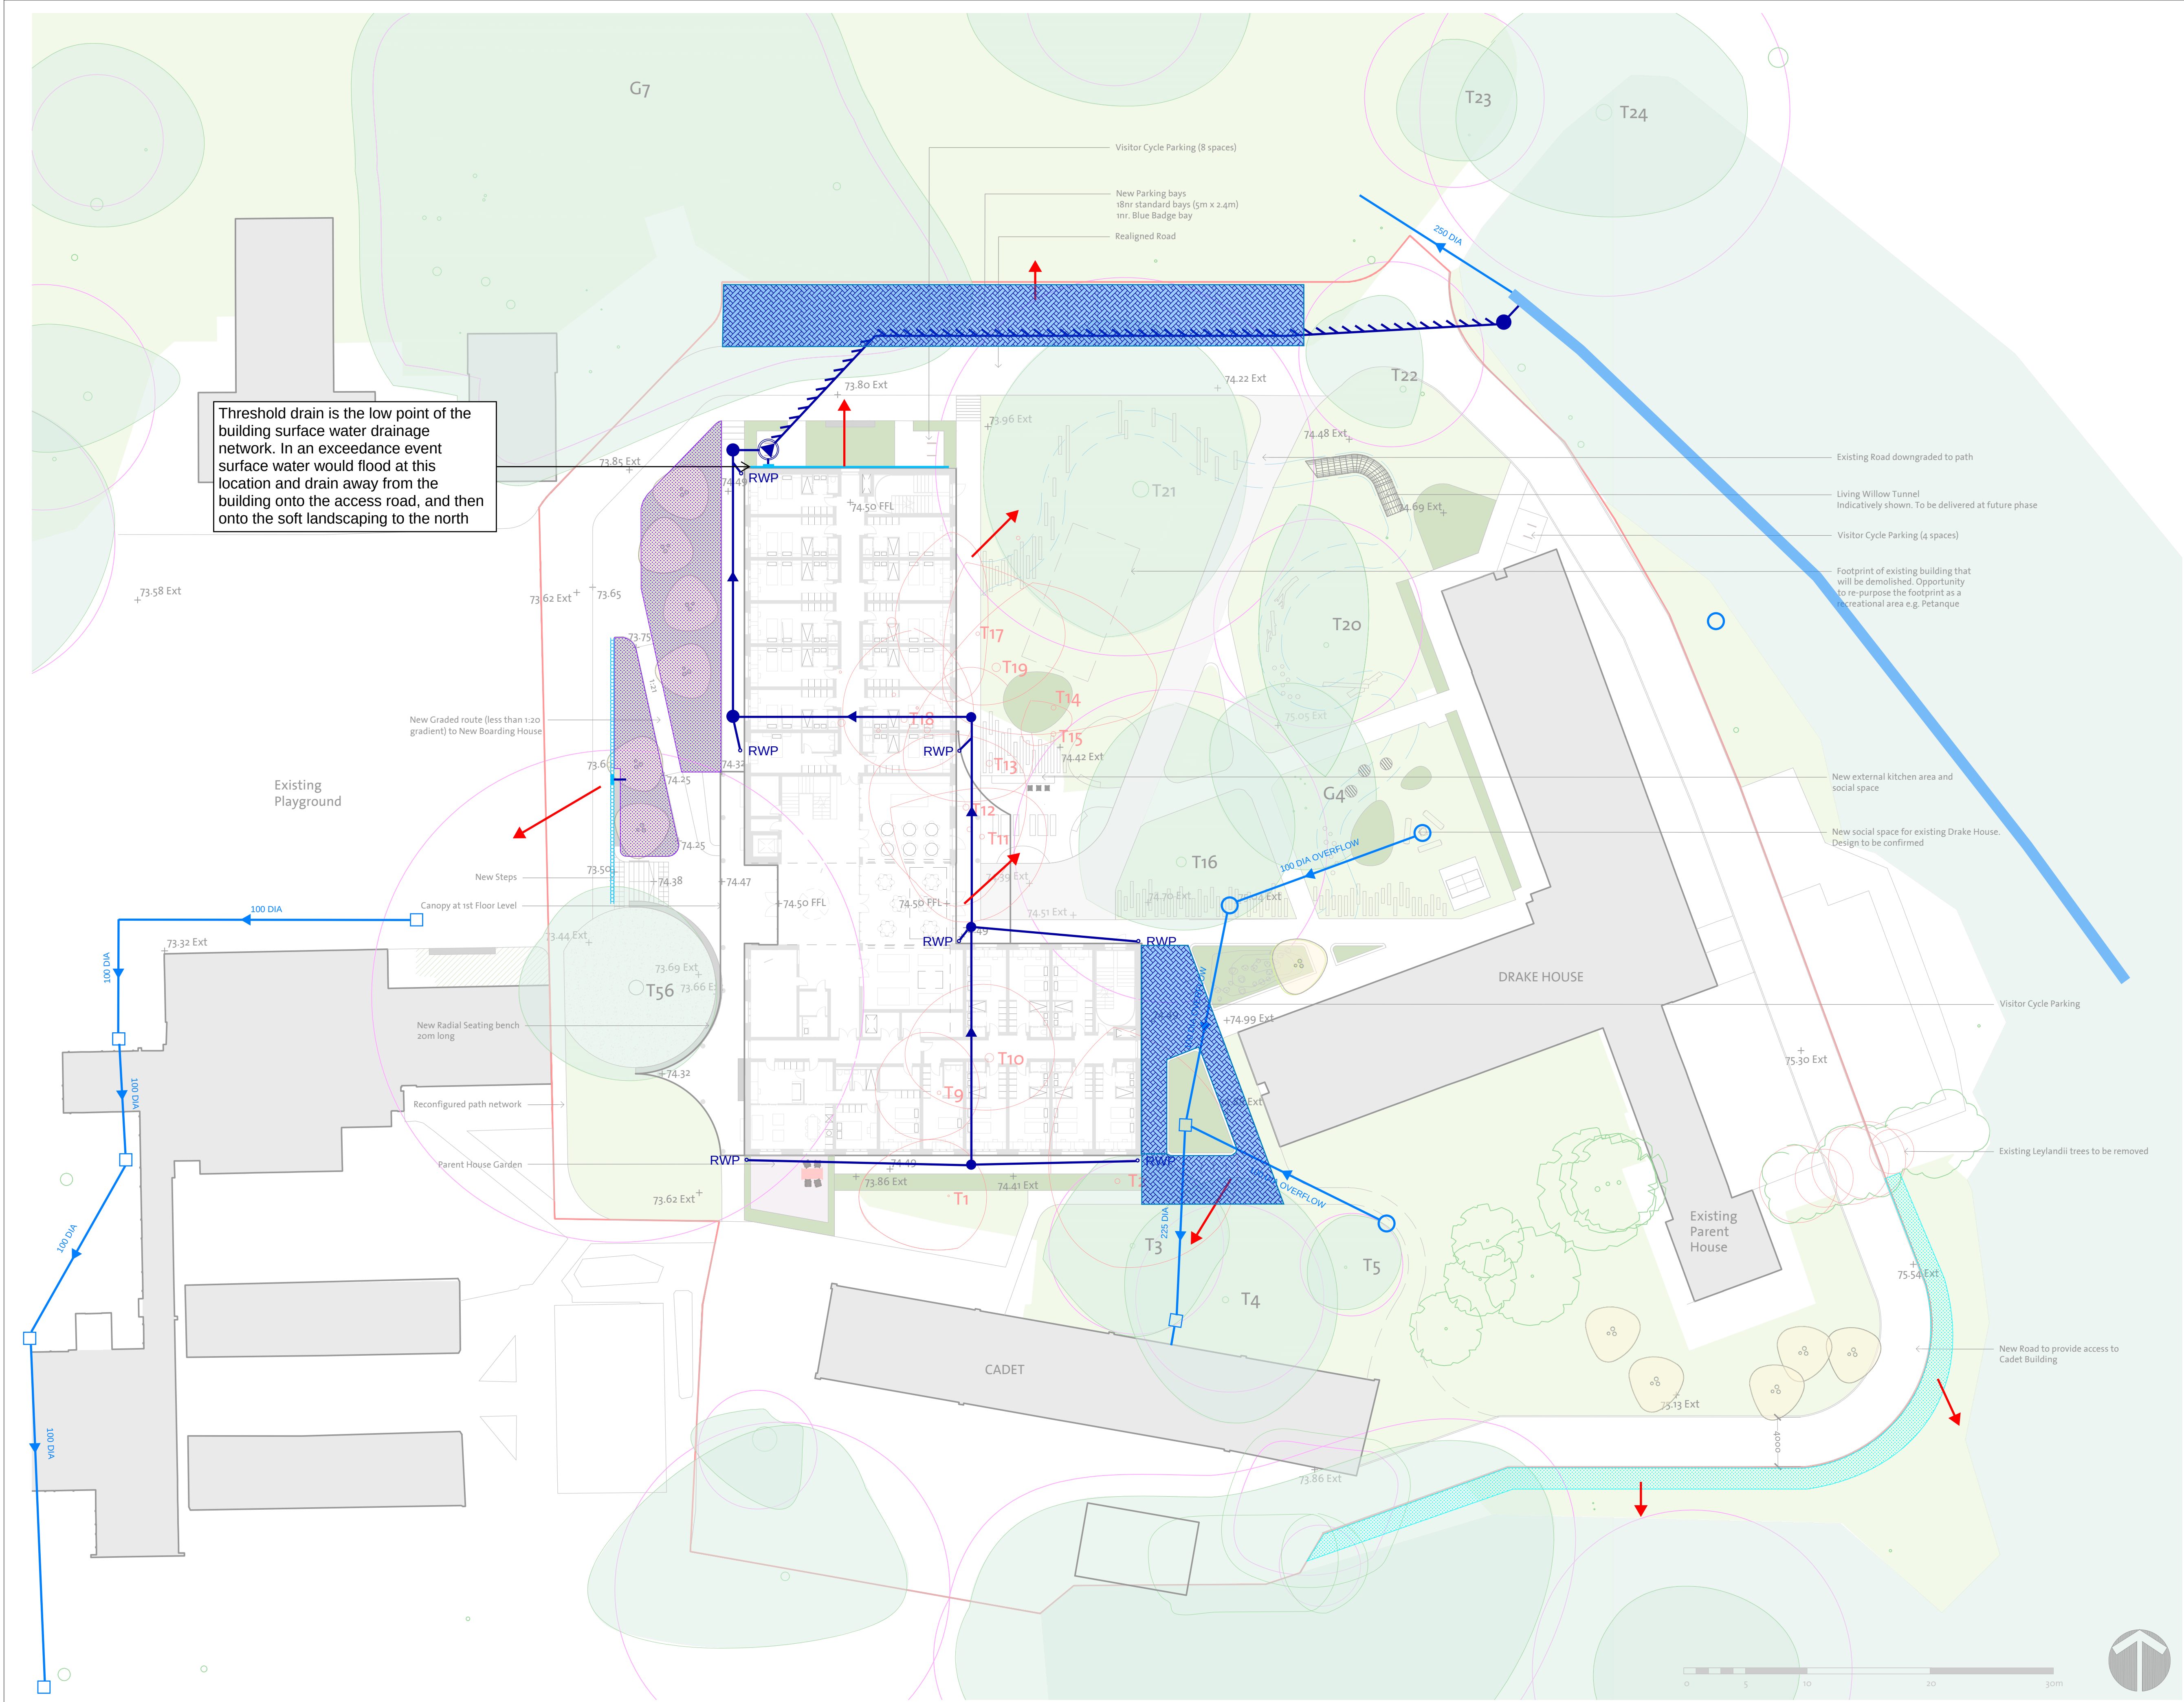

This drawing is to be read in conjunction with all relevant Architects, Engineers and Specialists Drawings and Specifications.

Do not scale from this drawing.

NOTES

1. DRAWING BASED ON BD LANDSCAPE ARCHITECTS 'LANDSCAPE AREAS PLAN' 0363-BDL-XX-XX-DR-L-0002-P06.

2. EXISTING DRAINAGE SHOWN BASED ON TOWER SURVEYS TOPOGRAPHICAL SURVEY DATED OCTOBER 2014.

3. ALL BELOW GROUND DRAINAGE WILL BE DESIGNED TO ACCOMODATE THE 1IN100 YEAR + 40% CLIMATE CHANGE RAINFALL EVENT WITHOUT FLOODING.

LEGEND

- PROPOSED OVERLAND SURFACE WATER FLOW ROUTE IN EXCEEDANCE EVENT
- EXISTING SURFACE WATER DRAINAGE
- PROPOSED SURFACE WATER DRAINAGE
- PROPOSED SURFACE WATER PUMPING STATION
- PROPOSED SURFACE WATER RISING MAIN
- RWP - INDICATIVE LOCATION
- CHANNEL DRAIN
- THRESHOLD DRAIN WITH BRICKSLOT UPSTAND
- PERMEABLE PAVING WITH POROUS SUB-BASE (UNLINED)
- FILTER DRAIN (UNLINED)
- RAIN GARDEN (UNLINED)
- CURRENT RED LINE BOUNDARY

P2	19/12/24	MTr	KTr	Issued for planning
P1	17/12/24	MTr	KTr	Issued for planning (Draft)
Rev	Date	By	Chk	Description

ElliottWood

Fitzrovia • Wimbledon • Nottingham

•info@elliottwood.co.uk

•+44(0)20-7499-5888

Project

New Reddam Boarding

Drawing Title


Proposed Overland Flow Routes for Exceedance Events

Scale	EWP Project	Date	Drawn
1:250@ A1	2240251	Dec 2024	MTr
Design Phase	Status	Revision	
Preliminary	S2	P2	

[Project]-[Origin]-[Function]-[Spatial]-[Form]-[Discipline]-[No.]

2240251-EWP - ZZ - 00 - SK - C - 00003

Appendix D – Thames Water Asset Records

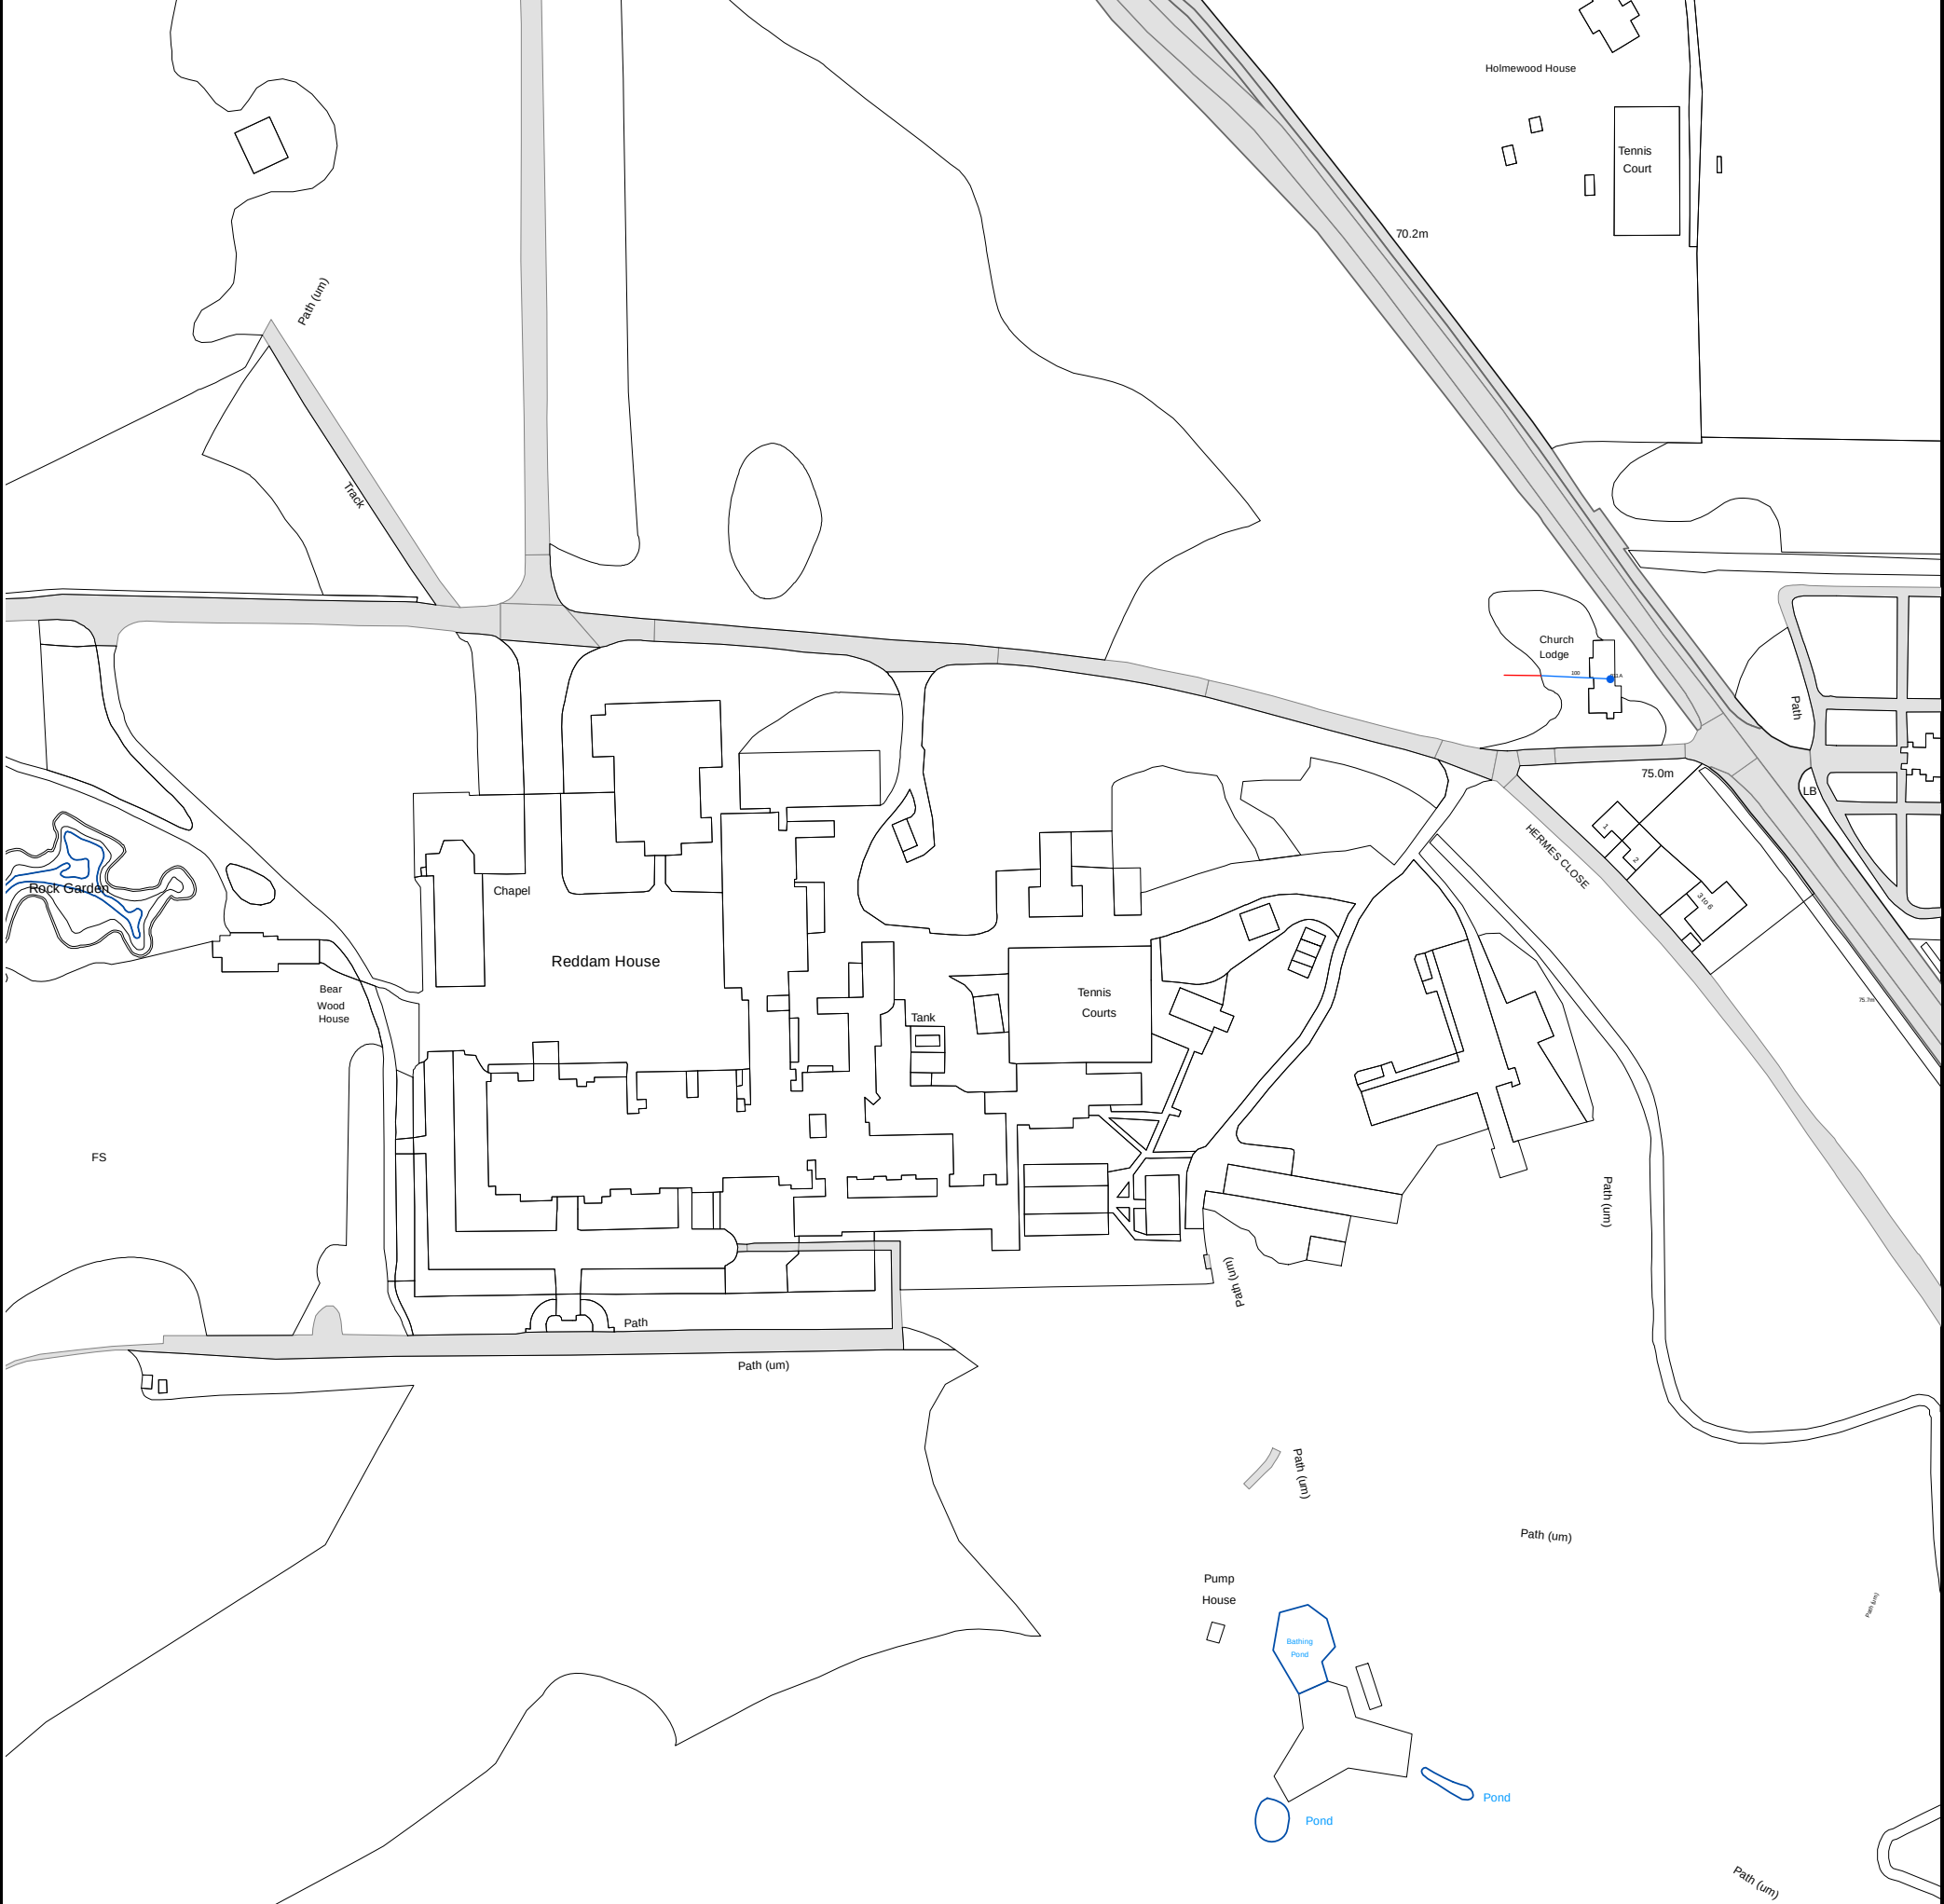


The width of the displayed area is 500 m and the centre of the map is located at OS coordinates 477780,169097

The position of the apparatus shown on this plan is given without obligation and warranty, and the accuracy cannot be guaranteed. Service pipes are not shown but their presence should be anticipated. No liability of any kind whatsoever is accepted by Thames Water for any error or omission. The actual position of mains and services must be verified and established on site before any works are undertaken.

Based on the Ordnance Survey Map (2020) with the Sanction of the controller of H.M. Stationery Office, License no. 100019345 Crown Copyright Reserved.

NB. Levels quoted in metres Ordnance Newlyn Datum. The value -9999.00 indicates that no survey information is available

Manhole Reference	Manhole Cover Level	Manhole Invert Level
911A	n/a	n/a
The position of the apparatus shown on this plan is given without obligation and warranty, and the accuracy cannot be guaranteed. Service pipes are not shown but their presence should be anticipated. No liability of any kind whatsoever is accepted by Thames Water for any error or omission. The actual position of mains and services must be verified and established on site before any works are undertaken.		

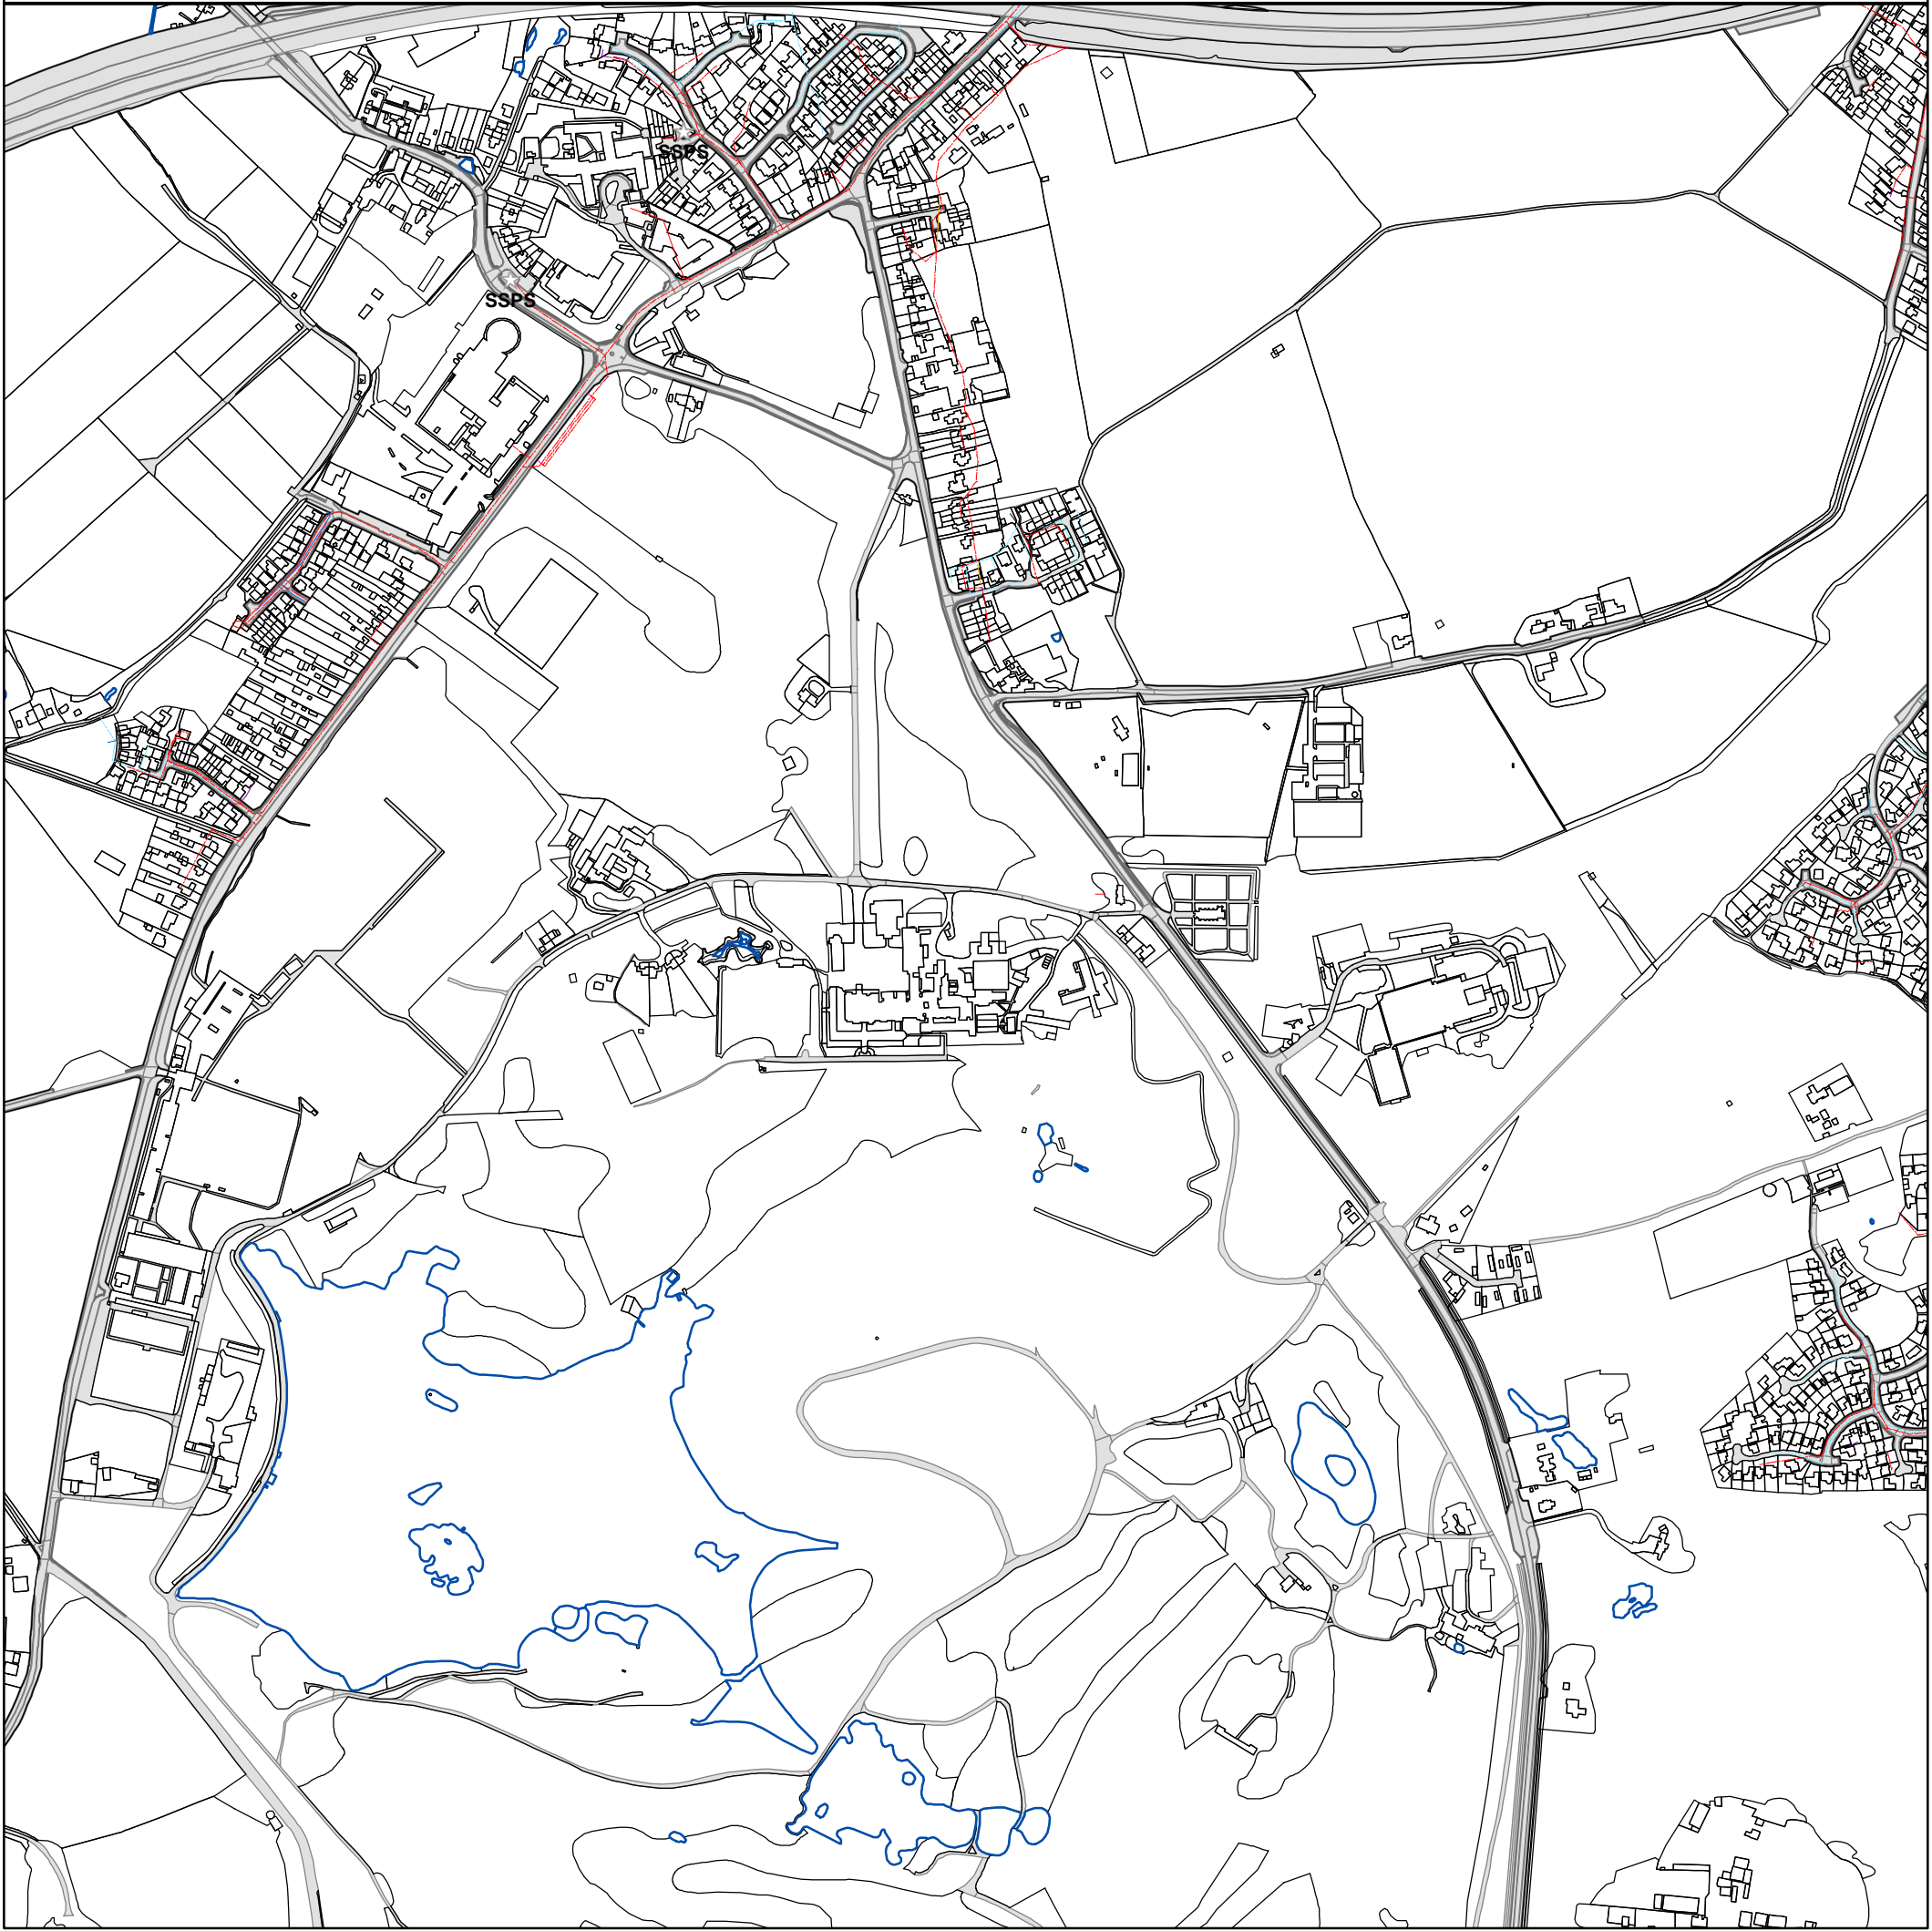

The position of the apparatus shown on this plan is given without obligation and warranty, and the accuracy cannot be guaranteed. Service pipes are not shown but their presence should be anticipated. No liability of any kind whatsoever is accepted by Thames Water for any error or omission. The actual position of mains and services must be verified before any works are undertaken. Crown copyright Reserved

Scale: 1:7161
Width: 2000m
Printed By: ASuji
Print Date: 04/11/2024
Map Centre: 477780,169097
Grid Reference: SU7769SE

Comments:



Asset Location Search - Sewer Key

Public Sewer Types (Operated and maintained by Thames Water)

	Foul Sewer: A sewer designed to convey waste water from domestic and industrial sources to a treatment works.
	Surface Water Sewer: A sewer designed to convey surface water (e.g. rain water from roofs, yards and car parks) to rivers or watercourses.
	Combined Sewer: A sewer designed to convey both waste water and surface water from domestic and industrial sources to a treatment works.
	Storm Sewer
	Sludge Sewer
	Foul Trunk Sewer
	Surface Trunk Sewer
	Combined Trunk Sewer
	Foul Rising Main
	Surface Water Rising Main
	Combined Rising Main
	Vacuum
	Thames Water Proposed
	Vent Pipe
	Gallery

Other Sewer Types (Not operated and maintained by Thames Water)

	Sewer
	Culverted Watercourse
	Proposed
	Decommissioned Sewer
	Content of this drainage network is currently unknown
	Ownership of this drainage network is currently unknown

Notes:

- 1) All levels associated with the plans are to Ordnance Datum Newlyn.
- 2) All measurements on the plan are metric.
- 3) Arrows (on gravity fed sewers) or flecks (on rising mains) indicate the direction of flow.
- 4) Most private pipes are not shown on our plans, as in the past, this information has not been recorded.

Sewer Fittings

A feature in a sewer that does not affect the flow in the pipe. Example: a vent is a fitting as the function of a vent is to release excess gas.

	Air Valve		Meter
	Dam Chase		Vent
	Fitting		

Operational Controls

A feature in a sewer that changes or diverts the flow in the sewer. Example: A hydrobrake limits the flow passing downstream.

	Ancillary		Drop Pipe
	Control Valve		Weir

End Items

End symbols appear at the start or end of a sewer pipe. Examples: an Undefined End at the start of a sewer indicates that Thames Water has no knowledge of the position of the sewer upstream of that symbol. Outfall on a surface water sewer indicates that the pipe discharges into a stream or river.

	Inlet		Outfall
	Undefined End		

Other Symbols

Symbols used on maps which do not fall under other general categories.

	Change of Characteristic Indicator		Public / Private Pumping Station
	Invert Level		Summit

Areas

Lines denoting areas of underground surveys, etc.


	Agreement
	Chamber
	Operational Site

Ducts or Crossings

	Casement	Ducts may contain high voltage cables. Please check with Thames Water.
	Conduit Bridge	
	Subway	
	Tunnel	

5) 'na' or '0' on a manhole indicates that data is unavailable.



6) The text appearing alongside a sewer line indicates the internal diameter of the pipe in millimeters. Text next to a manhole indicates the manhole reference number and should not be taken as a measurement. If you are unsure about any text or symbology, please contact Property Searches on 0800 009 4540.

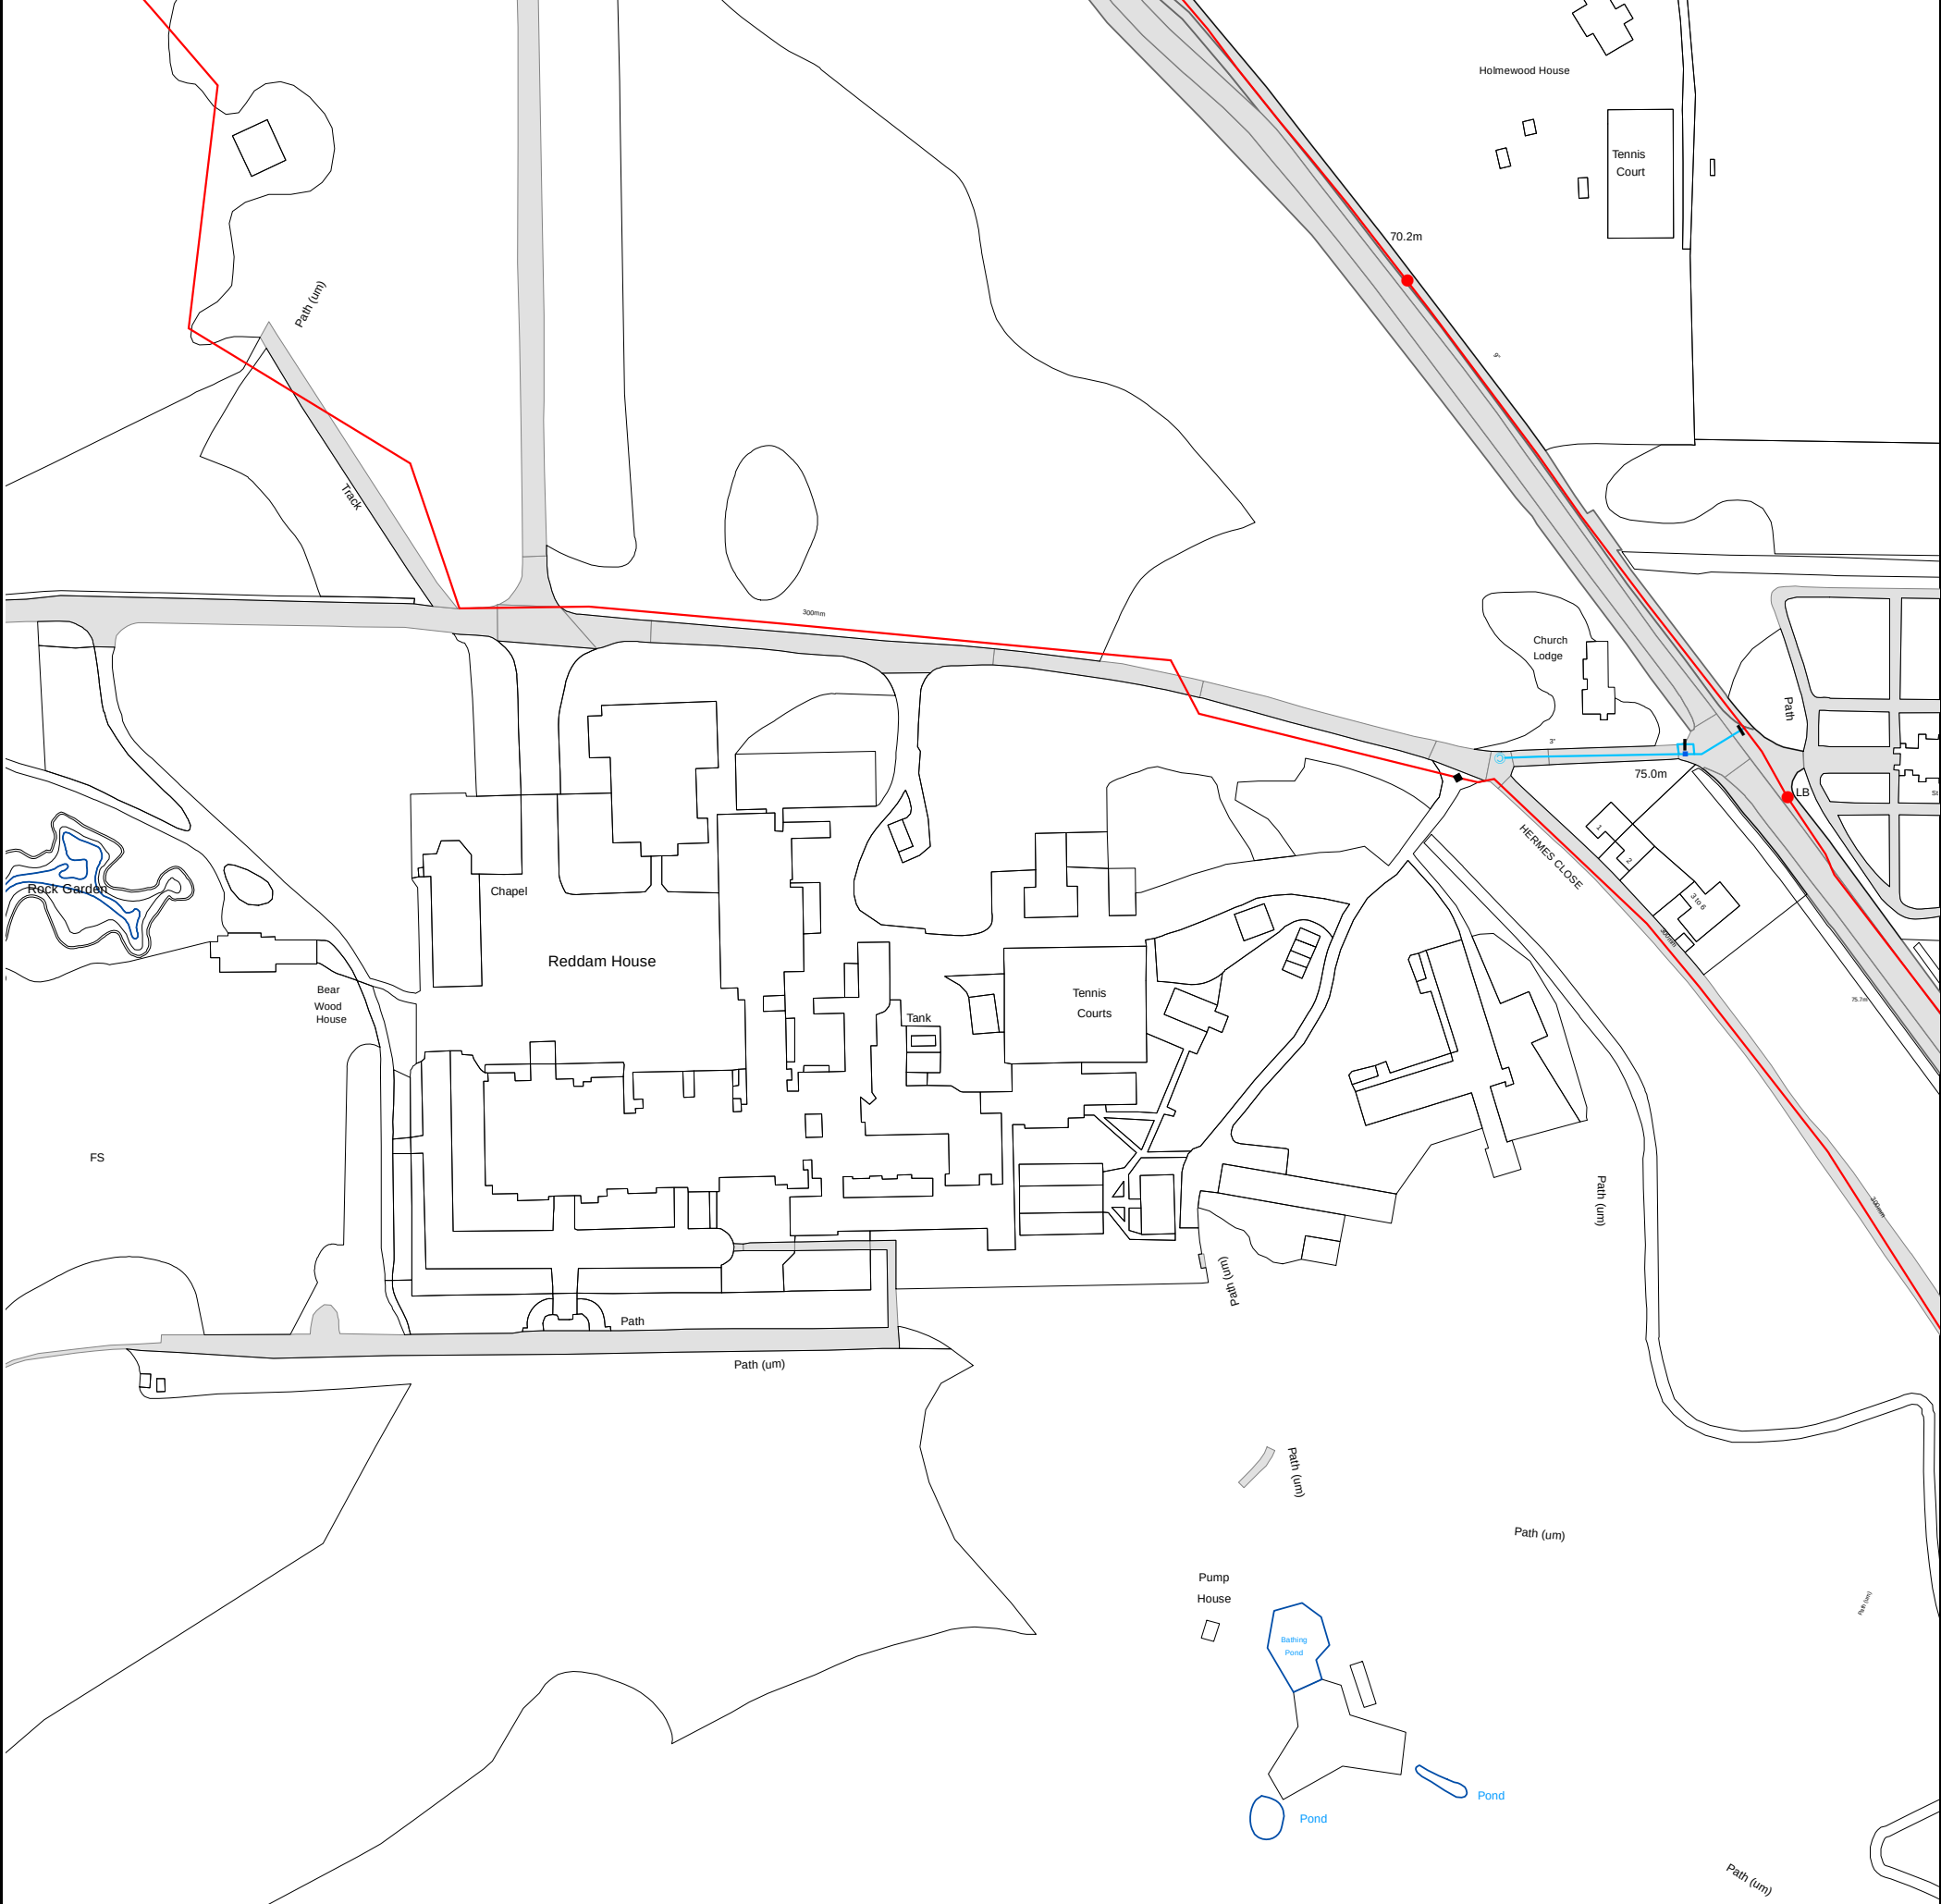

The width of the displayed area is 500 m and the centre of the map is located at OS coordinates 477780, 169097.

The position of the apparatus shown on this plan is given without obligation and warranty, and the accuracy cannot be guaranteed. Service pipes are not shown but their presence should be anticipated. No liability of any kind whatsoever is accepted by Thames Water for any error or omission. The actual position of mains and services must be verified and established on site before any works are undertaken.

Based on the Ordnance Survey Map (2020) with the Sanction of the controller of H.M. Stationery Office, License no. 100019345 Crown Copyright Reserved.

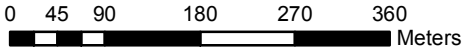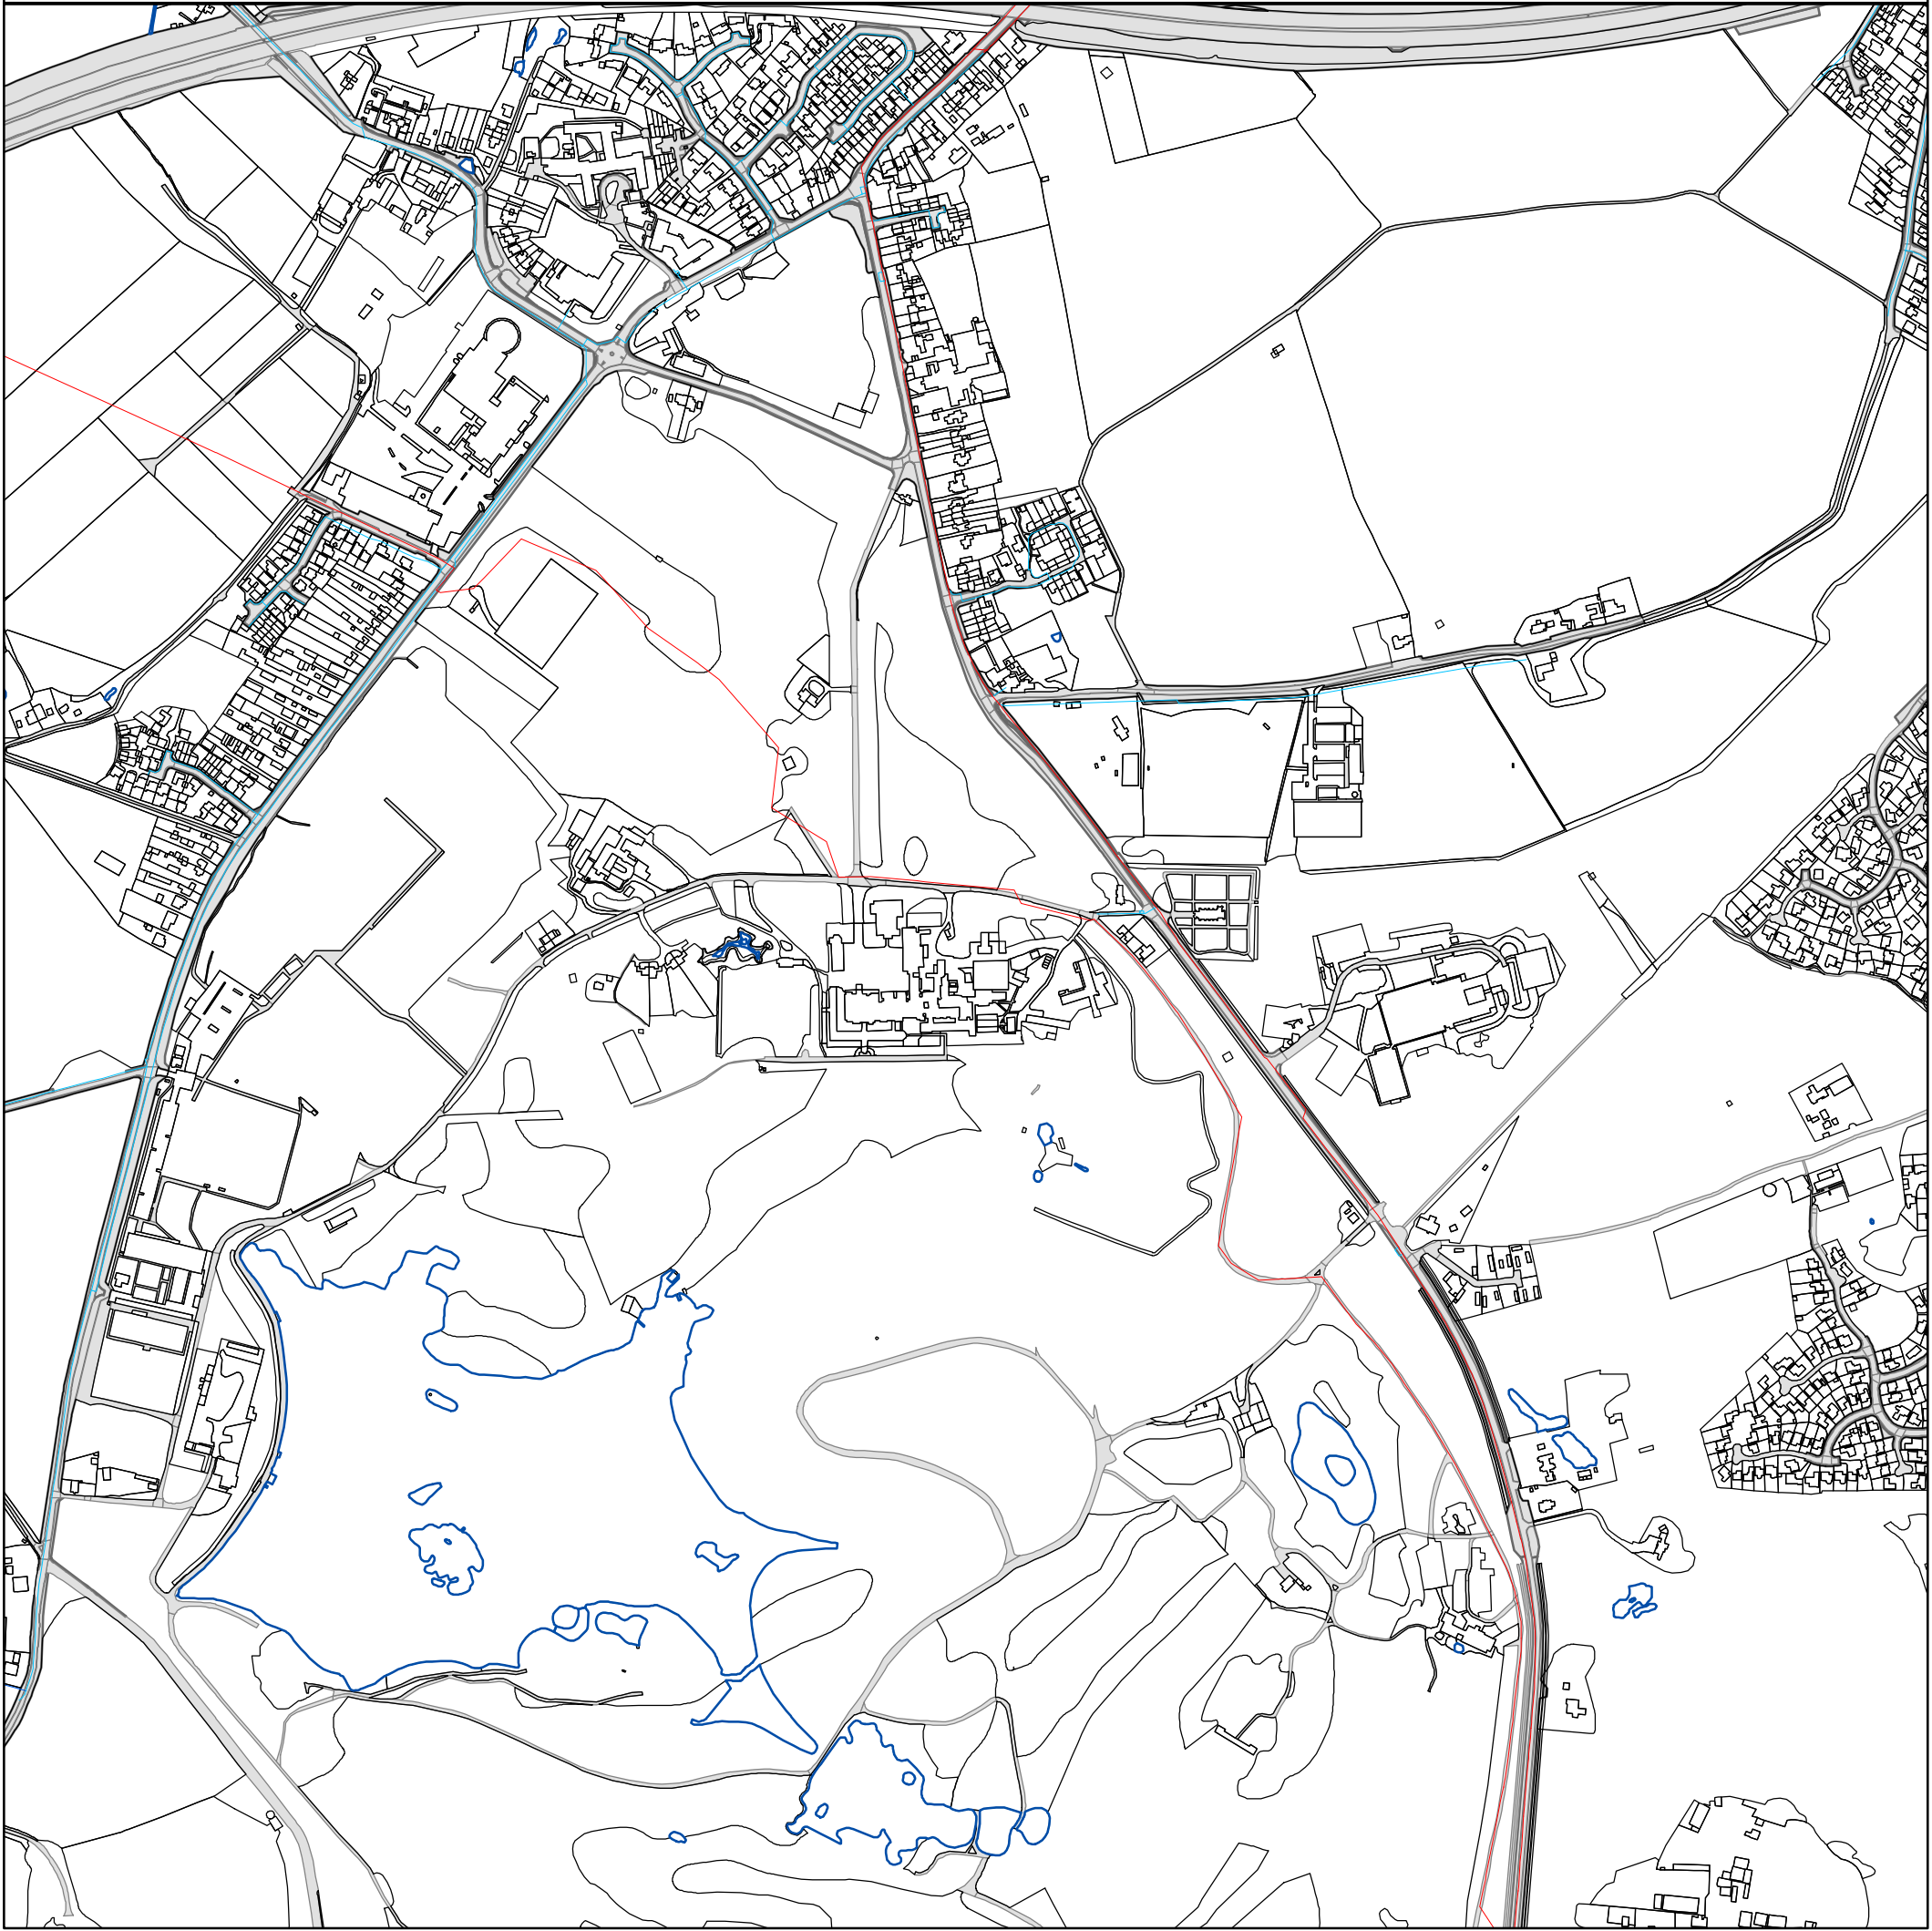

The position of the apparatus shown on this plan is given without obligation and warranty, and the accuracy cannot be guaranteed. Service pipes are not shown but their presence should be anticipated. No liability of any kind whatsoever is accepted by Thames Water for any error or omission. The actual position of mains and services must be verified before any works are undertaken. Crown copyright Reserved

Scale: 1:7161
Width: 2000m
Printed By: ASuji
Print Date: 04/11/2024
Map Centre: 477780,169097
Grid Reference: SU7769SE

Comments:



Asset Location Search - Water Key

Water Pipes (Operated & Maintained by Thames Water)

- 4"** **Distribution Main:** The most common pipe shown on water maps. With few exceptions, domestic connections are only made to distribution mains.
- 16"** **Trunk Main:** A main carrying water from a source of supply to a treatment plant or reservoir, or from one treatment plant or reservoir to another. Also a main transferring water in bulk to smaller water mains used for supplying individual customers.
- 3" SUPPLY** **Supply Main:** A supply main indicates that the water main is used as a supply for a single property or group of properties.
- 3" FIRE** **Fire Main:** Where a pipe is used as a fire supply, the word FIRE will be displayed along the pipe.
- 3" METERED** **Metered Pipe:** A metered main indicates that the pipe in question supplies water for a single property or group of properties and that quantity of water passing through the pipe is metered even though there may be no meter symbol shown.
- Transmission Tunnel:** A very large diameter water pipe. Most tunnels are buried very deep underground. These pipes are not expected to affect the structural integrity of buildings shown on the map provided.
- Proposed Main:** A main that is still in the planning stages or in the process of being laid. More details of the proposed main and its reference number are generally included near the main.

PIPE DIAMETER	DEPTH BELOW GROUND
Up to 300mm (12")	900mm (3')
300mm - 600mm (12" - 24")	1100mm (3' 8")
600mm and bigger (24" plus)	1200mm (4')

Valves

- General Purpose Valve
- Air Valve
- Pressure Control Valve
- Customer Valve

Hydrants

- Single Hydrant

Meters

- Meter

End Items

Symbol indicating what happens at the end of a water main.

- Blank Flange
- Capped End
- Emptying Pit
- Undefined End
- Manifold
- Customer Supply
- Fire Supply

Operational Sites

- Booster Station
- Other
- Other (Proposed)
- Pumping Station
- Service Reservoir
- Shaft Inspection
- Treatment Works
- Unknown
- Water Tower

Other Symbols

- Data Logger
- Casement:** Ducts may contain high voltage cables. Please check with Thames Water.

Other Water Pipes (Not Operated or Maintained by Thames Water)

- Other Water Company Main:** Occasionally other water company water pipes may overlap the border of our clean water coverage area. These mains are denoted in purple and in most cases have the owner of the pipe displayed along them.
- Private Main:** Indicates that the water main in question is not owned by Thames Water. These mains normally have text associated with them indicating the diameter and owner of the pipe.

ElliottWood

• Fitzrovia The Building Society 55 Whitfield Street London W1T 4AH	• Wimbledon The Building Society 241 The Broadway London SW19 1SD	• Nottingham St Mary's Hall 17 Barker Gate Nottingham NG1 1JU
• +44 (0) 20-7499-5888	• +44 (0) 20-8544-0033	• +44 (0) 1158-223-148

- info@elliottwood.co.uk
- elliottwood.co.uk

