



NOTES:
All construction to comply with all relevant and current building regulations.
For building regulation compliance please refer building regulation/ structural engineers drawing.
All Dimensions to be measured by contractor on site prior to construction. Not for construction.

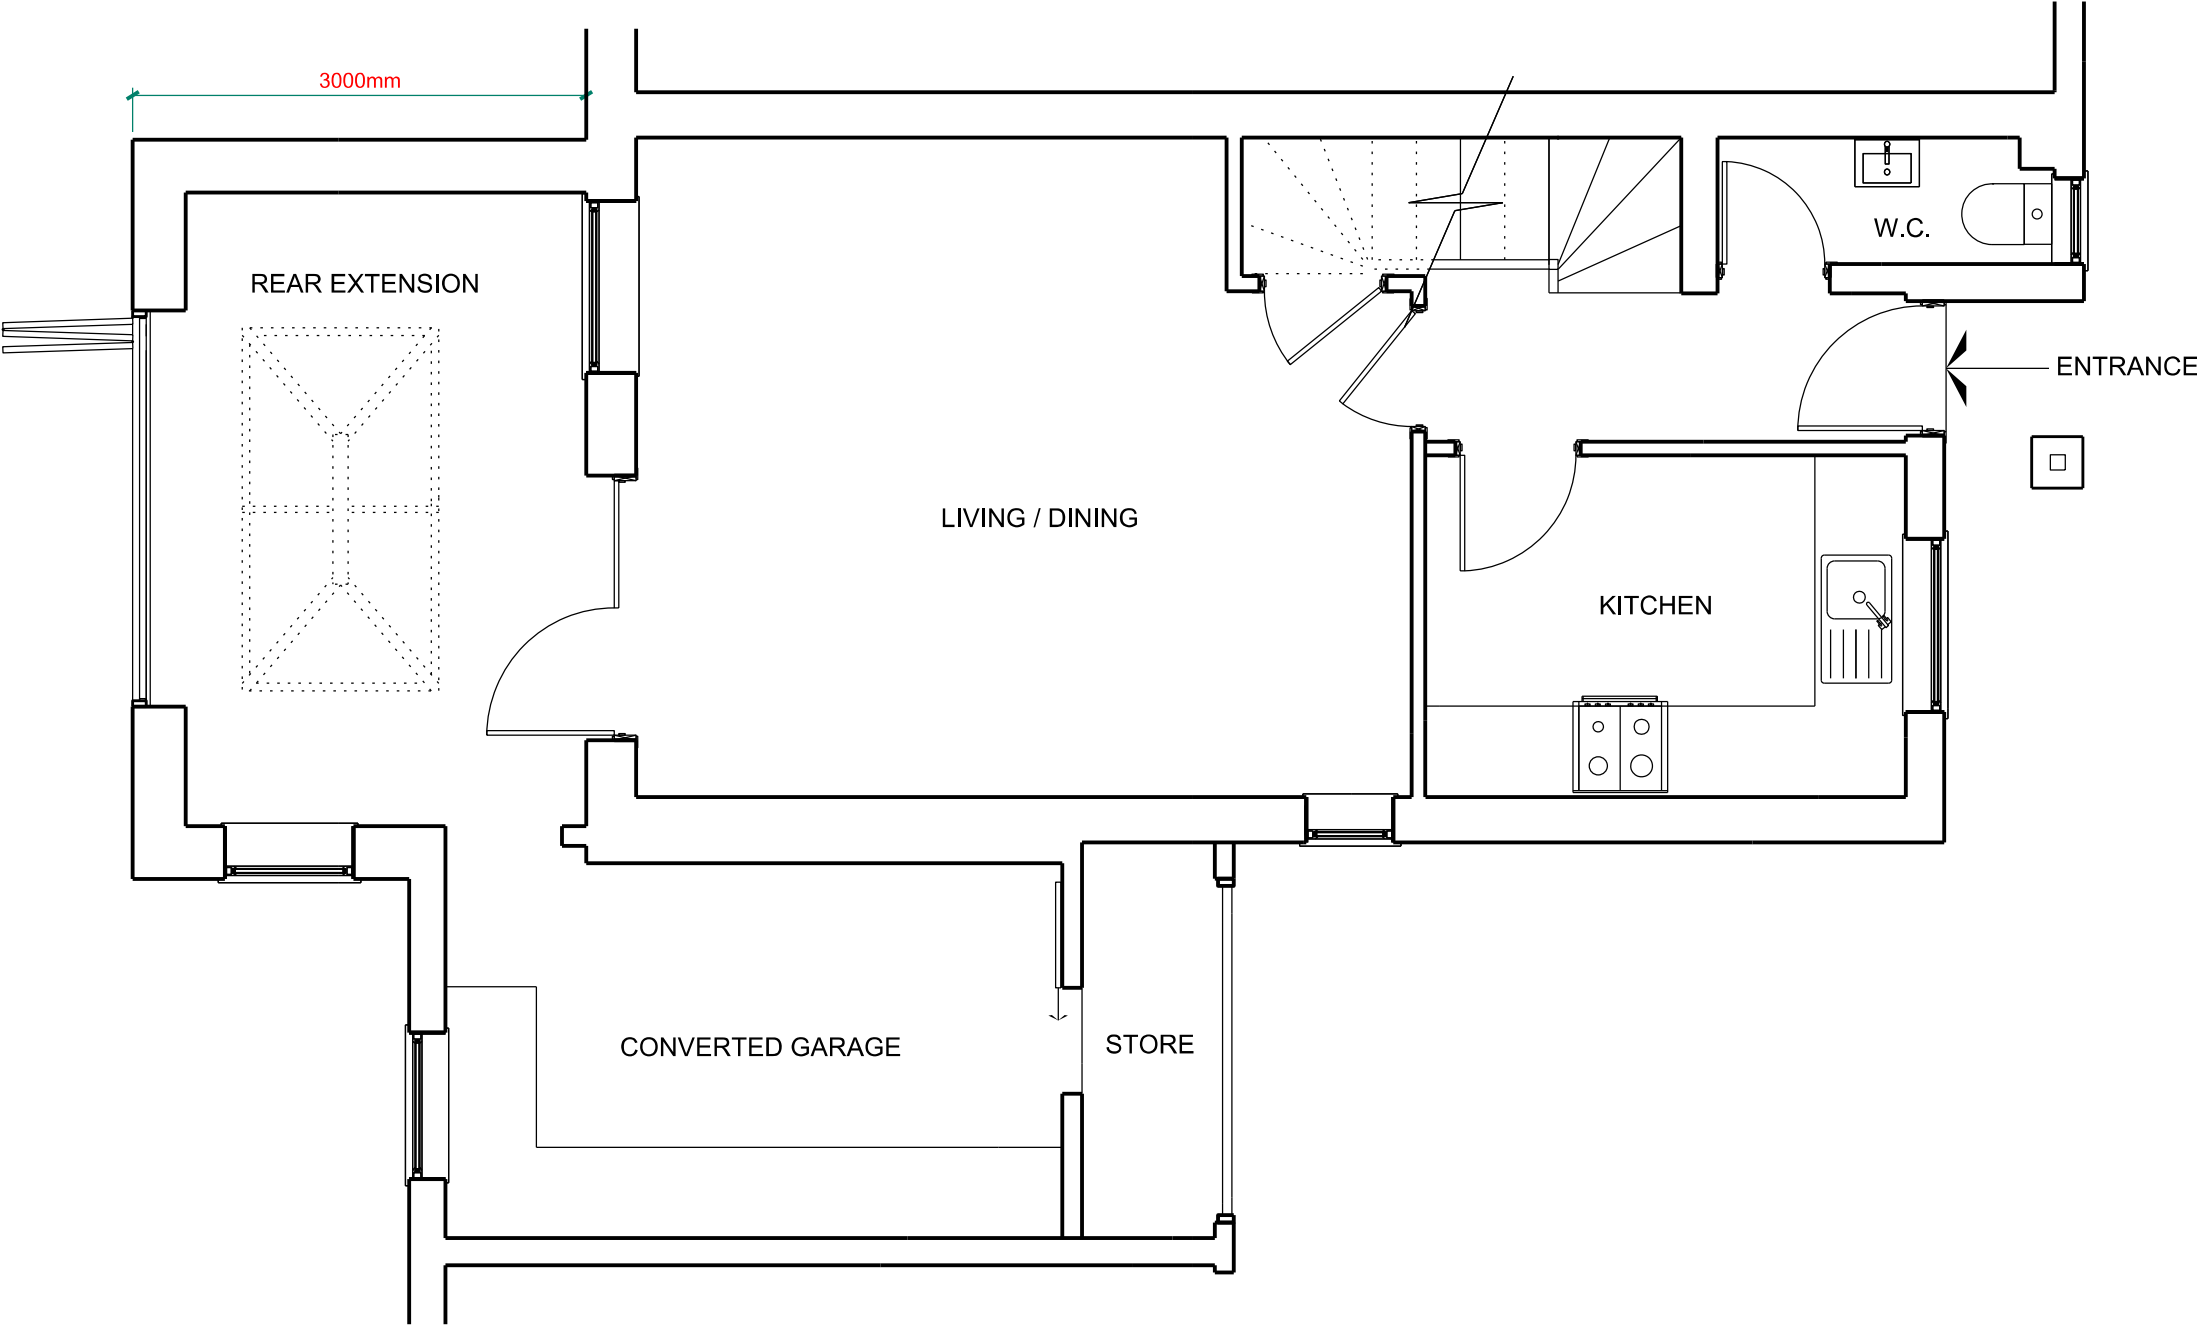

01 AS-BUILT GROUND FLOOR PLAN
SCALE 1:50

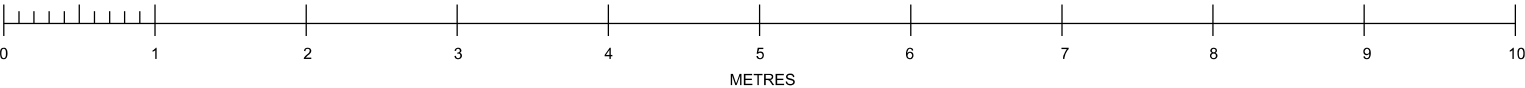

D1	02/08/2025	Planning
REV.	DATE	REASON FOR ISSUE
FAÇADE DESIGN STUDIO		
Boundary House Cricket Field Road Uxbridge UB8 1QG www.facadesign.co.uk info@facadesign.co.uk t +44 (0) 7438294487		
Project Address: 31 Amber Close		
Earley		
RG6 7ED		
Project Number: RDK 171025		
Description: Garage conversion		
SCALE: 1:50@A3		
RAM1001		