




Notes:

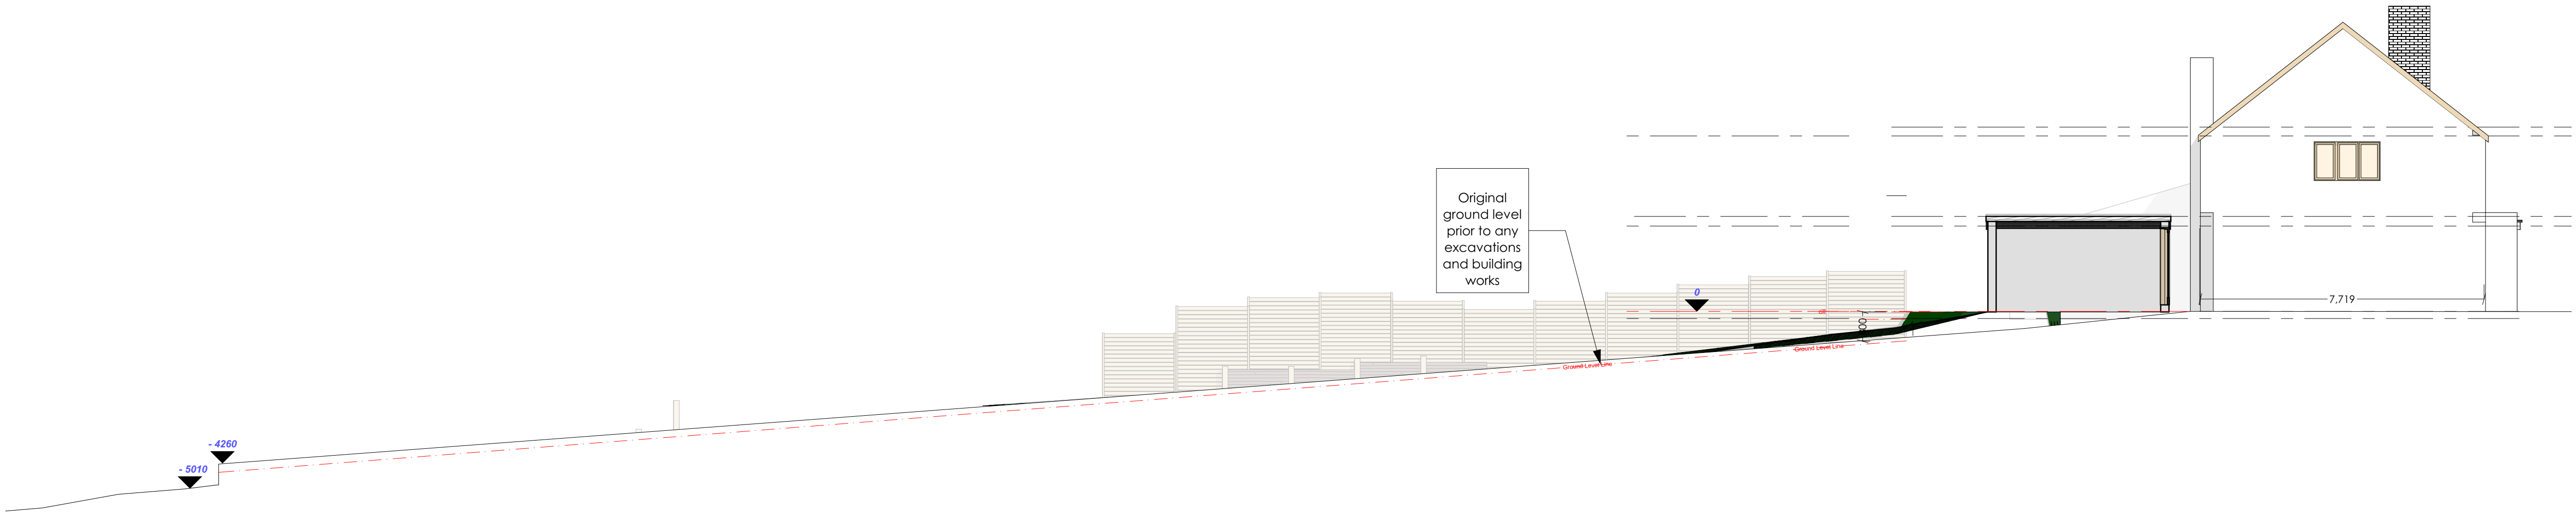

1:100 Existing Elevation - Showing Neighbour 114 Ground Level

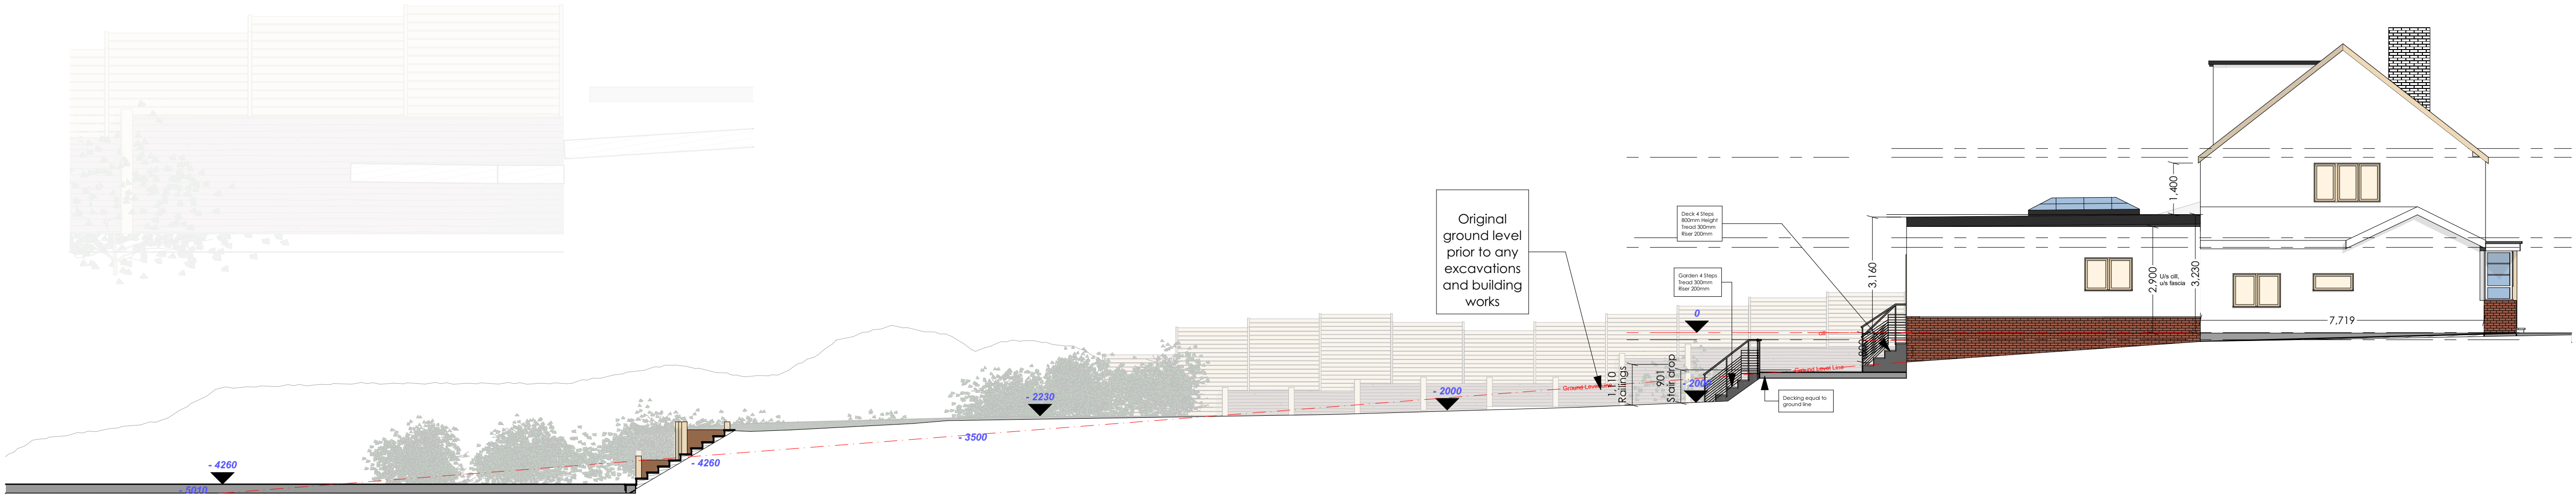

1:100 AS BUILT EXTENSION - Proposed stairs and deck- Showing Neighbour 114 Ground Level

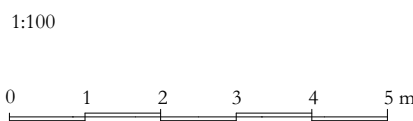

**THE KEEN PARTNERSHIP**  
The Courtyard  
Edinburgh Road  
Reading RG30 2UA  
Tel: 0118 9510 855  
Fax: 0118 9510 866  
chris@keenpartnership.co.uk  
www.keenpartnership.co.uk



Client:

Mr Zahir Butt

Job Title: 112 Silverdale Road, Earley, READING, Berkshire, RG6 7LU

Drawing Title: Neighbour at 114 Ground Level  
REV 07

Drawing Date:

Status:

Decking Application

Issue Date:

Drawn By:

Scale:

21/06/2024

SY

@A1

Job No:

Drawing No:

Rev:

9105

9126 - 221380 - 106

REV 06