


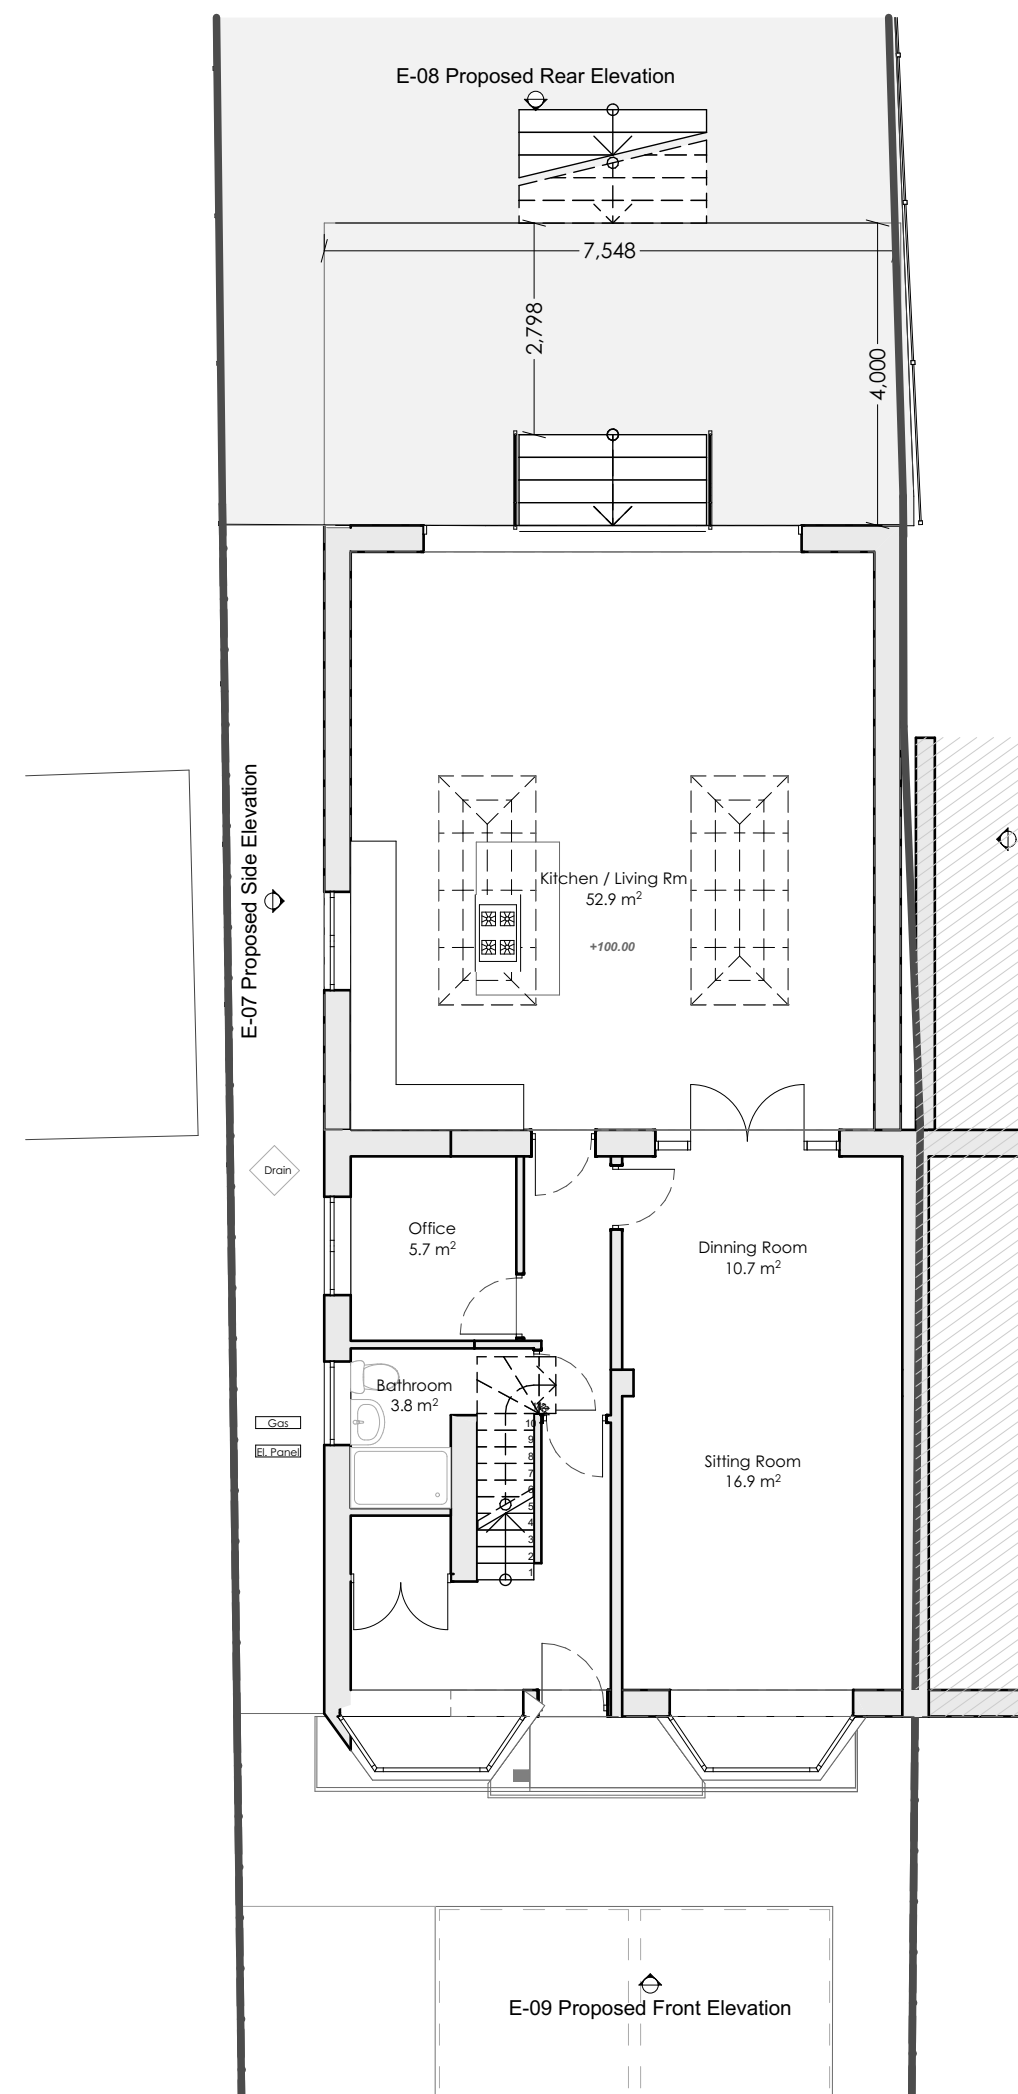


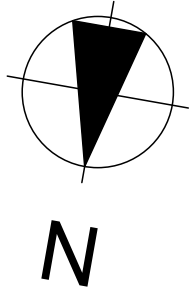

1:100
AS BUILT EXTENSION - Proposed stairs and deck Ground Floor Plan

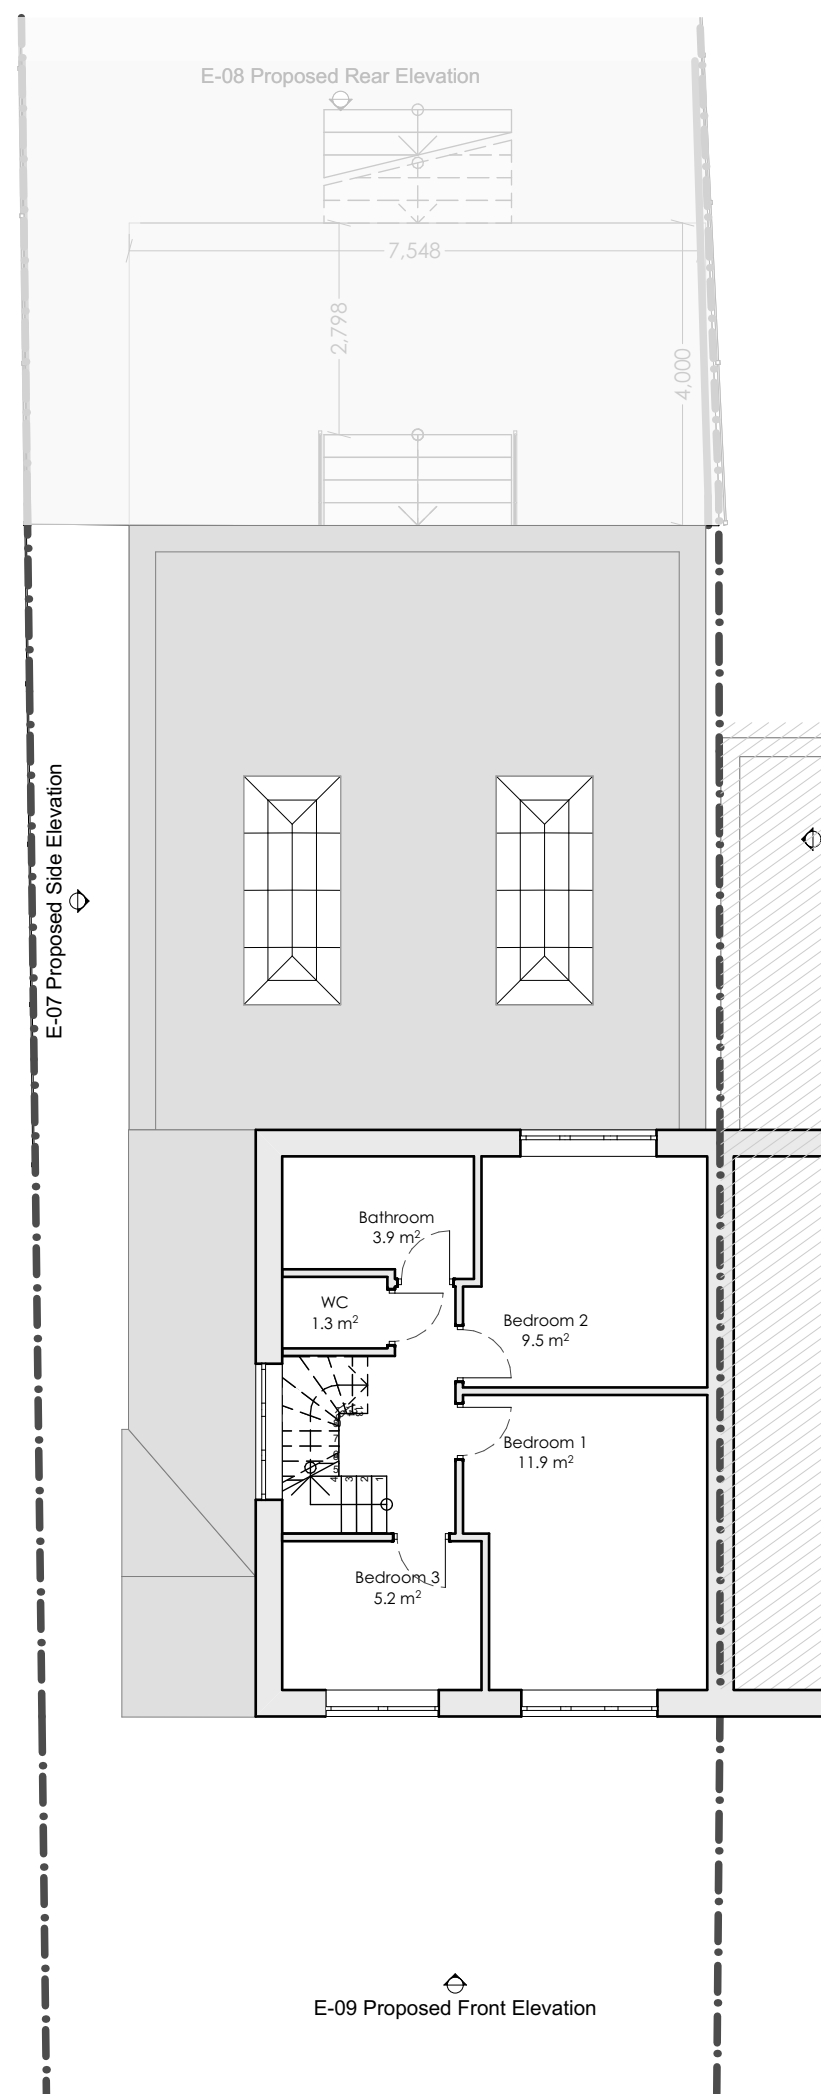



1:100
AS BUILT EXTENSION - Proposed stairs and deck - First Floor Plan

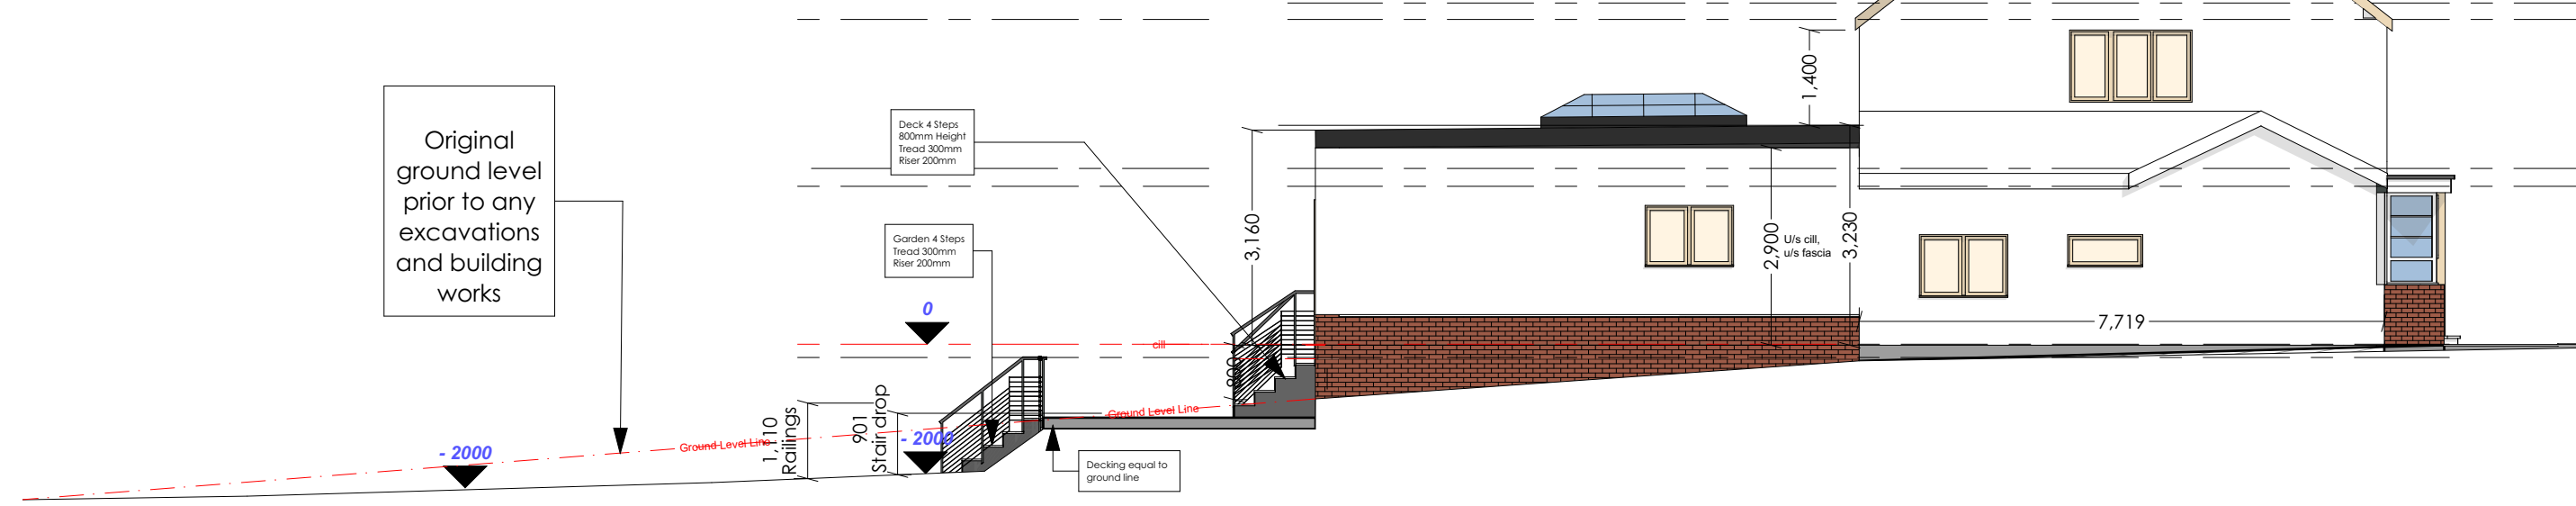

1:100
AS BUILT EXTENSION - Proposed stairs and deck - Side Elevation



1:100
AS BUILT EXTENSION - Proposed stairs and deck Rear Elevation

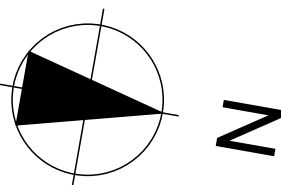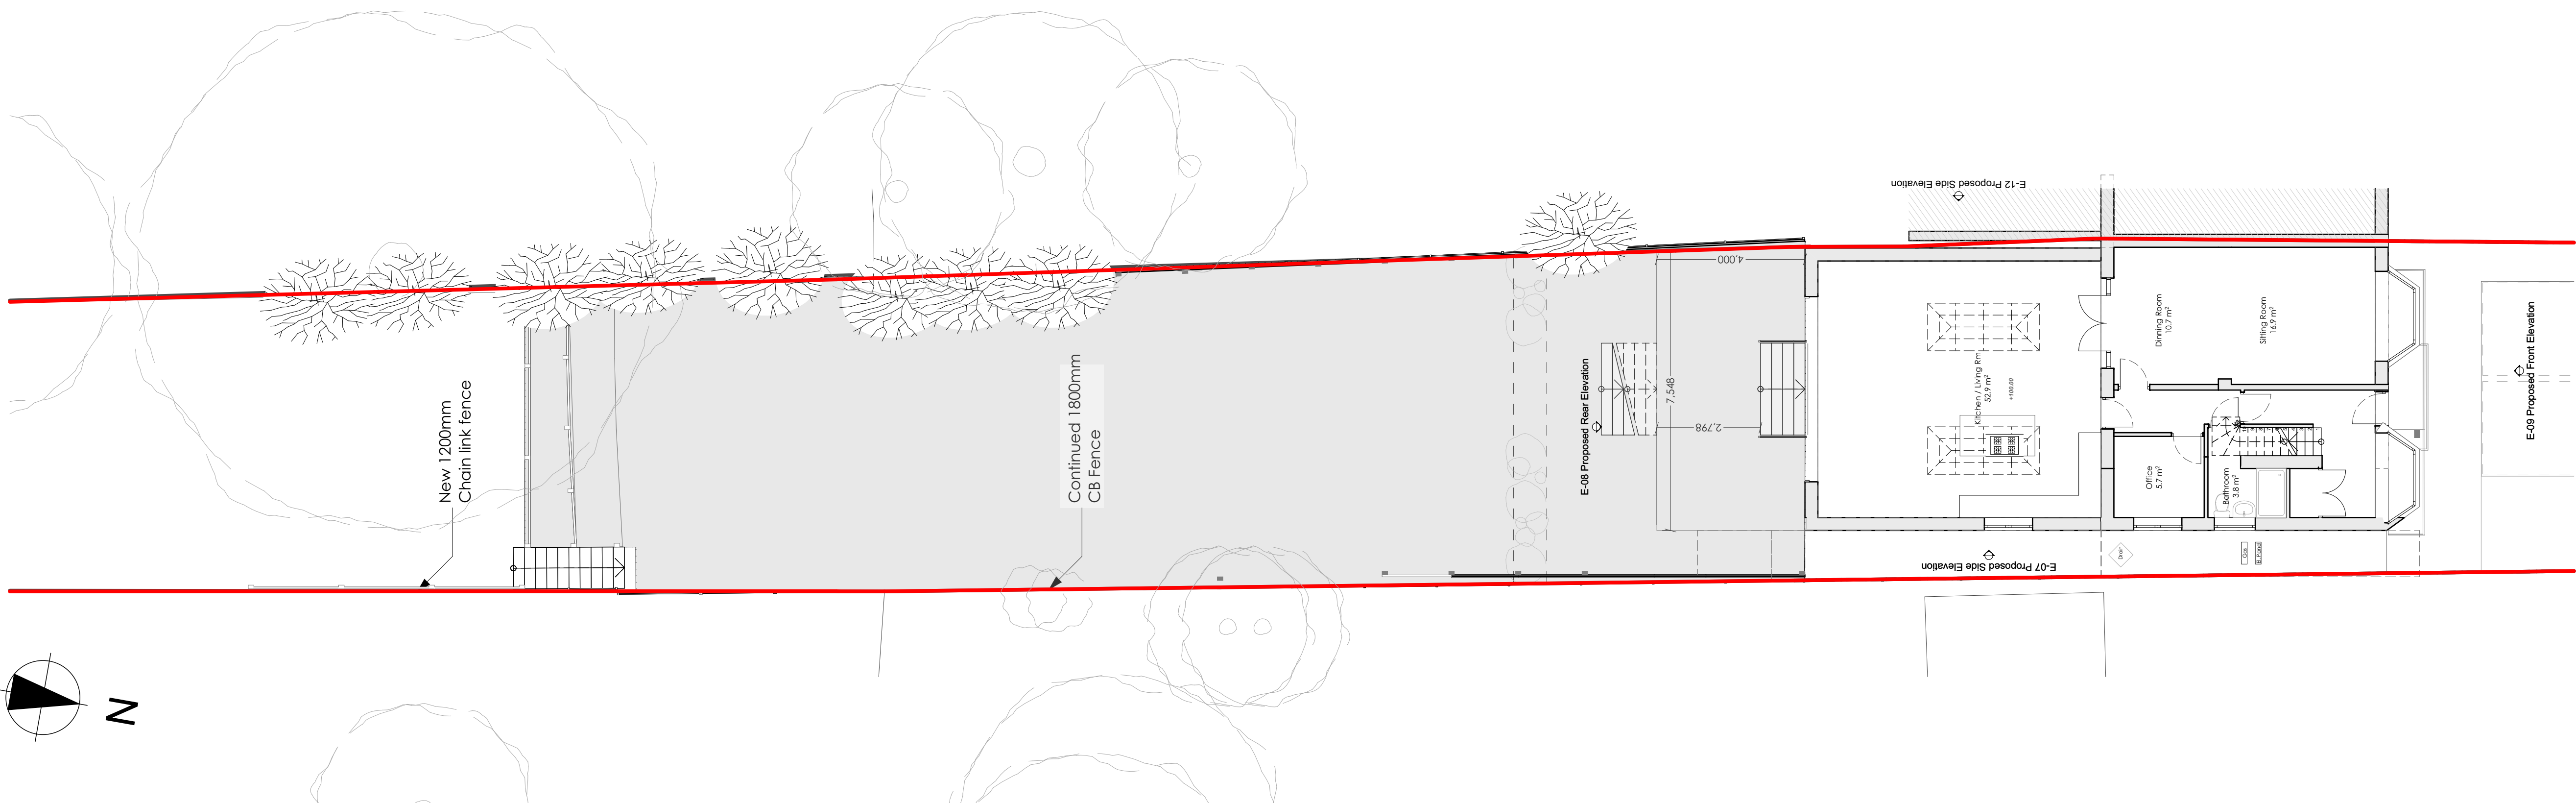

1:100
AS BUILT EXTENSION - Proposed stairs and deck - Site Plan

© This drawing remains the property of The Keen Partnership and shall not be copied without prior written consent.
All dimensions to be checked on site and any discrepancies to be reported before work commences.

Notes:

1:100
0 1 2 3 4 5 m

THE KEEN PARTNERSHIP
The Courtyard
Edinburgh Road
Reading RG30 2UA
Tel: 0118 9510 855
Fax: 0118 9510 866
chris@keenpartnership.co.uk
www.keenpartnership.co.uk

cabe
chartered association
of building engineers
RICS

Client: **Mr Zahir Butt**

Job Title: **112 Silverdale Road, Earley, READING, Berkshire, RG6 7LU**

Drawing Title: **AS BUILT EXTENSION - Proposed stairs and deck - Site Plan REV 08**

Drawing Date:	Status:
Issue Date:	Decking Application
21/06/2024	Drawn By: SY Scale: @A1
Job No: 9105	Drawing No: 9126 - 221380 - 102 Rev: REV 07