




Notes:

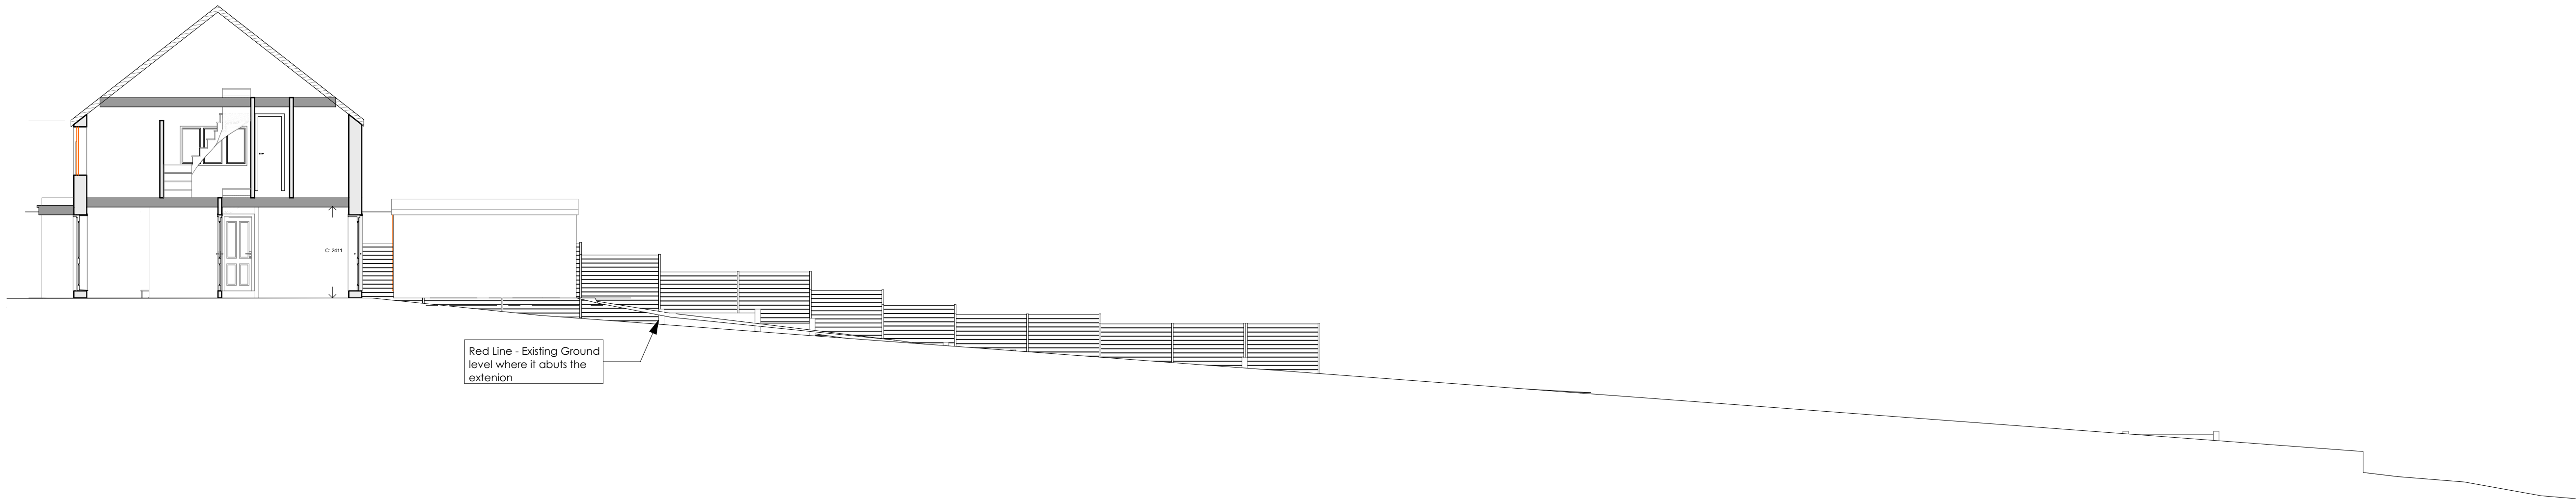

1:100 AS BUILT Section showing neighbours at 110 Ground Level

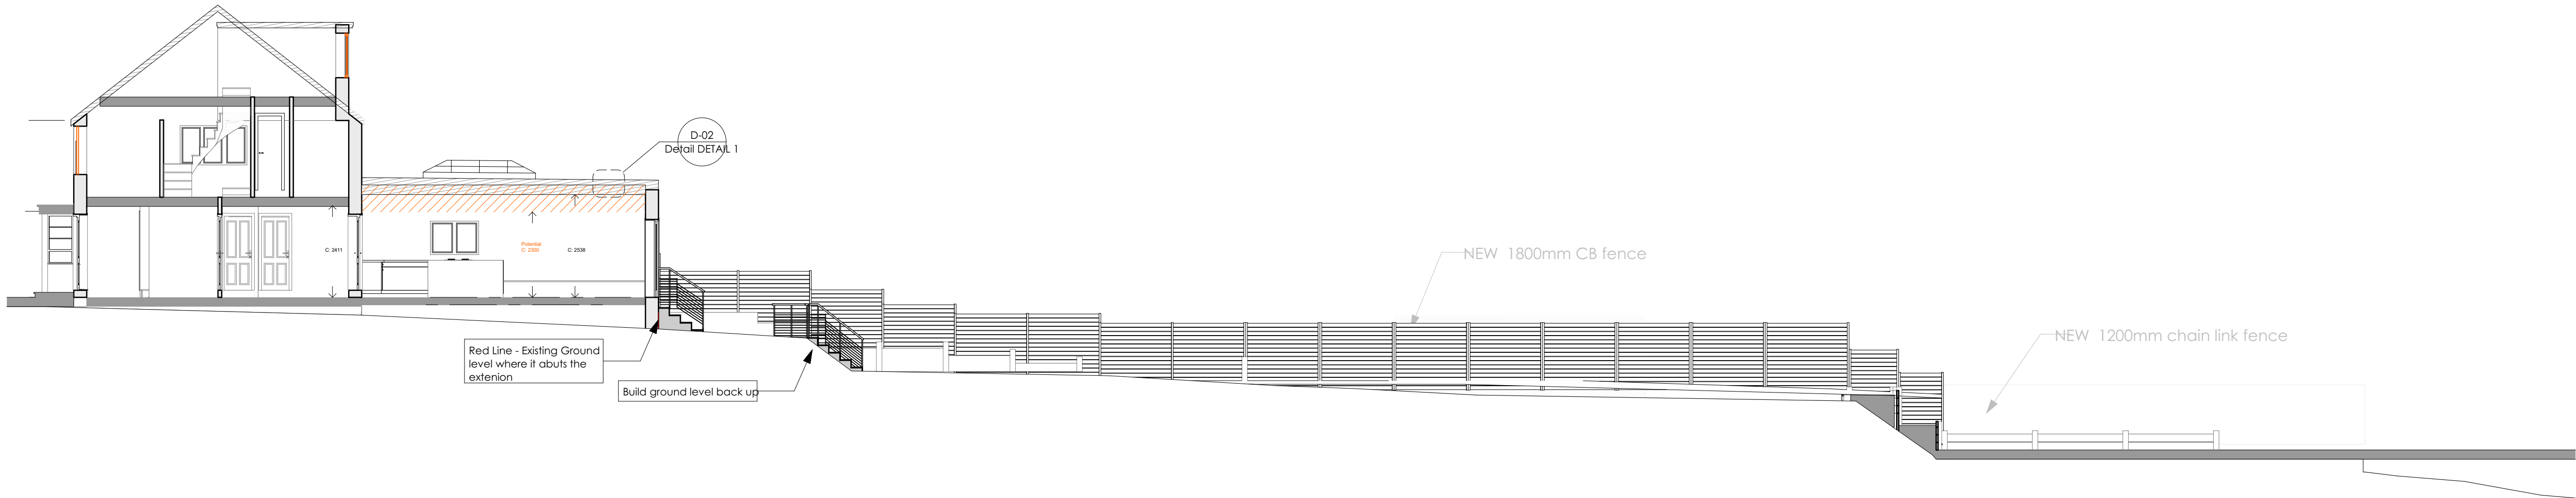

1:100 AS BUILT EXTENSION - Proposed stairs and deck - Section showing neighbours at 110 Ground Level

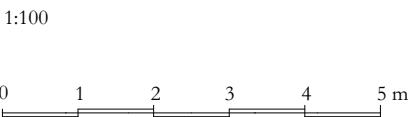

THE KEEN PARTNERSHIP
The Courtyard
Edinburgh Road
Reading RG30 2UA
Tel: 0118 9510 855
Fax: 0118 9510 856
chris@keenpartnership.co.uk
www.keenpartnership.co.uk



Client:

Mr Zahir Butt

Job Title: **112 Silverdale Road, Earley, READING, Berkshire, RG6 7LU**

Drawing Title: **Neighbour at 110 Ground Level REV 07**

Drawing Date: Status: **Decking Application**

Issue Date: **21/06/2024** Drawn By: **SY** Scale: **@A1**

Job No: **9105** Drawing No: **9126 - 221380 - 107** Rev: **REV 06**