






FRONT ELEVATION – As Built
Scale 1:100

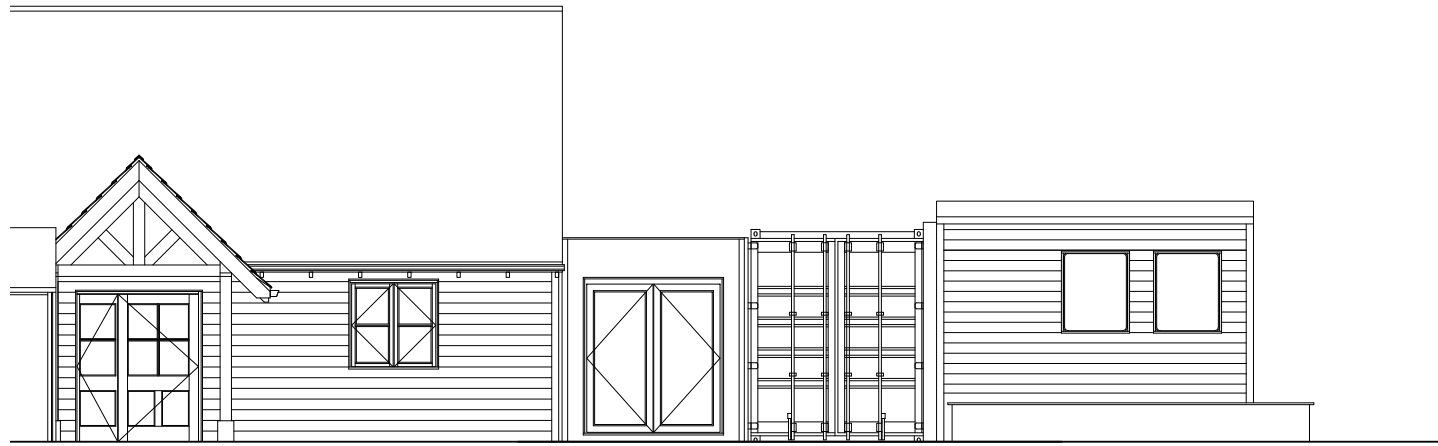


SIDE ELEVATION – As Built
Scale 1:100

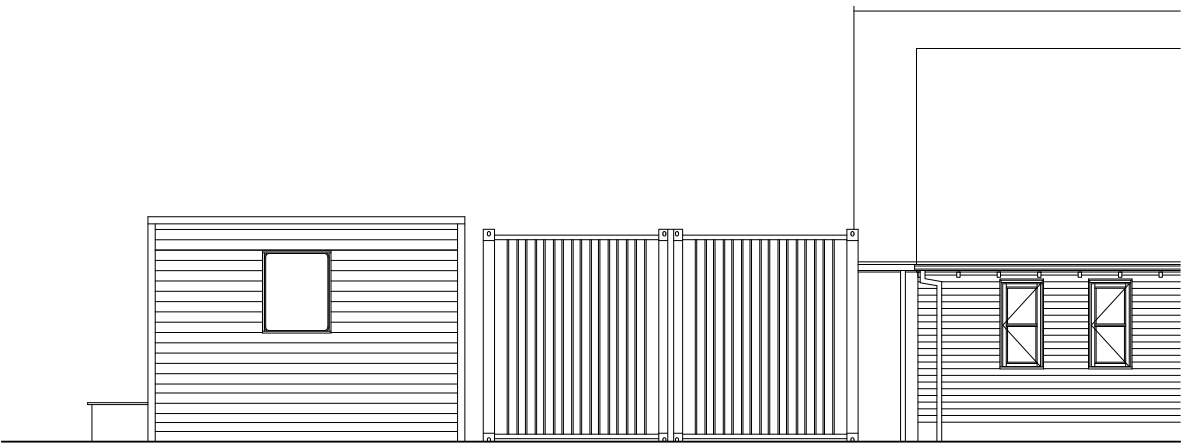


REAR ELEVATION – As Built
Scale 1:100

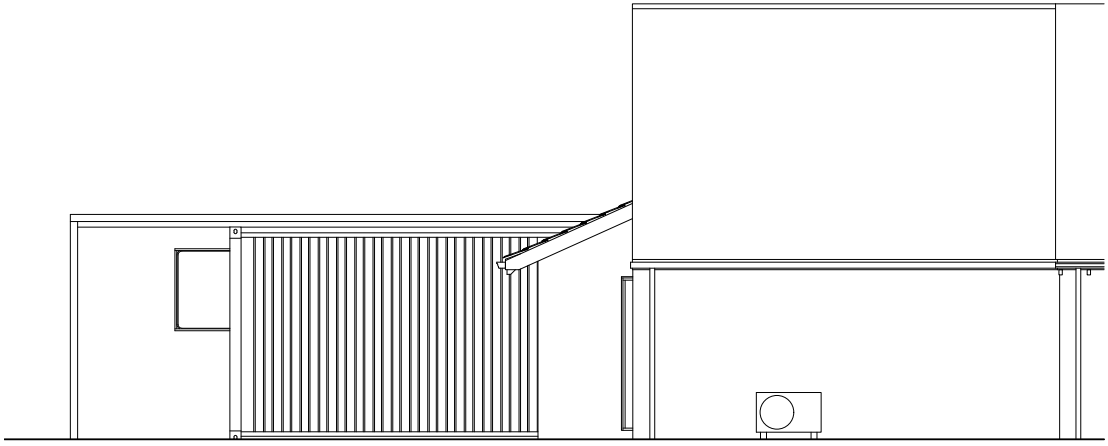

SIDE ELEVATION – As Built
Scale 1:100

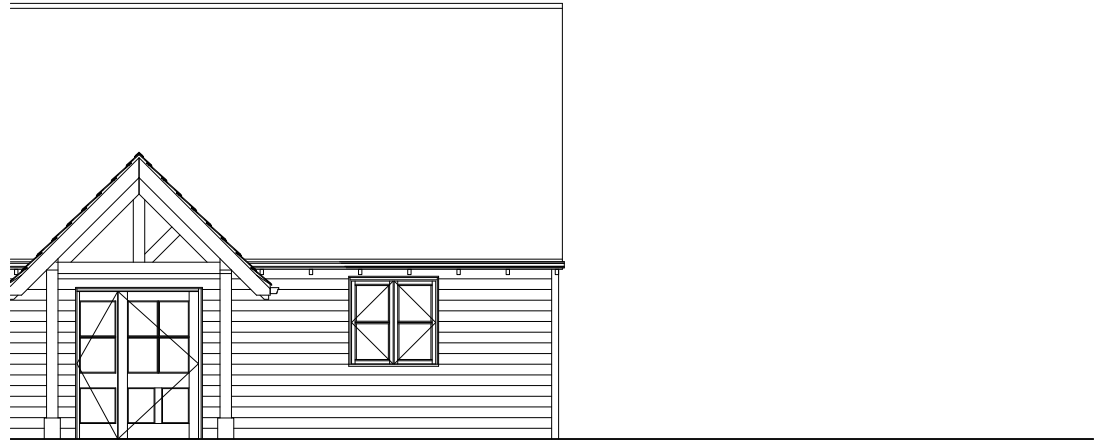


FRONT ELEVATION – As Original
Scale 1:100

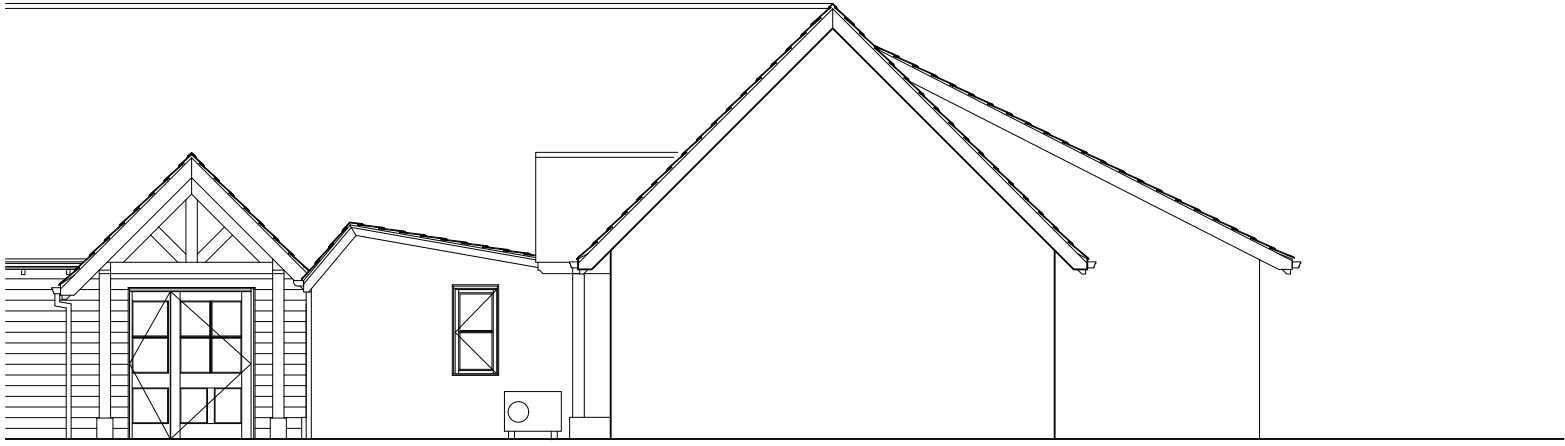


SIDE ELEVATION – As Original
Scale 1:100




REAR ELEVATION – As Original
Scale 1:100

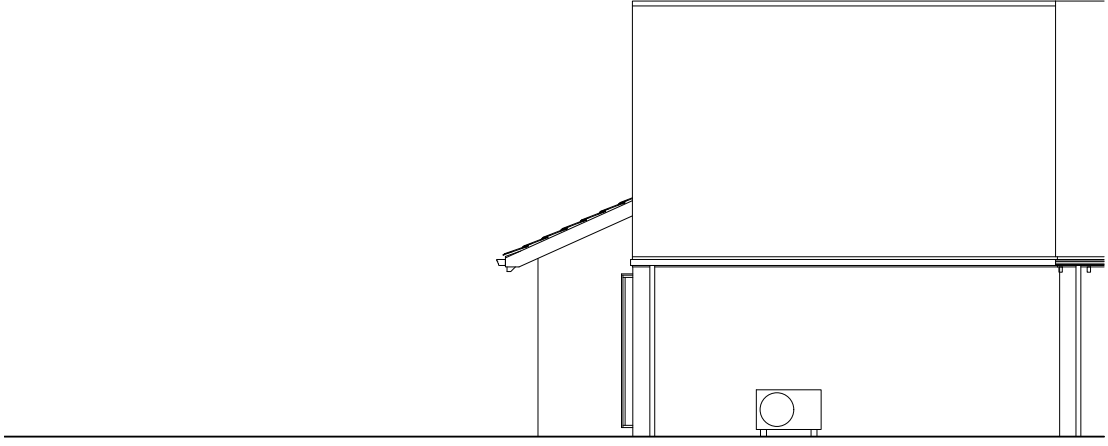



SIDE ELEVATION – As Original
Scale 1:100

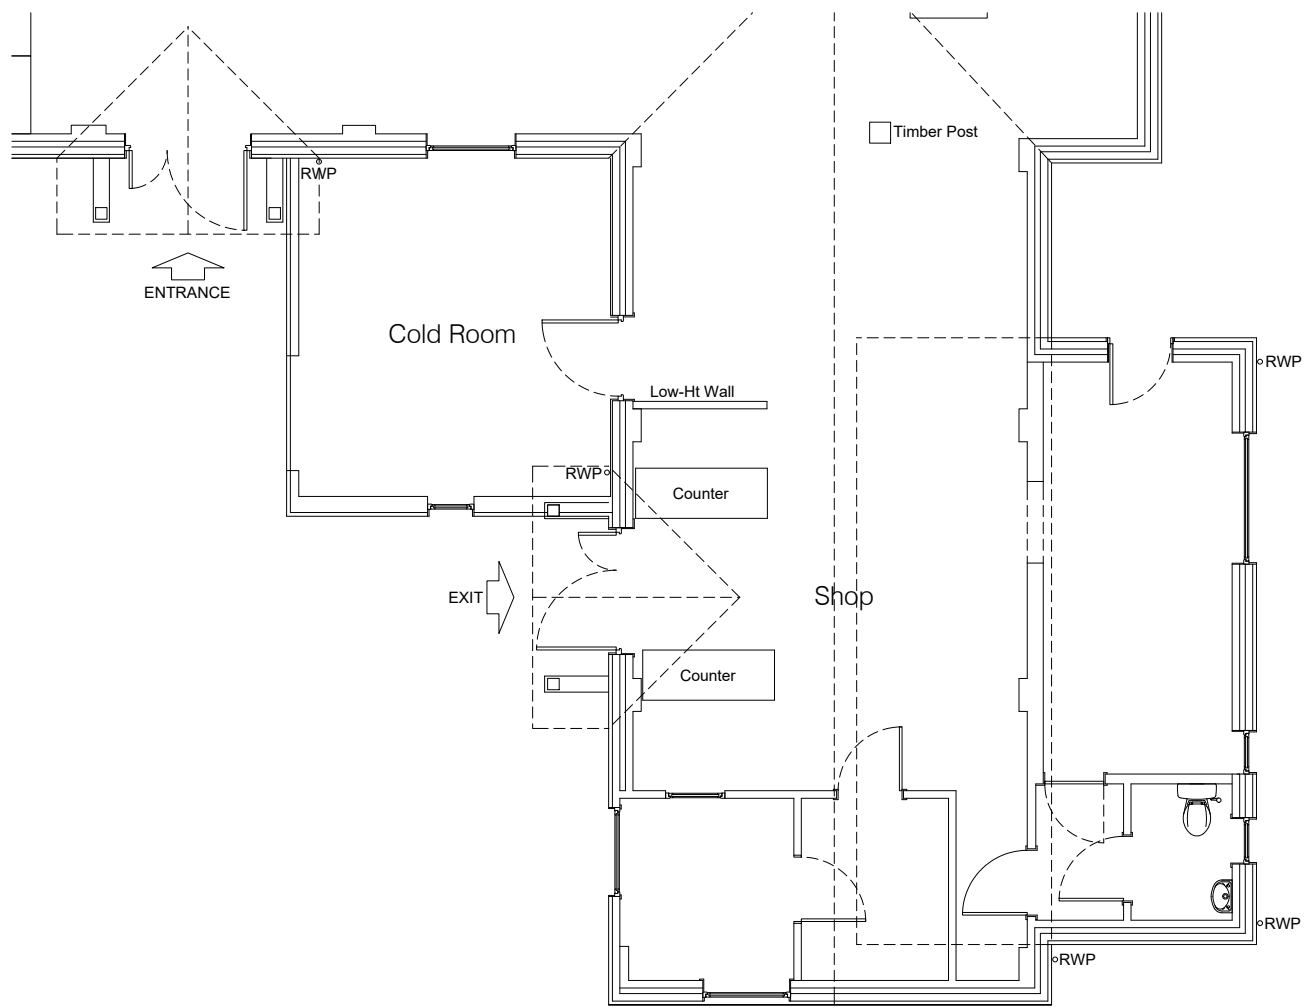

GROUND FLOOR PLAN – As Original
Scale 1:50

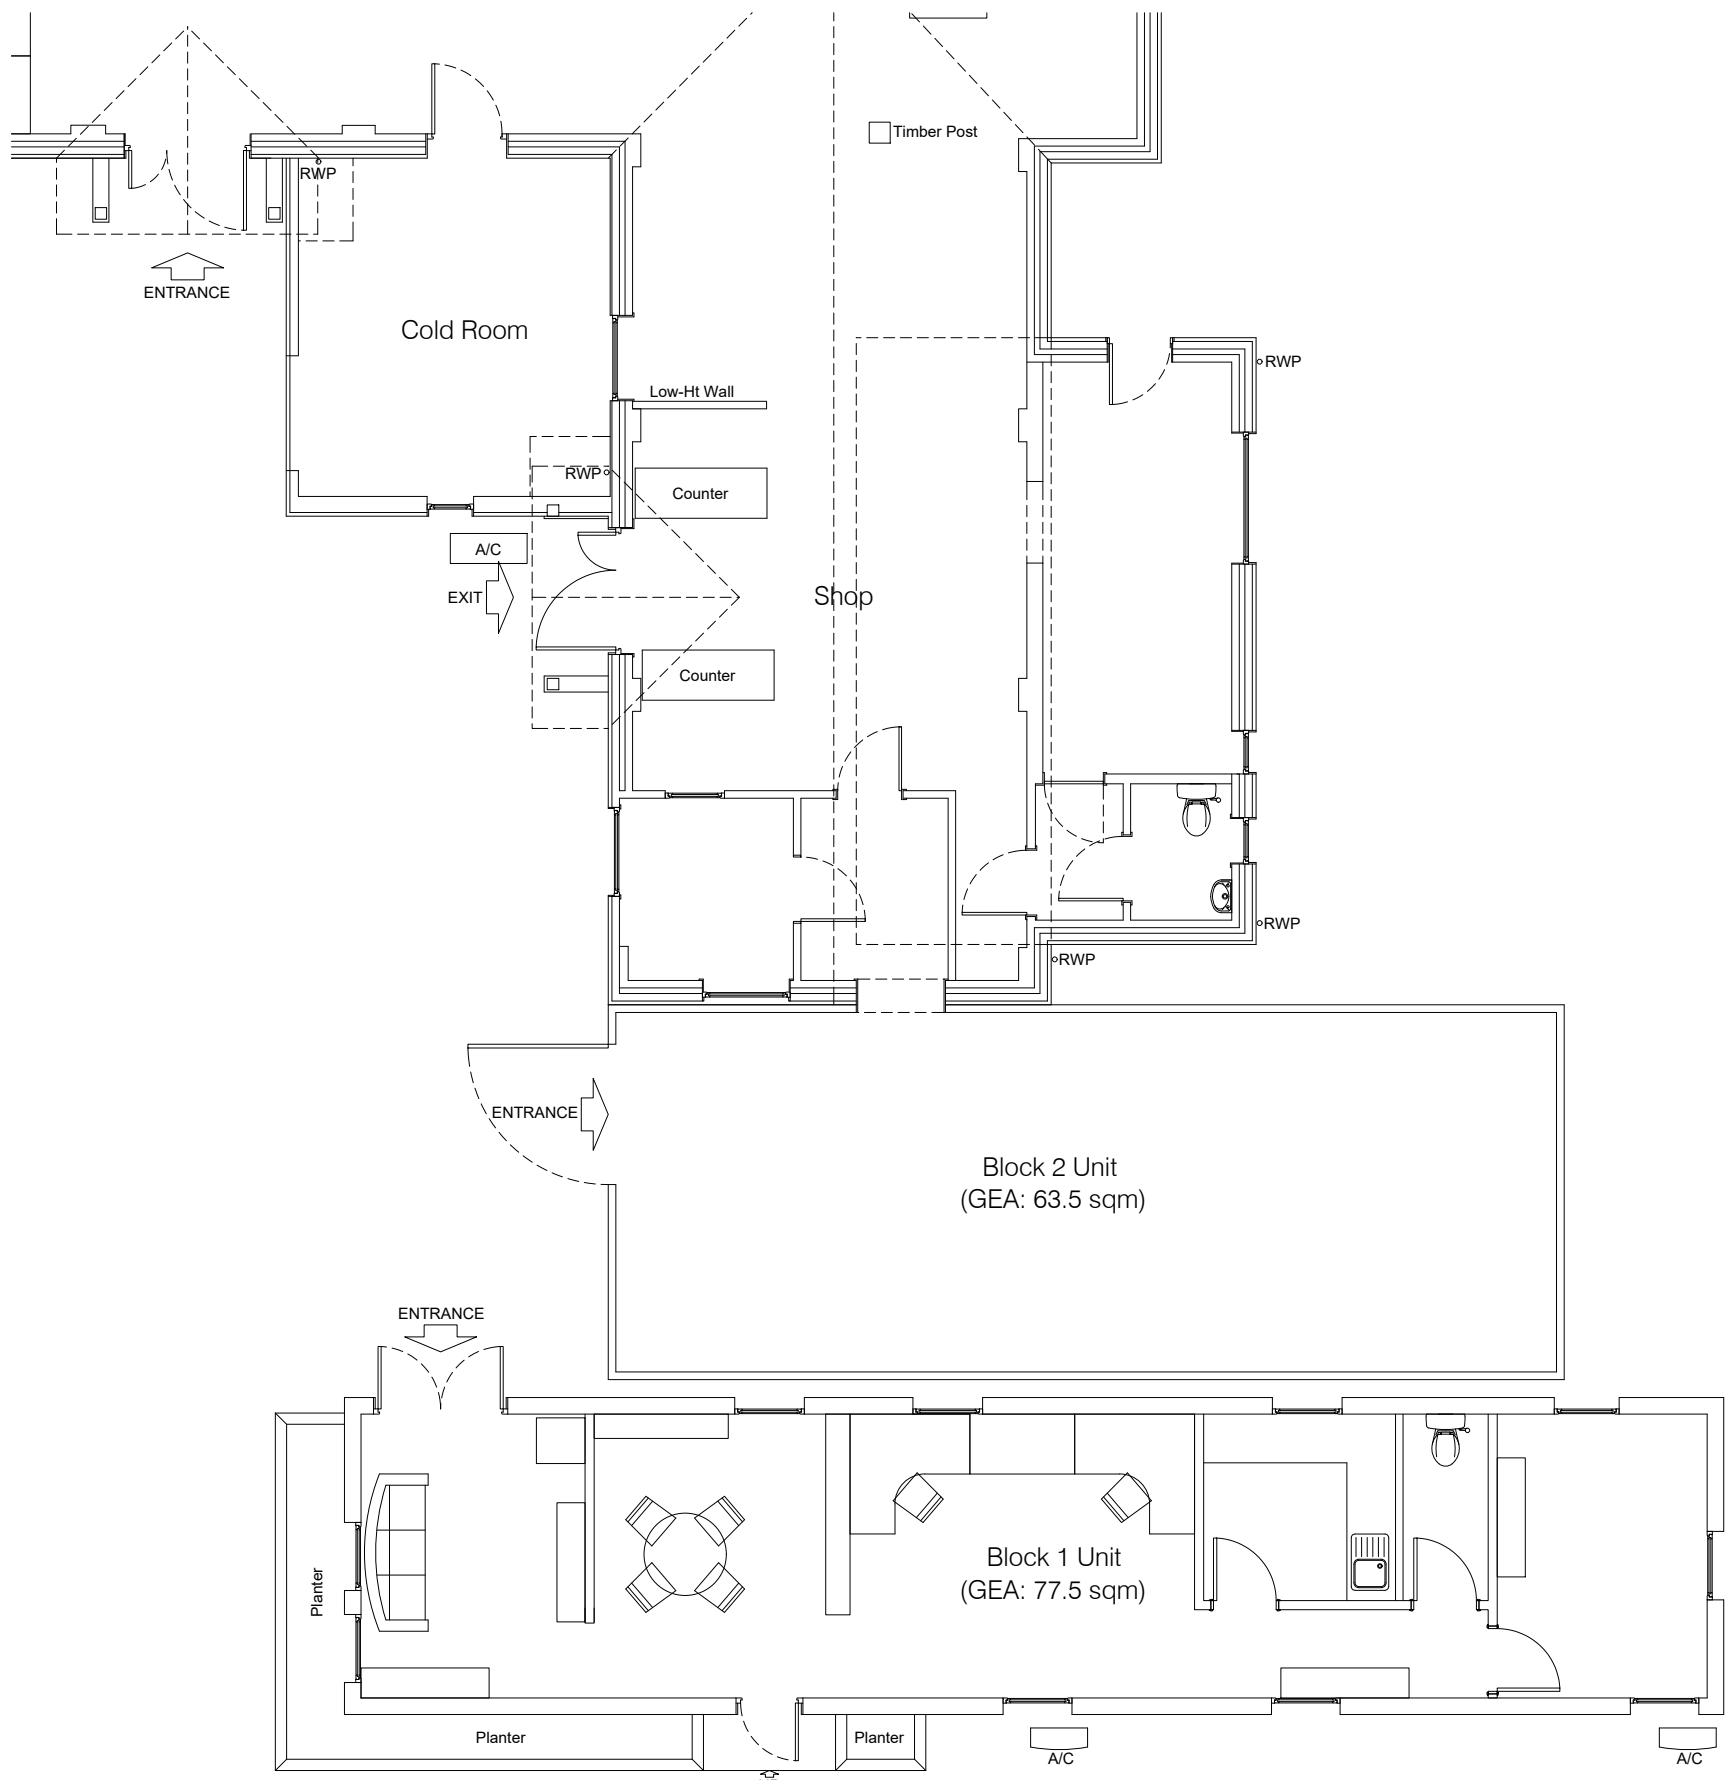

GROUND FLOOR PLAN – As Built
Scale 1:50

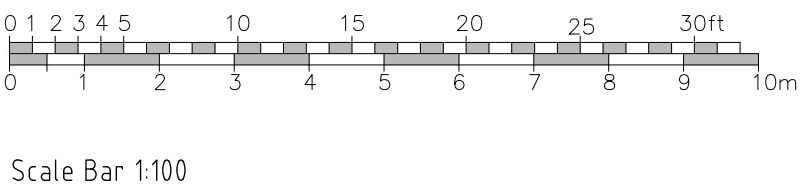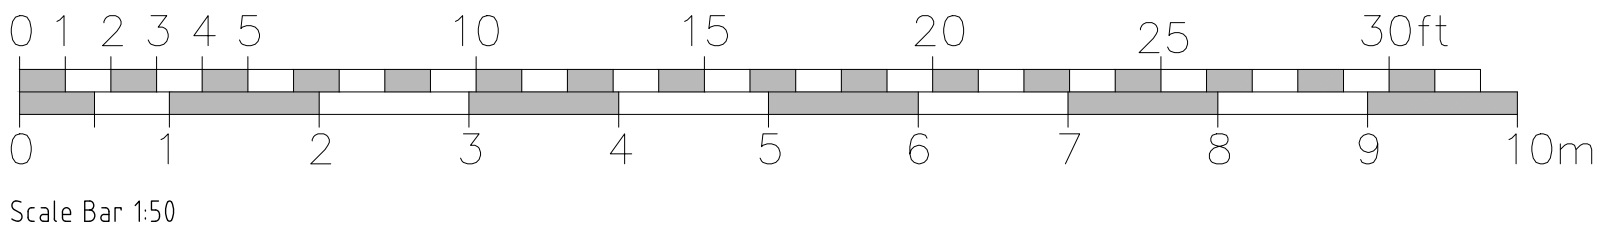

Rev	Description	Date	Initials
Status			
HOLTHAM+NEWMAN ARCHITECTS The Design Studio, Lockey Farm, Sindlesham Road, Arborfield, Reading, Berkshire RG2 9JH T: 07971 316499 E: hello@hnarchitects.co.uk			
Project: - Lockey Farm Sindlesham Road, Arborfield Reading RG2 9JH			
Client Graham Adams			
Drawing Title: Ground Floor General Arrangement Plans Inc. External Elevations Denoting Blocks 1 and 2 As Original and As Built			
Scale:	Varies @ A1 Dwg. No.:	Rev.:	
	-	2203-P123	
Drawn by:	DH	P1	
Date:	Dec 2022		