


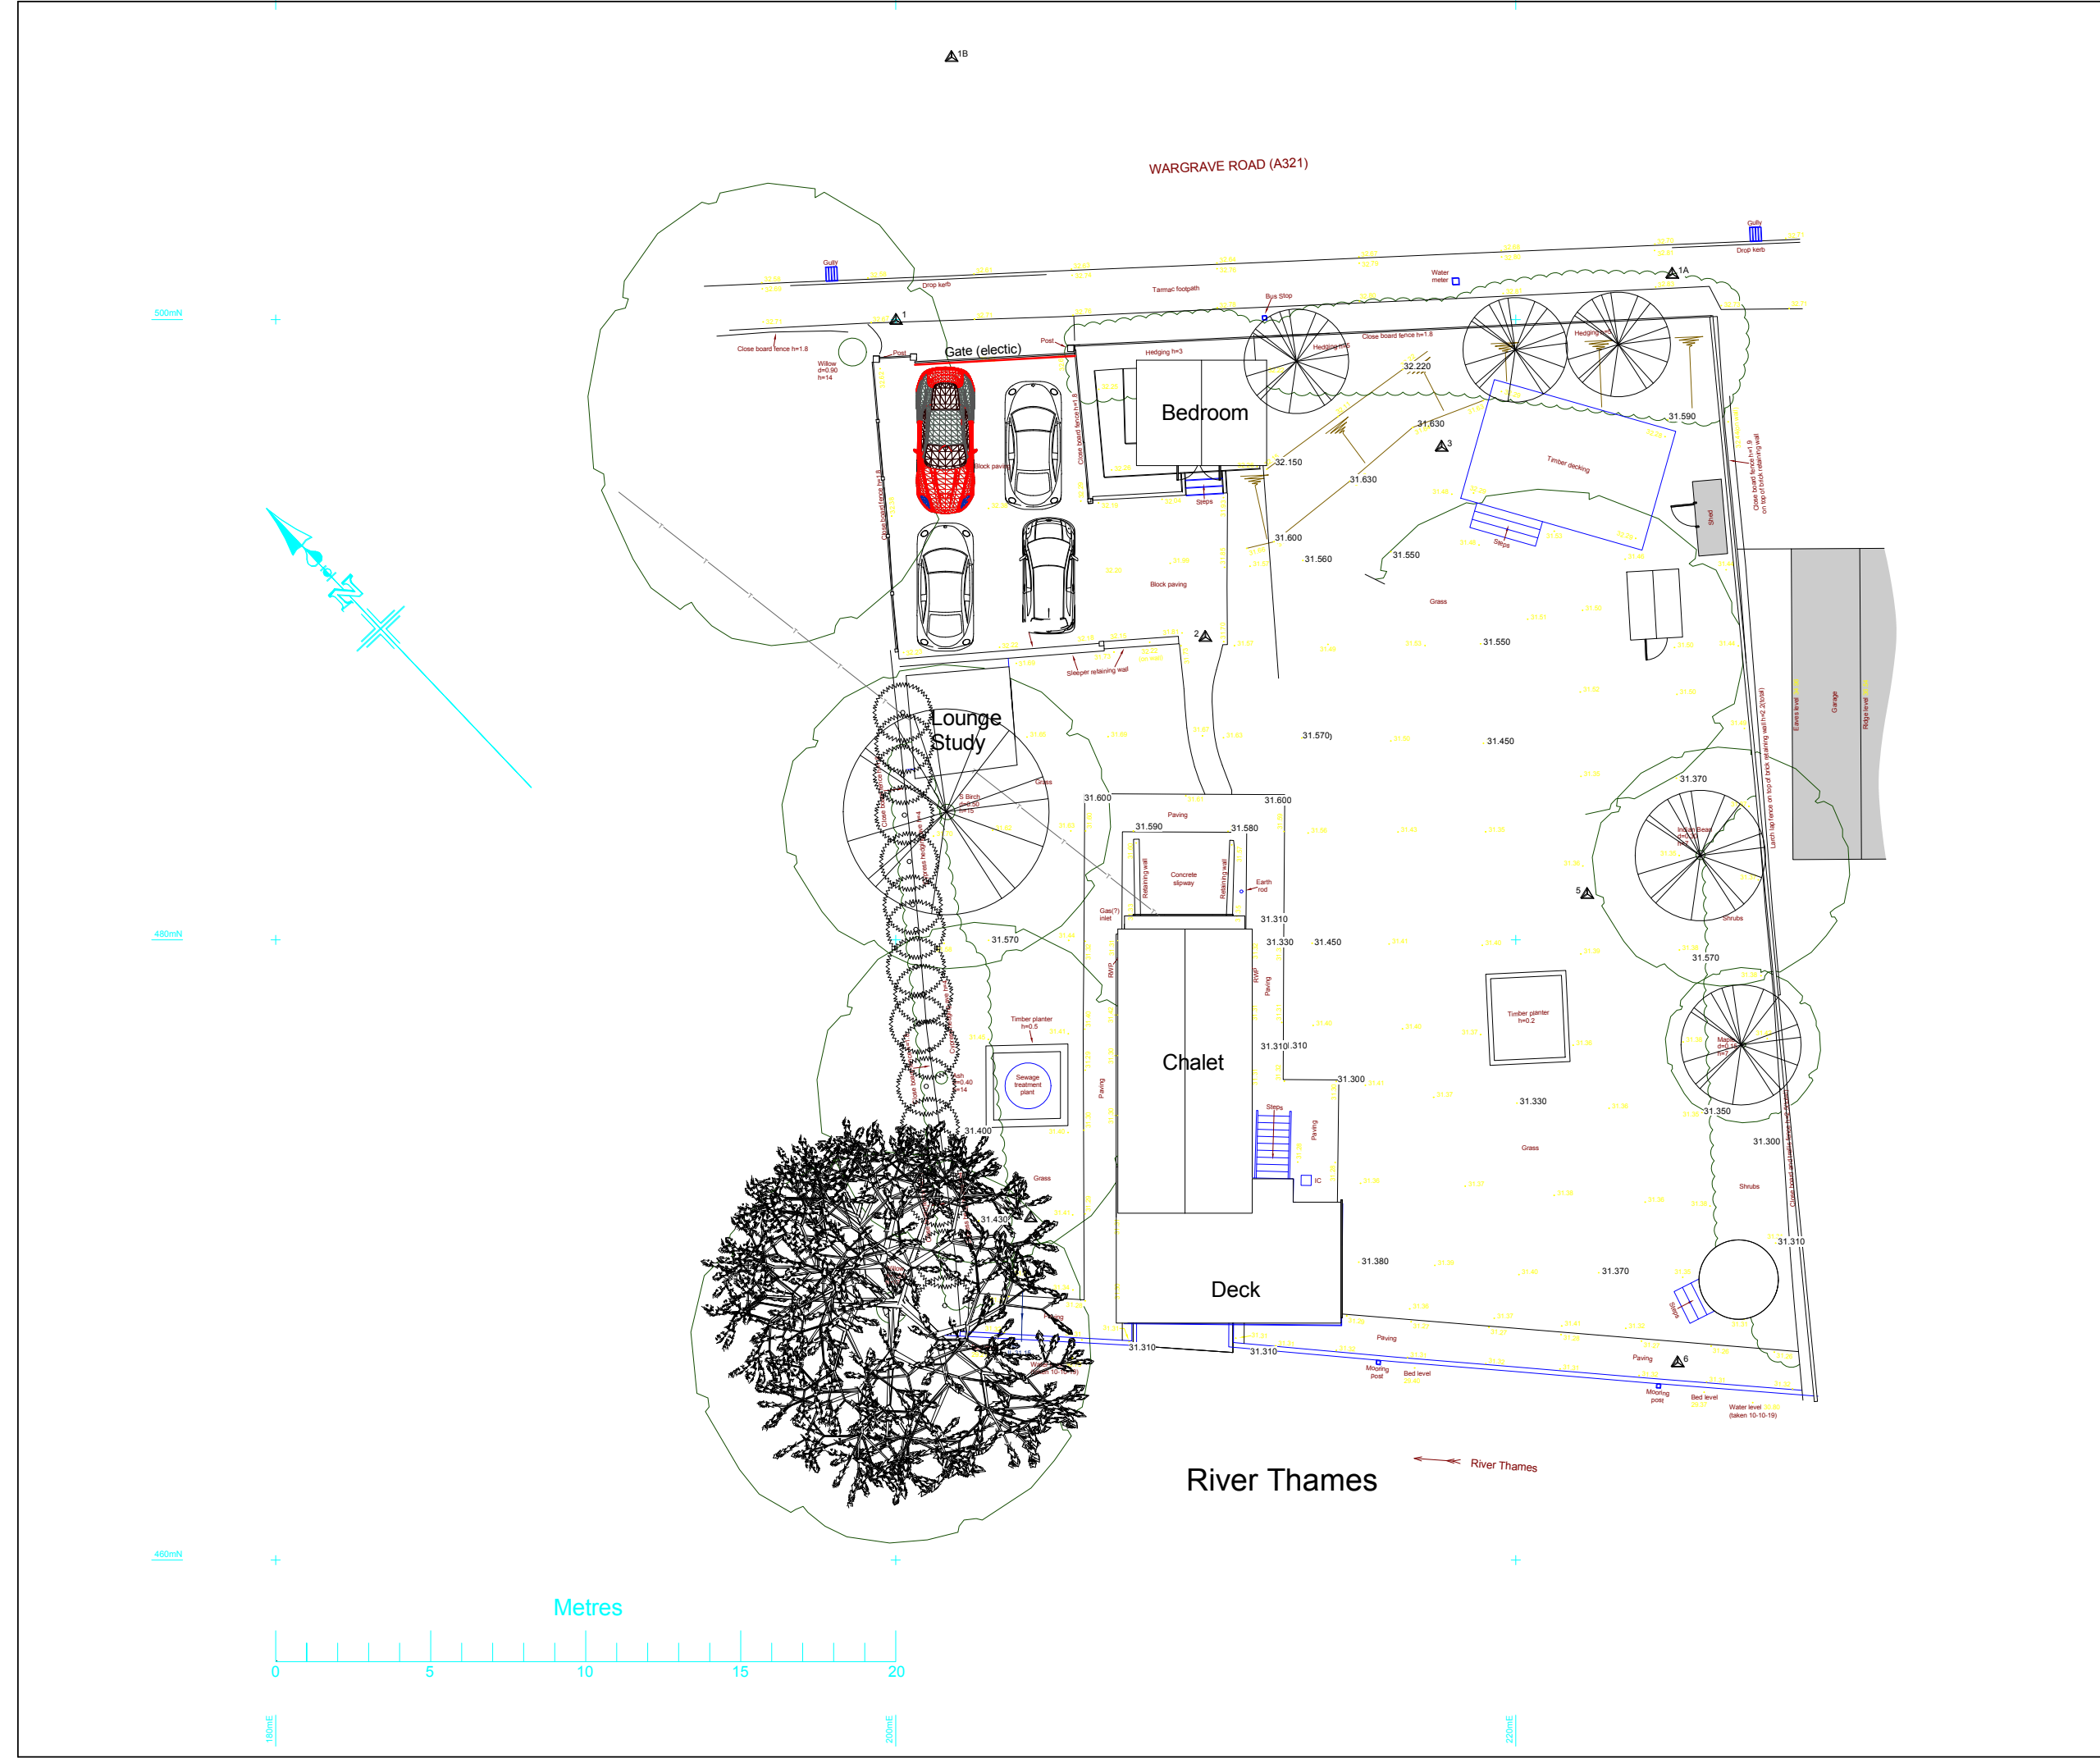

Notes

a. New Gate shown highlighted in red

Secundus
Wargrave Road
Remenham RG9 3JD

for Mr & Mrs Rydzinski
Planning application
Entrance Gate
As constructed

Scale at A3 1 : 200
Drg.No 293-02a

GIULIANI ARCHITECTS
HENLEY ON THAMES RG9 1ET UK
Email: architects@giuliani.co.uk
Website: www.giuliani.co.uk
Tel: 0044 1491 572601