


Elevation Plan 261611 v5



Pre-existing

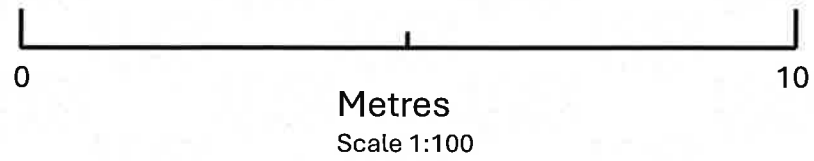


Front elevation




Side elevation

As Built

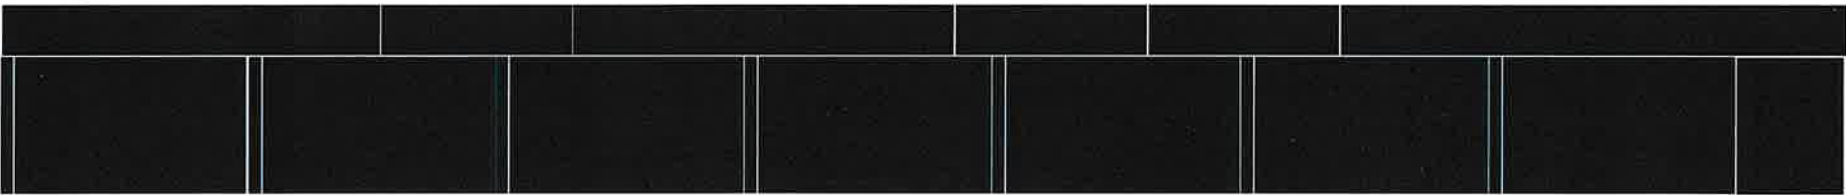

Front elevation

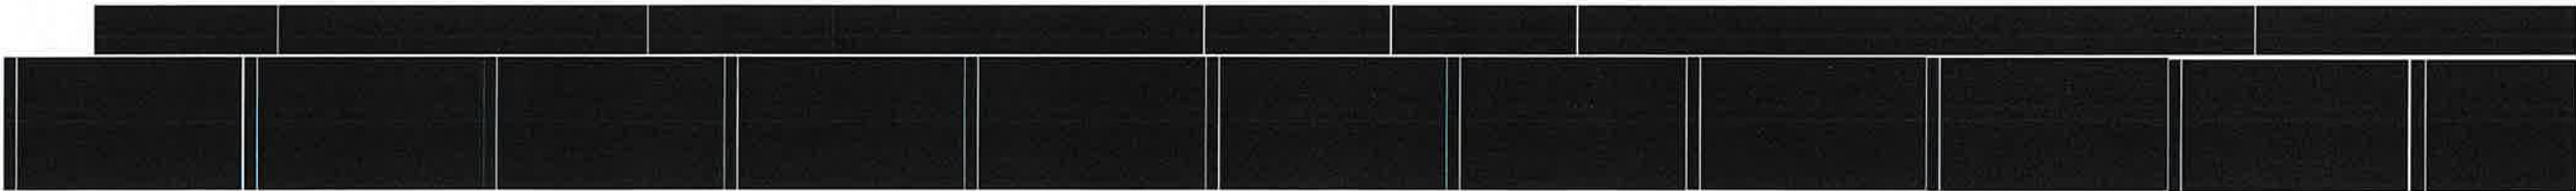

Side elevation