

Rev'd To reflect as built on site.
Rev'd Stud wall added.
REV'D: STUD WALLS
BUILT ADDED

1/1 Copyright

**WILDER
ASSOCIATES**
Architects & Designers

2 Mill Lane
Wallingford
Oxon
OX10 0DU
Tel & Fax
01491 832572
E Mail
anne@wilder.co.uk

Client
Bob Turner

Job Title
45 Hyde End Lane, Ryesh Green,
Reading
RG7 7EP


Drawing Title

Floor Plans as Built.


Scale
1:100@A3

Date Feb 25
Checked by
Anne Wilder

Rev
D

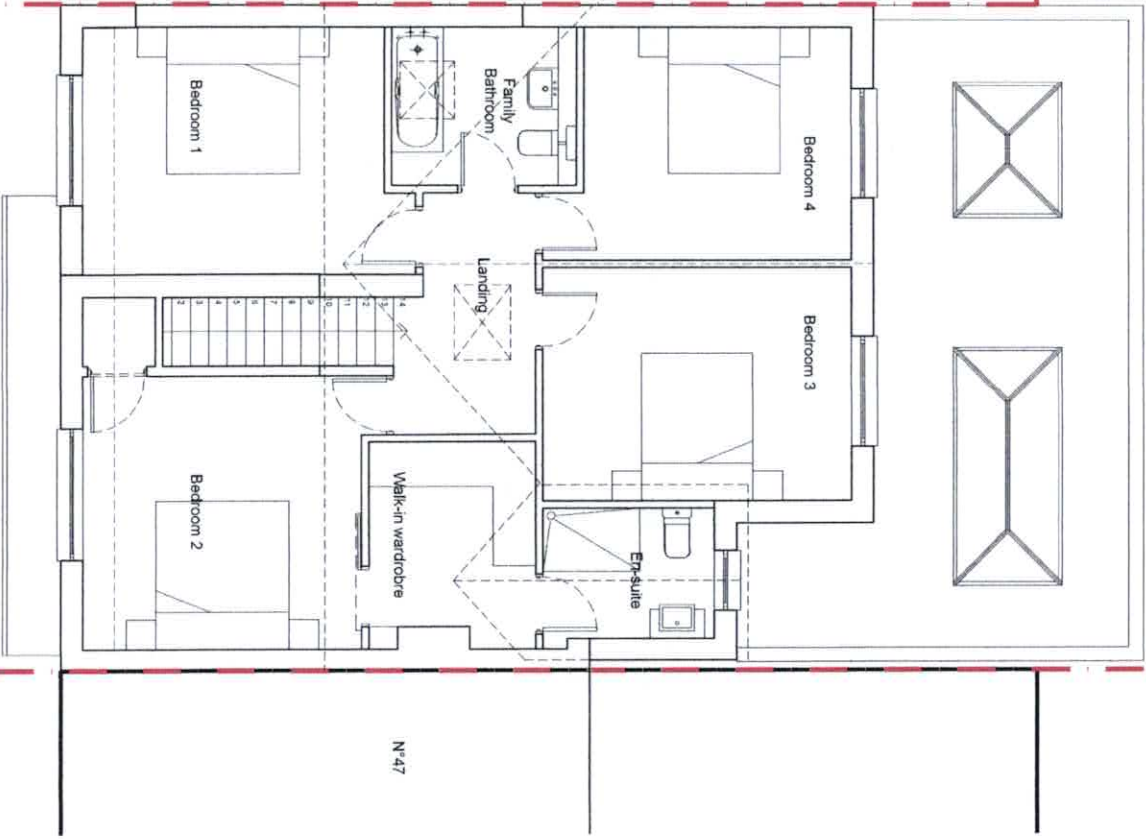

First Floor.

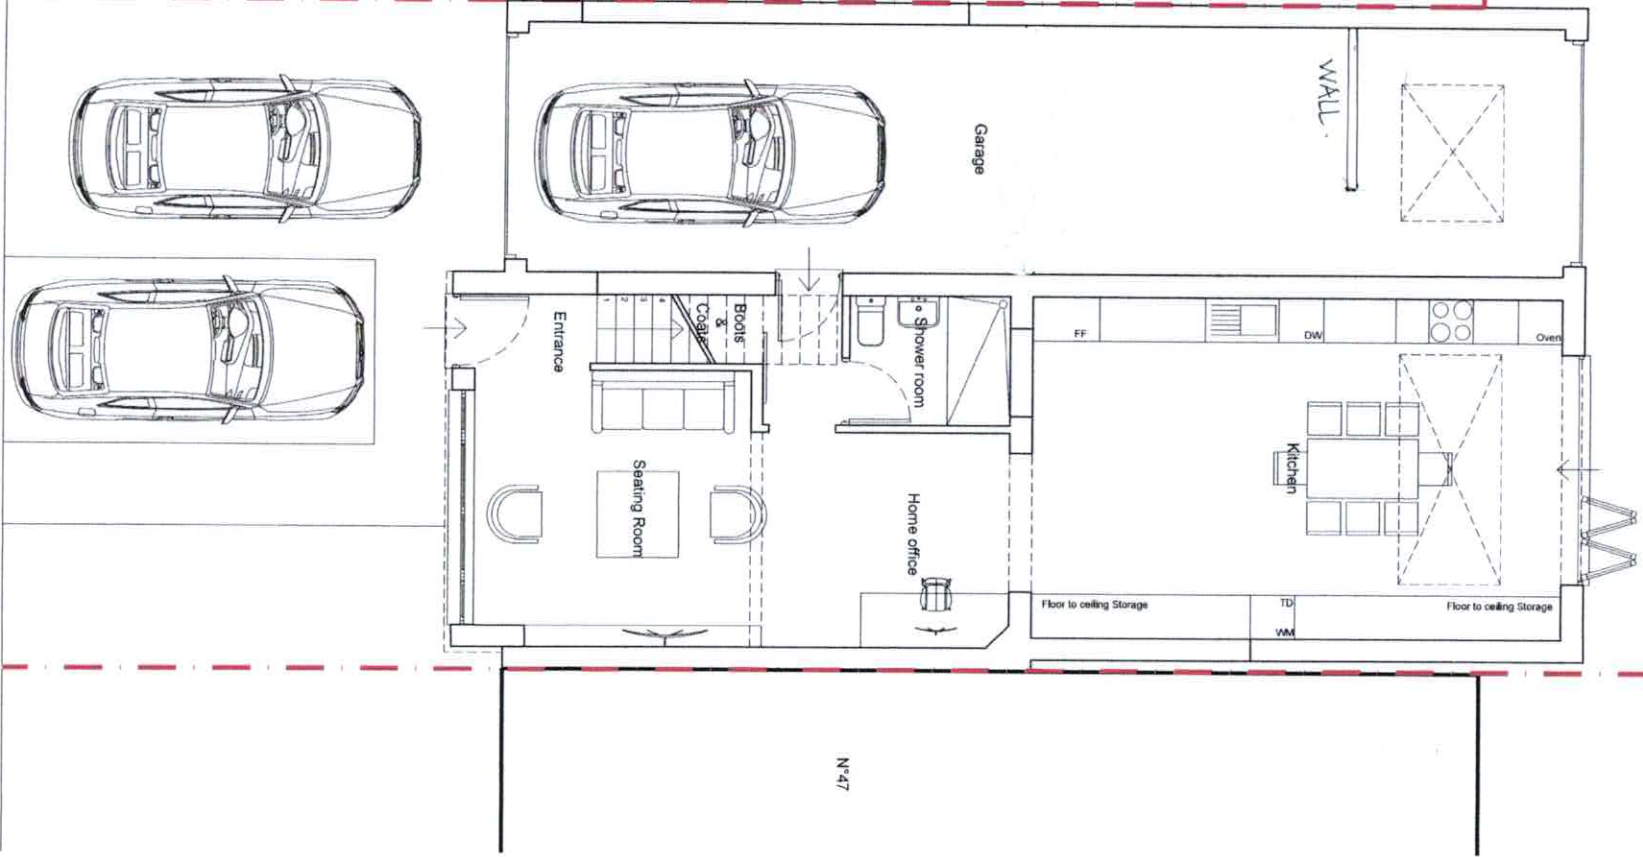

Ground floor.

