


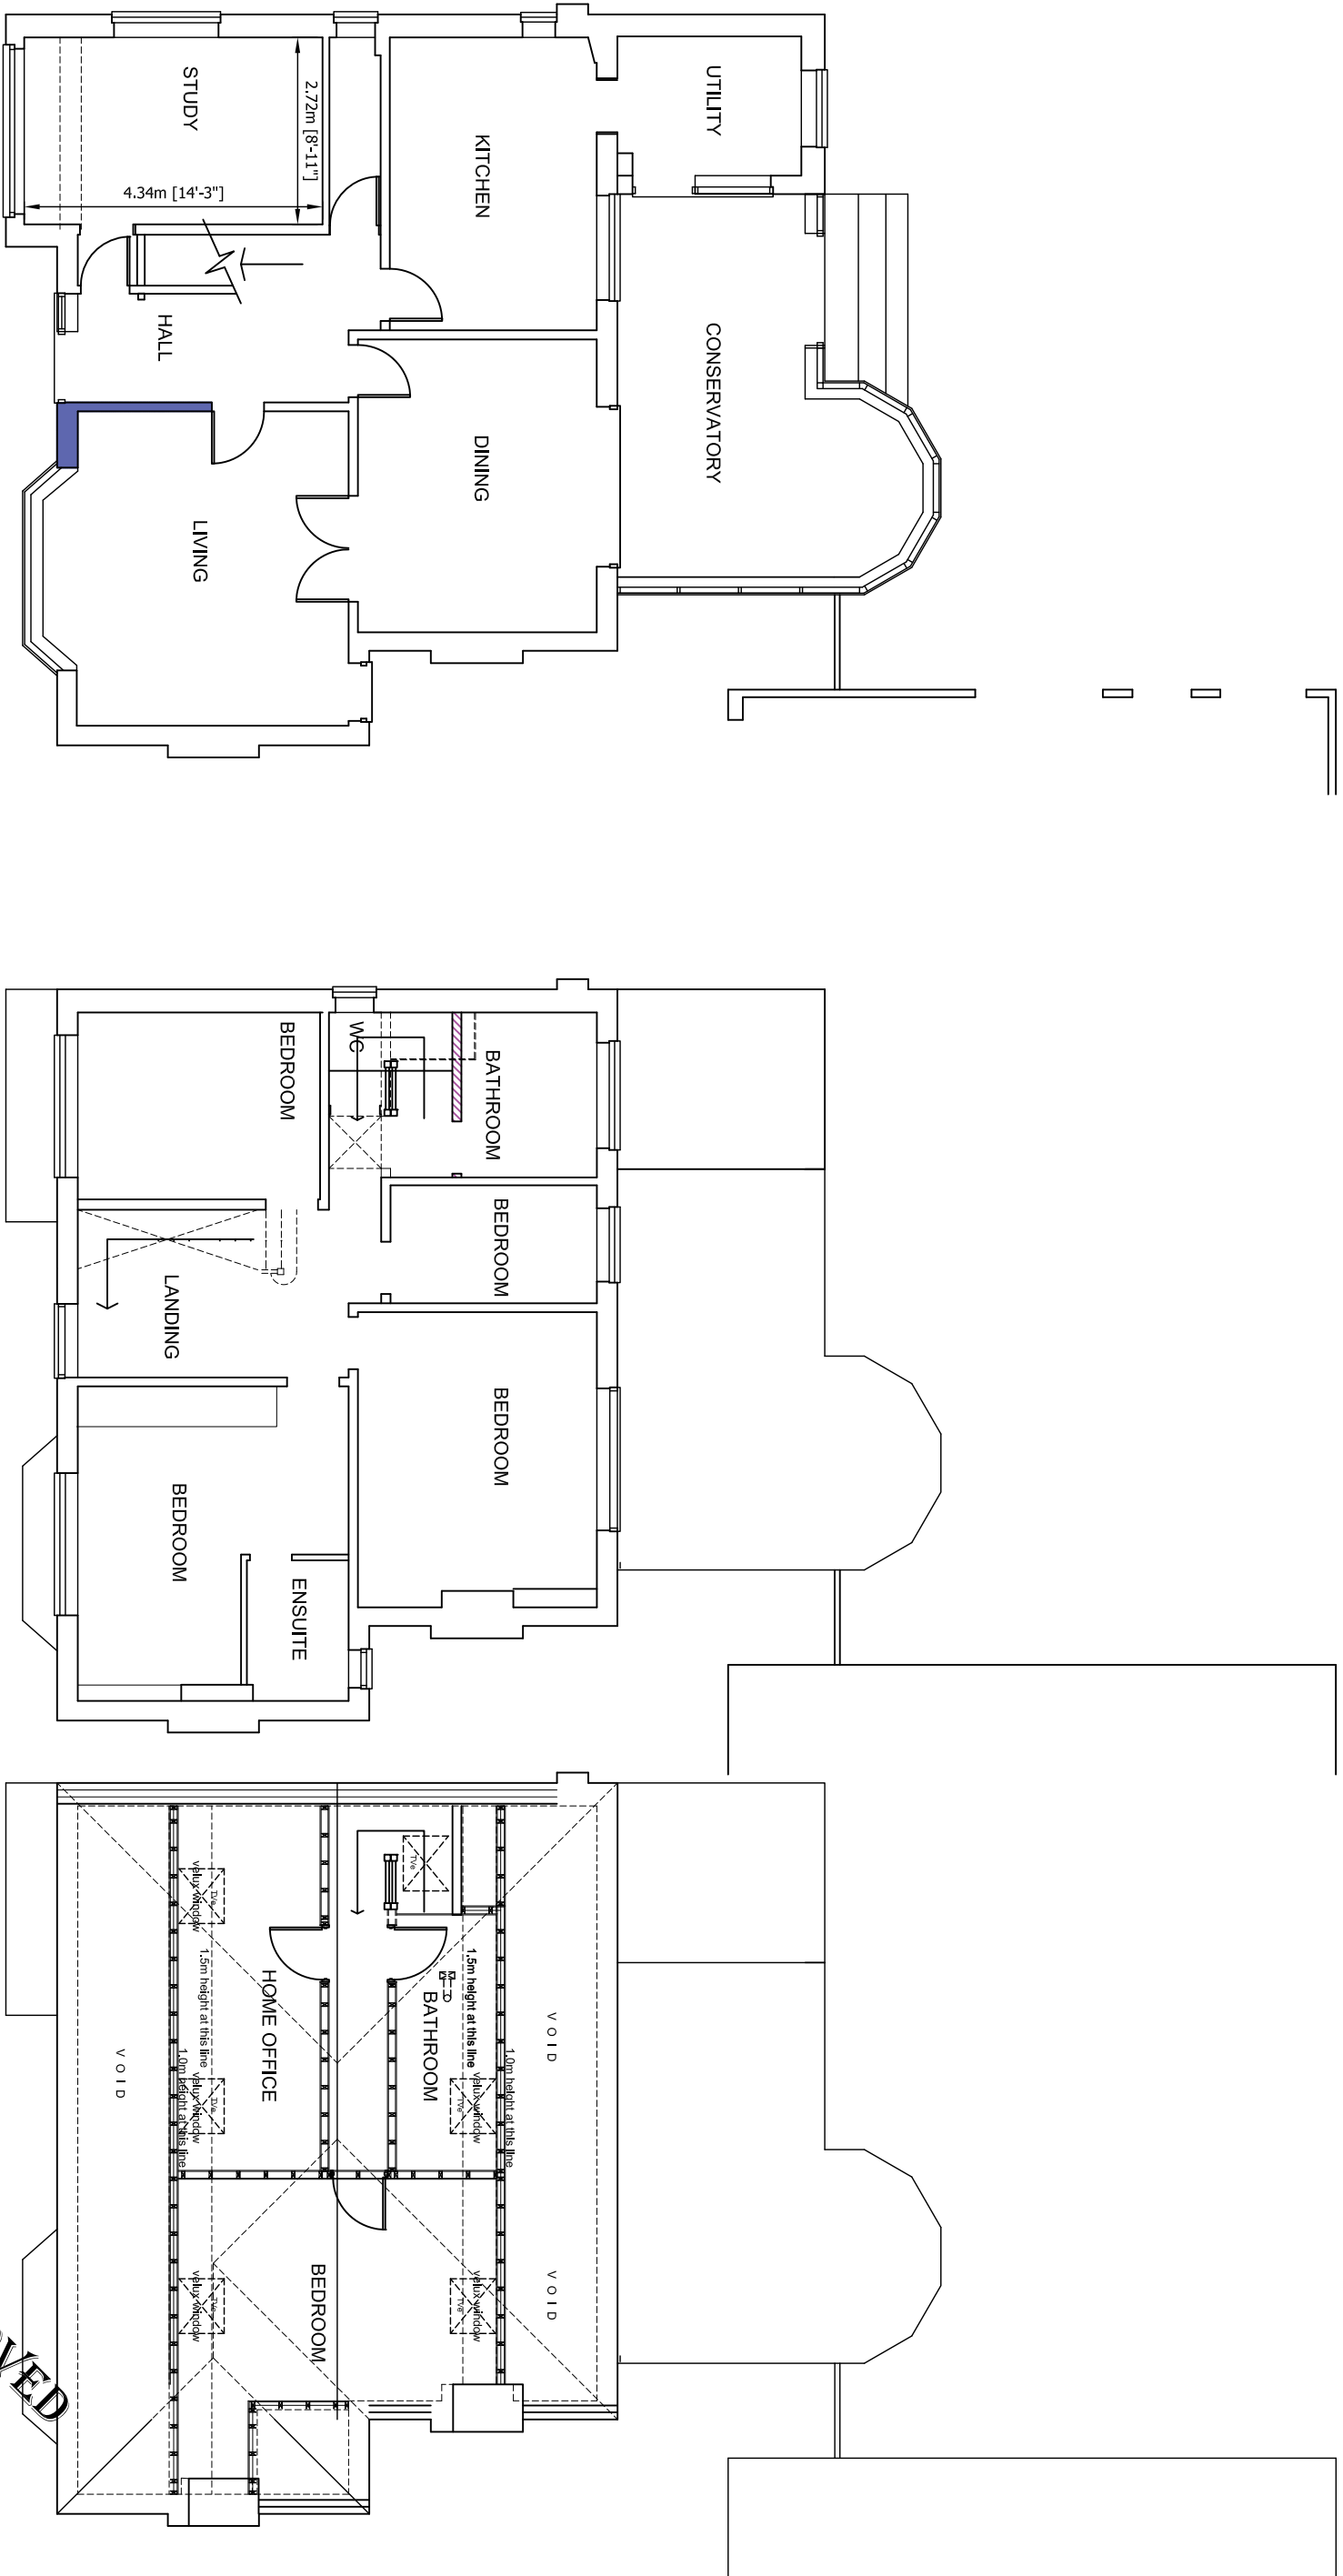


Ground Floor Plan

First Floor Plan

Loft Floor Plan

AS APPROVED
REF:242600

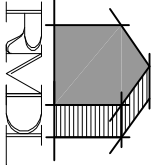

RAMMURTI DESIGN LTD
ARCHITECTURAL & PLANNING SERVICES
268 TILFURST Lane, READING RG30 2NE
TEL/FAX:01189510628 MOB:07799883574



Proposed demolition of conservatory and addition of double storey rear extension followin approval of loft conversion with "hip" to "gable" extensions, with the addition of roof windows to front and rear elevations of existing dwelling (Planning reference 242600)
at 5, Elm Lane, Earley Reading
for Kennet Investments Ltd

AS BUILT FLOOR PLANS

Scale: as shown
Date: September 2024

EL05:004 Rev -