



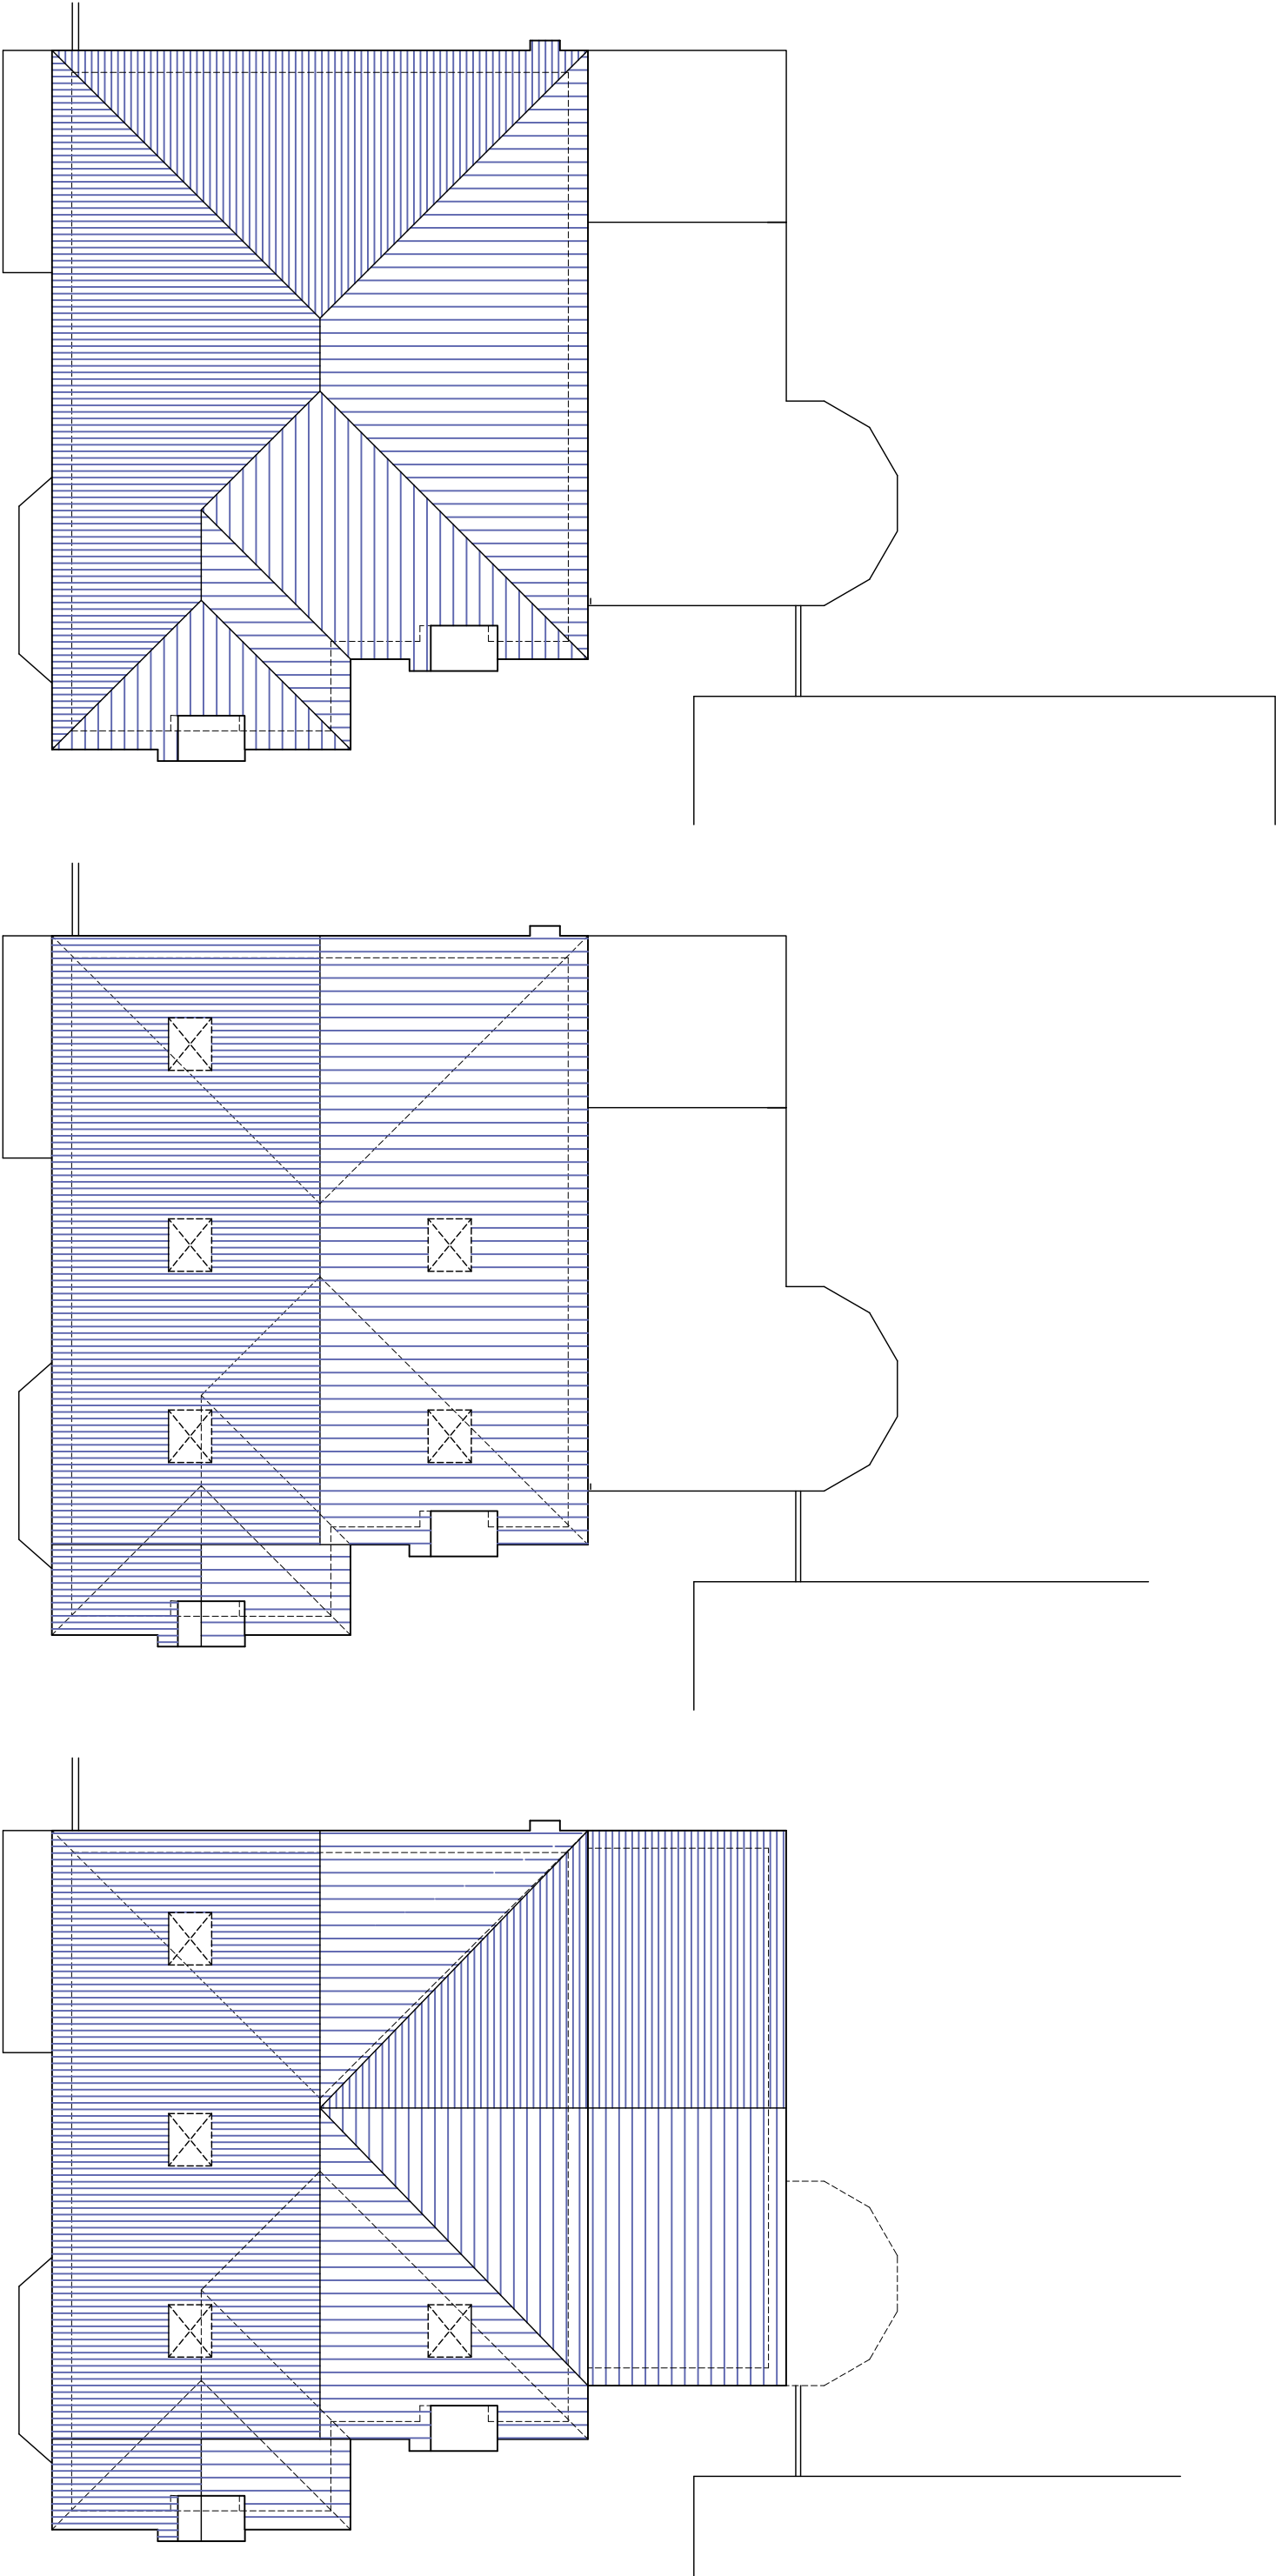

Roof Plan Pre-existing

Roof Plan Existing (as built)
as approved Planning reference 240600

Proposed Roof Plan
with rear extension included

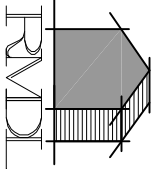

RAMMURTI DESIGN LTD
ARCHITECTURAL & PLANNING SERVICES
268 TILFHURST Lane, READING RG30 2NE
TEL/FAX: 01189510628 MOB: 07799883574



Proposed demolition of conservatory and addition of double storey rear extension followin approval of loft conversion with "hip" to "gable" extensions, with the addition of roof windows to front and rear elevations of existing dwelling (Planning reference 242600)
at 5, Elm Lane, Earley Reading
for Kennet Investments Ltd

EXISTING AND AS PROPOSED ROOF PLANS

Scale: as shown
Date: March 2025

EL05:110 Rev -