




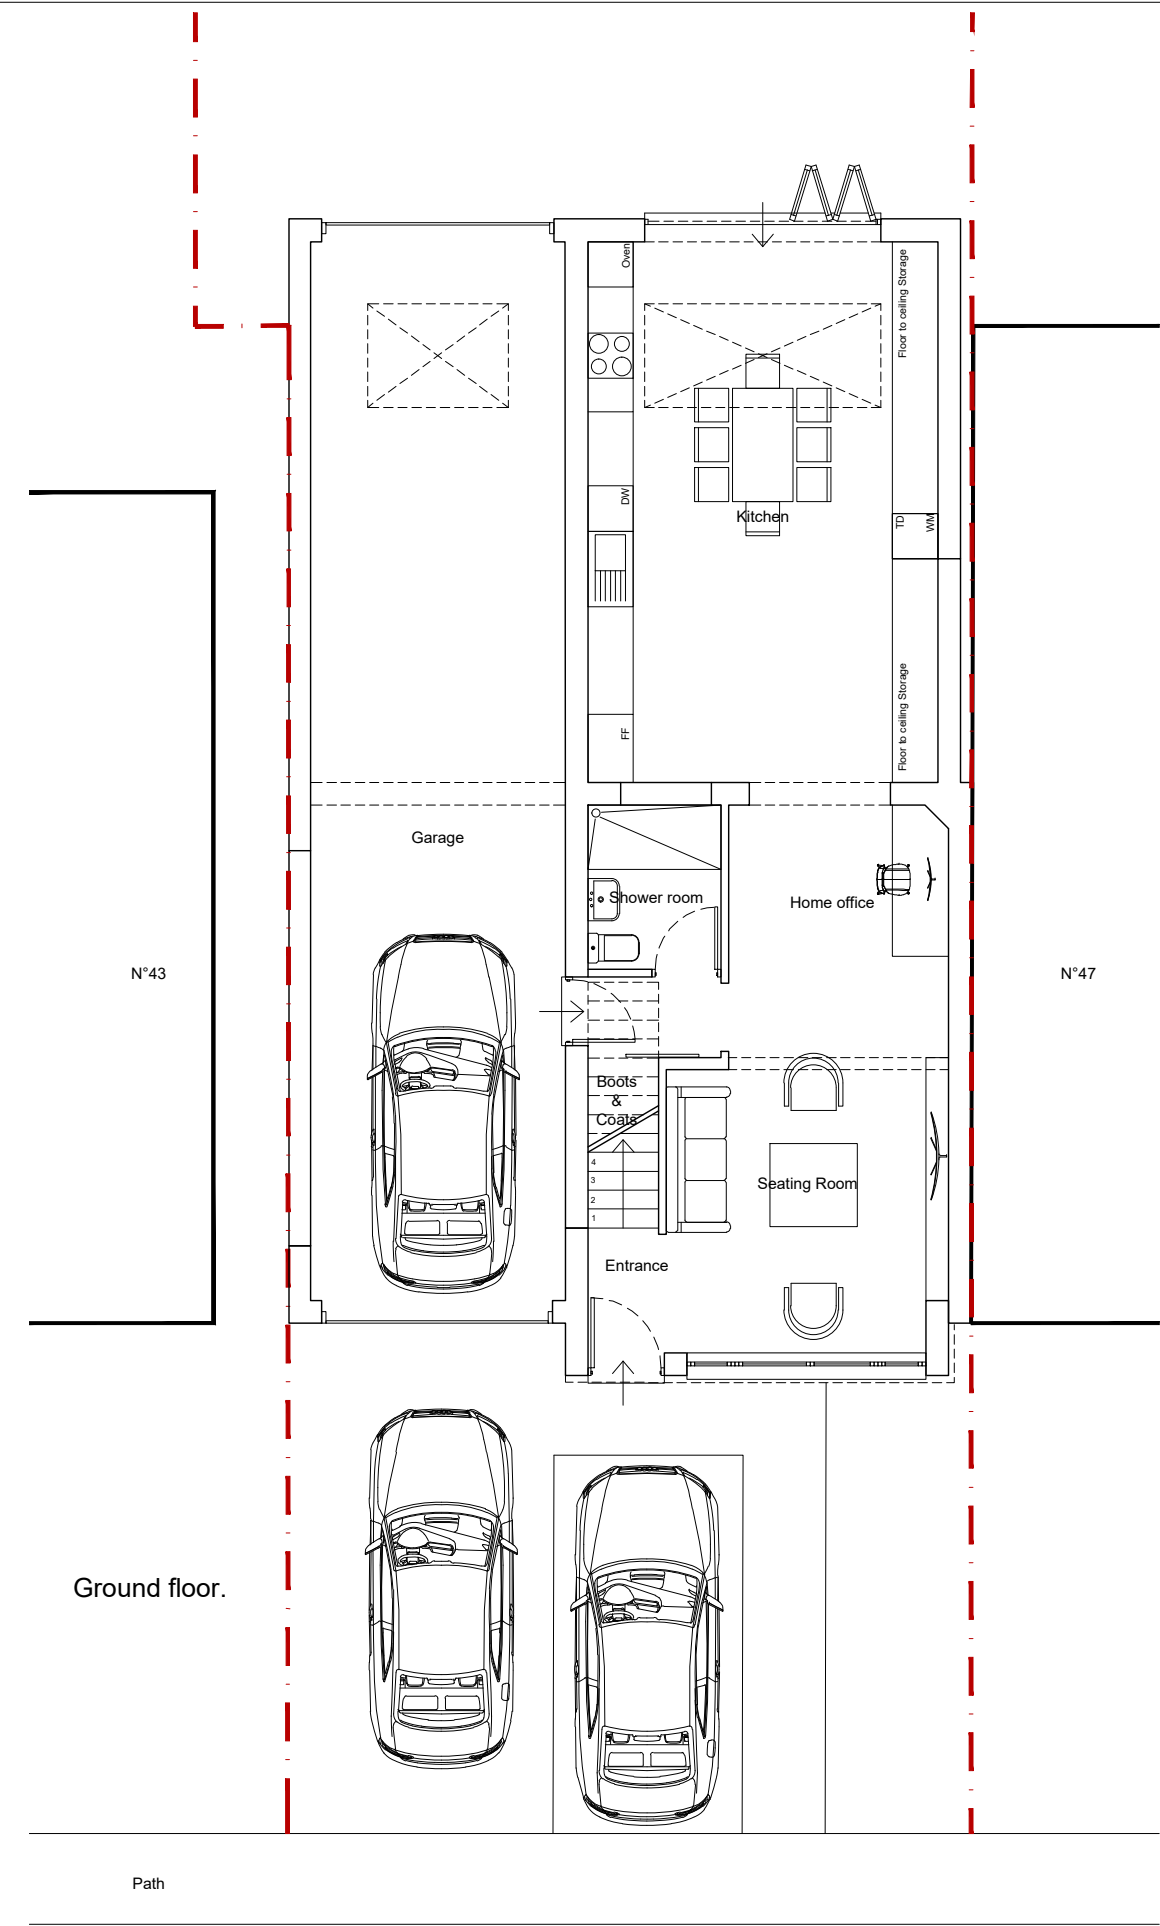

Ground floor.

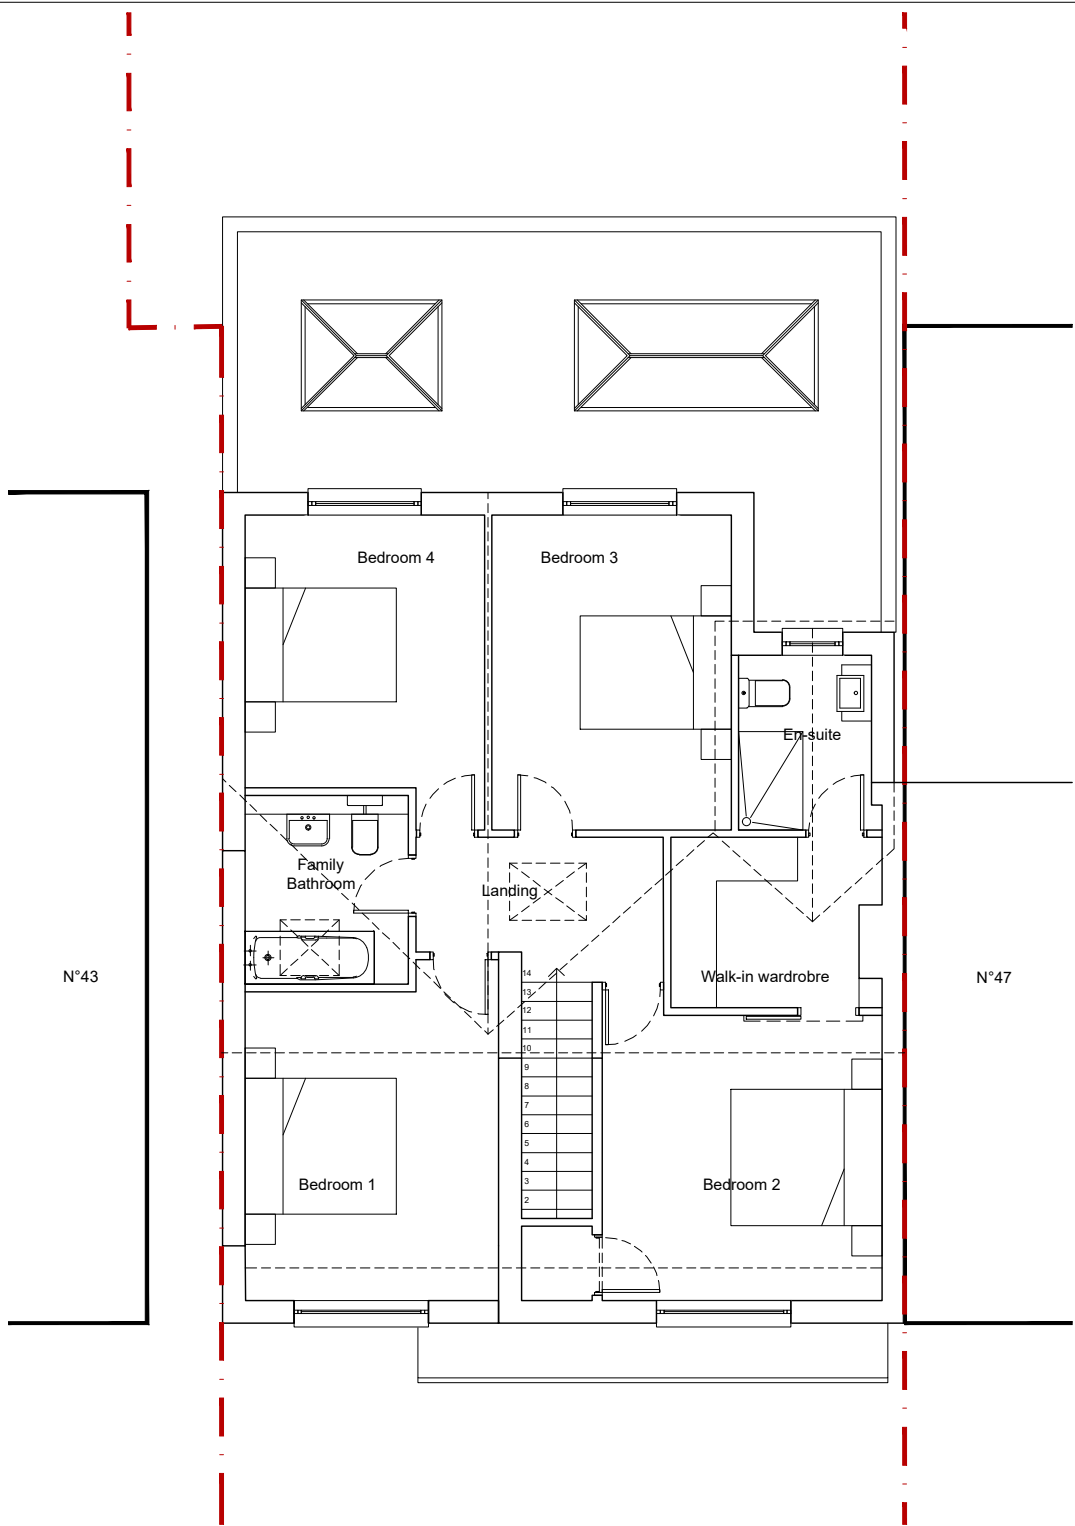

First Floor.

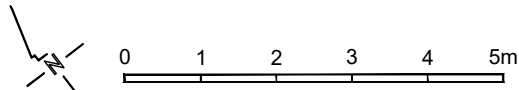

RevB_ To reflect as built on site.

(c) Copyright

WILDER ASSOCIATES
Architects & Designers

2 Mill Lane
Wallingford
Oxon
OX10 0DU
Tel & Fax
01491 832572
E Mail
anne@wilder.co.uk

Client
Bob Tanner

Job Title
45 Hyde End Lane, Ryeish Green,
Reading
RG7 1EP

Drawing Title
Floor Plans as Built.

Scale 1:100@A3

Date Sept 24 **Drawn by** Michel C.

Checked by Anne Wilder

Drg No
BTE/PL/06

Rev
B