





front

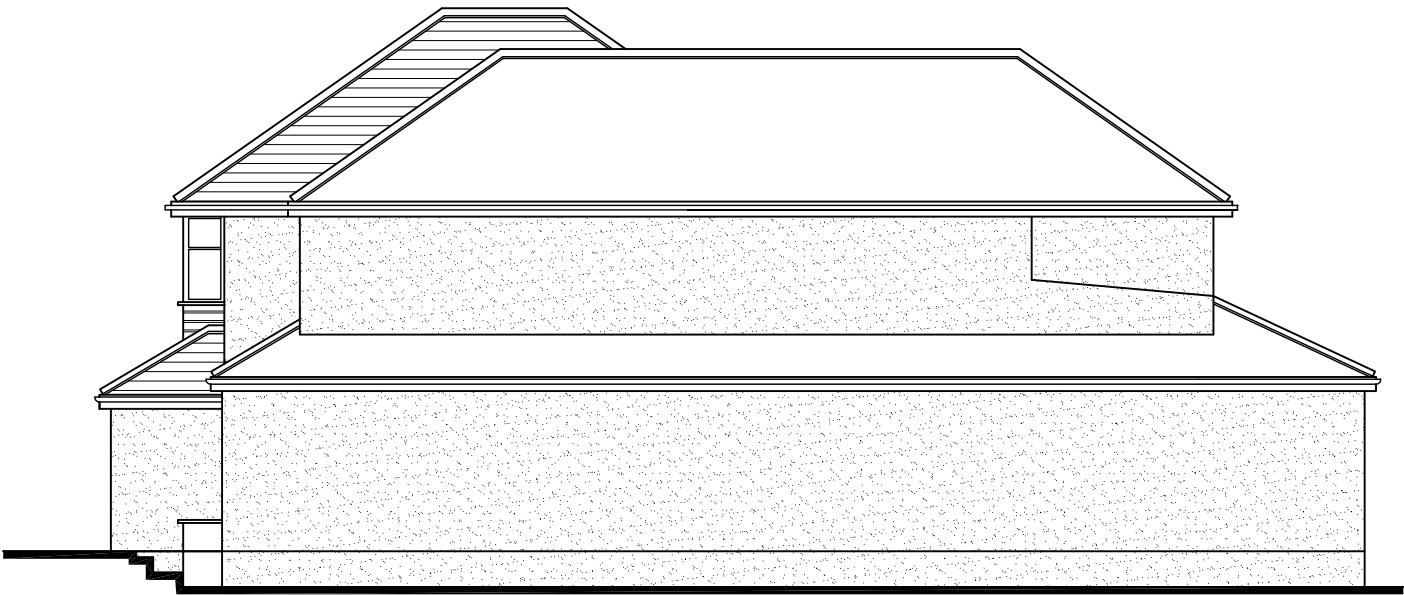


side view from No 70

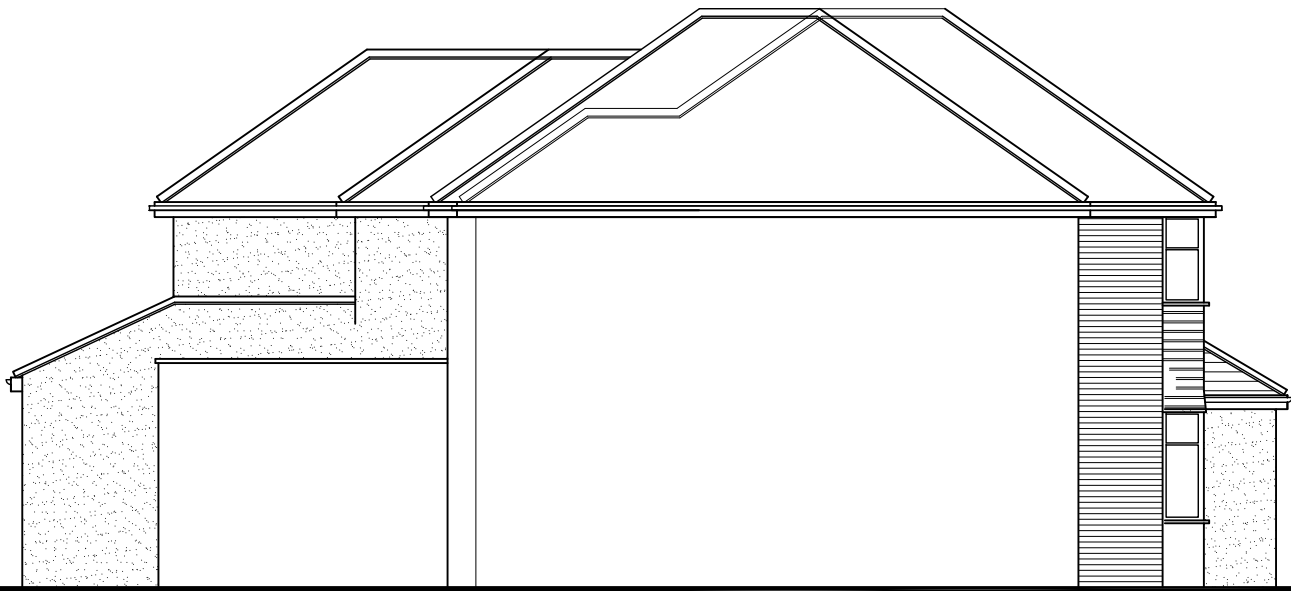

side view from No 74



rear

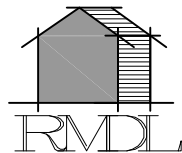

RAMMURTI DESIGN LTD
 ARCHITECTURAL & PLANNING SERVICES
 268 TILEHURST ROAD, READING RG30 2NE
 TEL/FAX:01189510628 MOB:07799883574



Proposed part side and part rear single & double storey extensions to existing dwelling with new front entrance porch

at 72, Crockhamwell Road, Woodley
 for Mr & Mrs H SINGH

**ELEVATIONS AS EXISTING & As PROPOSED
 (AS BUILT)**

Scale: 1/100
 Date: May 2025

CMR72:509 Rev P1