

| Name                              | Girth/Dia. cm | Height cm | Root Zone | Specification                         | Mix % | Area m² | Ctr m | No./m² | Qty |
|-----------------------------------|---------------|-----------|-----------|---------------------------------------|-------|---------|-------|--------|-----|
| <b>Trees</b>                      |               |           |           |                                       |       |         |       |        |     |
| Acer campestre                    | 16-18         | 400-450   | RB        | 3x EHS; clear stem min. 200cm         |       |         |       |        | 3   |
| Corylus colurna                   | 16-18         | 400-450   | RB        | 3x EHS; clear stem min. 200cm         |       |         |       |        | 3   |
| Pinus avium 'Pinea'               | 18-20         | 400-500   | RB        | 3x Semi-mature; clear stem min. 200cm |       |         |       |        | 4   |
| Pinus culleniana 'Chanticleer' MS | Multi-stem    | 300-350   | RB        | 4x Multi-stem; bushy; 3 stems minimum |       |         |       |        | 12  |
| Sorbus aucuparia 'Streetwise'     | 16-18         | 400-450   | RB        | 3x EHS; clear stem min. 200cm         |       |         |       |        | 12  |
| Tilia cordata 'Streetwise'        | 16-18         | 400-450   | RB        | 3x EHS; clear stem minimum 200cm      |       |         |       |        | 4   |
| Sub-totals                        |               |           |           |                                       |       |         |       |        | 32  |

**Individually listed Specimens**

|                                      |  |       |     |                                         |        |     |      |  |     |
|--------------------------------------|--|-------|-----|-----------------------------------------|--------|-----|------|--|-----|
| Camellia x williamsii 'Anticipation' |  | 60-80 | 10L | Leader with laterals; 4 brks            |        |     | 1    |  | 17  |
| Choisya 'Aztec Pearl'                |  | 40-60 | 10L | Bushy; 7 brks                           |        |     | 1    |  | 12  |
| Dryopteris filix-mas                 |  | 60-80 | 10L | Full pot                                |        |     | 1    |  | 17  |
| Fatsia japonica                      |  | 60-80 | 10L | Leader                                  |        |     | 1    |  | 3   |
| Philadelphus 'Belle Etoile'          |  | 40-60 | 10L | Branched; 7 brks                        |        |     | 1    |  | 15  |
| Stipa gigantea                       |  |       | 10L | Full pot                                |        |     | 1    |  | 21  |
| Sub-totals                           |  |       |     |                                         |        |     |      |  | 85  |
| <b>Hedging</b>                       |  |       |     |                                         | Lin.m. |     |      |  |     |
| Fagus sylvatica 'Purpurea'           |  | 60-90 | 2L  | 2x Feathered with 3 breaks. Pot size 2L |        | 172 | 0.25 |  | 688 |
| Sub-totals                           |  |       |     |                                         |        |     |      |  | 688 |

Note: Plants in mixes to be positioned in a naturalistic and unstructured style in small same-species groups of 3 or 5. Avoid planting in grids, lines or blocks.

**Mix 1 - Rain Garden**

**- Sunny Aspect**

Planted at 5/m2

Note: Helenium, Rudbeckia, Deschampsia and Crocosmia to be planted minimum 1m from front of plant bed.

|                                          |        |       |                                       |                                                                                       |      |     |      |  |      |
|------------------------------------------|--------|-------|---------------------------------------|---------------------------------------------------------------------------------------|------|-----|------|--|------|
| Campanula lactiflora 'Loddon Anna'       |        |       | 2L                                    | Full pot                                                                              | 5    |     | 0.45 |  | 80   |
| Crocosmia x crocosmiflora                |        |       | 3L                                    | Full pot                                                                              | 5    |     | 0.45 |  | 80   |
| Deschampsia cespitosa 'Goldtau'          |        |       | 3L                                    | Full pot                                                                              | 5    |     | 0.45 |  | 80   |
| Eupatorium cannabinum                    |        |       | 2L                                    | Full pot; Sept to April planting; British native-origin                               | 5    |     | 0.45 |  | 80   |
| Geranium macrorrhizum 'Album'            |        |       | 3L                                    | Full pot                                                                              | 5    |     | 0.45 |  | 80   |
| Helenium 'Moerheim Beauty'               |        |       | 2L                                    | Full pot                                                                              | 5    |     | 0.45 |  | 80   |
| Inula hookeri                            |        |       | 2L                                    | Full pot                                                                              | 5    |     | 0.45 |  | 80   |
| Iris pseudacorus                         |        |       | 50cc min.                             | Plug; established root 2-3 months min.; Sept to April planting; British native-origin | 15   |     | 0.45 |  | 241  |
| Pachysandra terminalis                   | 15-20D |       | 3L                                    | Several shoots; 9 brks                                                                | 10   |     | 0.45 |  | 160  |
| Polystichum setiferum                    |        |       | 3L                                    | Full pot                                                                              | 5    |     | 0.45 |  | 80   |
| Rudbeckia fulgida sultivanti 'Goldsturm' |        |       | 3L                                    | Full pot                                                                              | 5    |     | 0.45 |  | 80   |
| Sarcococca humilis                       |        | 20-25 | 3L                                    | Bushy; 6 brks                                                                         | 5    |     | 0.45 |  | 80   |
| Saxifraga x urbium                       |        |       | 2L                                    | Full pot                                                                              | 5    |     | 0.45 |  | 80   |
| Sedum 'Herbstfreude'                     |        |       | 3L                                    | Full pot                                                                              | 5    |     | 0.45 |  | 80   |
| Sedum spectabile 'Stardust'              |        |       | 3L                                    | Full pot                                                                              | 5    |     | 0.45 |  | 80   |
| Vinca minor 'Gertrude Jekyll'            | 20-30D |       | 3L                                    | Several shoots; 3 brks                                                                | 10   |     | 0.45 |  | 160  |
| Quantity co-efficient *                  | 1      |       | TOTAL AREA OF COMBINED PLANTING BEDS: |                                                                                       | 100% | 325 |      |  | 1601 |

**Mix 1 - Rain Garden - Bulbs**

Planted in groups of 9-12 of the same species, groups spaced @ 1.5m centres

|                           |   |  |                                       |                    |      |     |      |  |      |
|---------------------------|---|--|---------------------------------------|--------------------|------|-----|------|--|------|
| Allium 'Mount Everest'    |   |  |                                       | Grade 20/+         | 10   |     | 0.35 |  | 265  |
| Narcissus pseudonarcissus |   |  |                                       | Grade 6/+ Topsizes | 90   |     | 0.35 |  | 2388 |
| Quantity co-efficient *   | 1 |  | TOTAL AREA OF COMBINED PLANTING BEDS: |                    | 100% | 325 |      |  | 2653 |

**Mix 4 - Low Shady**

Planted at 5/m2

Note: Prunus to be planted minimum 1m from front of plant bed.

|                                      |        |       |            |                        |      |     |      |  |     |
|--------------------------------------|--------|-------|------------|------------------------|------|-----|------|--|-----|
| Ajuga reptans 'Atropurpurea'         |        |       | 2L         | Full pot               | 8    |     | 0.45 |  | 71  |
| Asplenium scolopendrium              |        |       | 3L         | Full pot               | 8    |     | 0.45 |  | 71  |
| Euonymus fortunei 'Emerald 'n' Gold' | 20-30D | 20-25 | 3L         | Bushy; 7 brks          | 7    |     | 0.45 |  | 62  |
| Geranium 'Johnson's Blue'            |        |       | 3L         | Full pot               | 8    |     | 0.45 |  | 71  |
| Helleborus orientalis                |        |       | 3L         | Full pot               | 8    |     | 0.45 |  | 71  |
| Lonicera pileata 'Moss Green'        | 20-30D |       | 2L         | Bushy; 3 brks          | 8    |     | 0.45 |  | 71  |
| Luzula sylvatica                     |        |       | 2L         | Full pot               | 8    |     | 0.45 |  | 71  |
| Pachysandra terminalis               | 15-20D |       | 3L         | Several shoots; 9 brks | 8    |     | 0.45 |  | 71  |
| Polypodium vulgare                   |        |       | 3L         | Full pot               | 8    |     | 0.45 |  | 71  |
| Prunus laurocerasus 'Cherry Brandy'  | 30-40D |       | 3L         | Bushy; 3 brks          | 5    |     | 0.45 |  | 44  |
| Sarcococca humilis                   |        | 20-25 | 3L         | Bushy; 6 brks          | 8    |     | 0.45 |  | 71  |
| Veronica prostrata                   |        |       | 2L         | Full pot               | 8    |     | 0.45 |  | 71  |
| Vinca minor 'Gertrude Jekyll'        | 20-30D |       | 3L         | Several shoots; 3 brks | 8    |     | 0.45 |  | 71  |
| Quantity co-efficient *              | 1      |       | Sub-totals |                        | 100% | 179 |      |  | 887 |

**Mix 4 - Low Shady - Bulbs**

Planted in groups of 9-12, groups spaced @ 1.5m centres

|                         |   |  |            |           |      |     |      |  |      |
|-------------------------|---|--|------------|-----------|------|-----|------|--|------|
| Galanthus nivalis       |   |  |            | Grade 5/6 | 100  |     | 0.35 |  | 1339 |
| Quantity co-efficient * | 1 |  | Sub-totals |           | 100% | 164 |      |  | 1339 |

**Mix 5 - Low Shady**

Planted at 5/m2

Individual varieties to be planted in small groups of 3 and 5.

|                                     |   |       |            |               |      |    |      |  |    |
|-------------------------------------|---|-------|------------|---------------|------|----|------|--|----|
| Anemone x hybrida 'Honorine Jobert' |   |       | 2L         | Full pot      | 25   |    | 0.45 |  | 17 |
| Liriope muscari                     |   |       | 2L         | Full pot      | 50   |    | 0.45 |  | 34 |
| Sarcococca humilis                  |   | 20-25 | 3L         | Bushy; 6 brks | 25   |    | 0.45 |  | 17 |
| Quantity co-efficient *             | 1 |       | Sub-totals |               | 100% | 14 |      |  | 68 |

**Mix 6 - Low Sunny**

Planted at 5/m2

|                             |   |       |            |               |      |    |      |  |    |
|-----------------------------|---|-------|------------|---------------|------|----|------|--|----|
| Hakonechloa macra 'Aureola' |   |       | 2L         | Full pot      | 50   |    | 0.45 |  | 27 |
| Santolina chamaecyparissus  |   | 20-30 | 3L         | Bushy; 7 brks | 25   |    | 0.45 |  | 14 |
| Viburnum davidii            |   | 20-30 | 3L         | Bushy; 3 brks | 25   |    | 0.45 |  | 14 |
| Quantity co-efficient *     | 1 |       | Sub-totals |               | 100% | 11 |      |  | 55 |

**Mix 7 - Low Sunny**

Planted at 5/m2

Note: Prunus to be planted minimum 1m from front of plant bed.

|                                     |   |        |            |                                                         |      |     |      |  |     |
|-------------------------------------|---|--------|------------|---------------------------------------------------------|------|-----|------|--|-----|
| Achillea ptarmica 'The Pearl'       |   |        | 2L         | Full pot                                                | 20   |     | 0.45 |  | 192 |
| Briza media                         |   |        | 2L         | Full pot; Sept to April planting; British native-origin | 15   |     | 0.45 |  | 144 |
| Leucanthemum vulgare                |   |        | 2L         | Full pot                                                | 20   |     | 0.45 |  | 192 |
| Lonicera pileata 'Moss Green'       |   | 20-30D | 2L         | Bushy; 3 brks                                           | 15   |     | 0.45 |  | 144 |
| Prunus laurocerasus 'Cherry Brandy' |   | 30-40D | 3L         | Bushy; 3 brks                                           | 15   |     | 0.45 |  | 144 |
| Santolina chamaecyparissus          |   | 20-30  | 3L         | Bushy; 7 brks                                           | 15   |     | 0.45 |  | 144 |
| Quantity co-efficient *             | 1 |        | Sub-totals |                                                         | 100% | 194 |      |  | 960 |

**Mix 7 - Low Sunny - Bulbs**

Planted in groups of 9-12 of the same species, groups spaced @ 1.5m centres

|                           |   |  |                                       |                    |      |     |      |  |      |
|---------------------------|---|--|---------------------------------------|--------------------|------|-----|------|--|------|
| Narcissus pseudonarcissus |   |  |                                       | Grade 6/+ Topsizes | 100  |     | 0.45 |  | 1086 |
| Quantity co-efficient *   | 1 |  | TOTAL AREA OF COMBINED PLANTING BEDS: |                    | 100% | 220 |      |  | 1086 |

**Mix 8 - Low Sunny**

Planted at 5/m2

|                                     |   |        |            |               |      |    |      |  |    |
|-------------------------------------|---|--------|------------|---------------|------|----|------|--|----|
| Achillea ptarmica 'The Pearl'       |   |        | 2L         | Full pot      | 50   |    | 0.45 |  | 30 |
| Prunus laurocerasus 'Cherry Brandy' |   | 30-40D | 3L         | Bushy; 3 brks | 25   |    | 0.45 |  | 15 |
| Santolina chamaecyparissus          |   | 20-30  | 3L         | Bushy; 7 brks | 25   |    | 0.45 |  | 15 |
| Quantity co-efficient *             | 1 |        | Sub-totals |               | 100% | 12 |      |  | 60 |

|                                  |  |  |  |  |  |  |  |  |    |
|----------------------------------|--|--|--|--|--|--|--|--|----|
| <b>Turf</b>                      |  |  |  |  |  |  |  |  |    |
| Lindam Turfs 'LT8 Festival PLUS' |  |  |  |  |  |  |  |  | 77 |

**Existing species-rich grass to be reinstated where necessary**


|                        |  |  |  |  |  |  |  |  |         |
|------------------------|--|--|--|--|--|--|--|--|---------|
|                        |  |  |  |  |  |  |  |  |         |
|                        |  |  |  |  |  |  |  |  | Area m² |
| EH1 – Hedgerow Mixture |  |  |  |  |  |  |  |  | 820     |

**Notes**

Check all dimensions on site. Do not scale from this drawing  
Report any discrepancies and omissions to HLM Architects  
This Drawing is Copyright ©

**FINAL CONSTRUCTION ISSUE**

This issue records the latest revision of this drawing as prepared for construction purposes, HLM cannot confirm the project was constructed entirely as shown and accept no liability for losses arising from any errors in, or omissions from the information provided. For areas and sizes, any dimensions shown for construction should be checked on site. For alterations, this drawing must be read in conjunction with the Health and Safety file, and the drawings of other consultants and specialists, and details checked on site prior to commencement.

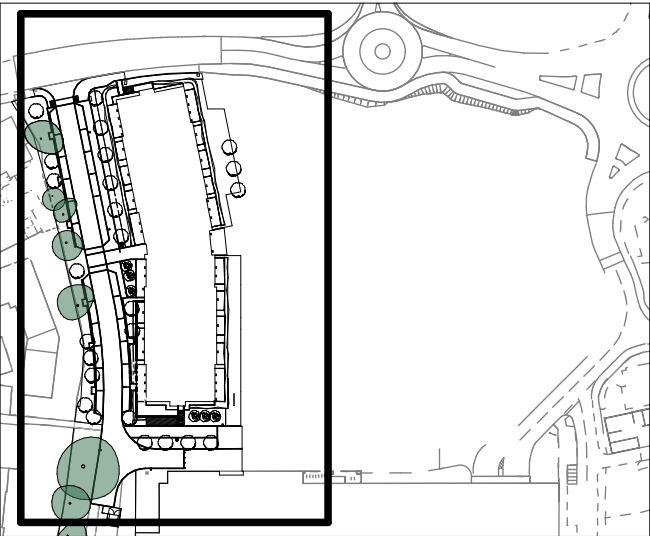

**NOTE:**

This drawing forms part of the Soft Landscape Package of Works and should be read in conjunction with the full package, which consists of the following drawings & documents:

- P1040-HLM-00-00-DR-L-0002 RESIDENTIAL SITE LEVELS PLAN SHEET 1
- P1040-HLM-00-00-DR-L-0003 RESIDENTIAL SITE LEVELS PLAN SHEET 2
- P1040-HLM-00-00-DR-L-3080 RESIDENTIAL HARD LANDSCAPE LAYOUT
- P1040-HLM-00-00-DR-L-3090 RESIDENTIAL HARD LANDSCAPE DETAILS - CAR PARK SHEET 1
- P1040-HLM-00-00-DR-L-3091 RESIDENTIAL HARD LANDSCAPE DETAILS - CAR PARK SHEET 2
- P1040-HLM-00-00-DR-L-3092 RESIDENTIAL HARD LANDSCAPE DETAILS - RAIN GARDENS
- P1040-HLM-00-00-DR-L-3093 RESIDENTIAL HARD LANDSCAPE DETAILS - STEPS
- P1040-HLM-00-00-DR-L-3094 RESIDENTIAL HARD LANDSCAPE DETAILS - TYPICAL DETAILS SHEET 1
- P1040-HLM-00-00-DR-L-3095 RESIDENTIAL HARD LANDSCAPE DETAILS - TYPICAL DETAILS SHEET 2
- P1040-HLM-00-00-DR-L-4501 RESIDENTIAL SOFT LANDSCAPE PLANTING LAYOUT
- P1040-HLM-00-00-DR-L-4502 RESIDENTIAL SOFT LANDSCAPE PLANTING SCHEDULE
- P1040-HLM-00-00-DR-L-4503 RESIDENTIAL SOFT LANDSCAPE TYPICAL DETAILS
- P1040-HLM-XX-XX-SP-L-0060 LANDSCAPE SPECIFICATION

|      |                                                             |          |    |     |
|------|-------------------------------------------------------------|----------|----|-----|
| CR01 | Final Construction Issue                                    | 14.10.25 | CC | AO  |
| C05  | Construction Issue                                          | 23.06.25 | CC | AO  |
| C04  | Construction Issue                                          | 30.08.24 | CC | SG  |
| P07  | Stage 4 Issue                                               | 15.03.24 | CC | AO  |
| P06  | Stage 4 Issue                                               | 06.01.24 | CC | AO  |
| C03  | Stage 4 Issue                                               | 14.12.23 | CC | AO  |
| C02  | Updated to reflect latest tree survey                       | 10.06.22 | RW | AO  |
| C01  | Stage 5 Issue                                               | 23.03.22 | RW | AO  |
| P05  | Updates clouded following footway widening                  | 20.12.21 | RW | AO  |
| P04  | Updated as clouded following Wellington Rd footway widening | 11.11.21 | RW | AO  |
| P03  | Final Stage 4 Issue                                         | 06.07.21 | SL | NI  |
| P02  | Draft Stage 4 Issue                                         | 02.07.21 | RW | AO  |
| P01  | Stage 3 Issue                                               | 21.05.21 | RW | AO  |
| Rev  | Description                                                 | Date     | By | Chk |

|           |             |
|-----------|-------------|
| Revisions | Suitability |
| Project   | S2          |

**Carnival Residential**  
**Record Drawings**

Client



Title

**RESIDENTIAL SOFT LANDSCAPE PLANTING SCHEDULE**

Drawing No. Revision

**P1040-HLM-XX-00-DR-L-4502 CR01**

Scale @ A1 Drawn

NTS CC

Date Checked

17/09/2025 AO



© HLM Architects

2nd Floor  
The Ruskin Building  
Tudor Square  
Sheffield S1 2LA

www.hlmarchitects.com

T. +44 (0) 114 263 9600  
F. +44 (0) 114 263 9650  
sheffield@hlmarchitects.com

