

project

288 Wokingham Road
Earley, Reading, Berkshire

for

Mr P Garner

title

Alterations to front wall

Drawing no:

1404 / 6 / f

M D Howlett

architectural consultant


11 Prospect Street, Caversham, Reading
Berkshire RG4 8JG, Tel: (0118) 947 7117
Email: pmharc@glbcsltd.co.uk

Date: October 2025

0 1 2 metres

Scale: 1:100 @ A3.

- Rev.a: timber fencing shown, November 2025.
Rev.b: sloping fence shown, November 2025.
Rev.c: pier height reduced, January 2026.
Rev.d: piers replaced with posts as built, January 2026.
Rev.e: piers, wall & fences shown as built, June 2026.
Rev.f: Dropped kerb altered, August 2026.

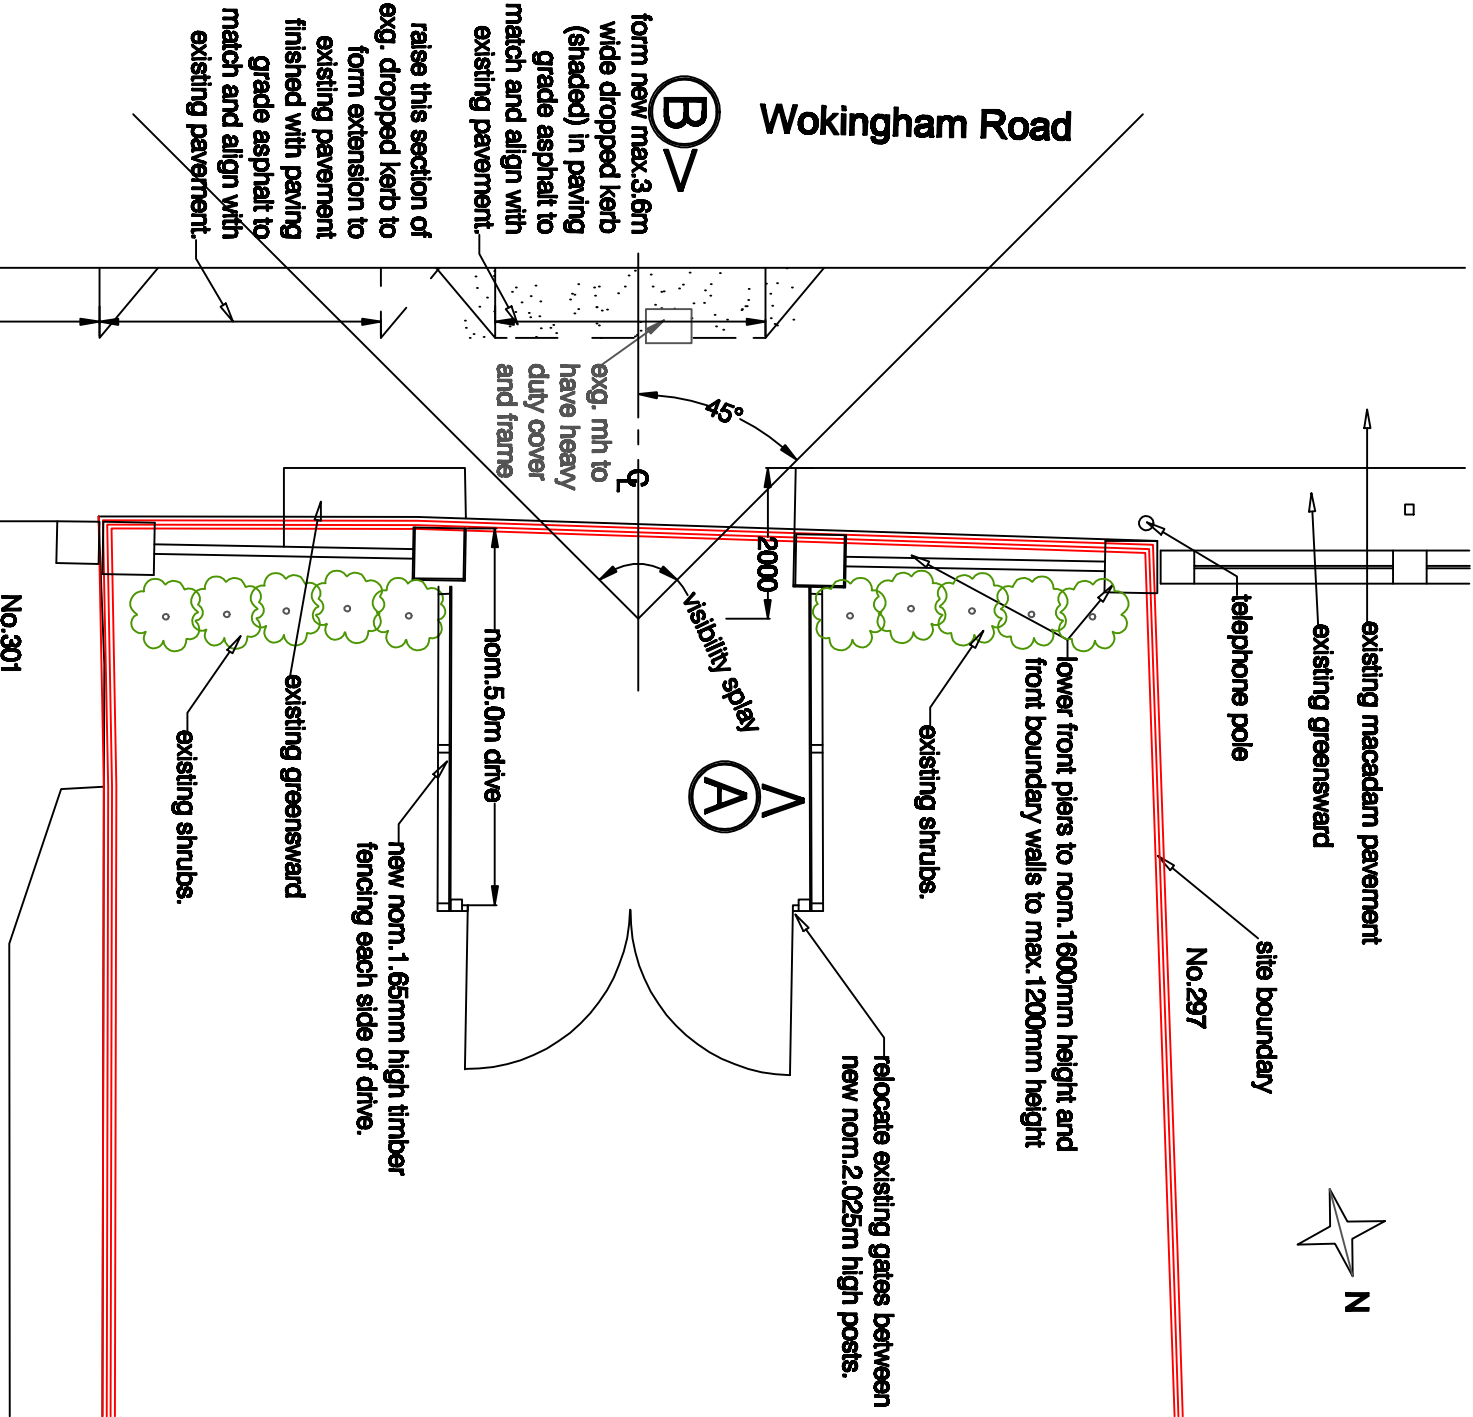

VIEW A

VIEW B

