


NOTES

Use figured dimensions only. Scale drawing only when a scale bar is present. All dimensions to be checked by user and any discrepancies, error or omissions to be reported to the architect before work commences. Read this drawing with all relevant materials.

Site Boundary

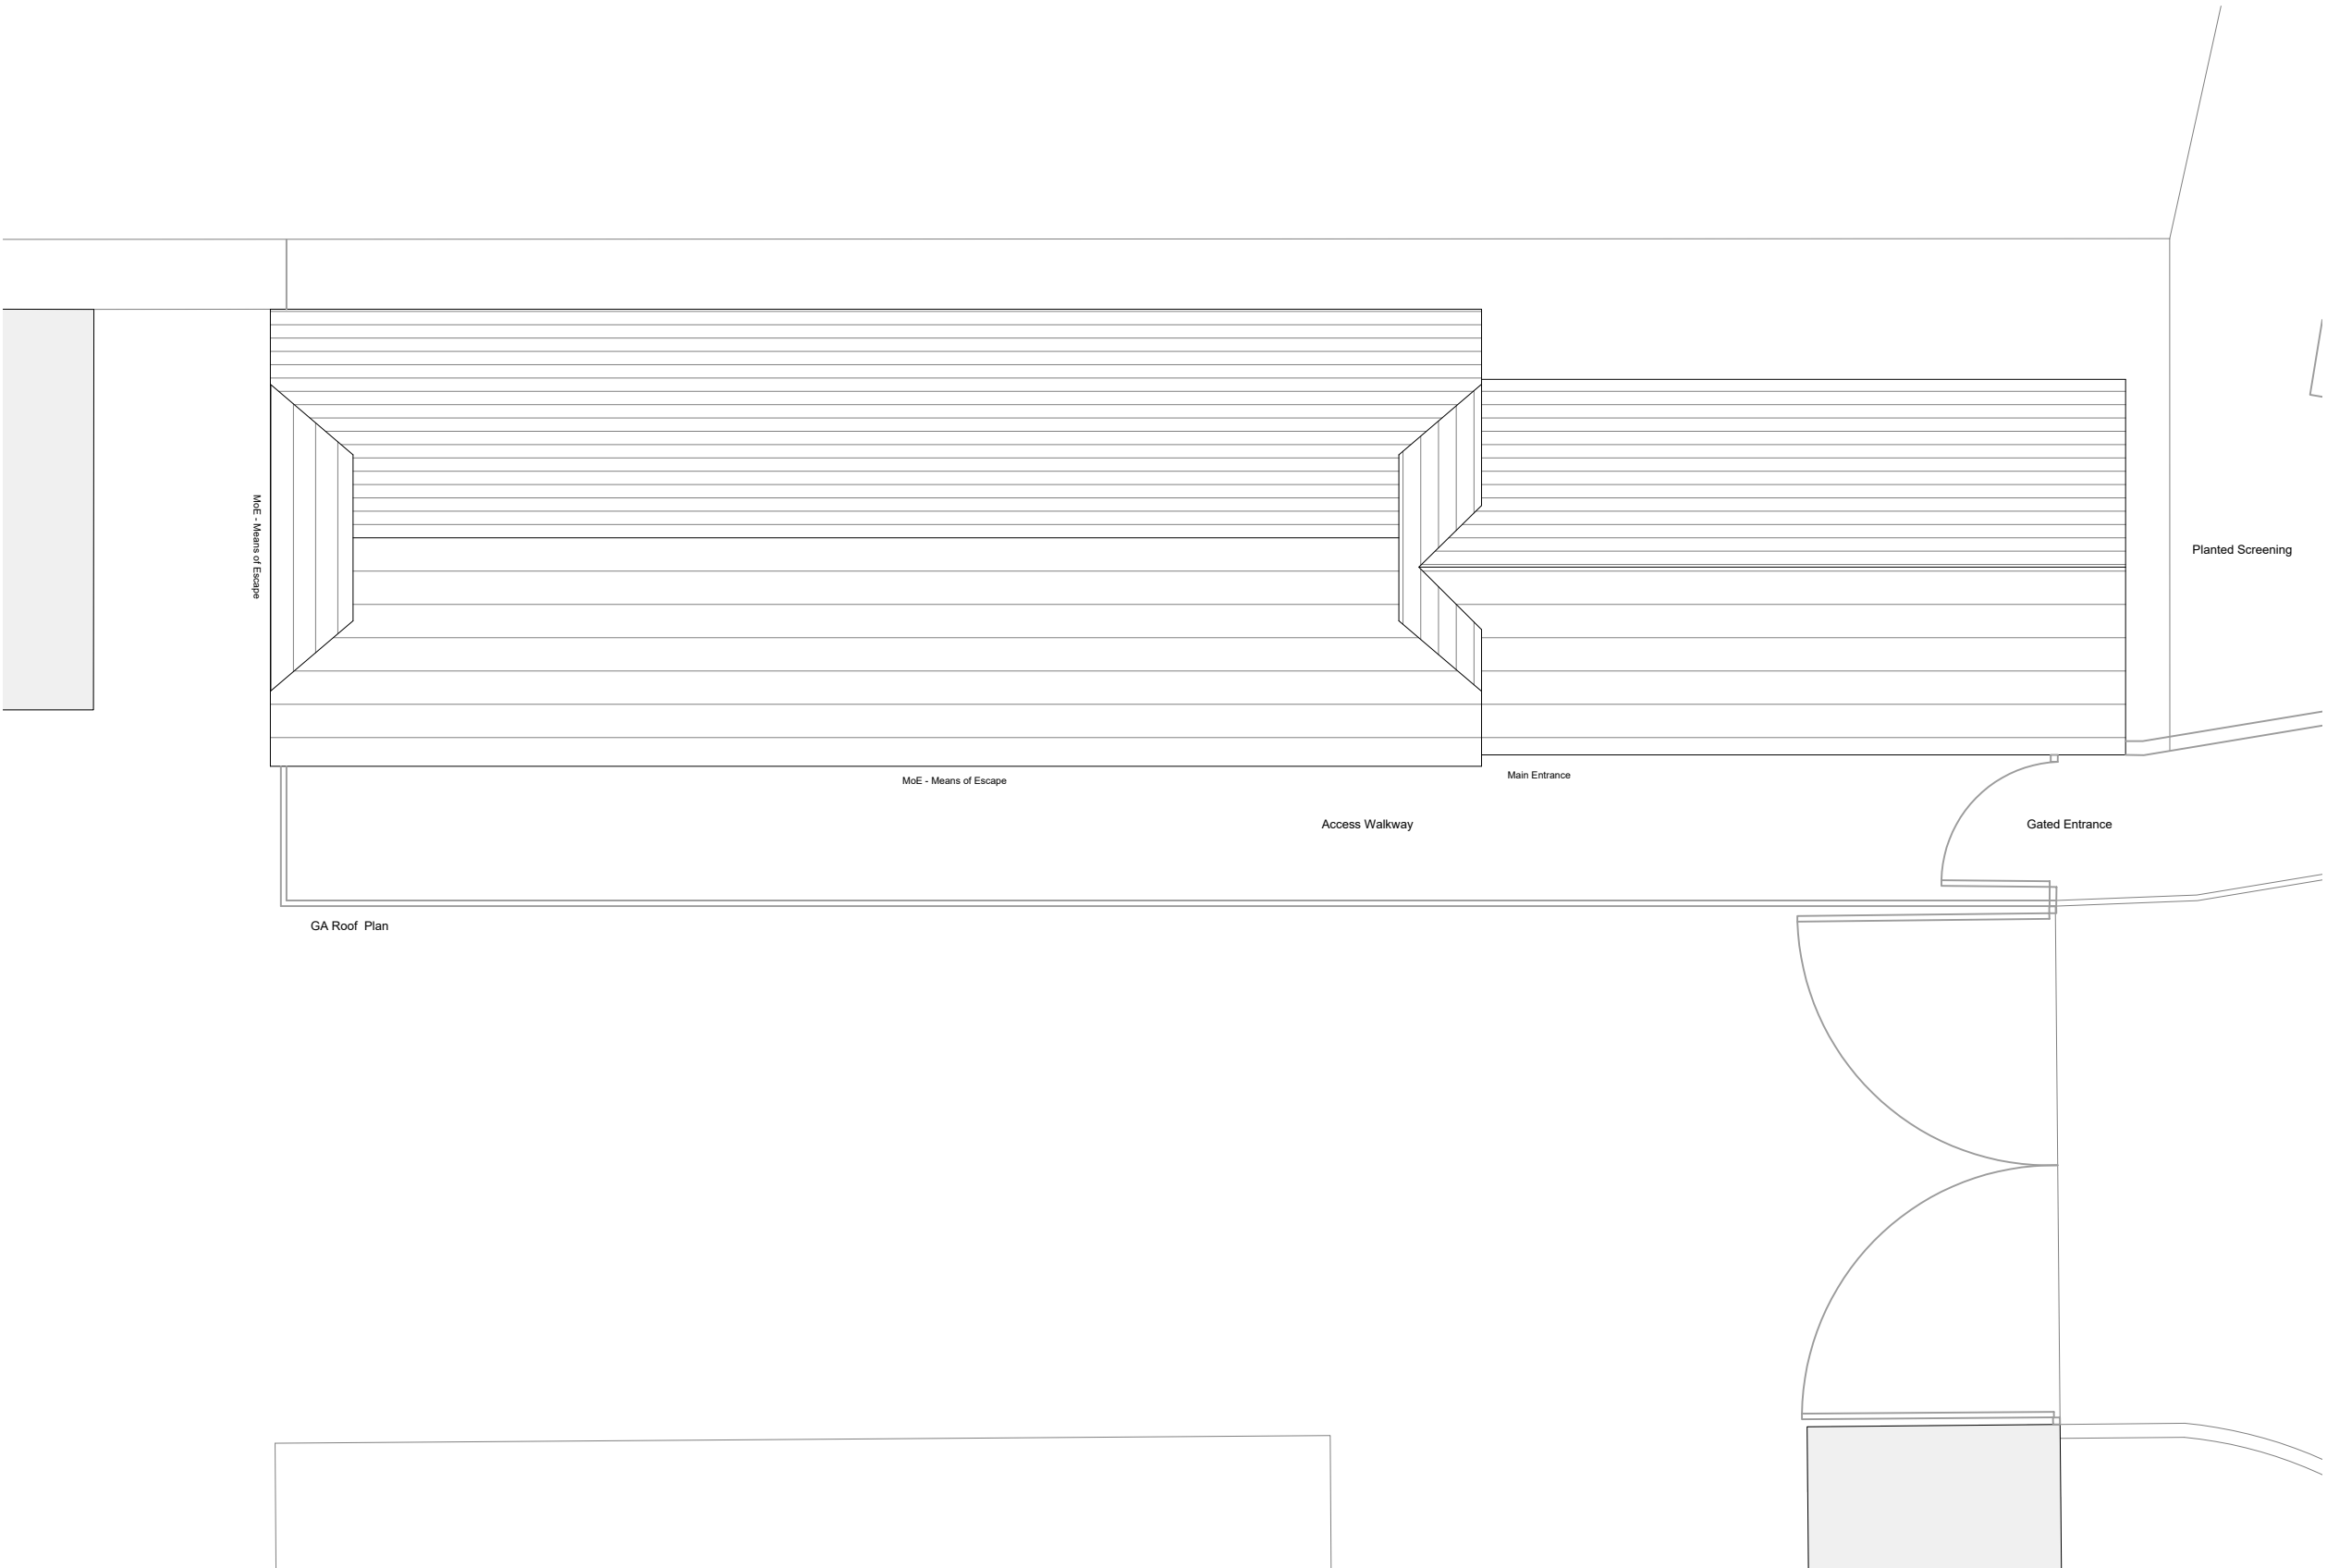

'As Built' Roof Plan

Scale 1:100 @ A3

A Nov'25 AA AT Amended to LPA comments.

Rev	Date	Drm	Chkd	Description
-----	------	-----	------	-------------

Purpose of Issue:
PLANNING

client:
Farley Farms and Estate

project:
Rowes Farm Clubhouse

drawing title:
'As Built' Roof Plan

scale at A3:	date:	drawn by:	checked by:
1:100	Oct 2025	EB	AT

drawing number:	revision:
1612 - PL1211	A

accord
architecture
www.accordarchitecture.com

Abbey House, Arena Business Centre, Farnborough Road, Farnborough, GU14 7NA
[t1] 01483 455100 [t2] 01483 678396 [e] design@accordarchitecture.com