


**Site Boundary**

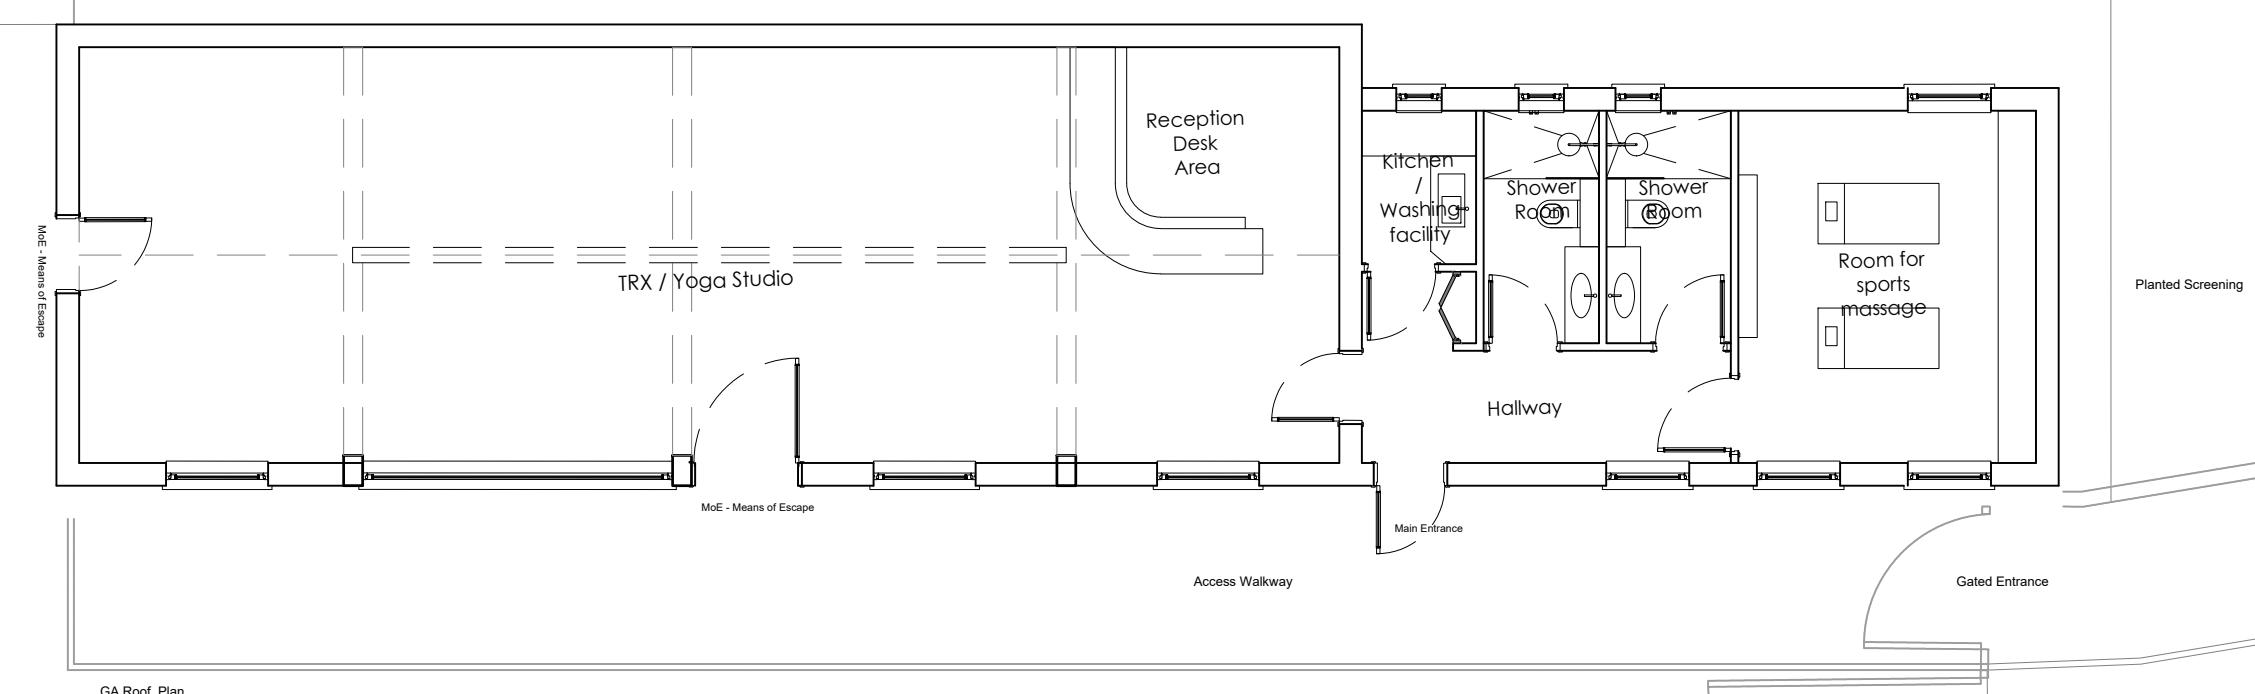

Equine Yard / Livery Yard

Secure Access Gates To  
Equine Yard / Livery Yard

A Nov'25 AA AT Amended to LPA comments.

Rev Date	Drn	Chkd	Description
----------	-----	------	-------------

Purpose of Issue:

PLANNING

client:

Farley Farms and Estate

project:

Rowes Farm Clubhouse

drawing title:

'As Built' Ground Floor Plan

scale at A3: date: drawn by: checked by:

1:100 Oct 2025 EB AT

drawing number:

1612 - PL1210 revision: A