



PLEASE NOTE:  
THESE PLANS MUST NOT BE ACTED UPON UNTIL THE APPROPRIATE  
PLANNING AND BUILDING REGULATION APPROVALS HAVE BEEN GRANTED.  
SHOULD THE WORKS BE UNDERTAKEN PRIOR TO THE ABOVE APPROVALS  
BEING IN PLACE, IT IS DONE SO ENTIRELY AT THE CLIENTS OWN RISK.



AS BUILT SIDE ELEVATION

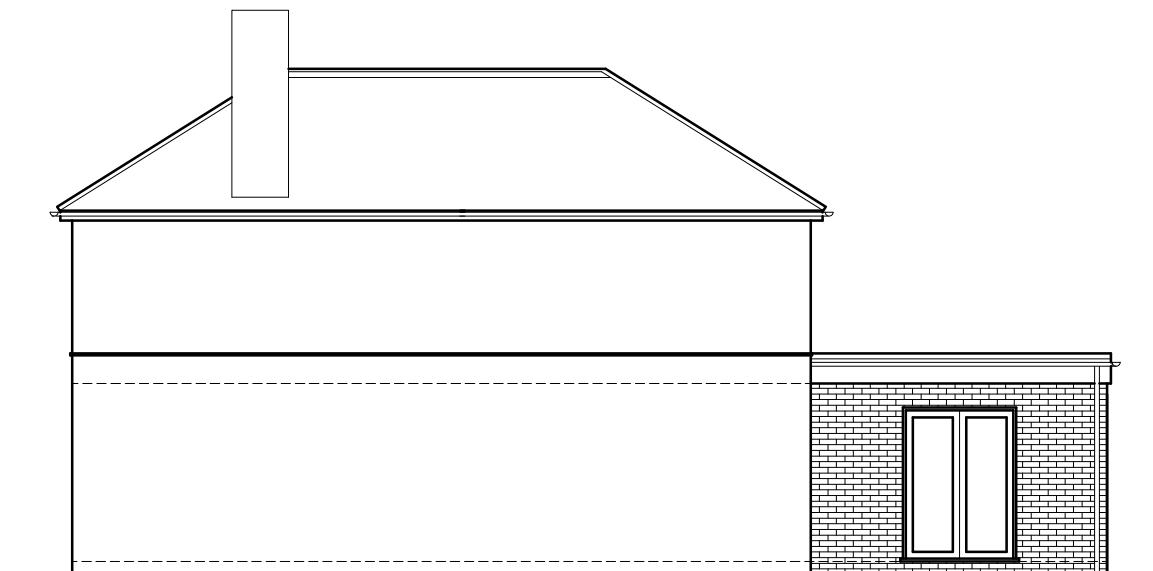

AS BUILT REAR ELEVATION

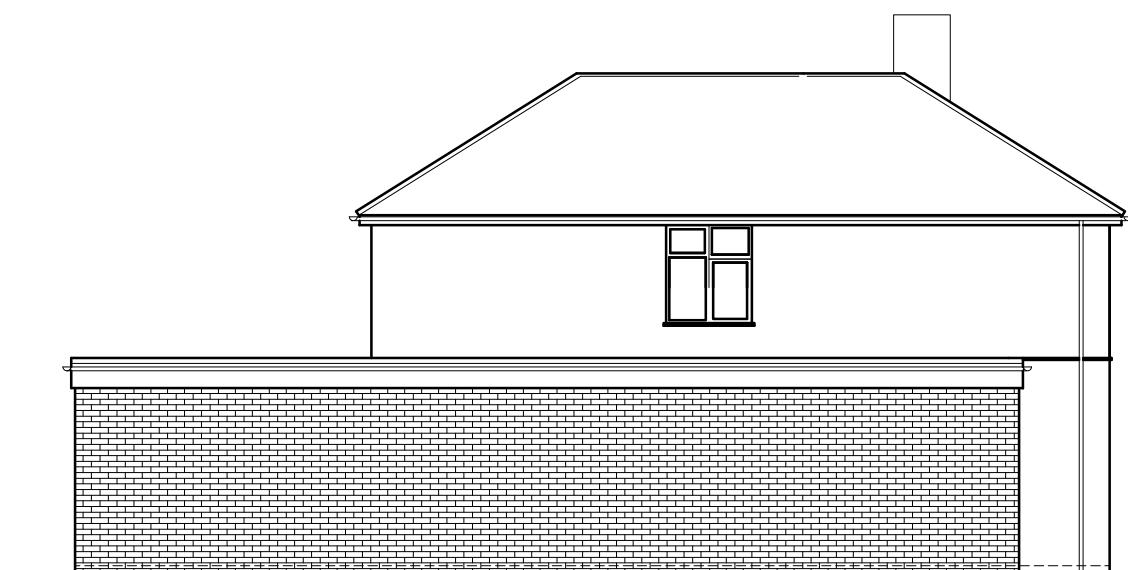

AS BUILT SIDE ELEVATION



AS BUILT FRONT ELEVATION

0 0.5 1 1.5 2 3 4 5m  
SCALE 1:100

PROJECT: 384 LONDON ROAD EARLEY READING RG6 1BA	DRAWING TITLE: AS BUILT ELEVATIONS	CREATIVE DESIGN & STRUCTURE	DRAWN: EB SCALE: 1:100 @ A3 DATE: APRIL 2024 STATUS: PLANNING	DRAWING NO. 31522-13	REV. A
---	---------------------------------------	--------------------------------	--	-------------------------	-----------