

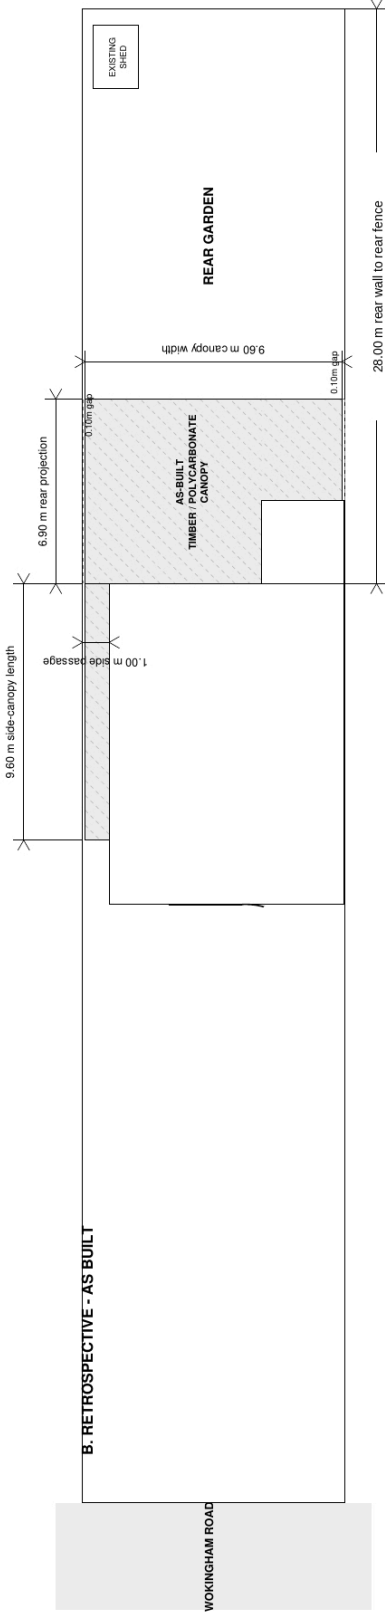


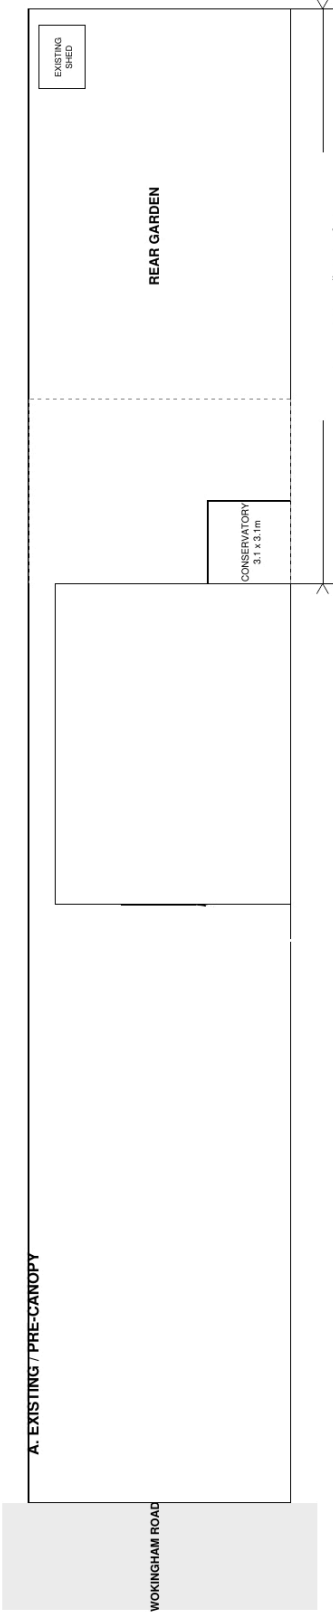

Key measured dimensions: rear canopy 9.60m wide x 6.90m projection, side canopy 9.60m long, side passage 1.00m, boundary gaps 0.10m, conservatory 3.10m x 3.10m, rear garden 28.00m.

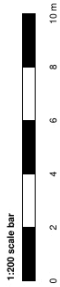

Retrospective retention of attached timber pergola / canopy 404 Wokingham Road, Earley, Reading, RG6 7HX Existing & As-Built Site / Ground Plan Dimensions in metres unless stated. Drawings based on applicant measured sketch, supplied floorplan and site photographs.	DRAWING NO. P-02 STATUS PLANNING - RETROSPECTIVE / AS BUILT	SCALE 1:200 @ A3 DATE 07 September 2026	REV B SHEET A3
---	---	---	--