




EAST ELEVATION

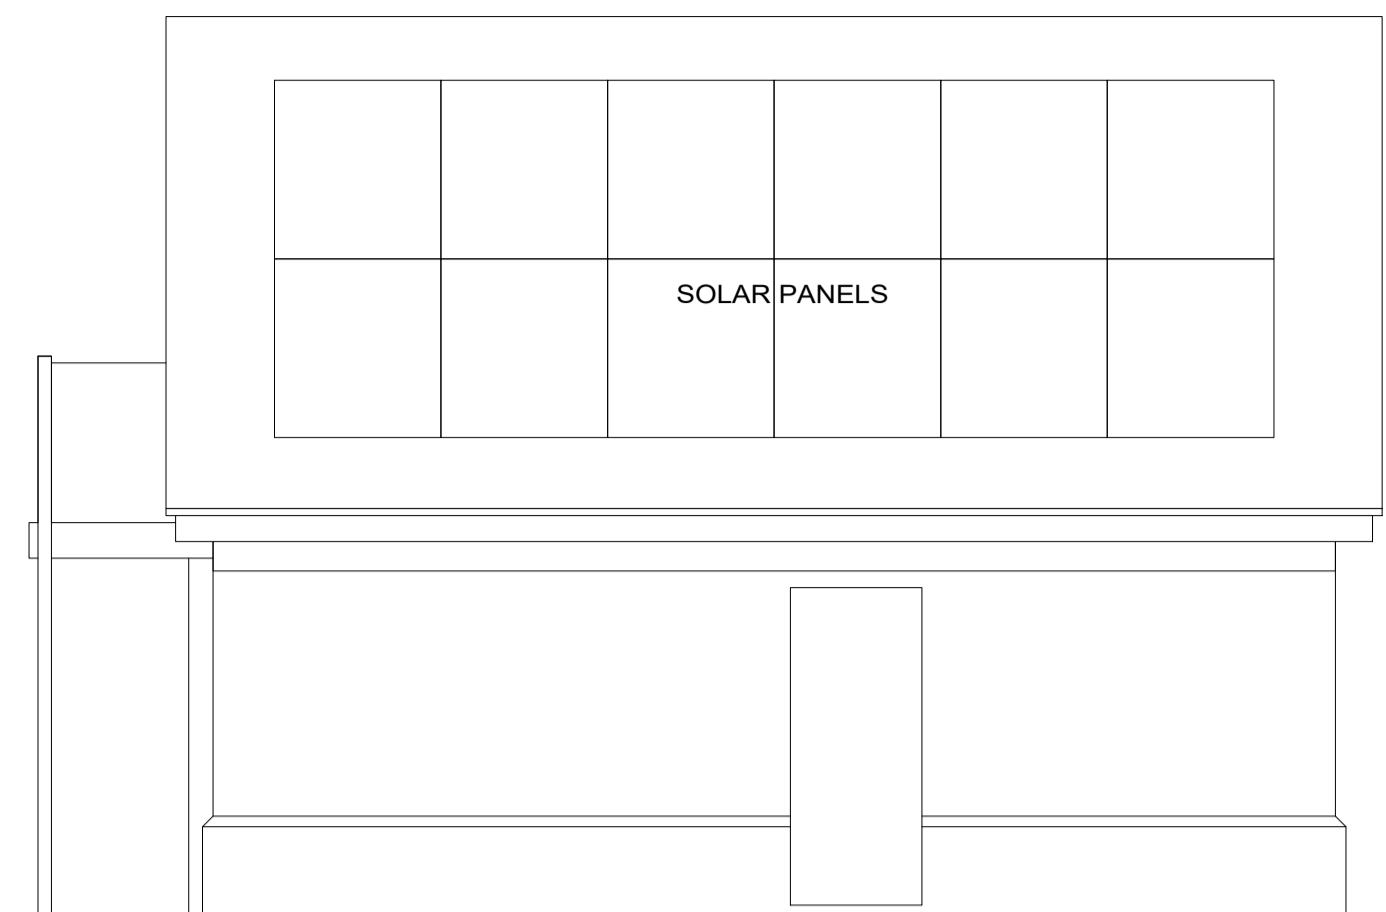

SOUTH ELEVATION

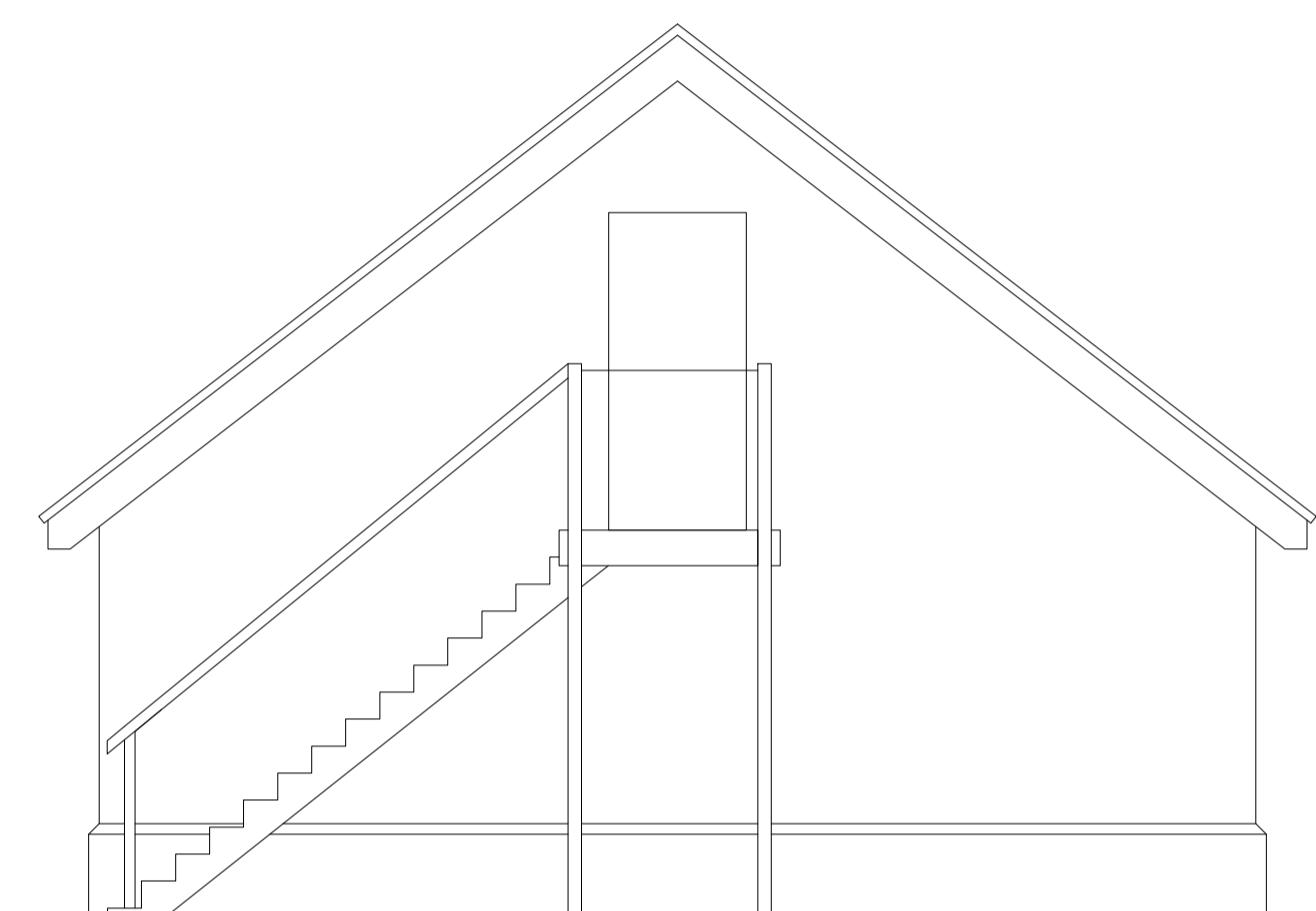


WEST ELEVATION

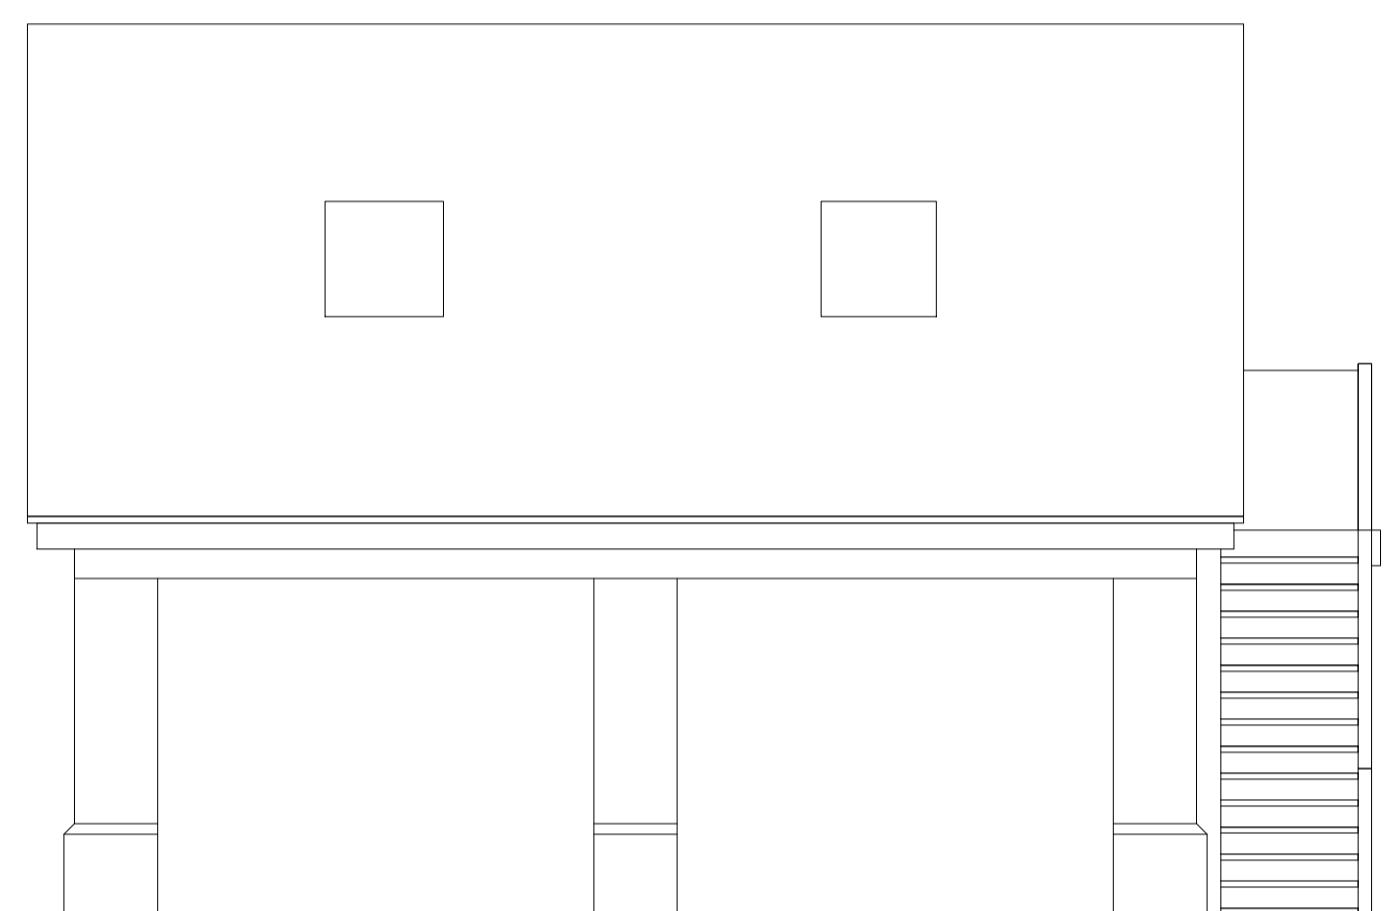


NORTH ELEVATION



1:50 scale Bar
This Drawing has been produced for printing onto A1 size paper.
If printing on A3 please use the scale below for reference.
0m 0.25m 0.5m 1m 2m 4m

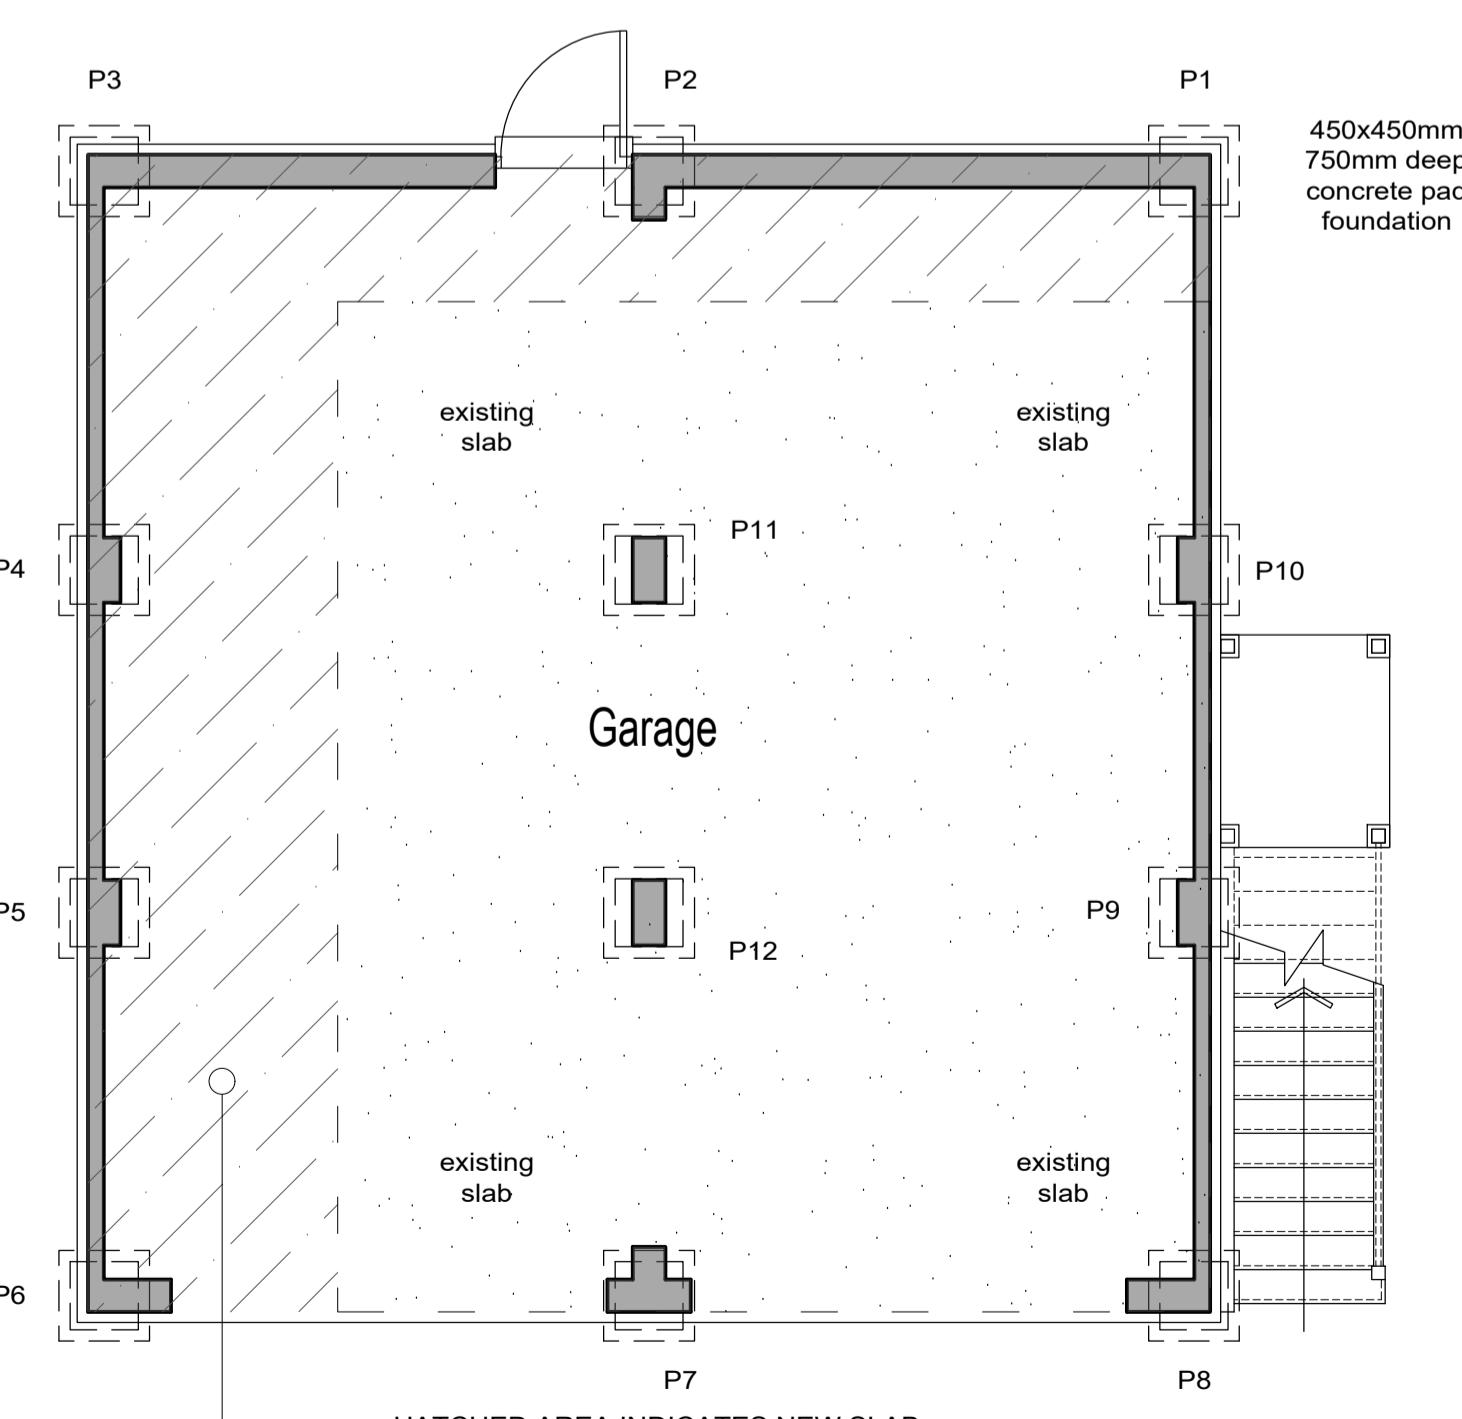

As built Garage Plan

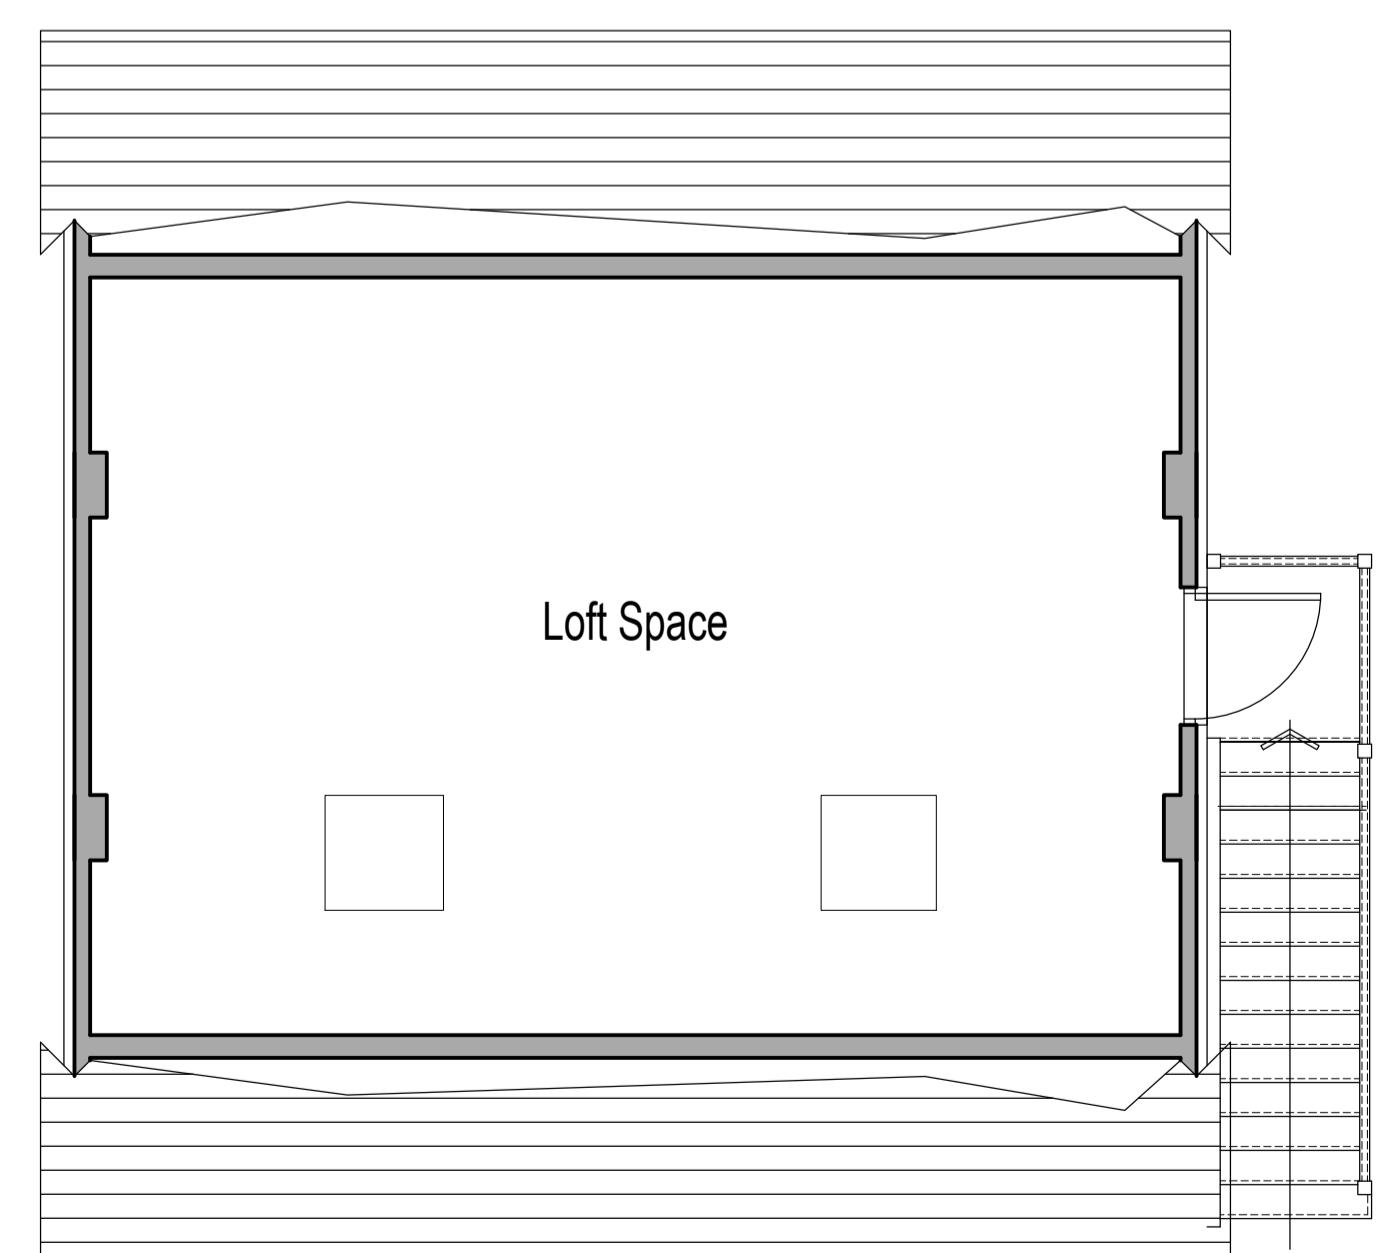

As built Loft Plan

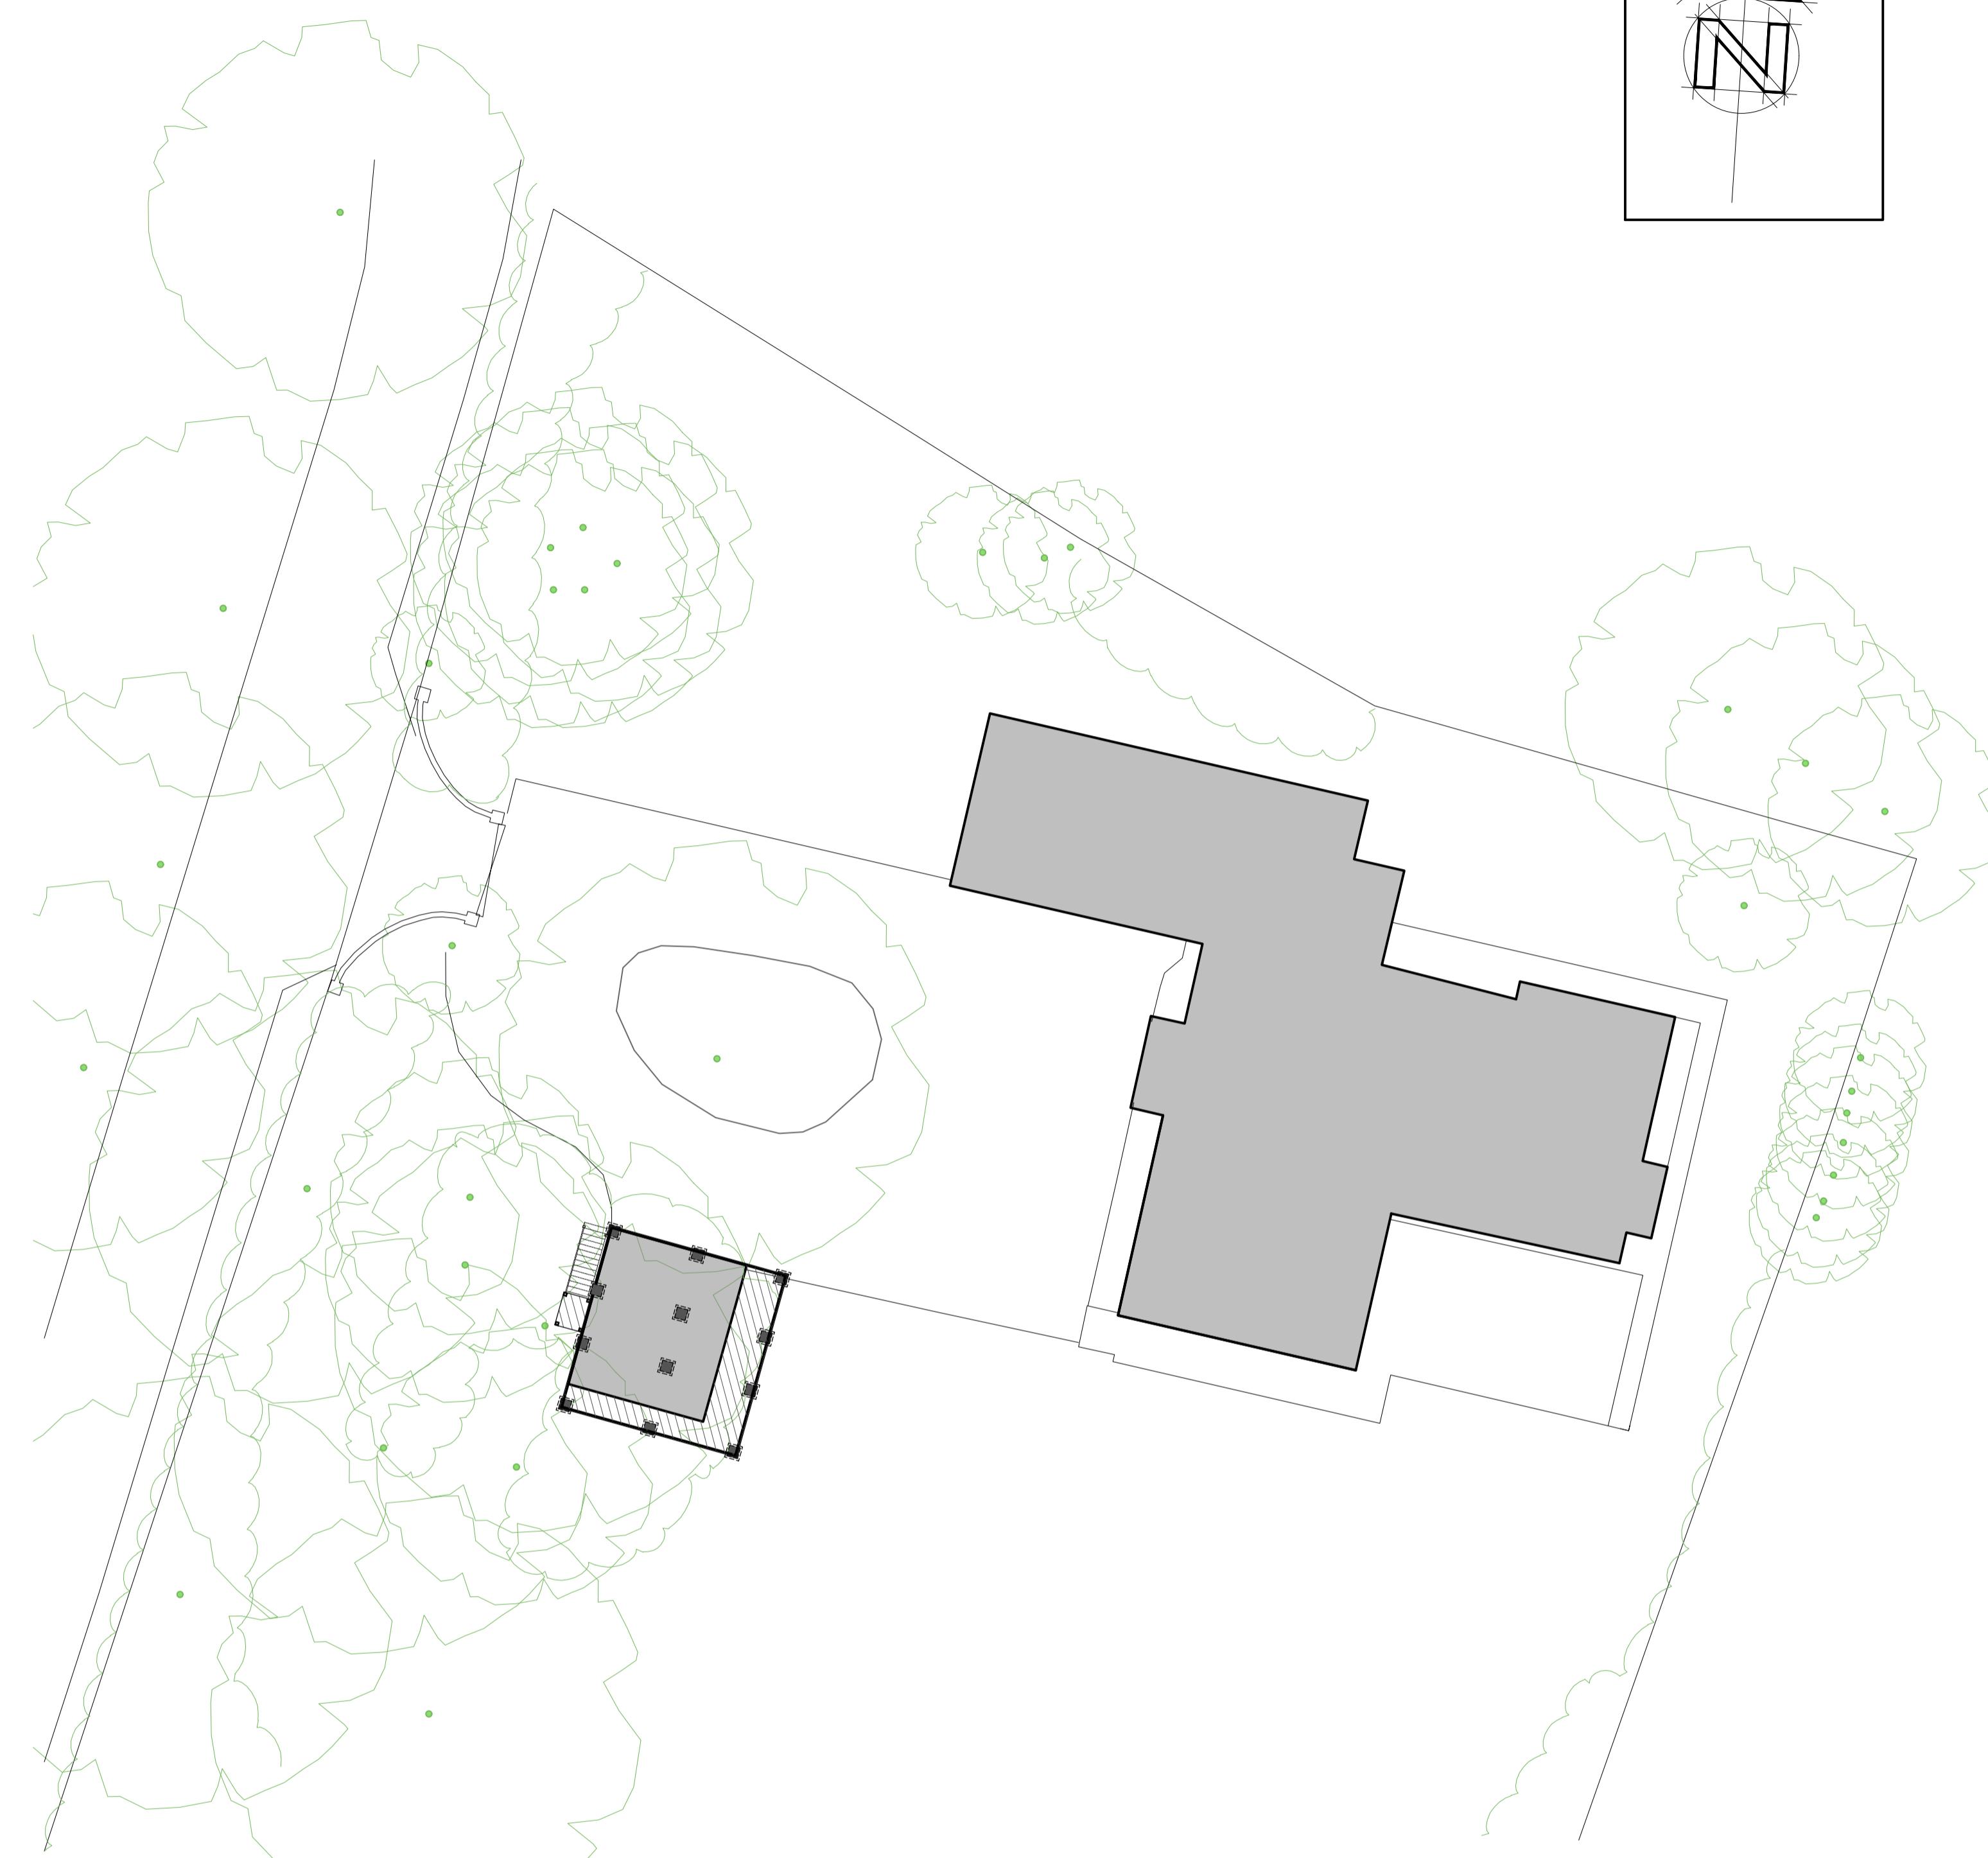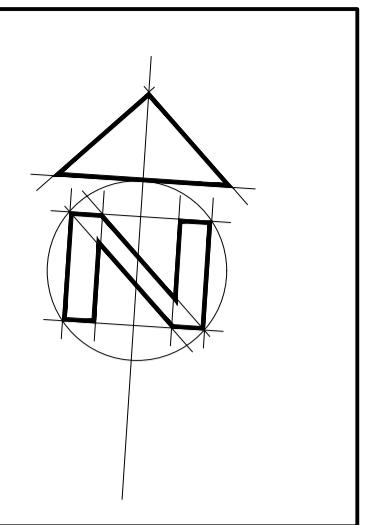

EXISTING SITE PLAN - (AS BUILT)

1:200 scale Bar
This Drawing has been produced for printing onto A1 size paper.
If printing on A3 please use the scale below for reference.
0m 0.25m 0.5m 1m 2m 4m 8m 16m

A	notes, hatched area added	05-01-26
REV	COMMENTS	DATE

SHAUN TANNER
ARCHITECTURE & PLANNING
www.sttarchitecture.co.uk studio@sttarchitecture.co.uk 0118 989 0808

CLIENT Mr M. Tongue
PROJECT LONGMORE COTTAGE, PARK LANE,
FINCHAMPSTEAD, RG40 4PT
DRAWING Existing Garage (As built) - Site and other plans
STATUS survey
SCALE 1:100 @ A1 DRAWN DN CHECKED NO 4003/300 REV A
DATE Sept 2025

THIS DRAWING MUST NOT BE SCALED UNLESS ISSUED FOR PLANNING PURPOSES. ALL DIMENSIONS ARE TO BE VERIFIED PRIOR TO SETTING OUT.
COMMENCING WORK OR PRODUCTION OF FABRICATION DRAWINGS. REPORT ANY DISCREPANCIES TO THE SUPERVISING OFFICER IMMEDIATELY.