




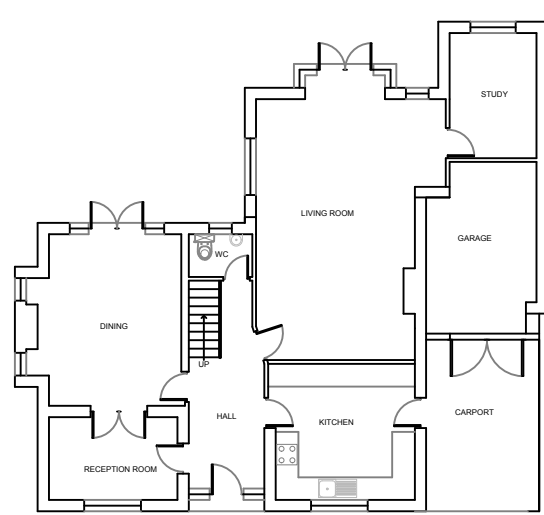

PRE-EXISTING GROUND FLOOR PLAN

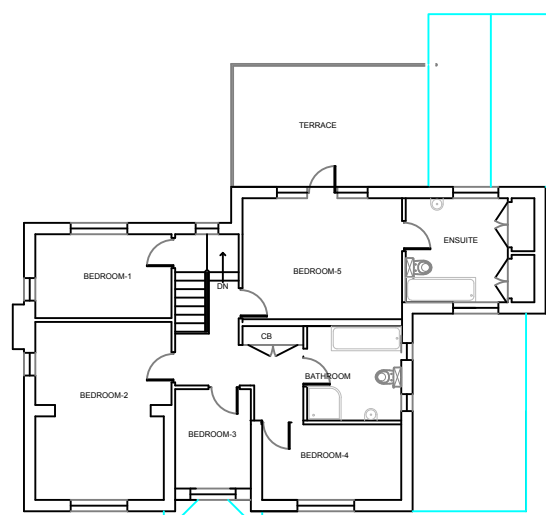

PRE-EXISTING FIRST FLOOR PLAN

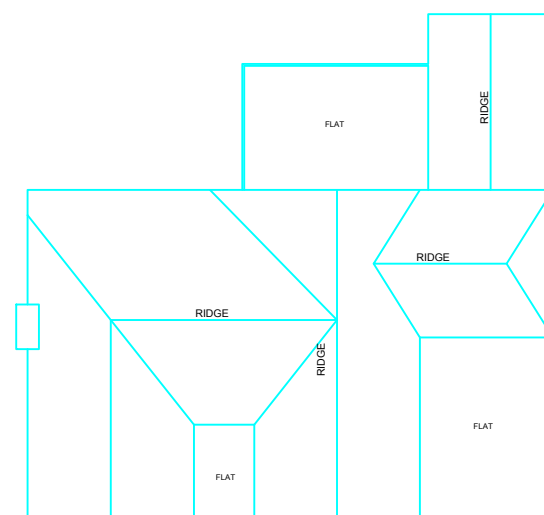

PRE-EXISTING ROOF PLAN




PRE-EXISTING FRONT ELEVATION





PRE-EXISTING SIDE-1 ELEVATION



PRE-EXISTING REAR ELEVATION

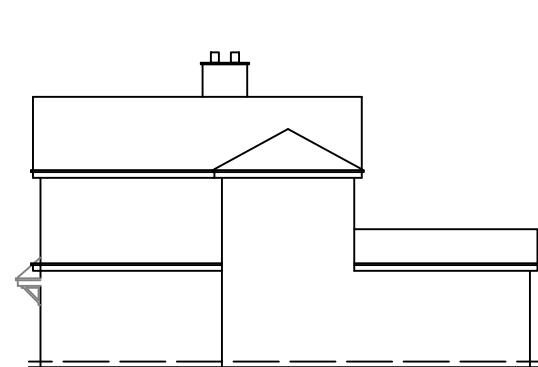

PRE-EXISTING SIDE-2 ELEVATION

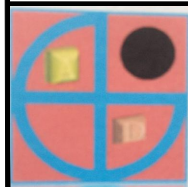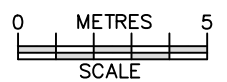


PROJECT:
PROPOSED Changes to Fenestration & Misc. Alterations

**68 Beech Lane
Earley**


DRAWN BY:	P.S.
DATE:	21/08/2026
SCALE:	1:200@A3
FILENAME:	22004

DRAWING TITLE:	
PRE-EXISTING PLANS & ELEVATIONS	
DRAWING NUMBER:	BL-02



ArchDezine Limited
archdeziner7@gmail.com

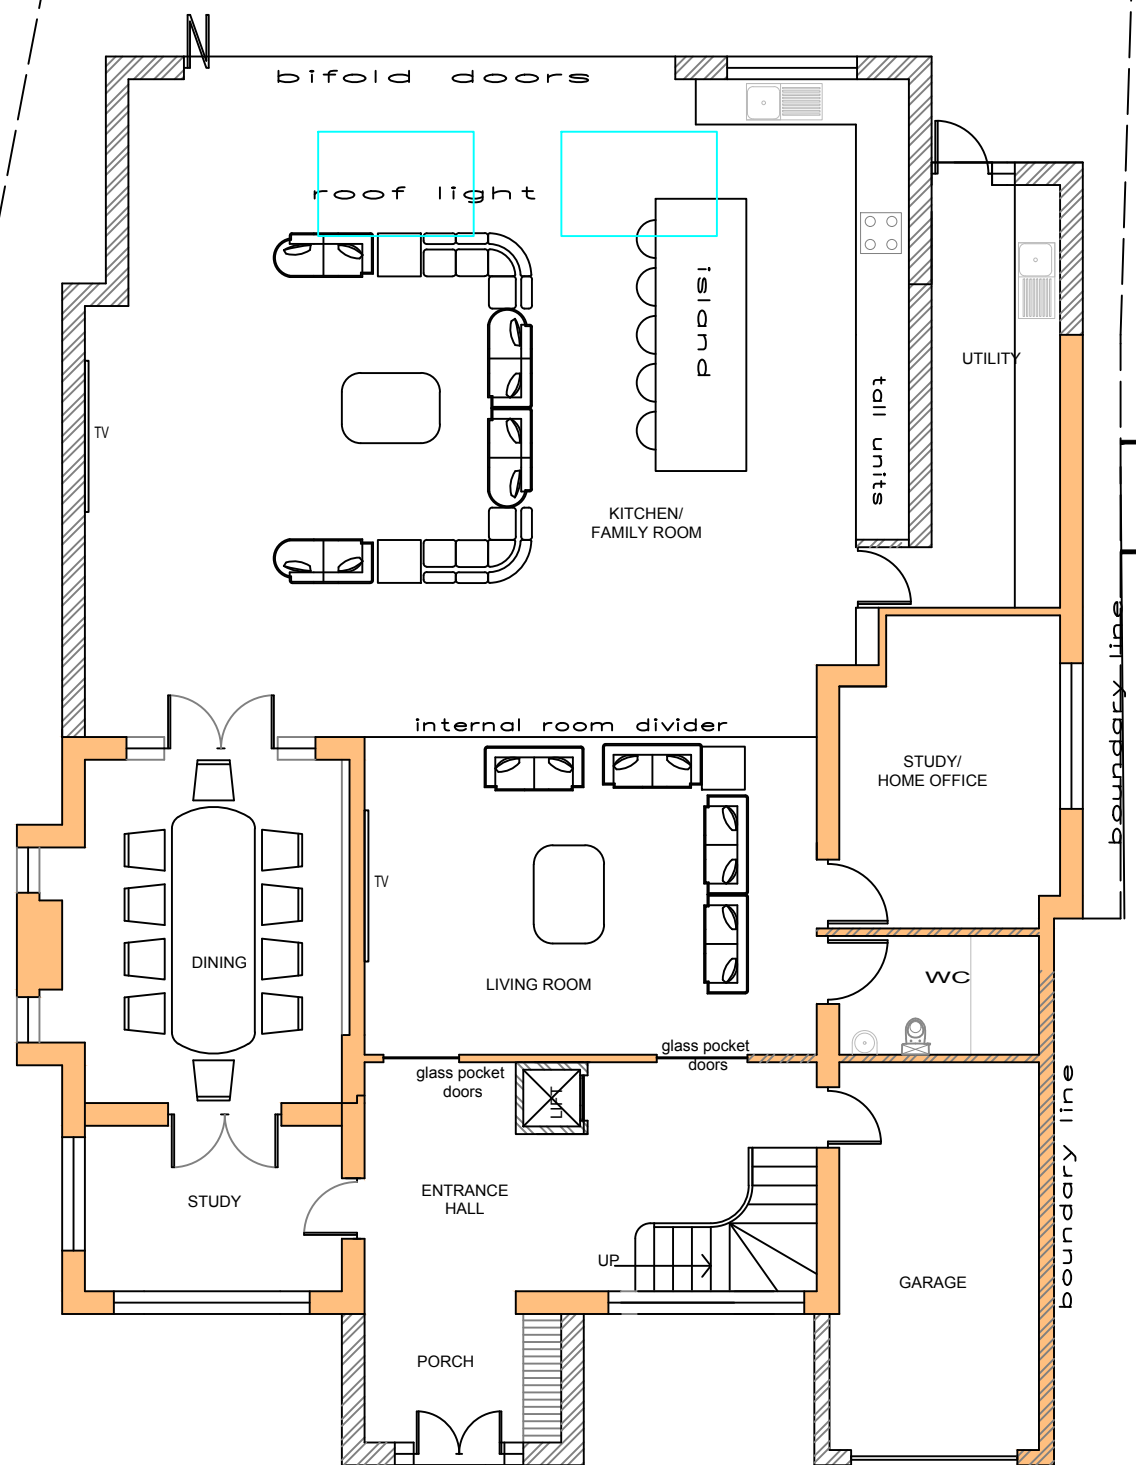

APPROVED GROUND FLOOR PLAN

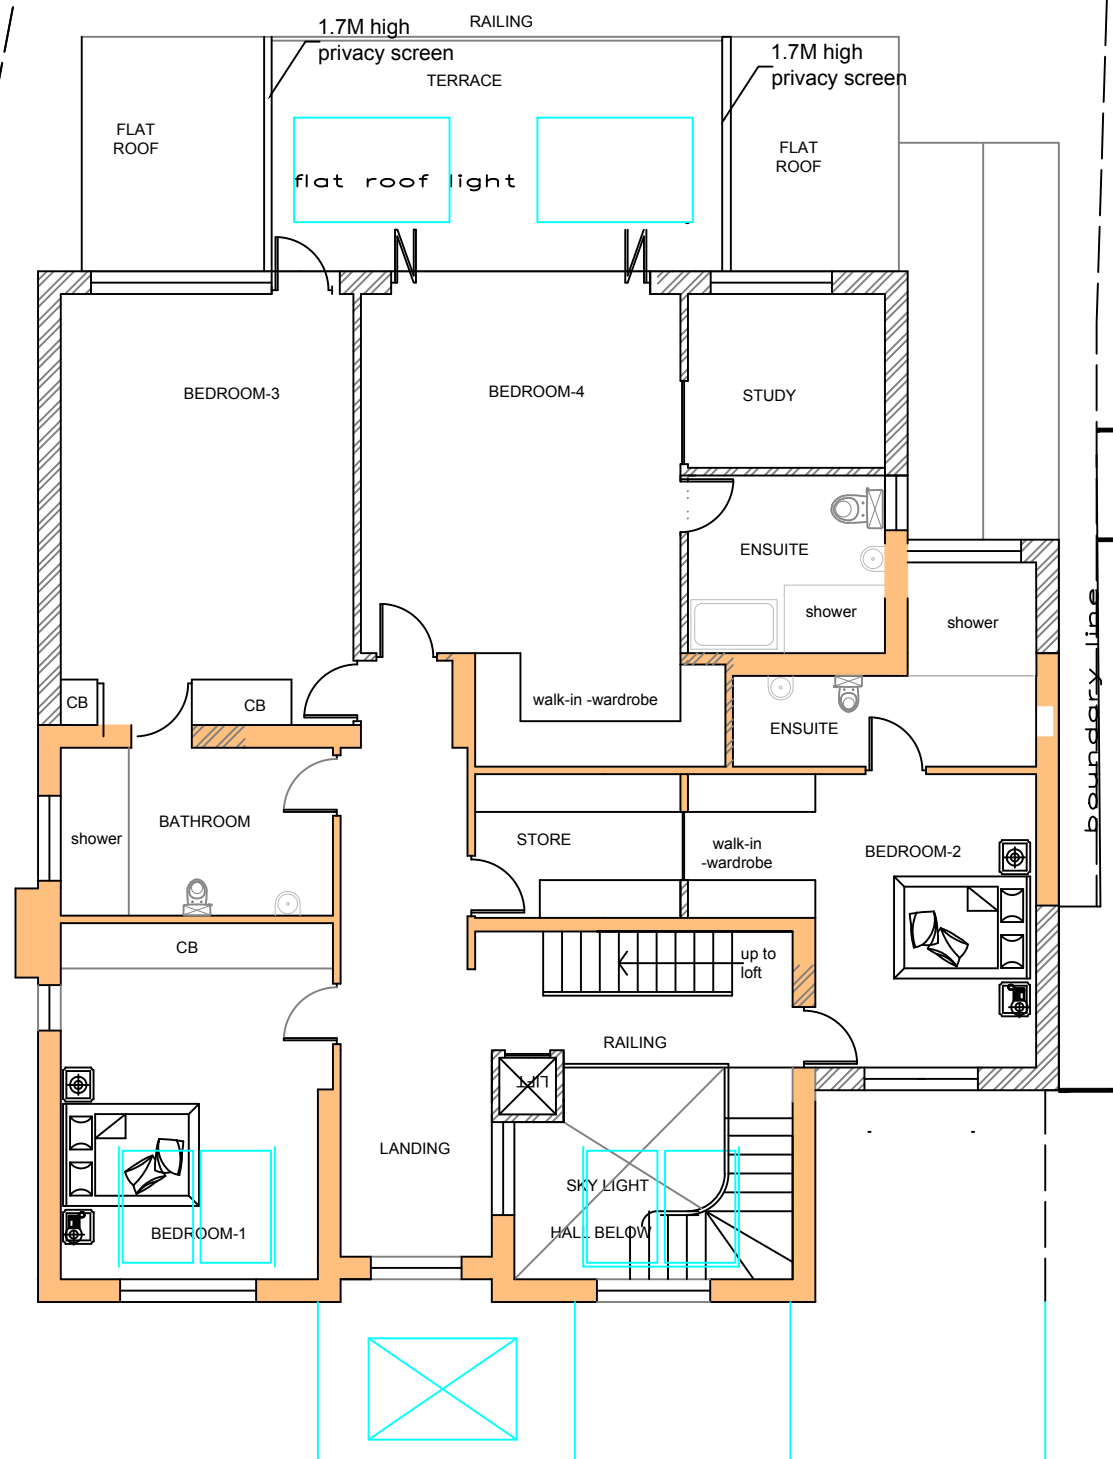

APPROVED FIRST FLOOR PLAN

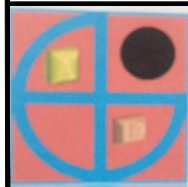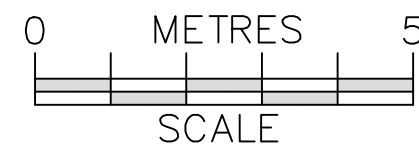





PROJECT:
PROPOSED Changes to Fenestration & Misc. Alterations

**68 Beech Lane
Earley**

DRAWN BY: P.S.
DATE: 21/08/2026
SCALE: 1:100@A3
FILENAME: 22004

DRAWING TITLE:
APPROVED PLANS
DRAWING NUMBER: BL-03

ArchDezine Limited
archdeziner7@gmail.com

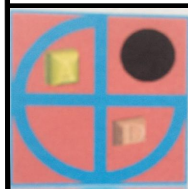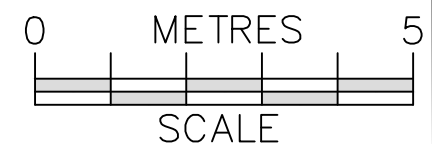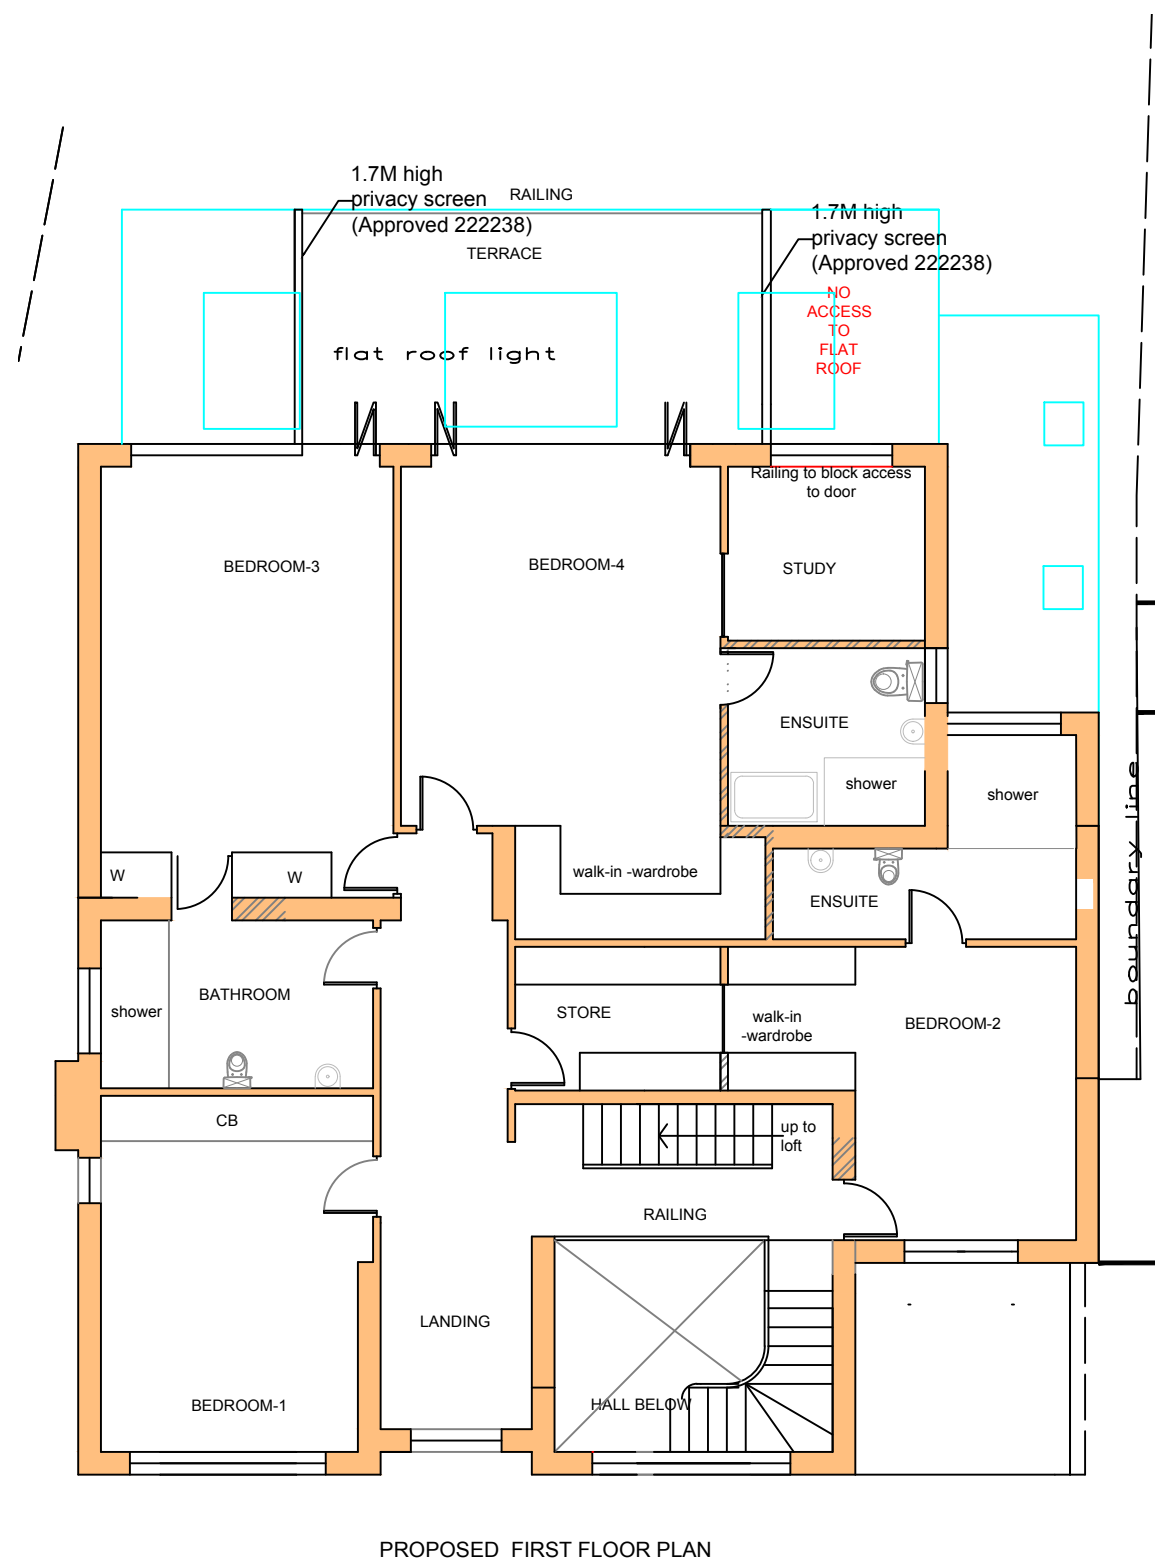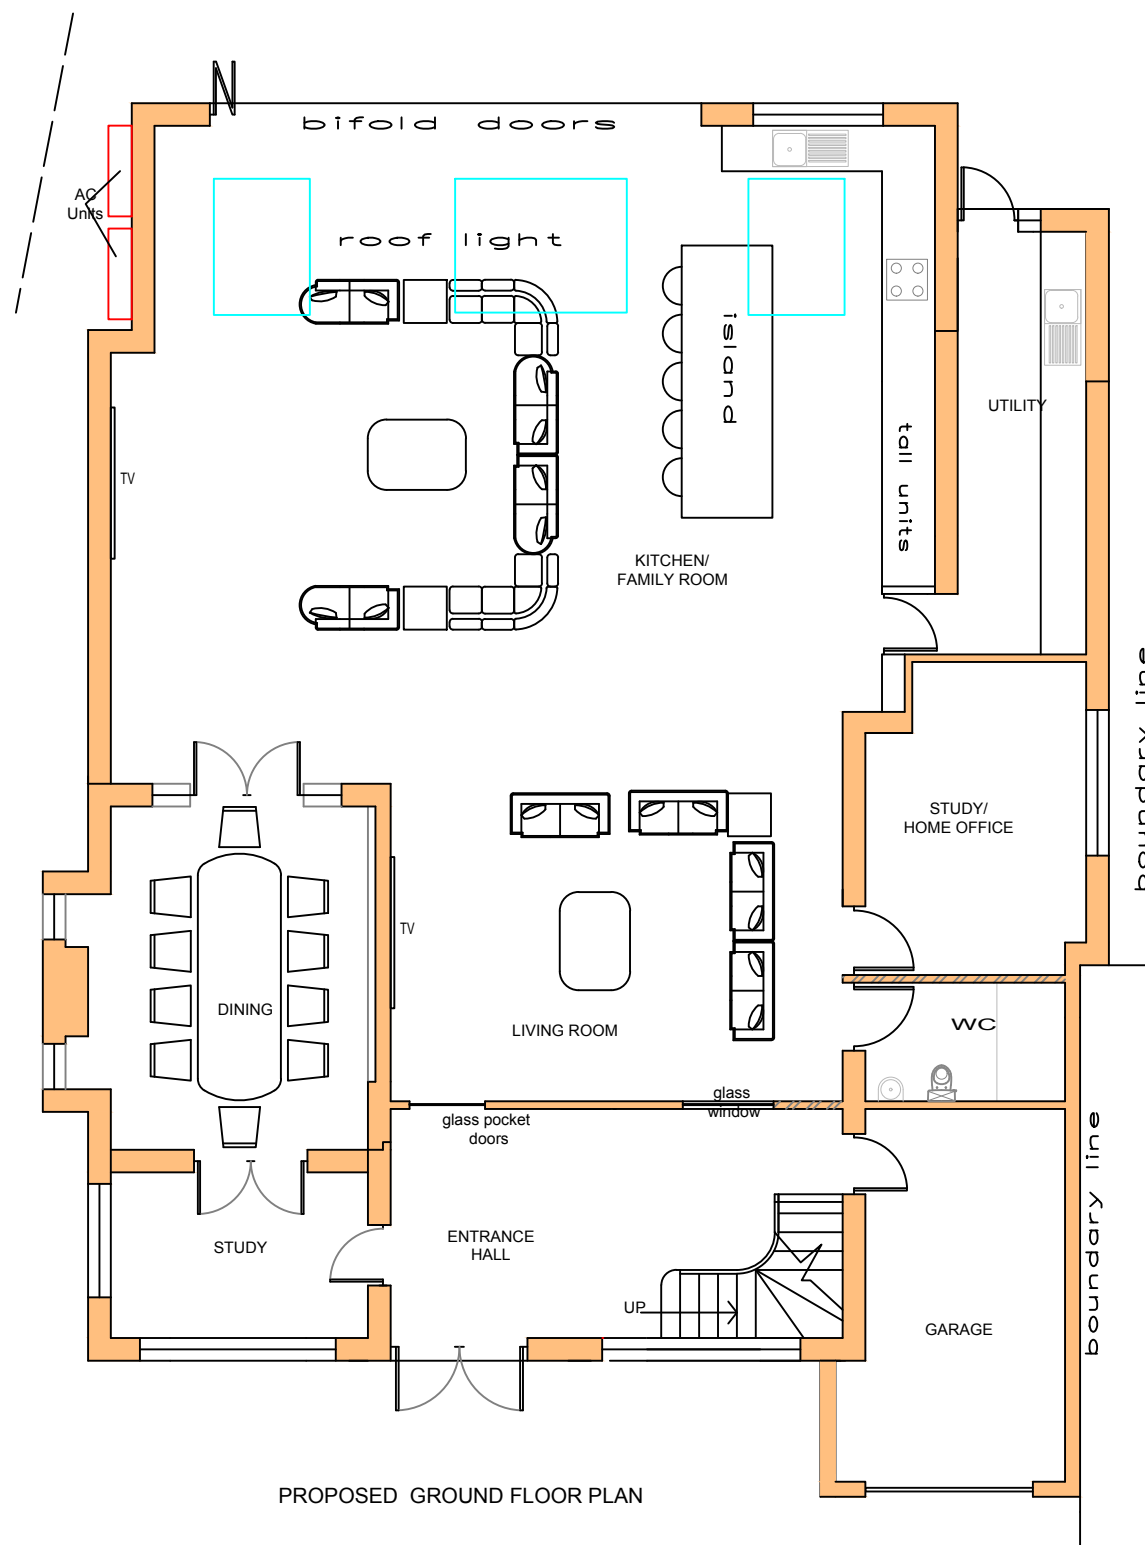


PROJECT:
PROPOSED Changes to Fenestration & Misc. Alterations

**68 Beech Lane
Earley**



DRAWN BY: P.S.
DATE: 21/08/2026
SCALE: 1:100@A3
FILENAME: 22004

DRAWING TITLE:
PROPOSED PLANS
DRAWING NUMBER: BL-04

ArchDezine Limited
archdeziner7@gmail.com

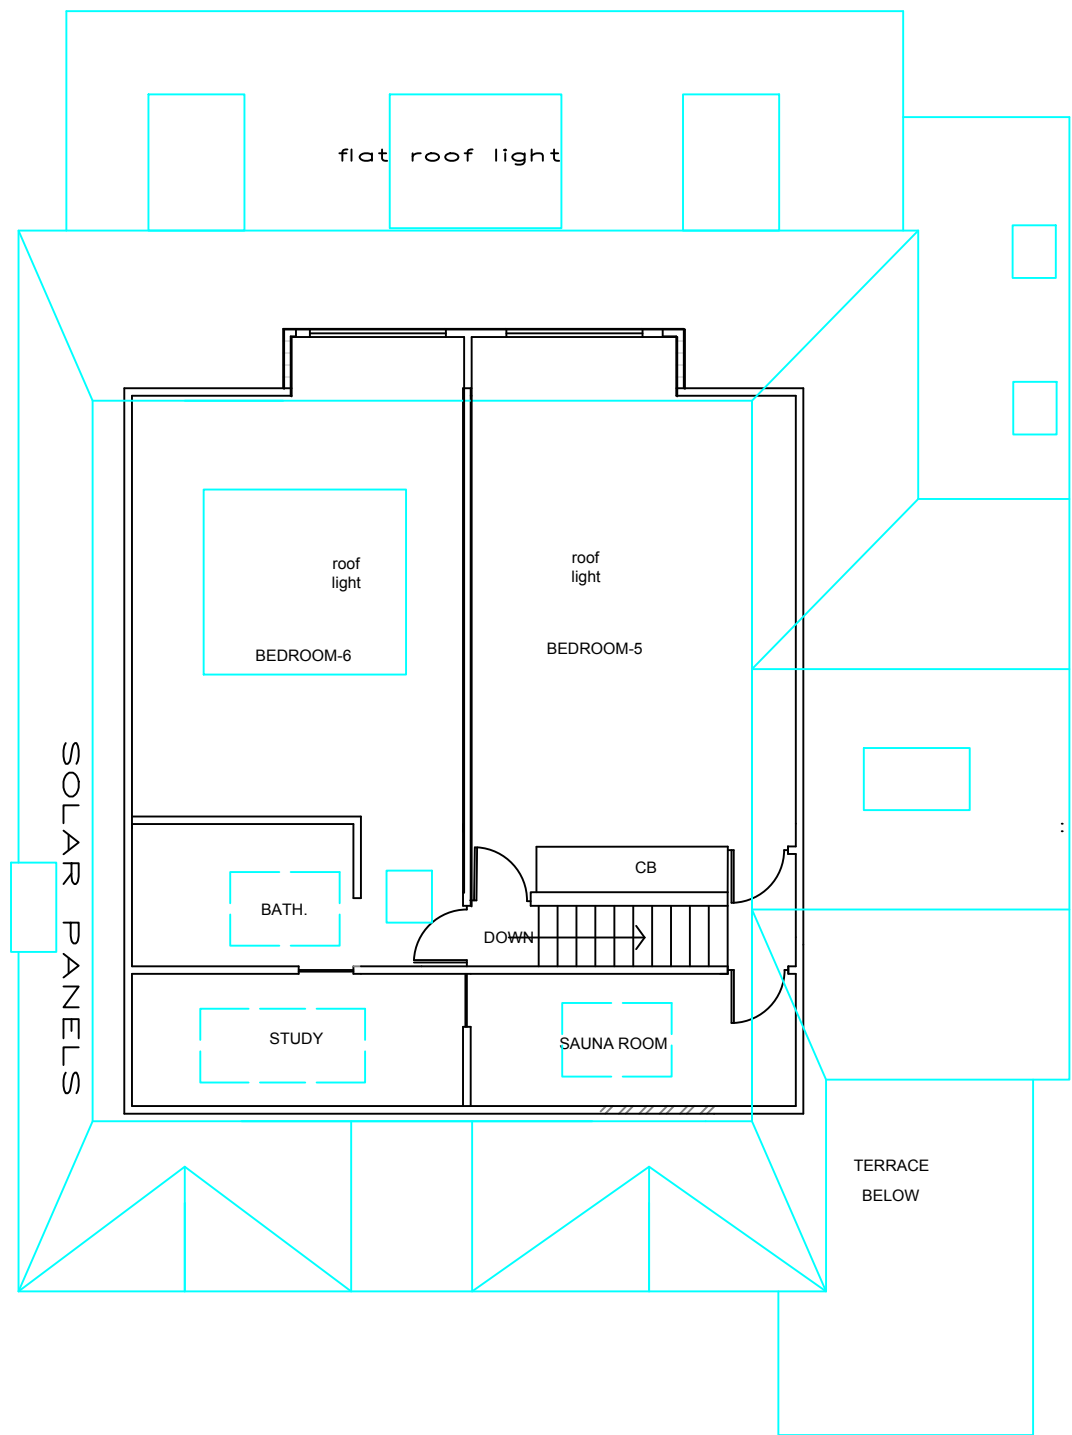

PROPOSED LOFT FLOOR PLAN

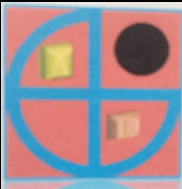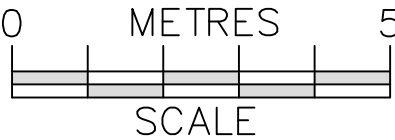

PROJECT:
PROPOSED Changes to Fenestration & Misc. Alterations

**68 Beech Lane
Earley**


DRAWN BY:	P.S.
DATE:	21/08/2026
SCALE:	1:100@A3
FILENAME:	22004

DRAWING TITLE:	
PROPOSED LOFT FLOOR PLAN	
DRAWING NUMBER:	BL-05

ArchDezine Limited
archdeziner7@gmail.com



APPROVED FRONT ELEVATION

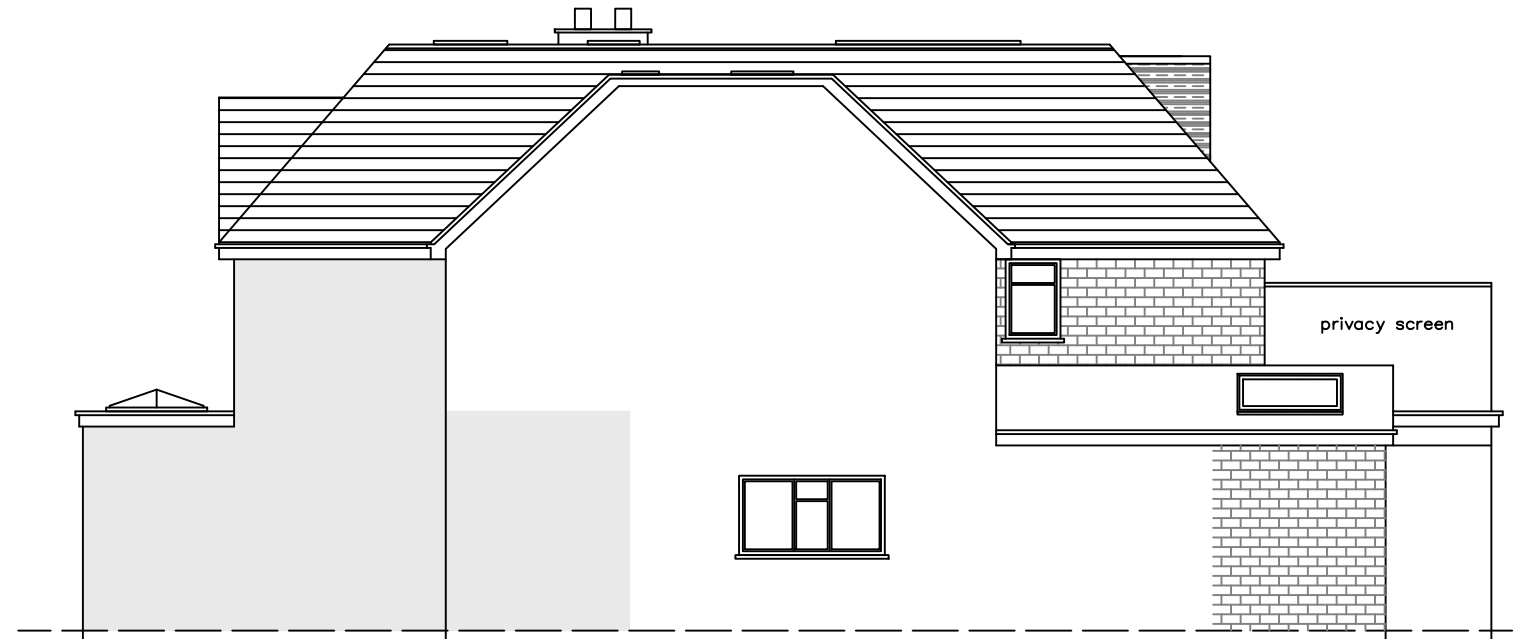



APPROVED SIDE-2 ELEVATION



APPROVED REAR ELEVATION



APPROVED SIDE-1 ELEVATION

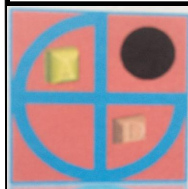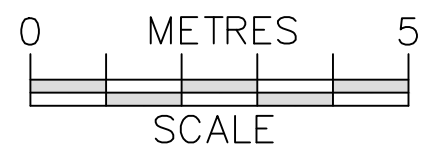

PROJECT:
PROPOSED Changes to Fenestration & Misc. Alterations


68 Beech Lane
Earley

DRAWN BY: P.S.
DATE: 21/08/2026
SCALE: 1:100@A3
FILENAME: 22004


DRAWING TITLE:
APPROVED Elevations

DRAWING NUMBER: BL-07


ArchDezine Limited
archdeziner7@gmail.com

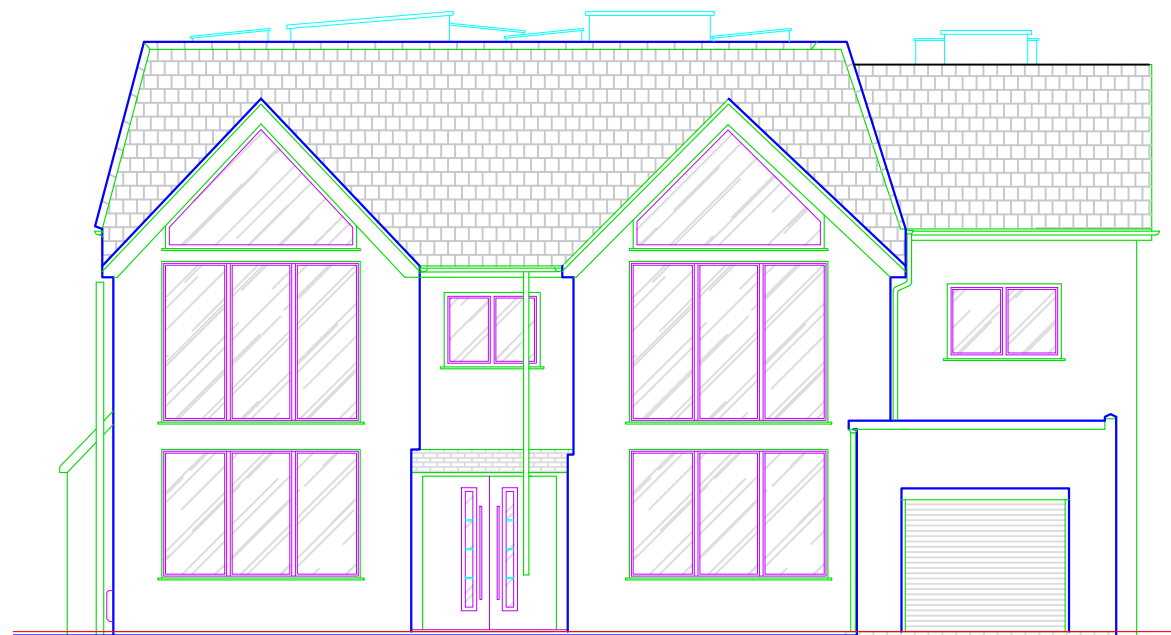


PROPOSED FRONT ELEVATION

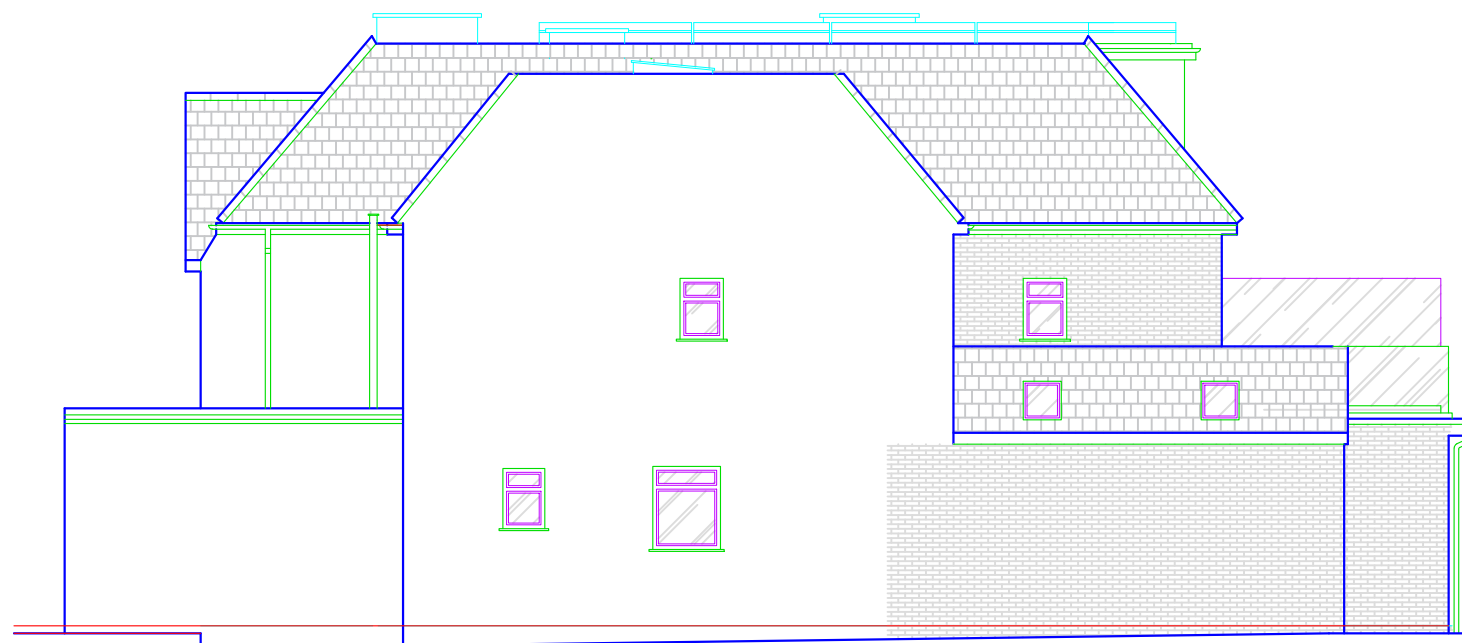


PROPOSED SIDE-2 ELEVATION

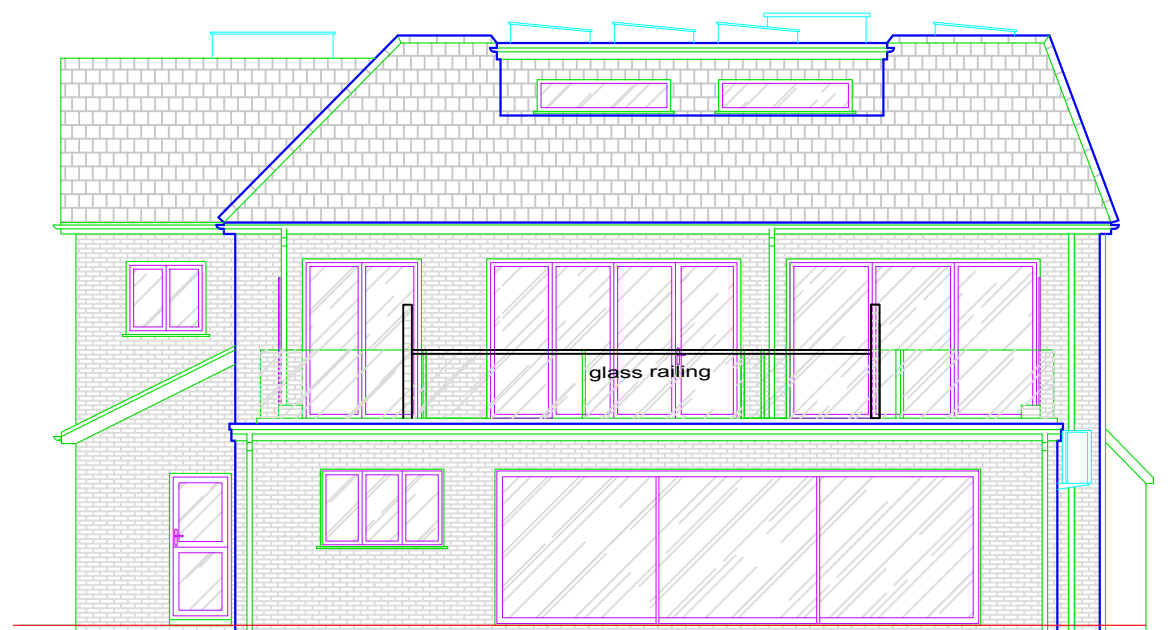


PROPOSED REAR ELEVATION

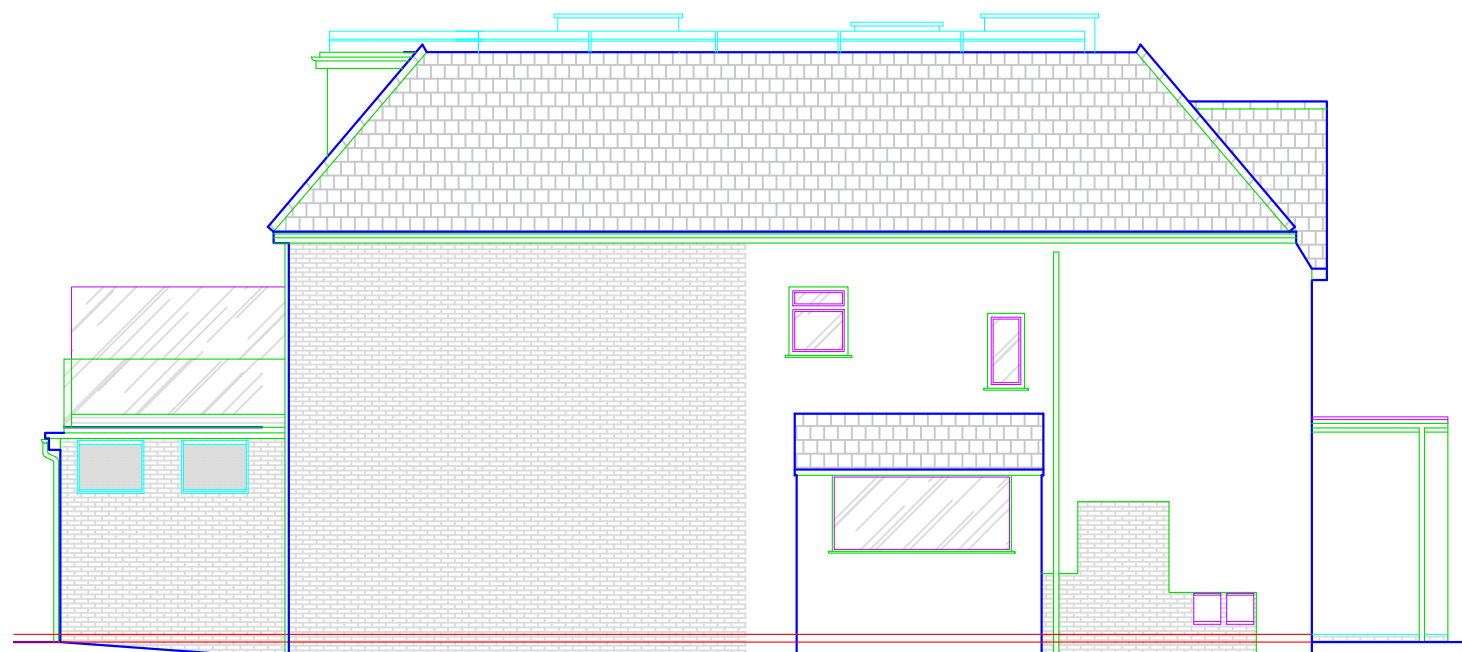

PROPOSED SIDE -1ELEVATION

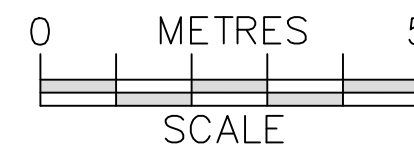

THESE 'AS BUILT' ELEVATIONS HAVE BEEN SURVEYED AND PREPARED BY A THIRD PARTY SURVEYOR INSTRUCTED BY THE APPLICANT

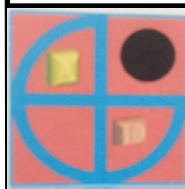

PROJECT:
PROPOSED Changes to Fenestration & Misc. Alterations

**68 Beech Lane
Earley**

DRAWN BY:	P.S.
DATE:	21/08/2026
SCALE:	1:100@A3
FILENAME:	22004

DRAWING TITLE: AS BUILT –Proposed Elevations	
---	--

DRAWING NUMBER:	BL–07
-----------------	-------

ArchDezine Limited
archdeziner7@gmail.com