



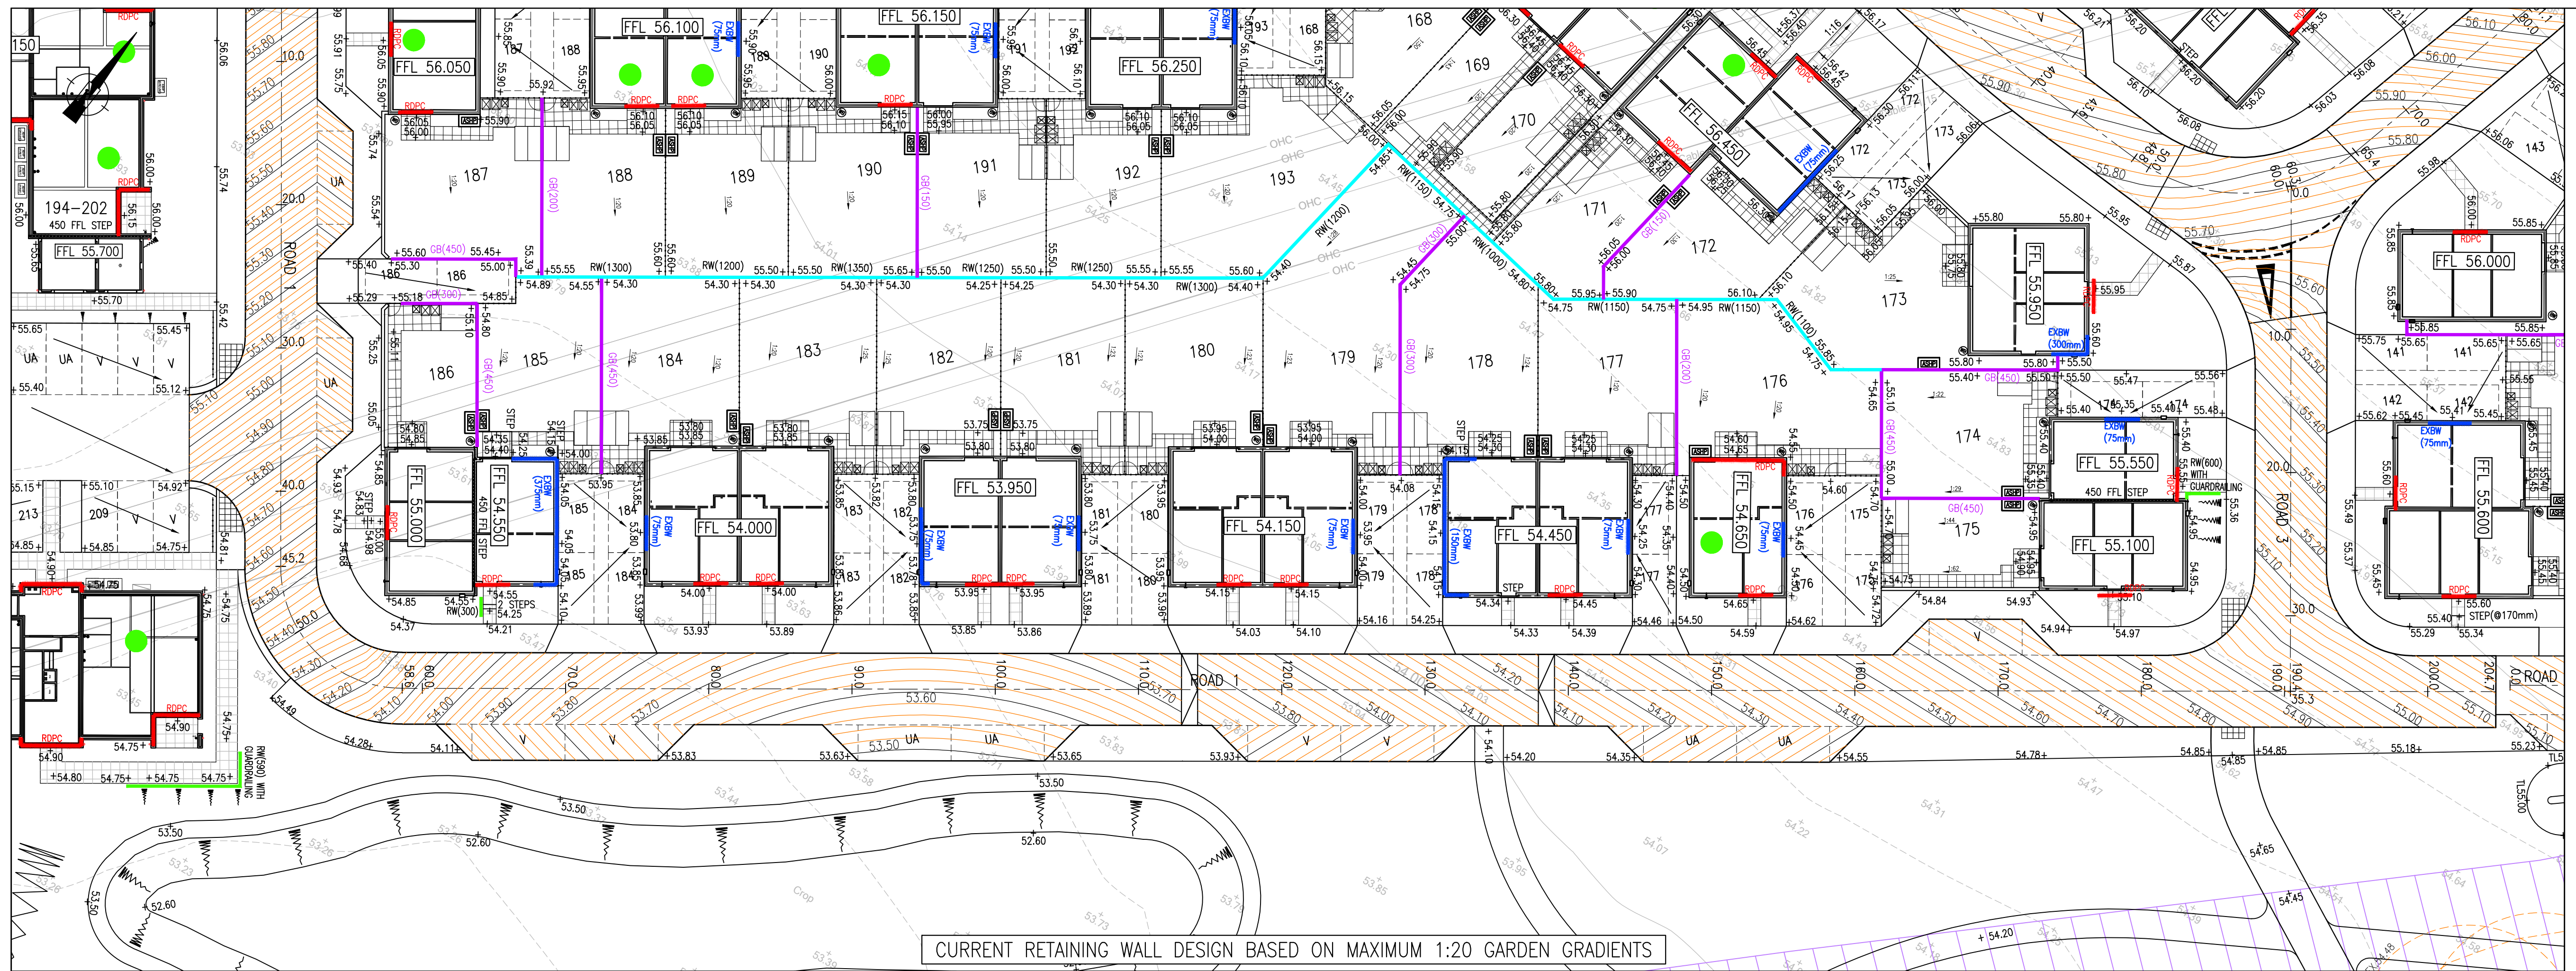

CURRENT RETAINING WALL DESIGN BASED ON MAXIMUM 1:20 GARDEN GRADIENTS

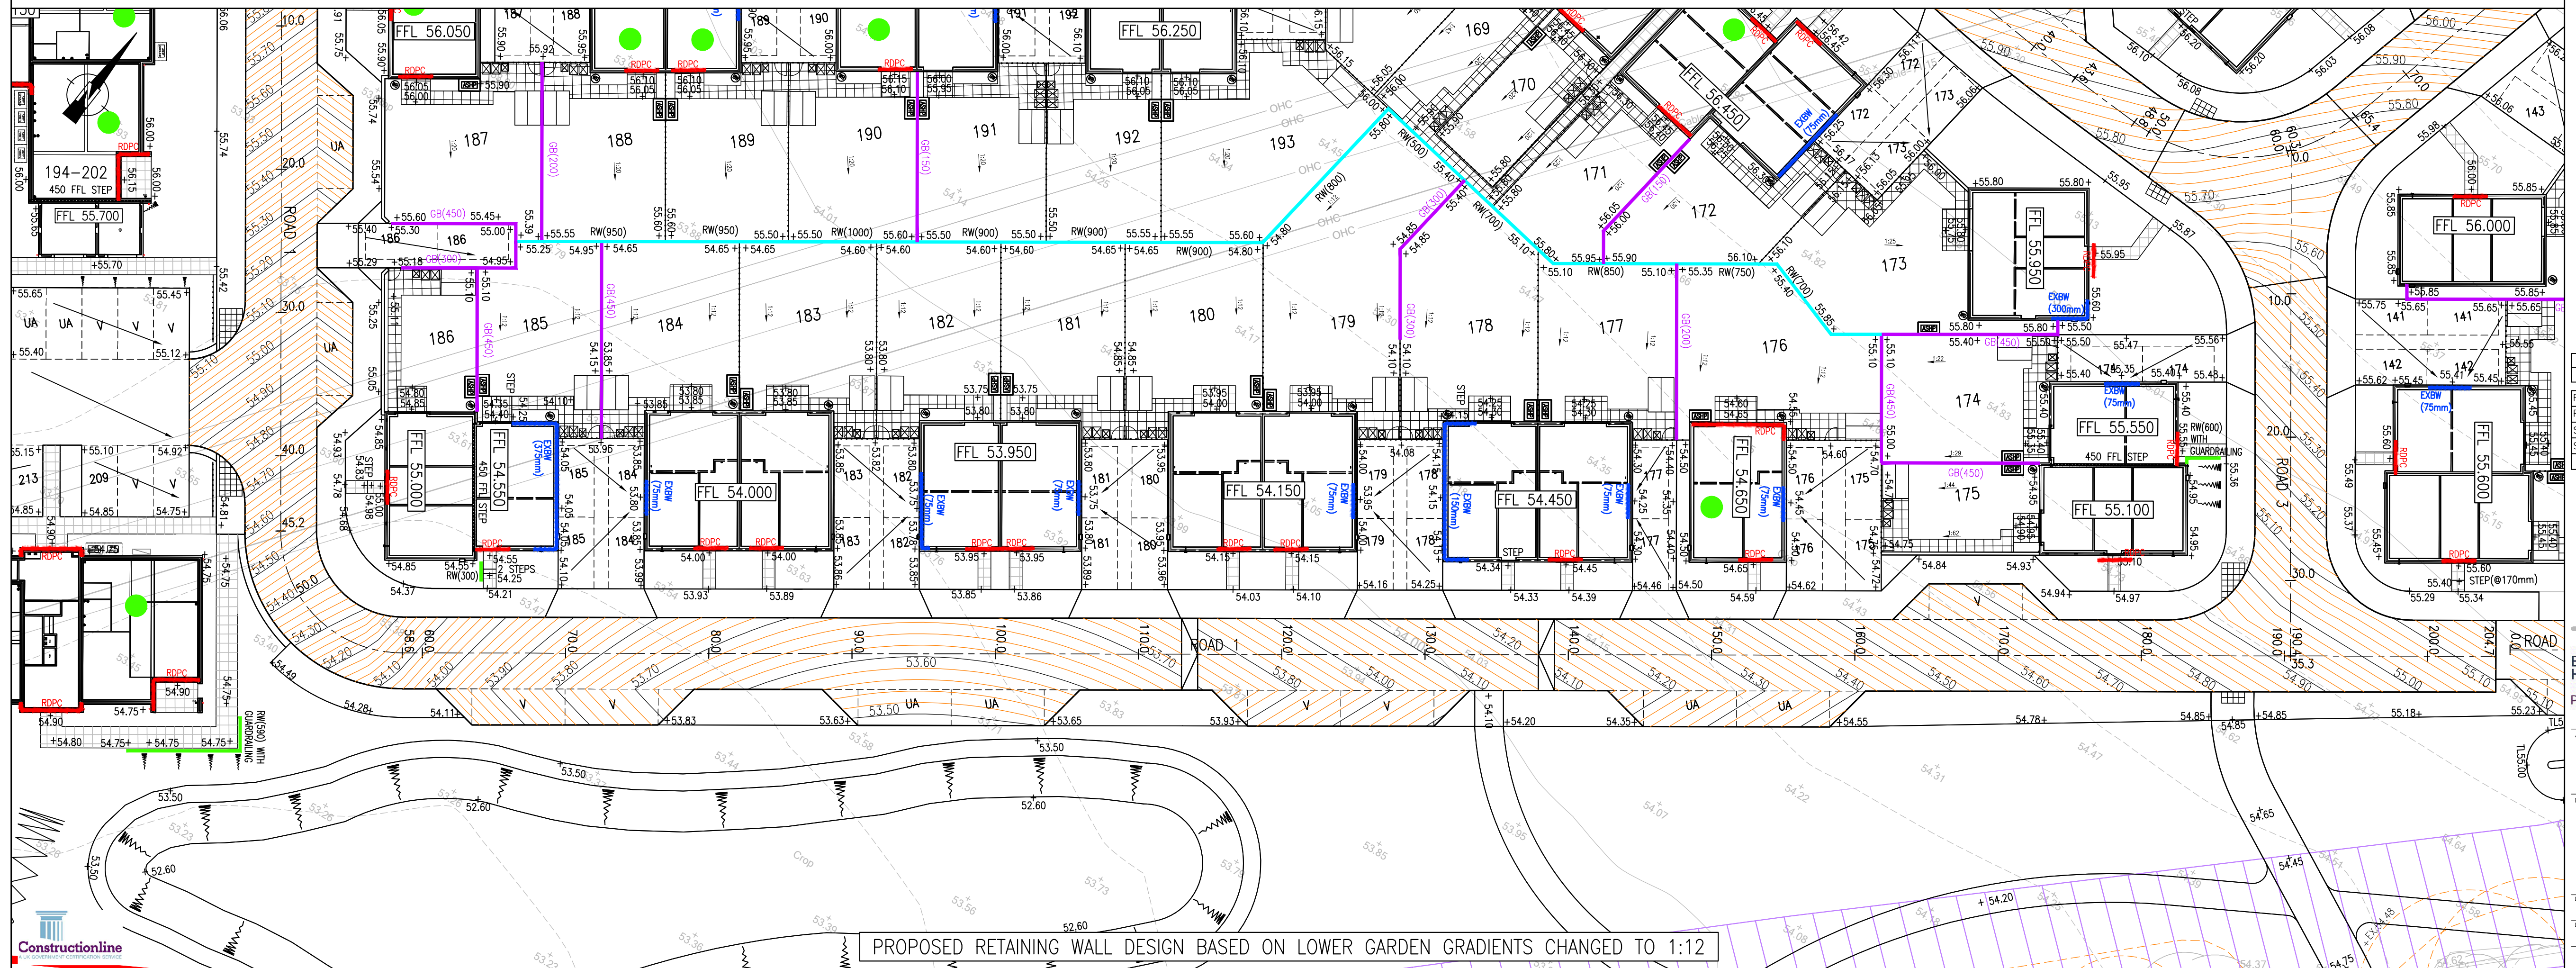

PROPOSED RETAINING WALL DESIGN BASED ON LOWER GARDEN GRADIENTS CHANGED TO 1:12

- NOTES:
- DO NOT SCALE FROM THIS DRAWING.
 - ALL DIMENSIONS ARE IN METRES, UNLESS STATED OTHERWISE.
 - THIS DRAWING IS TO BE READ IN CONJUNCTION WITH ALL RELEVANT SCHEME DRAWINGS AND SPECIFICATIONS.

- KEY:
- P11&12 SITE BOUNDARY
 - PRIMARY CONTOUR
 - SECONDARY CONTOUR
 - PROPOSED LEVEL
 - PROPOSED FINISHED FLOOR LEVEL
 - GRAVEL BOARD
 - RAISED DAMP PROOF COURSE
 - EXPOSED BRICKWORK
 - RETAINING WALL
 - TEAM ELITE RETAINING WALL
 - CENTRELINE AND CHAINAGE
 - M4(2) UNIT

ST	Rev	Description	Drm	Chk	Date
REVISIONS					
Preliminary Issue		Submitted for S104			
Planning Issue		Issued for Tender			
Submitted for S38		Issued for Construction			
Submitted for S278		As Built			
DRAWING STATUS					

STUART MICHAEL ASSOCIATES
CONSULTING ENGINEERS

Stuart Michael Associates Ltd
Coombe House, Coombe Square, Thatcham, Berkshire RG19 4JF
T: 01635 867 711
F: 01635 861 715
E: mail@stuartmichael.co.uk
W: www.stuartmichael.co.uk

Bovis Homes Linden Homes COUNTRYSIDE HOMES Countryside Partnerships

Part of the Vistry Group

FINCHWOOD PARCELS 11, 12 & 13

PARCELS 11 & 12
RETAINING WALL COMPARISON

DATE	DRAWN	CHECKED	SCALE	SHEET
AUG 2026	TA	MAS	1:250	0A1
7292.SK07				P01 S0

This drawing is the copyright of Stuart Michael Associates Limited. It may not be reproduced or amended without the written approval of Stuart Michael Associates