



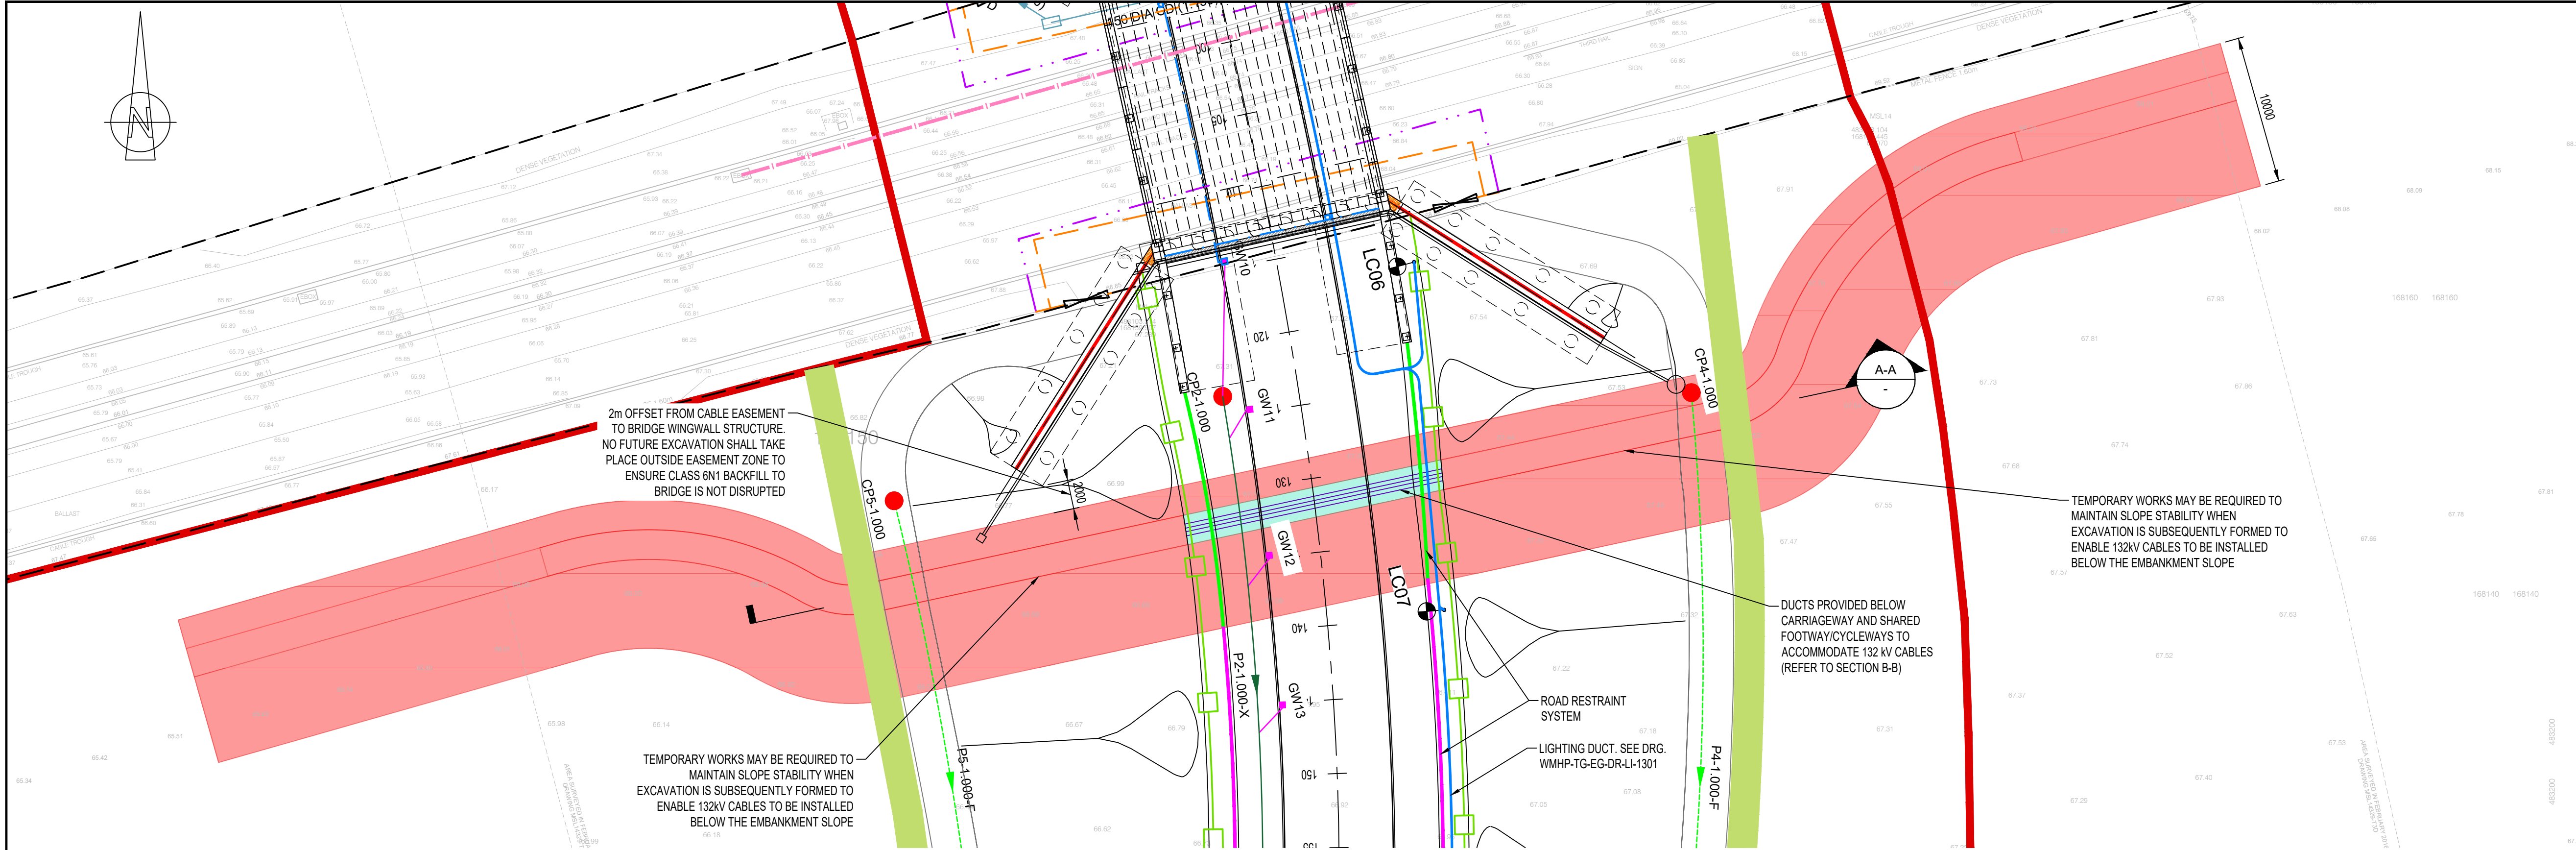


PLAN ON DIVERSION ACROSS BRIDGE EMBANKMENT

SCALE 1:250

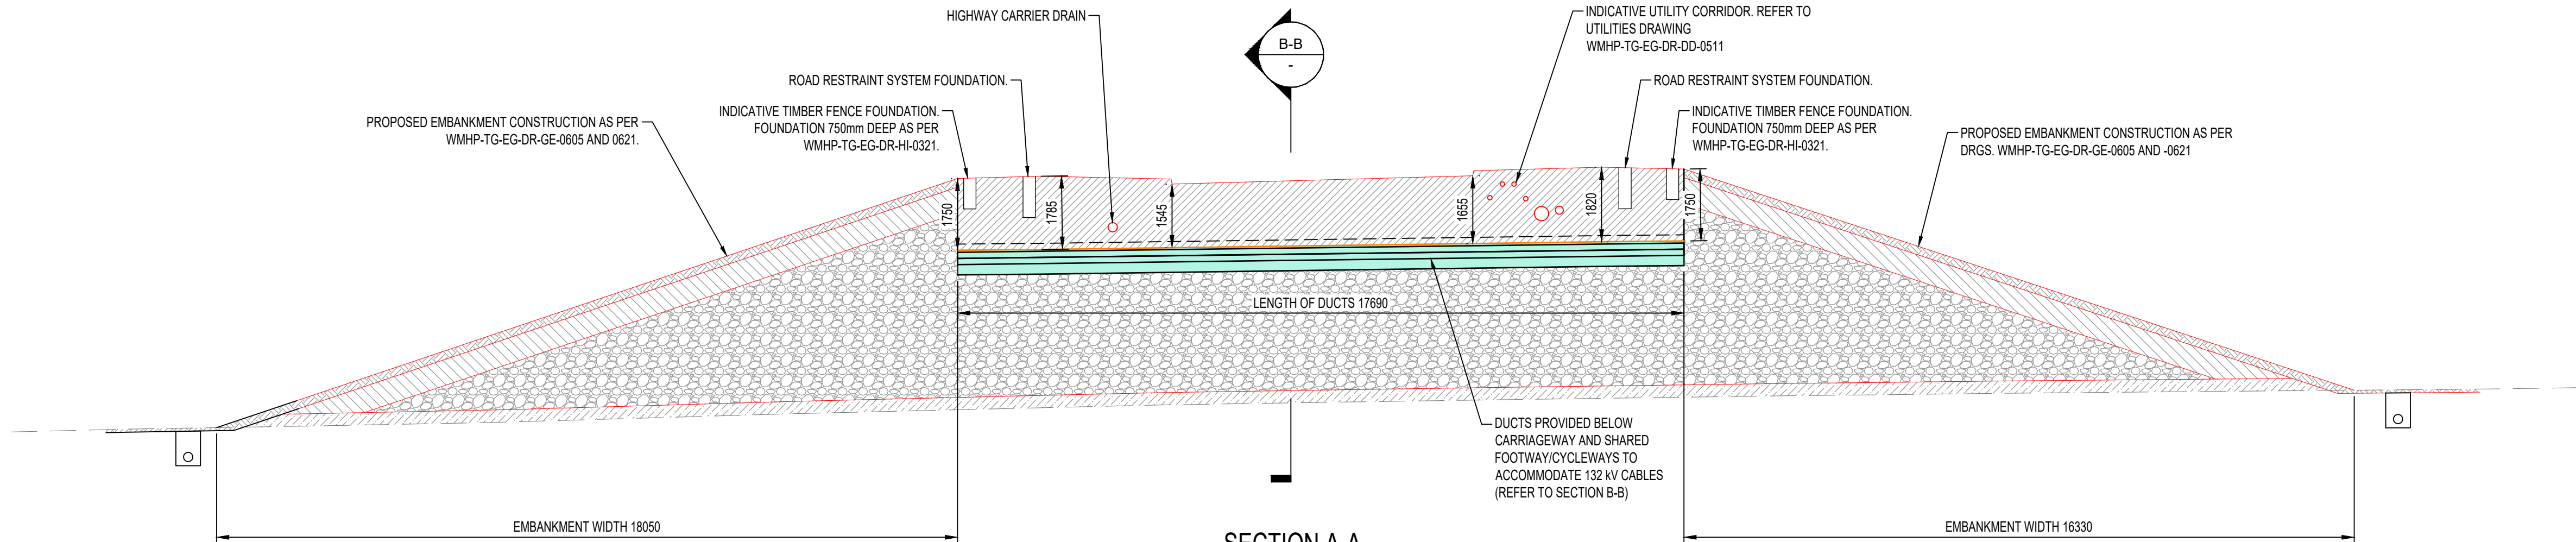

SECTION A-A

SCALE 1:100

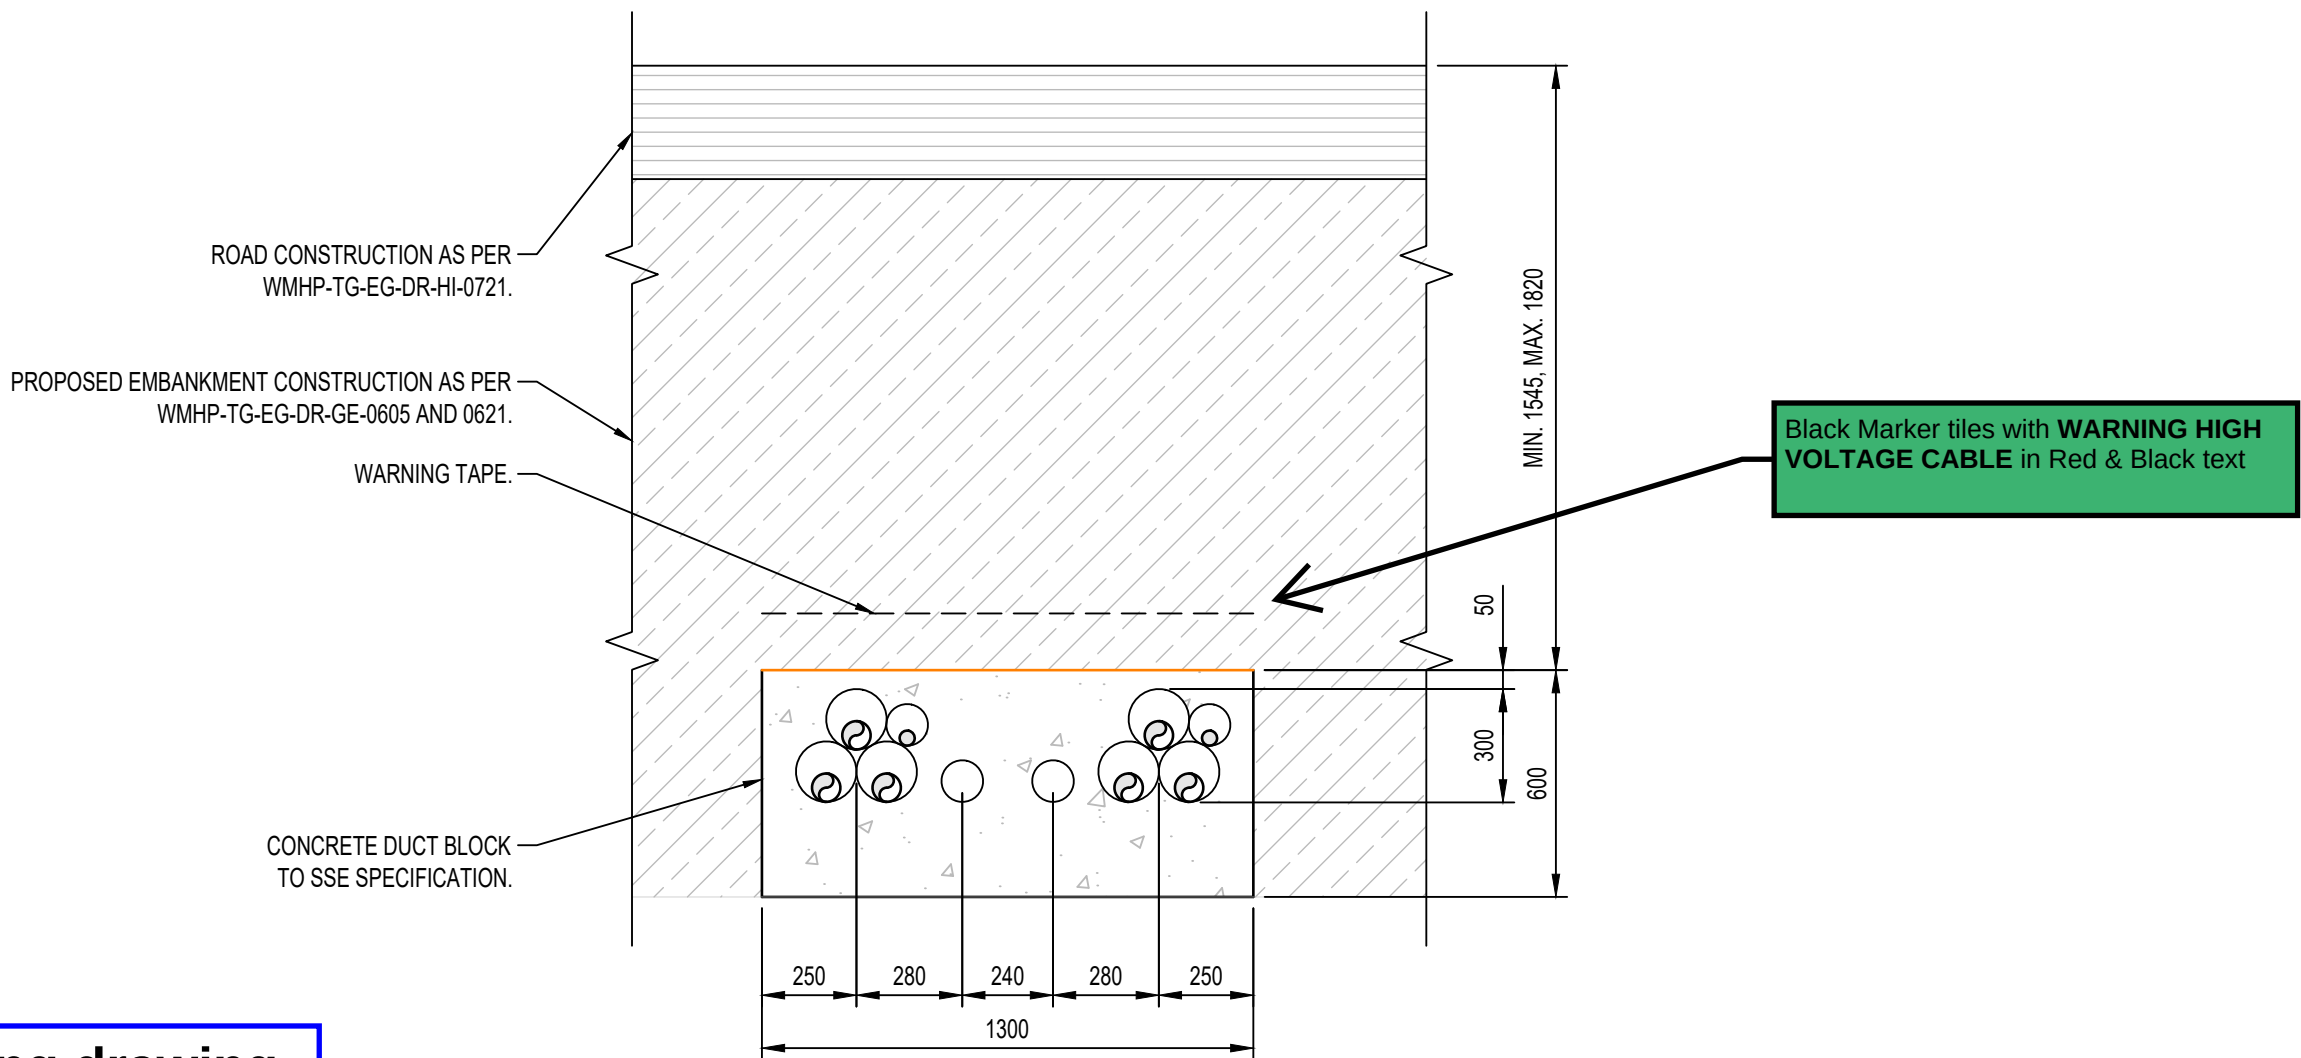

SECTION B-B

SCALE 1:20


Note - For ducting position and level please refer to as built ducting drawing

DO NOT SCALE

- NOTES:
- ALL DIMENSIONS ARE IN MILLIMETRES UNLESS NOTED OTHERWISE.
 - ALL LEVELS ARE IN METRES AOD UNLESS NOTED OTHERWISE.
 - 10m FINAL EASEMENT AND PLANTING TO BE CONFIRMED WITH SSE.
 - DUCT GEOMETRY AND BEDDING SHALL BE CONFIRMED WITH SSE PRIOR TO CONSTRUCTION.

KEY:

- 10m PERMANENT EASEMENT FOR 132KV DIVERSION.
- 132KV PROPOSED DUCT / SURROUND IN PLAN / SECTION - TO BE INSTALLED DURING CONSTRUCTION OF EMBANKMENT.
- PROPOSED DRAINAGE.
- PROPOSED FENCING.
- PROPOSED ROAD RESTRAINT SYSTEM.
- PROPOSED HEDGEROW (REFER TO LANDSCAPE DRAWINGS FOR DETAILS)

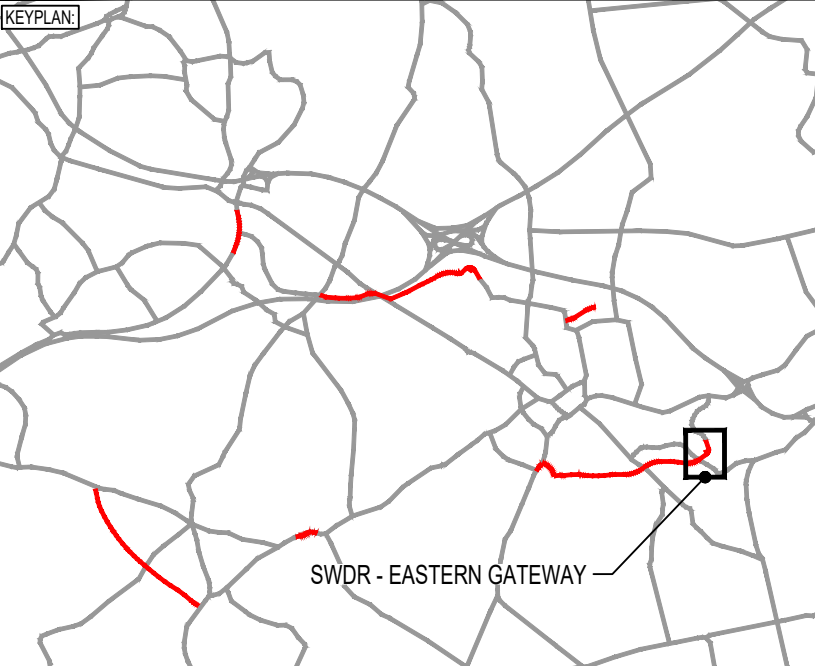

CD1	23/04/2021	TCH	FOR CONSTRUCTION	JSBR	ARL
P02	13/07/2020	TR	UPDATED TO INCORPORATE CONSORTIUM COMMENTS	JSBR	ARL
P01	03/04/2020	TR	UPDATED TO ADDRESS CLIENT COMMENTS	JSBR	ARL
REV	DATE	BY	DESCRIPTION	CHK	APP

DRAWING STATUS: APPROVED & ACCEPTED A

DESIGNER: Tony Gee and Partners LLP
Hardy House
140 High Street
Esher, Surrey
KT10 9QJ
Tel: 01372 461600
www.tonygee.com
Consulting Civil, Structural and Geotechnical Engineers

CONTRACTOR: Balfour Beatty

CLIENT: WOKINGHAM BOROUGH COUNCIL
Shute End, Wokingham, Berkshire RG40 1BN
Tel: (0118) 974 6000 Web: www.wokingham.gov.uk

PROJECT: WOKINGHAM MAJOR HIGHWAYS PROGRAMME
EASTERN GATEWAY

TITLE: HIGHWAYS
132kV DIVERSION

SCALE @ A1:	CHECKED:	APPROVED:
AS SHOWN	JSBR	MH
PROJECT NO:	DESIGNED:	DRAWN:
C117135	TDB	AJT
DRAWING NO:	DATE:	REV:
WMHP-TG-EG-DR-DD-0551	March 20	C01