



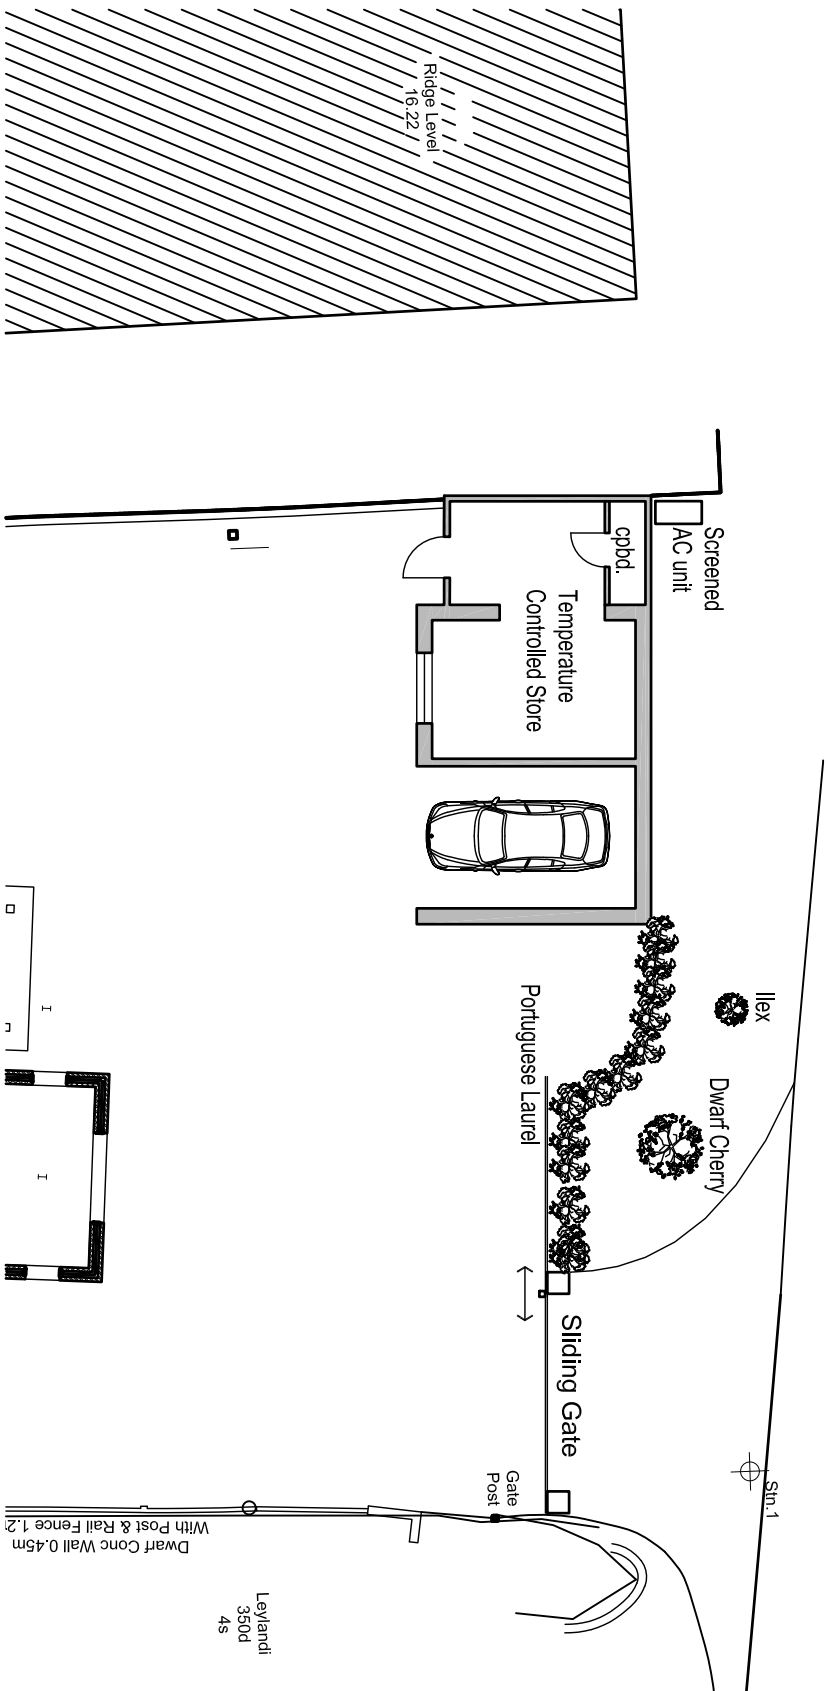

Species planted
Prunus Lusitanica (Portuguese Laurel)
Dwarf Cherry (Prunus Cerasus)
Ilex Aquifolium "Variega"

As Built

Permitted

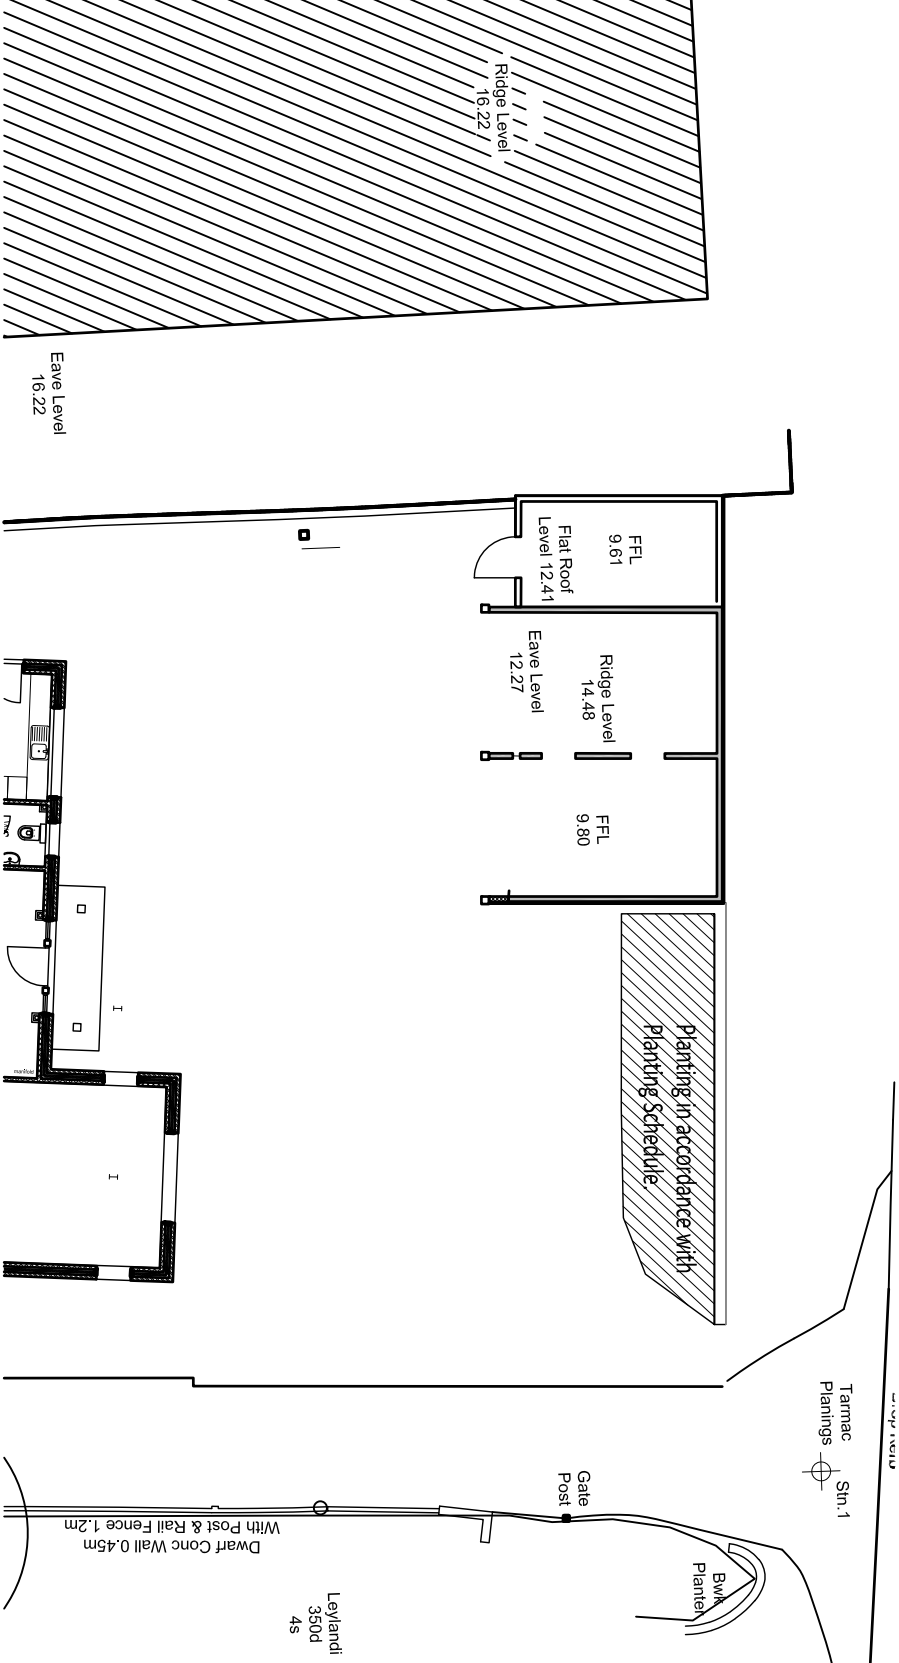

Giffillan Studios
Project
Works to White Horse Farm

Drawing Title
Stable block to North Plans

Date	Scale	Drawn by	Check by
Sept 2026	1:200@A3	AH	
Project No	Drawing No	Revision	
01			