



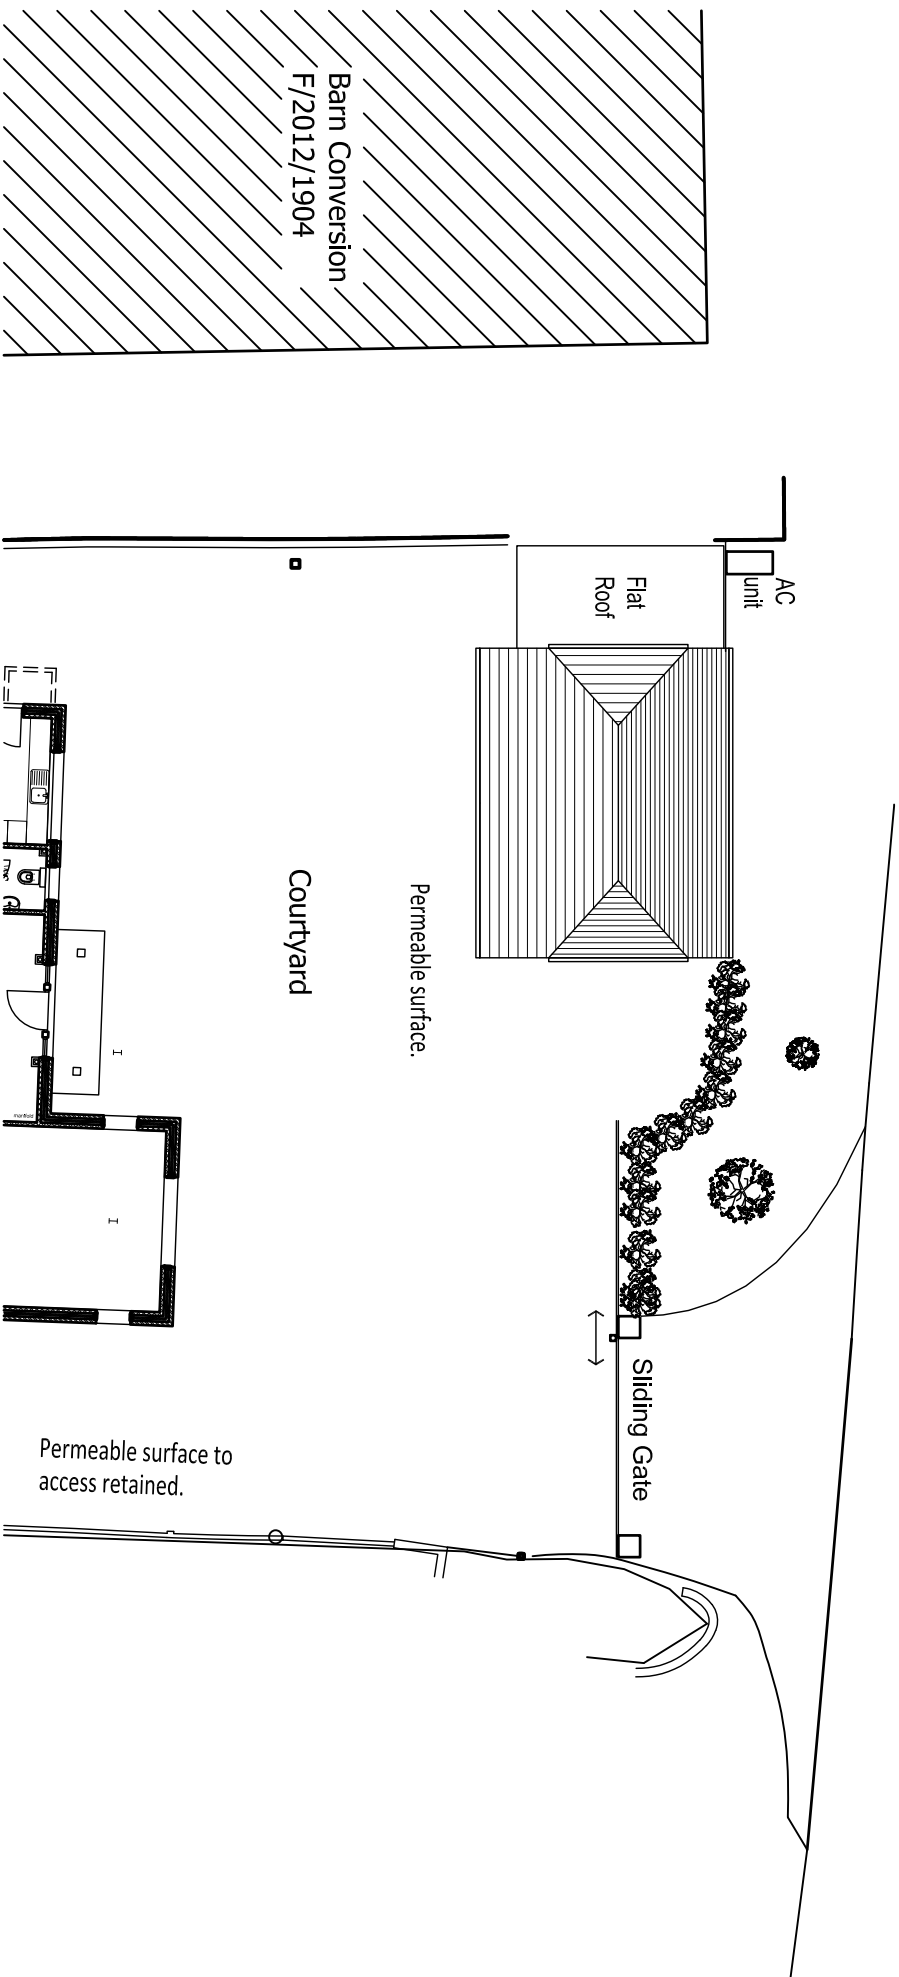

As Built

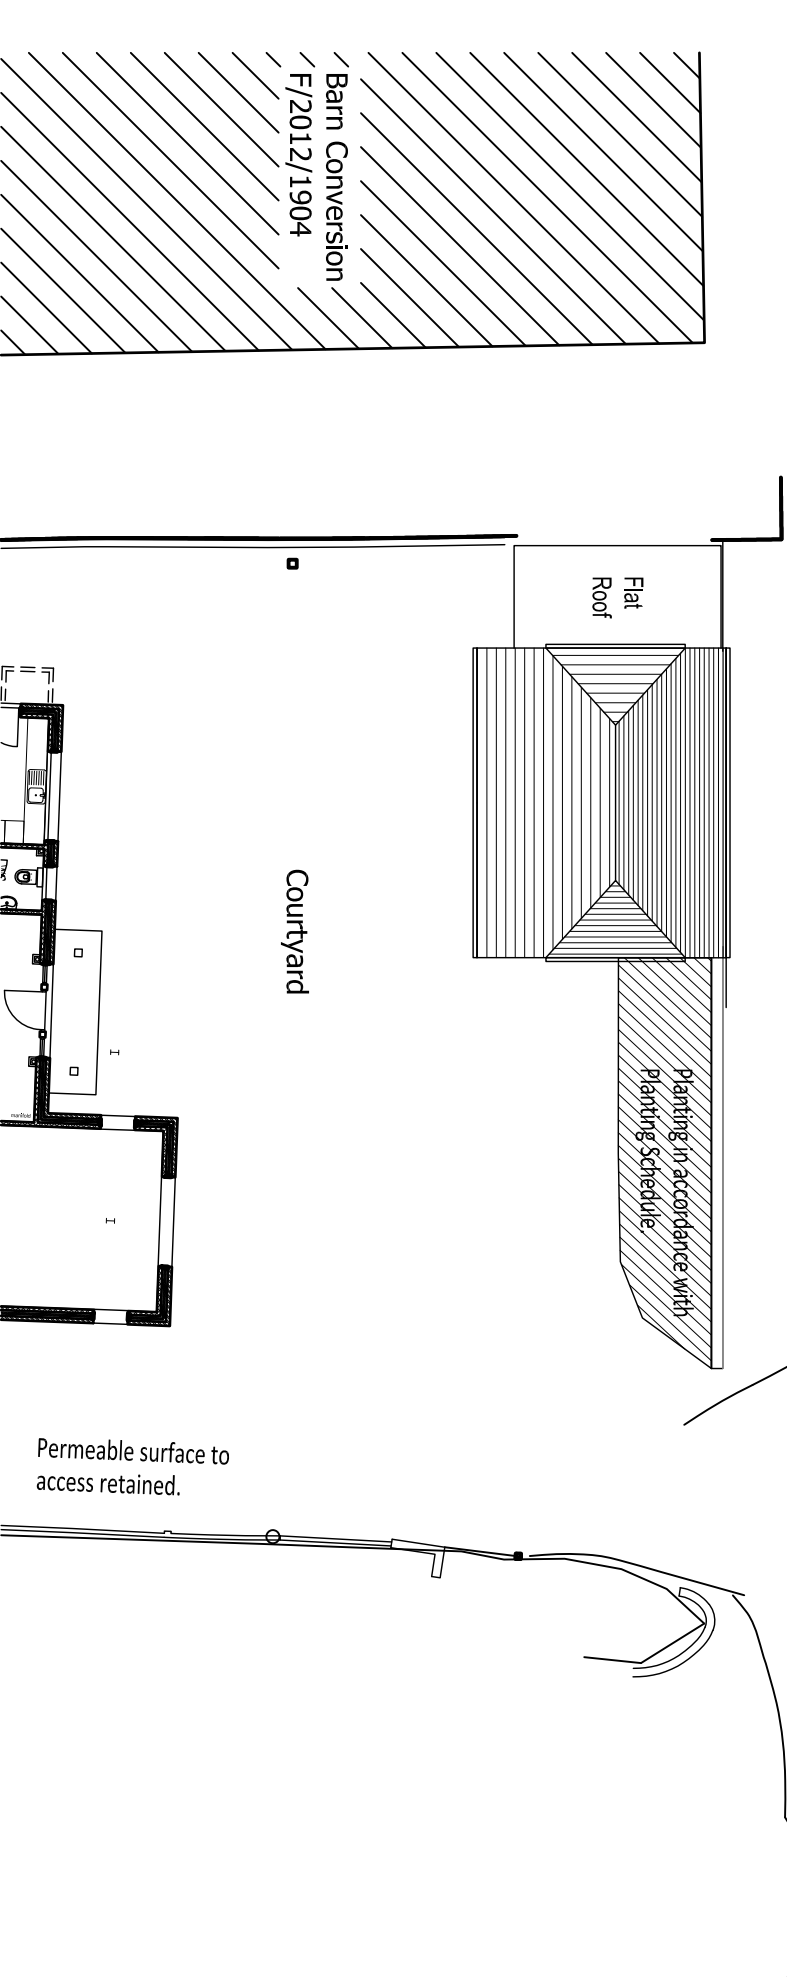

Permitted



Giffillan Studios
Project
Works to White Horse Farm
Drawing Title
Stable block to North
Roof Plans

Date	Sept 2026	Scale	1:200@A3	Drawn by	AH	Check by	
Project No	02	Drawing No		Revision			