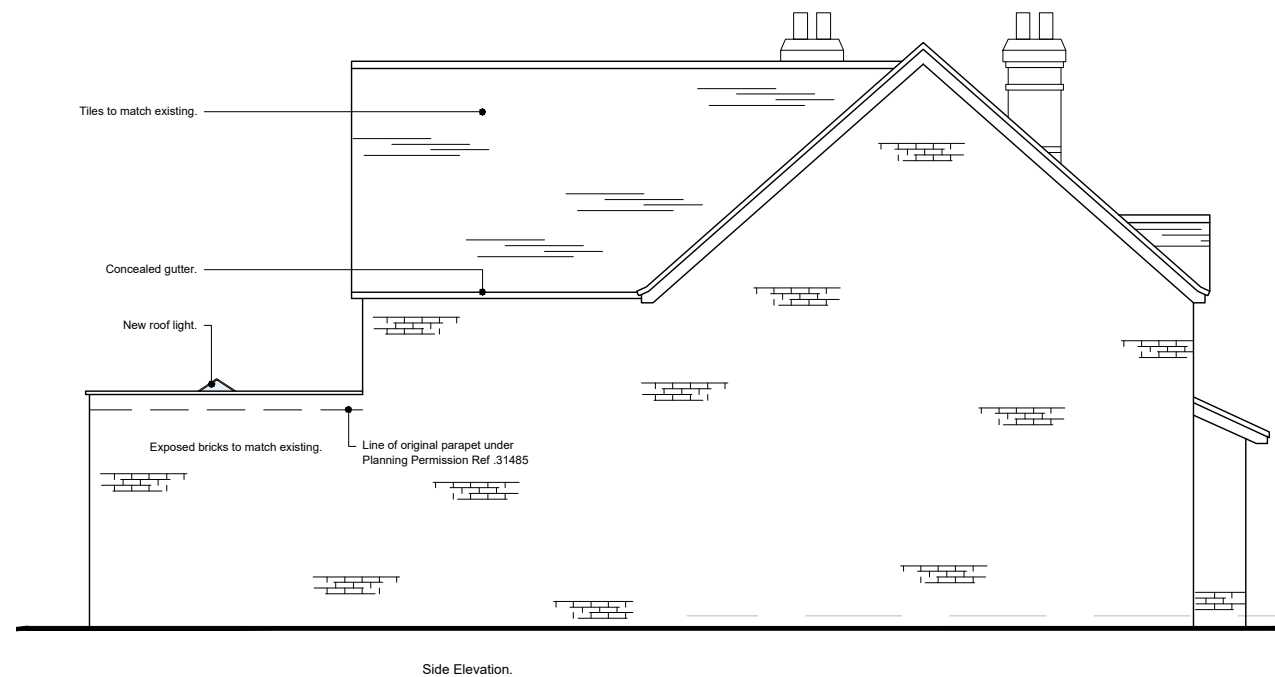
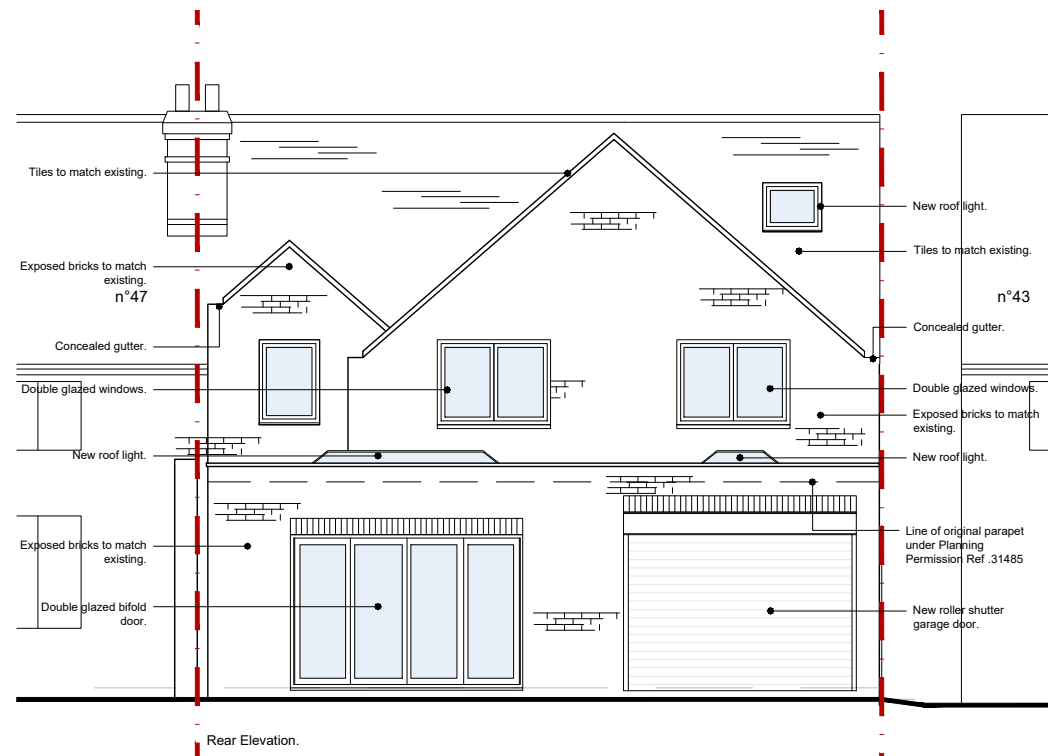
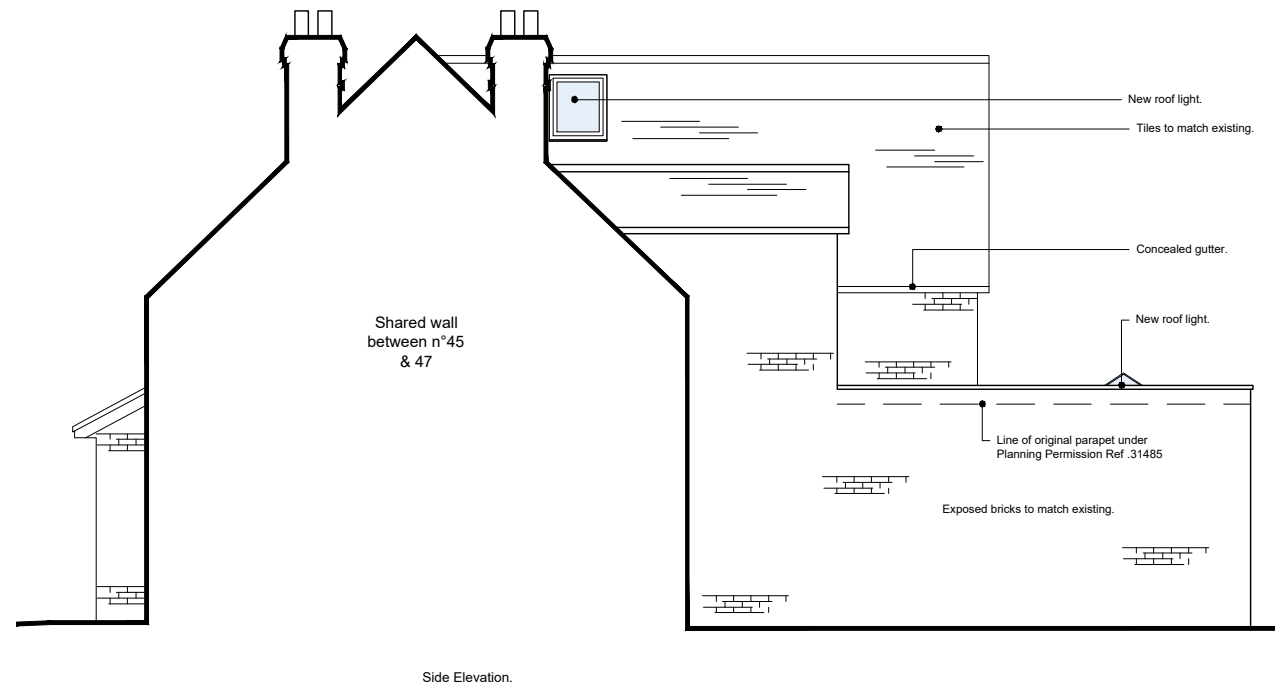


NOTE: Line of new extension is 50mm lower than extension to n°47.

RevB_ To reflect as built on site.
RevC_ Line of original parapet height added.

(c) Copyright

WILDER ASSOCIATES

Architects & Designers

2 Mill Lane
Wallingford
Oxon
OX10 0DU
Tel & Fax
01491 832572
E Mail
anne@wilder.co.uk

Client

Bob Tanner

Job Title

45 Hyde End Lane, Ryeish Green,
Reading
RG7 1EP

Drawing Title

Elevations as Built.

Scale 1:100@A3

Date Feb 25 Drawn by Michel C.

Checked by Anne Wilder

Drg No BTE/PL/08	Rev C
---------------------	----------