




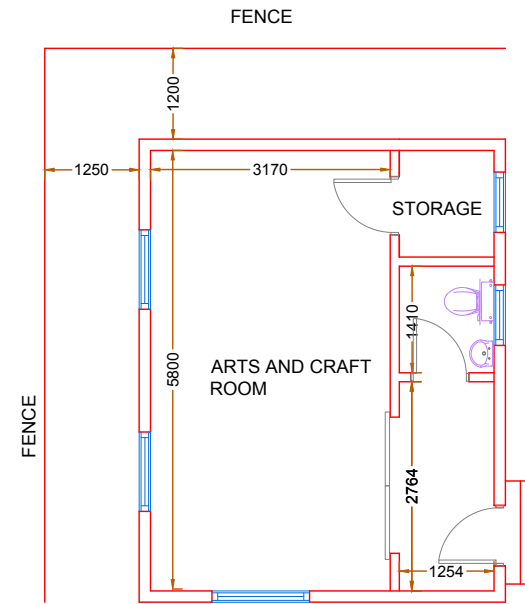

AS BUILT FLOOR PLAN

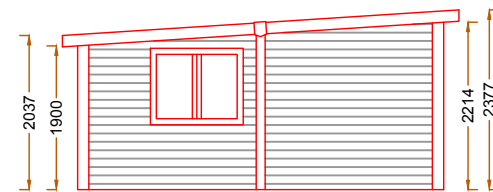


AS BUILT
SIDE ELEVATION - 1

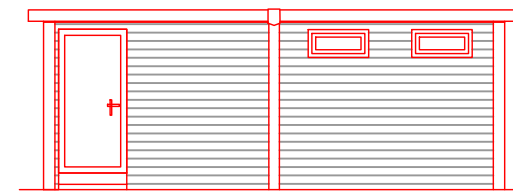


AS BUILT
FRONT ELEVATION



AS BUILT
SIDE ELEVATION - 2

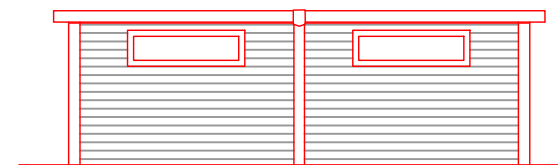

AS BUILT
REAR ELEVATION

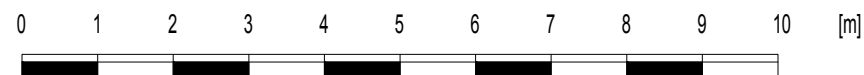

Scale bar 1:100 @ A3

CLIENT

DRAWING NO:
HB2025009-HB02

SITE
56 Robin Hood Lane RG41 5NQ

DRAWING TITLE
As built outbuilding plans

Date:
10.03.2025

Scale @ A3:
1:100

Revision:
P01

HB PLANNING SERVICES
EMAIL INFO@HBPLANNINGSERVICES.CO.UK
CONTACT 02038539648

Rev: **Date:** **Notes:**
P01 10.03.2025 For Planning Approval

