

LSBUD Job No: 37225668

Date: 09 May 2025

To: Mrs Marcia Head

UK Power Distribution Enquiry Response

We acknowledge with thanks your LSBUD request (referenced below) dated 09 May 2025 10:35:08 AM for information on the location of our assets.

LSBUD Reference:	37225668
Your reference:	251086

Enclosed is a plan showing the approximate position of UK Power Distribution assets within your area of interest. Our records indicate that network apparatus exists near to the area of your proposed works.

WARNING: When working in the vicinity of UK Power Distribution assets you have a legal *Duty of Care* that must be observed.

The information shown on the attached plan is given without obligation or warranty and its accuracy cannot be guaranteed. Safe digging practices in accordance with [HSE publication HSG47 "Avoiding danger from underground services"](#) must be used to verify and establish the actual position of the assets before any mechanical plant is used.

Please find enclosed a copy of our above referenced drawing, marked to show the approximate position of plant owned and operated by UK Power Distribution.

You will be aware that you have a duty to ensure that no damage is caused to this equipment as a result of your proposed works.

If you would like to discuss how your project will affect the current assets, please contact the relevant number below.

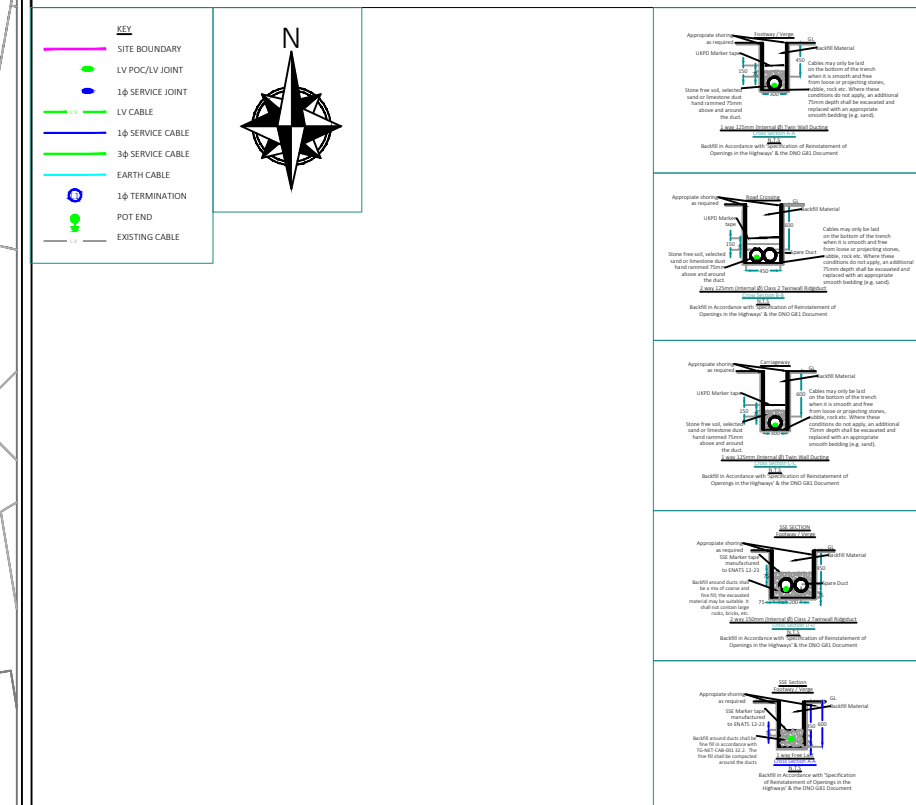
Yours sincerely,

UK Power Distribution

T: [03303 209899](tel:03303209899)

E: closure@ukpowerdistribution.co.uk

In Emergency: [0800 311 8074](tel:08003118074)

[illegible]

REVISION		EDITS TO REVISION
35	amended to BS 5940:1991, 1, 3 & 6	
AS CONSTRUCTED INFORMATION PRINCIPLE QUANTITIES		
CABLE		LENGTH
11circuit 1c Wapodorm		245m
11circuit 1c Wapodorm		245m
11circuit 1c C16		64m
11circuit 1c C16		64m
11circuit 1c C16		64m
11circuit 1c C16		64m

NOTES:
1.DO NOT SCALE FROM THIS DRAWING.
2.ALL DIMENSIONS MUST BE CHECKED/VERIFIED ON SITE.
3.UNLESS OTHERWISE STATED ALL DIMENSIONS IN
MILLIMETRES.

REVISIONS			
08			
07			
06			
05			
04			
03			
02			
01	XX/XX/XX	FIRST ISSUE - TENDER	XX
REV	DATE	DETAILS OF DESCRIPTION	CHK'D



Head Office	Midlands Office	Southern Office
6500 Daresbury Park	Northampton Science	7 Lidstone Court
Daresbury	Park	George Green
Warrington	Moulton Park	Slough
WA4 4GE	Northampton	SL3 6AG
Tel: 0844 74 000 74	NN3 6LG	Tel: 01753 578 971
Fax: 0844 74 000 75	Tel: 01604 654 282	

CLIENT	DANDARA		
PROJECT	STANBURY HOUSE		
SITE ADDRESS	STANBURY HOUSE, SPENCERS WOOD, RG7 1AJ		
TITLE	ICP1540-ASL-IDNO		
DRAWN BY	SM	DESIGNER	XX
SCALE	1:500 @ A1		
DRAWING NO	ICP1540-ASL-IDNO		
STATUS	AS LAID		