

APPLICATION TO MODIFY APPROVED APPLICATION 250853 - PROPOSED NEW FLOOR PLAN

Original (approved) application
250853 - details shown in black.


All variations being applied upon previous (approved) application 250853 - details shown in red.

 Hatched areas indicate details removed from Application 250853 due to modification of the Application to increase floor area

NOTE : this window is not a new addition upon Application 250853. The window on the side is shown in the side elevation of Application 250853, but was erroneously omitted from the Floor Plan of Application 250853. It is shown here as a correction and for completeness.


Scale Bar 1:50 @ A2

A horizontal scale bar consisting of a brown background with two white rectangular segments. The segments are evenly spaced and aligned with the numbers 0, 1, 2, 3, and 4 below it. The text "Scale Bar 1:50 @ A2" is positioned above the scale bar.

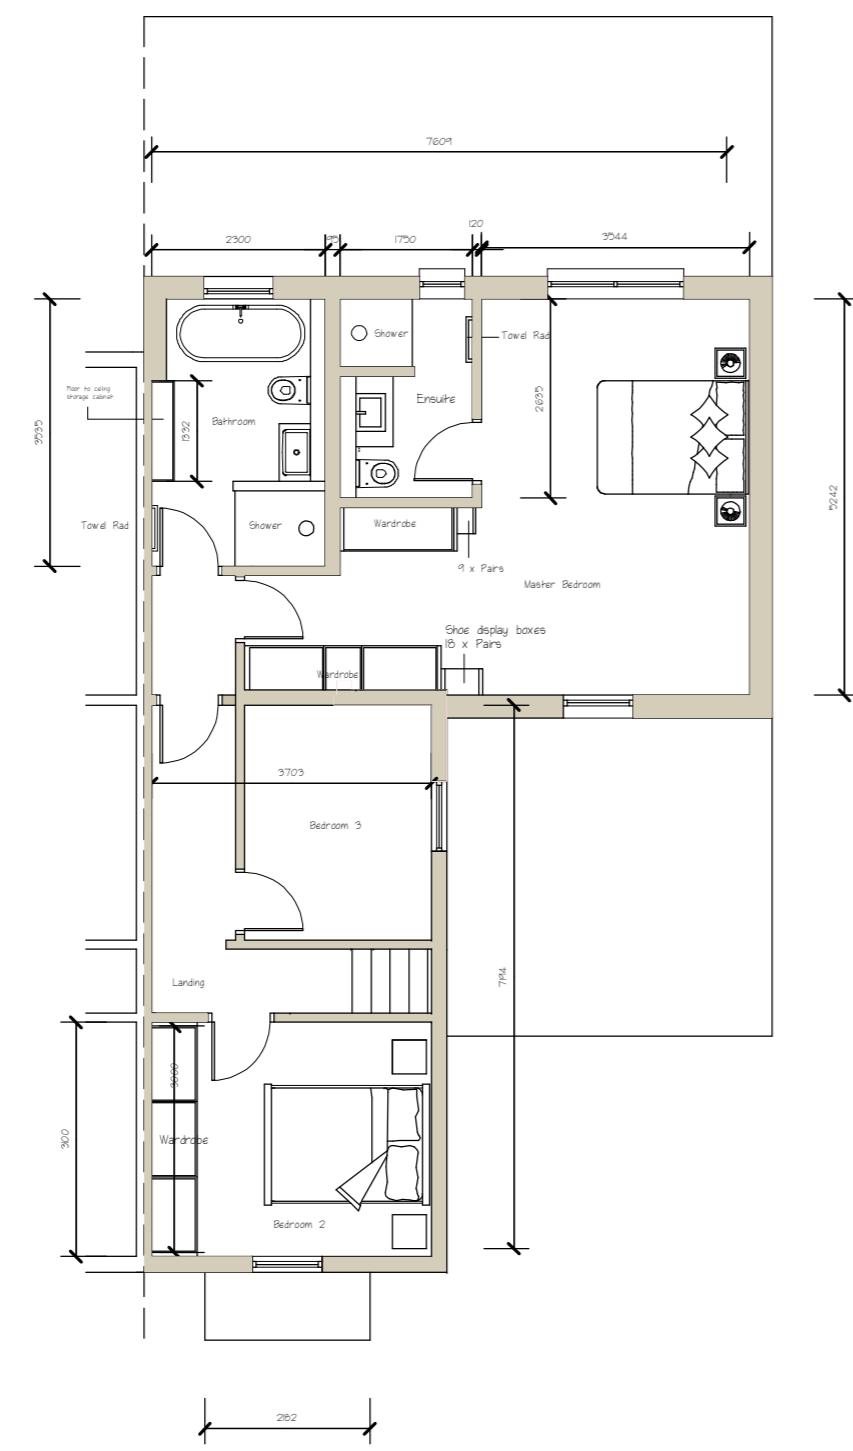

Proposed 1st Floor

No modification of First Floor Plan

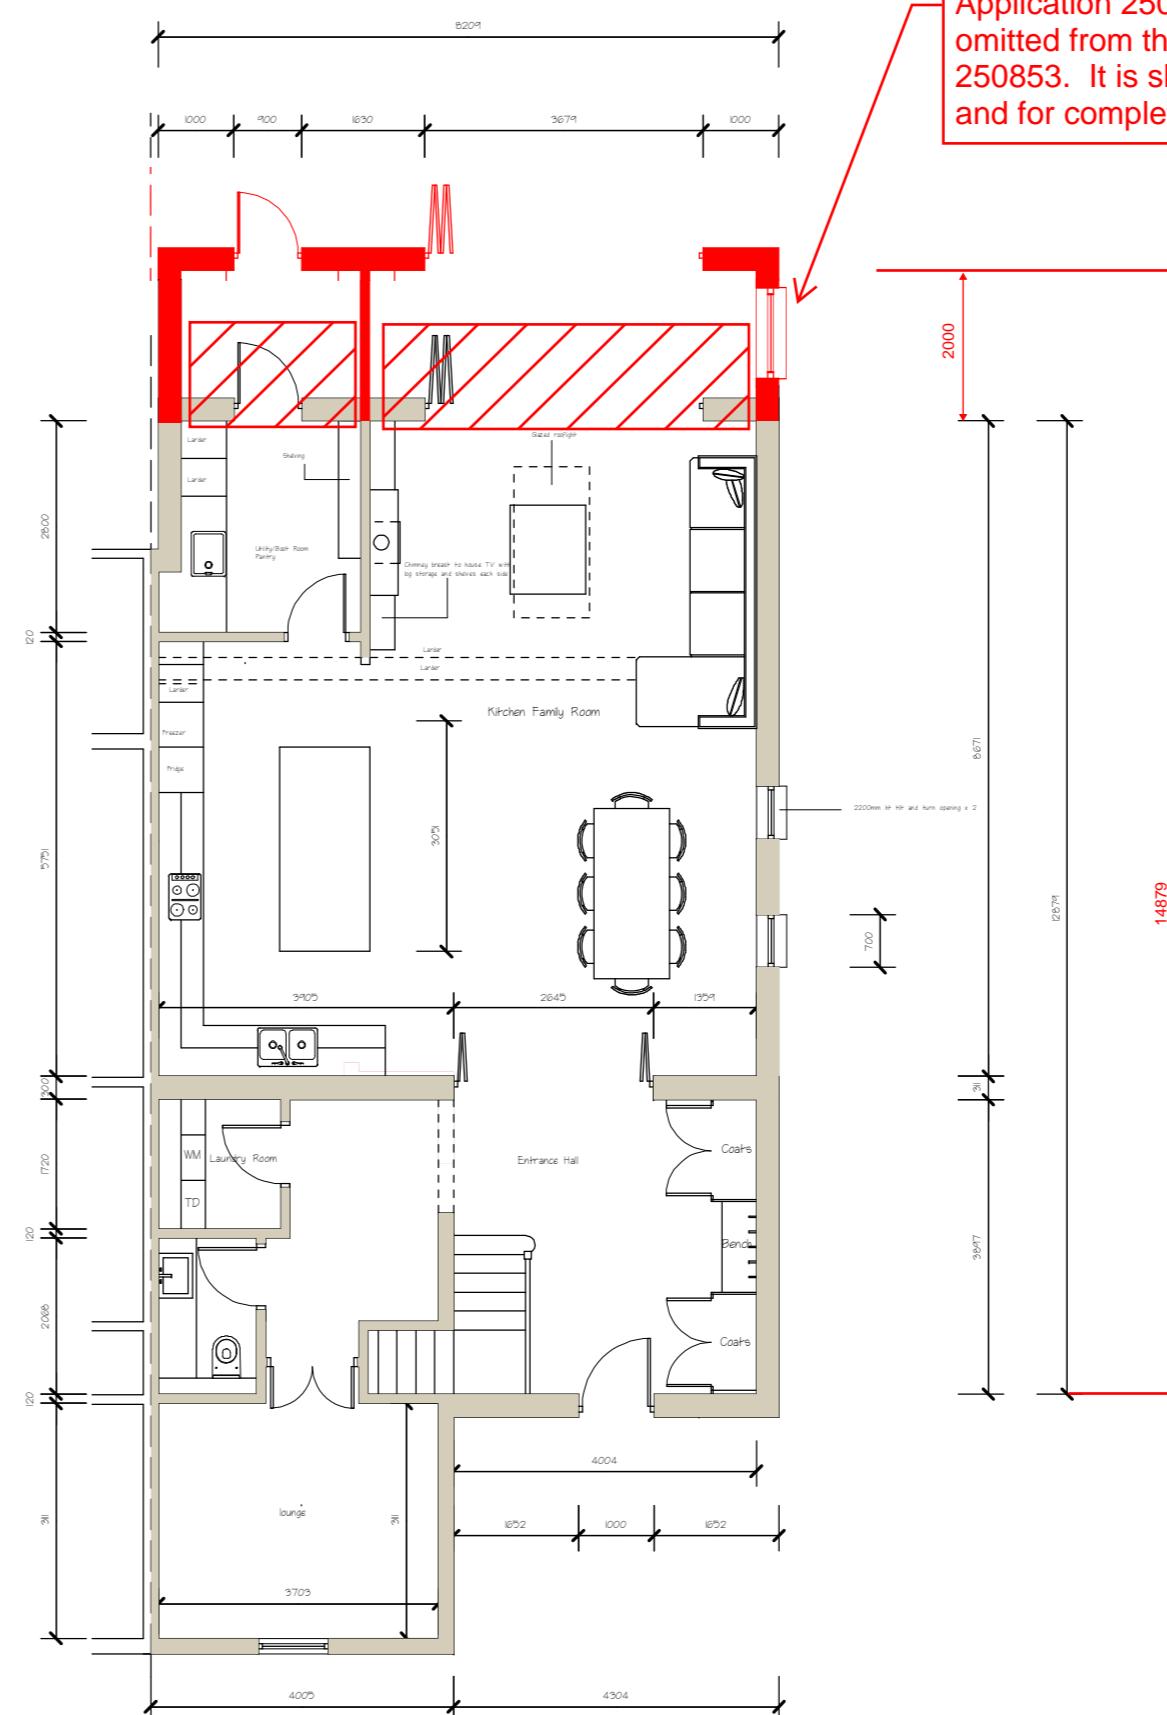

Proposed Ground Floor

16

PAUL SCHOFIELD
ARCHITECTURAL DESIGN

CLIENT

PROJECT TITLE
29 The Square
Spencers Wood
Reading
RG7 1BS

DRAWING TITLE

CALE	DATE	DRA
100	07-03-25	P.9

Email - paul@psdreamhome.com
Mob - 07949 5965

THE COPYRIGHT IN THIS DOCUMENT
DESIGN IS CONFIDENTIAL TO ANE

PROPERTY OF PAUL SCHOFIELD
