



# APPLICATION TO MODIFY APPROVED APPLICATION 250853 - PROPOSED NEW PARKING PROVISION DRAWING

Scale Bar 1:100 @ A2

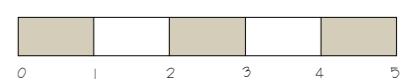

Original (approved) application  
250853 - details shown in black.

All variations being applied upon  
previous (approved) application  
250853 - details shown in red.

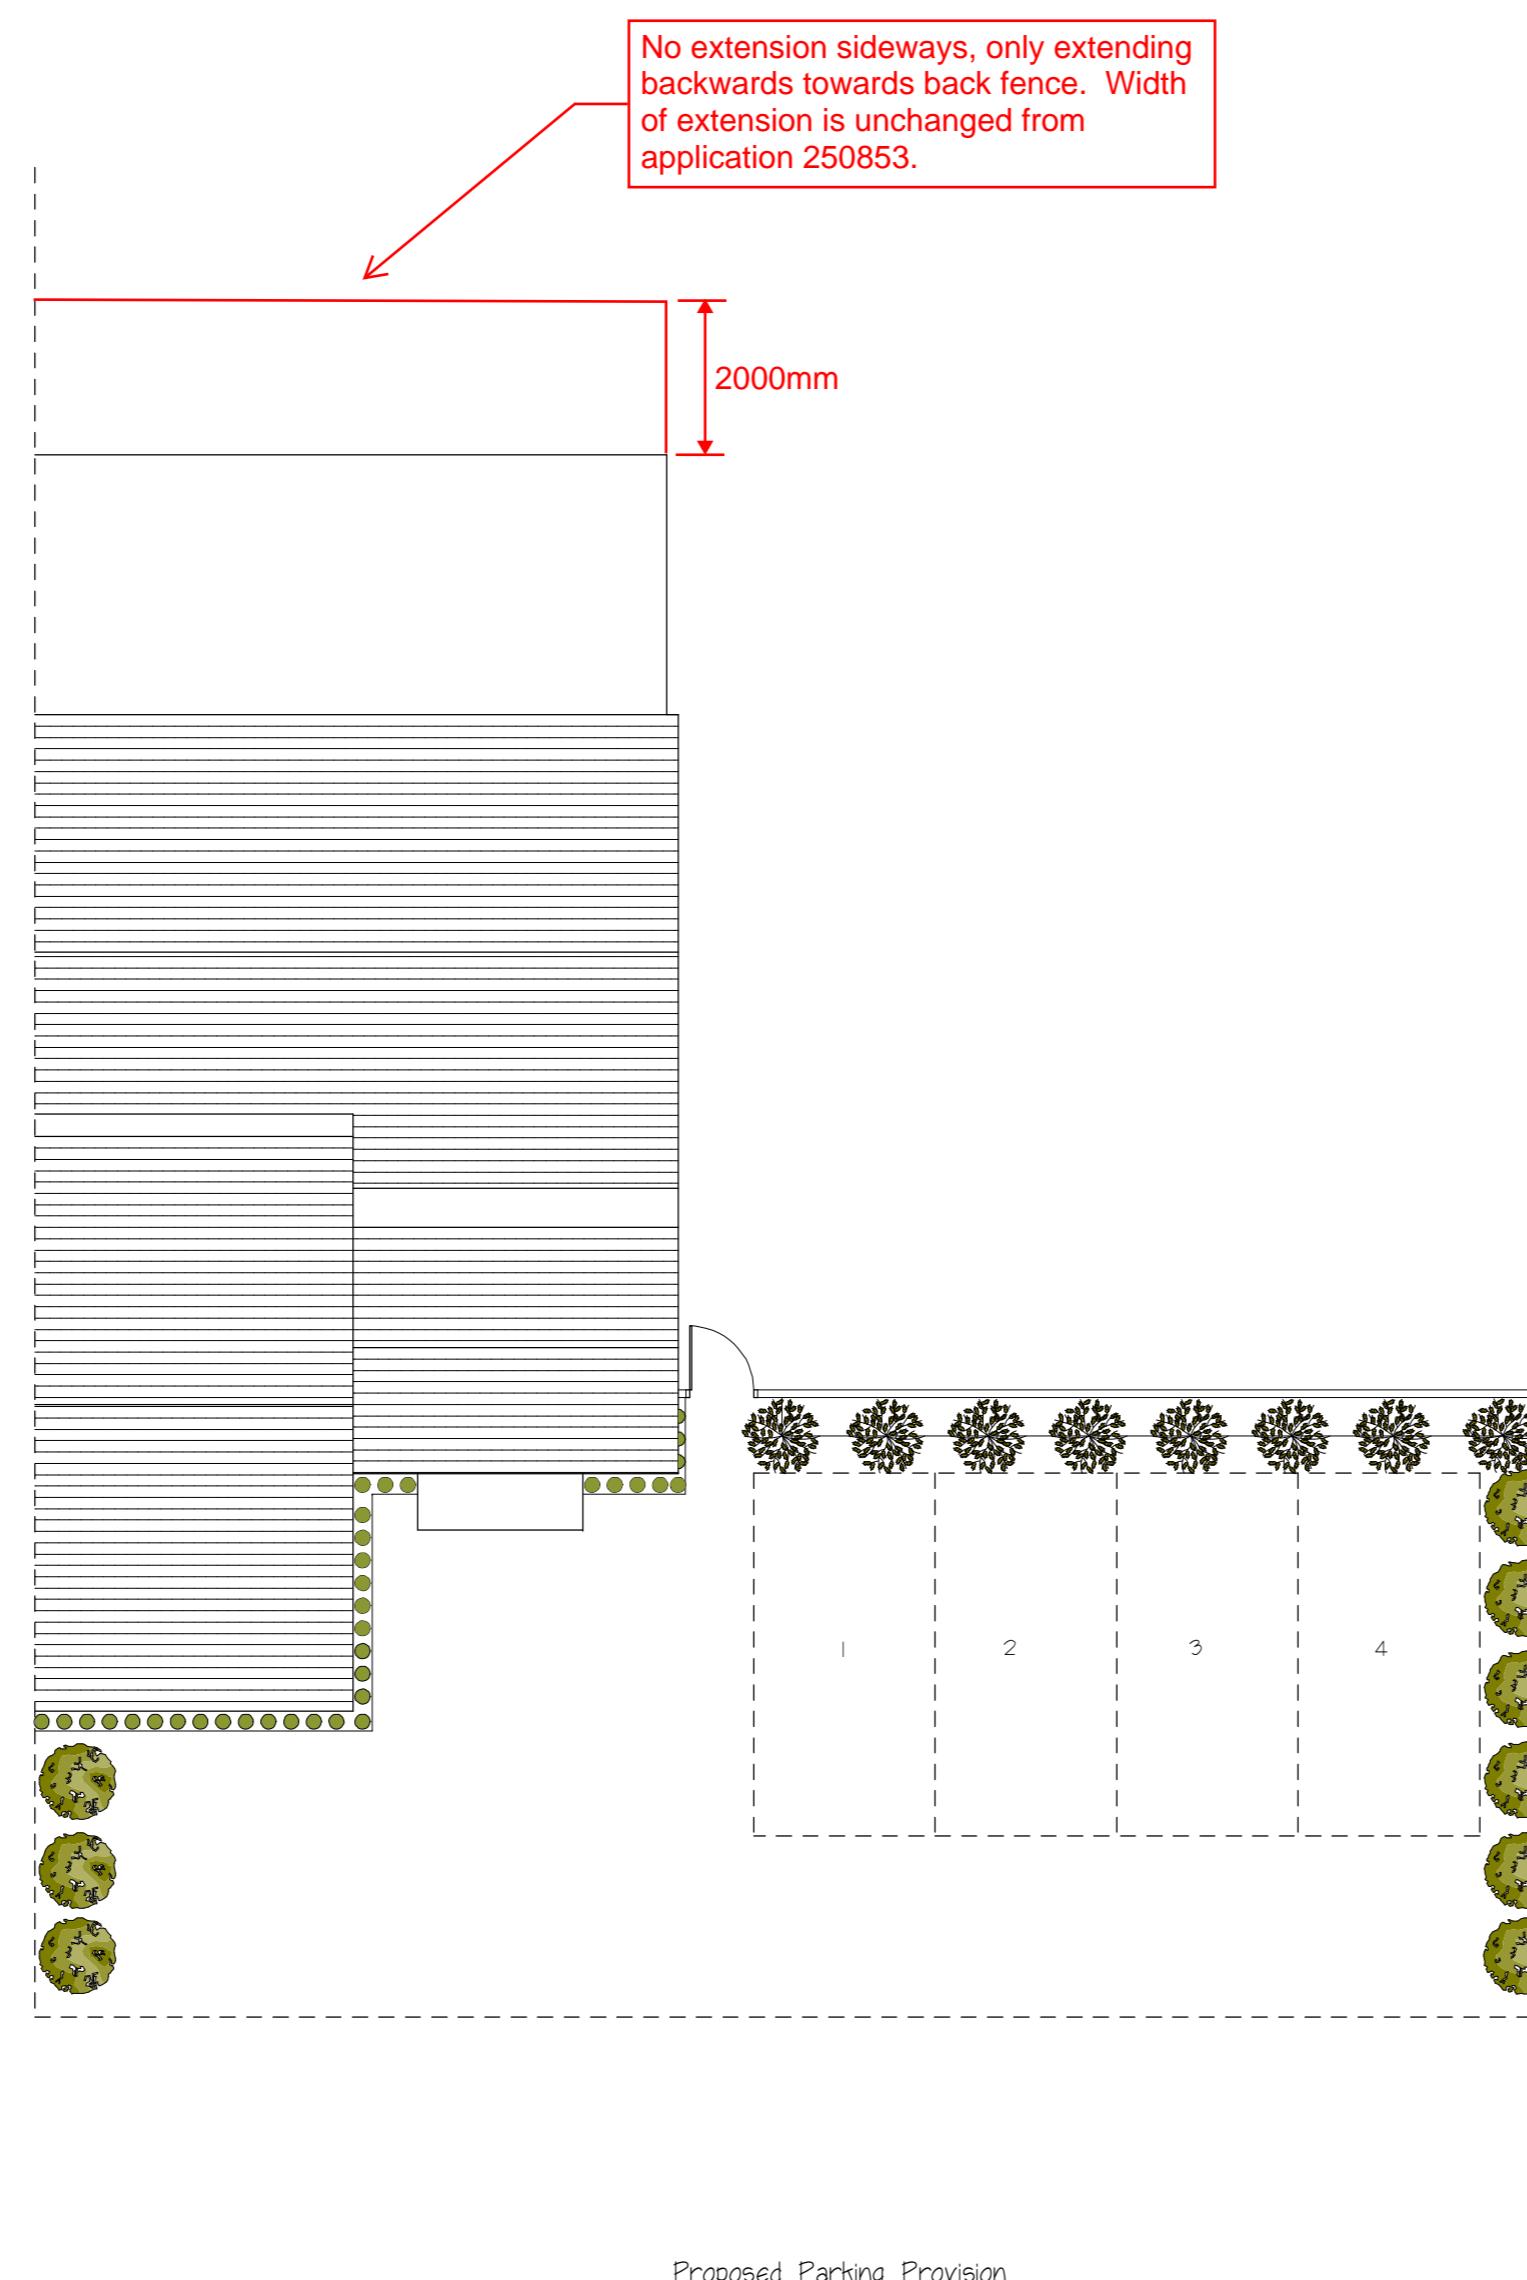

CLIENT  
Paul & Wiola Galabolo

PROJECT TITLE  
29, The Square  
Spencers Wood  
Berkshire  
RG7 1BS

DRAWING TITLE  
Proposed Parking Provision

SCALE 1:100 DATE 29.03.25 DRAWN P.Schofield

Email - paul@psdreamhome.com  
Mob - 07949 596589

THE COPYRIGHT IN THIS DOCUMENT AND DESIGN IS  
CONFIDENTIAL TO AND THE PROPERTY OF  
PAUL SCHOFIELD ARCHITECTURAL DESIGN LTD