


APPLICATION TO MODIFY APPROVED APPLICATION 250853 - PROPOSED NEW SIDE ELEVATION


Original (approved) application
250853 - details shown in black.

All variations being applied upon
previous (approved) application
250853 - details shown in red.

Scale Bar 1:100 @ A2
0 1 2 3 4 5

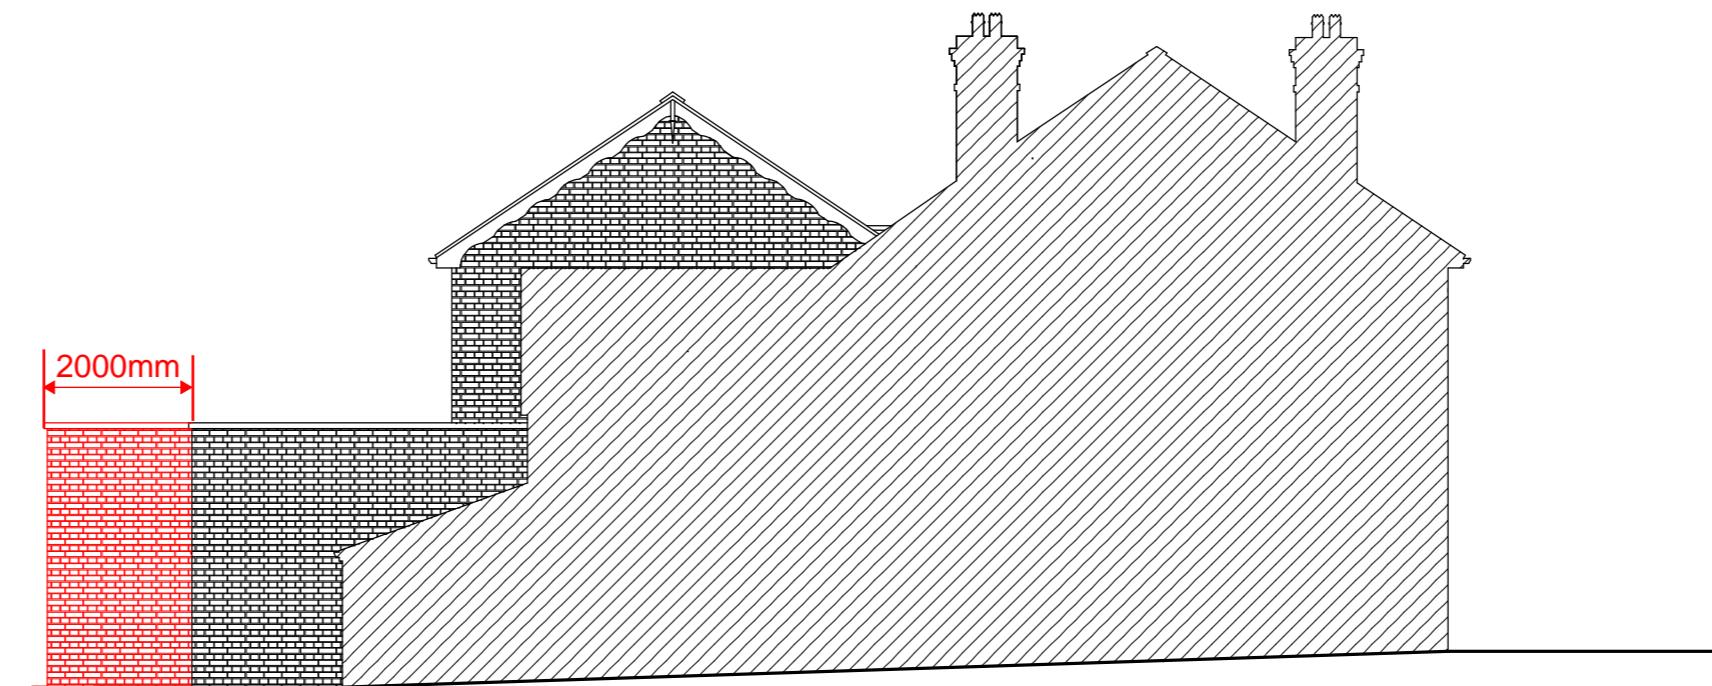

Proposed Left Side Elevation

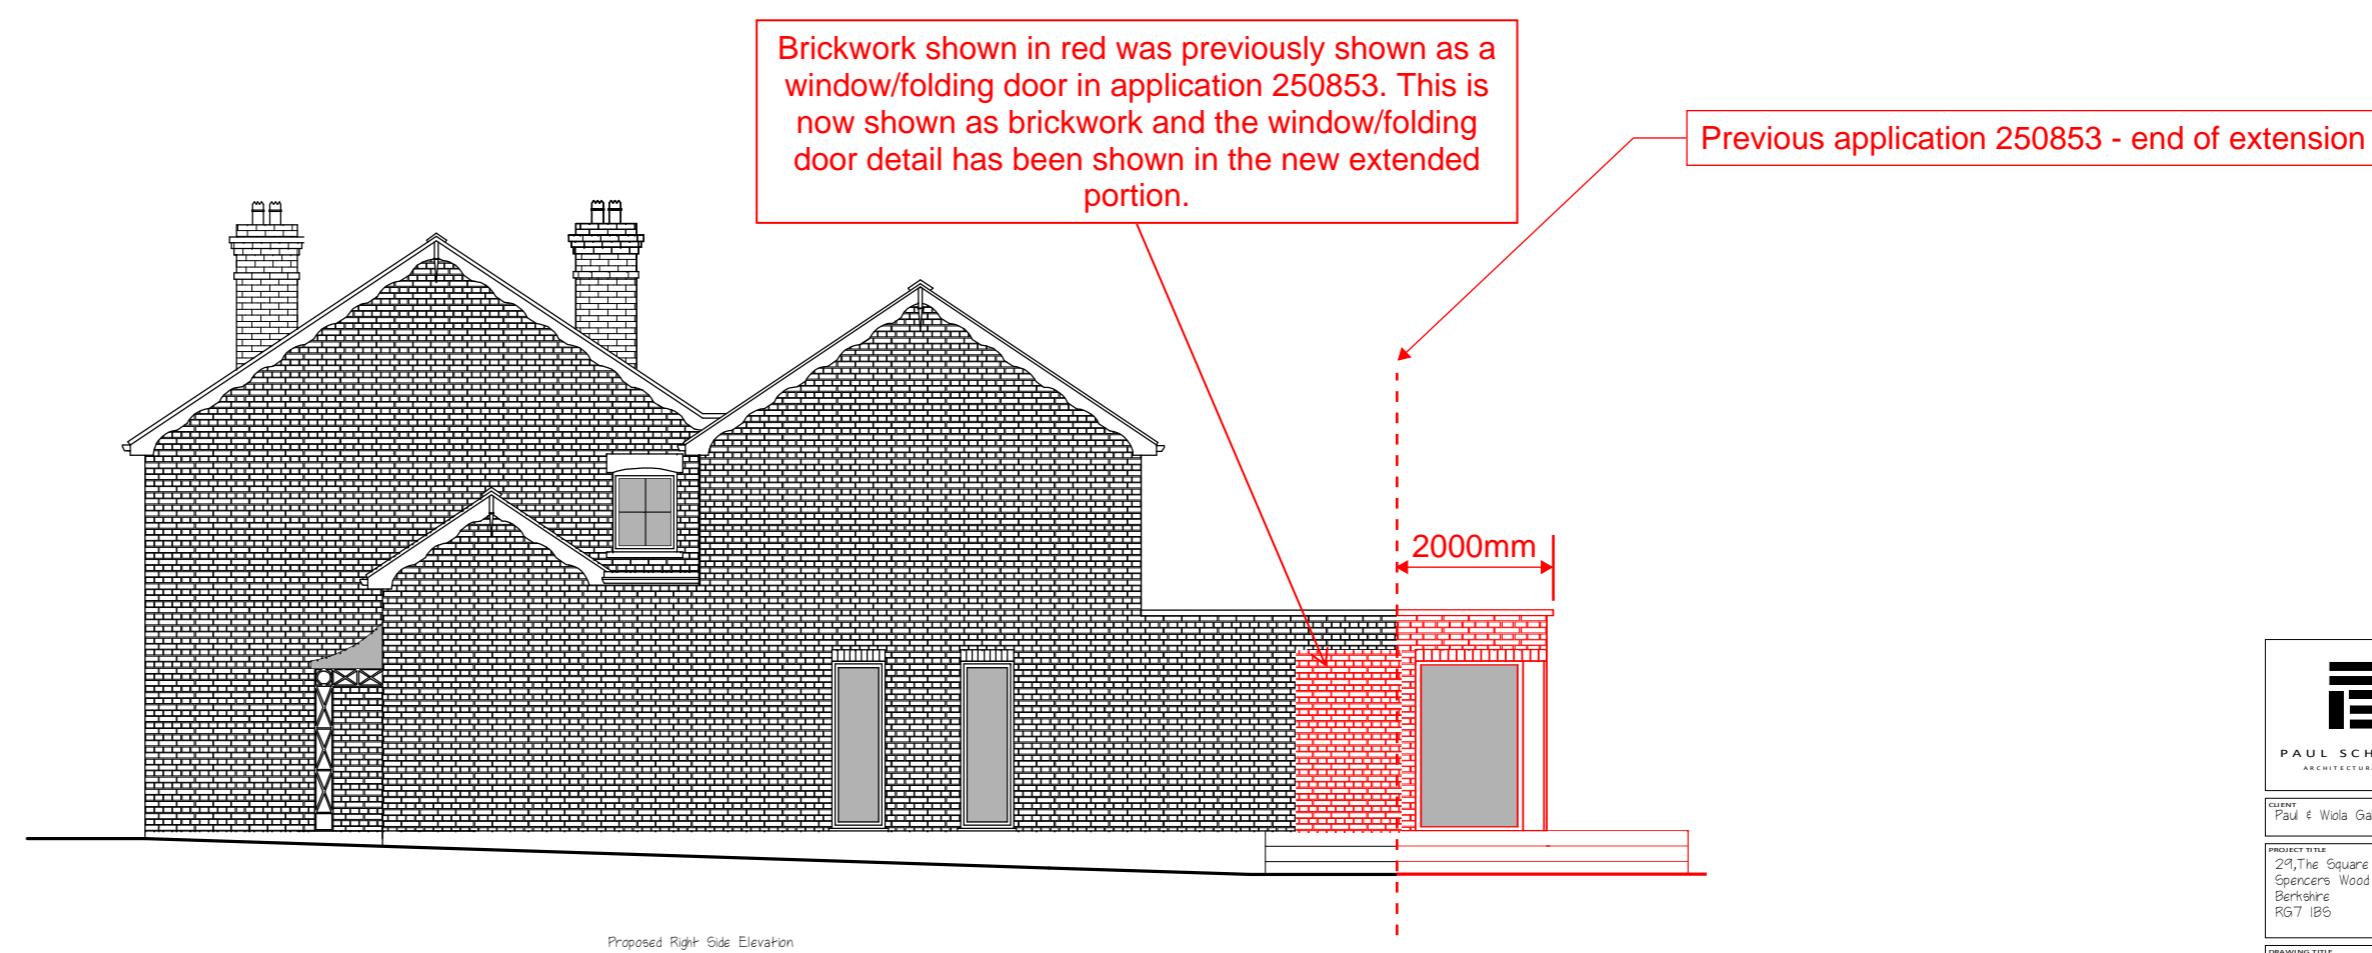

Proposed Right Side Elevation

PAUL SCHOFIELD
ARCHITECTURAL DESIGN
CONTACT: Paul & Viola Galahad
PROJECT NAME: 29, The Square, Greenham, Woking, Surrey, GU21 4BG
DRAWING TITLE: Proposed Side Elevation 3
SCALE: 1:100 DATE: 29-03-23 DRAWN BY: Pschofield
THIS COPYRIGHT IN THIS DOCUMENT AND DESIGN IS CONFIDENTIAL TO AND THE PROPERTY OF PAUL SCHOFIELD