


PLEASE NOTE:
THESE PLANS MUST NOT BE ACTED UPON UNTIL THE APPROPRIATE
PLANNING AND BUILDING REGULATION APPROVALS HAVE BEEN GRANTED.
SHOULD THE WORKS BE UNDERTAKEN PRIOR TO THE ABOVE APPROVALS
BEING IN PLACE, IT IS DONE SO ENTIRELY AT THE CLIENTS OWN RISK.

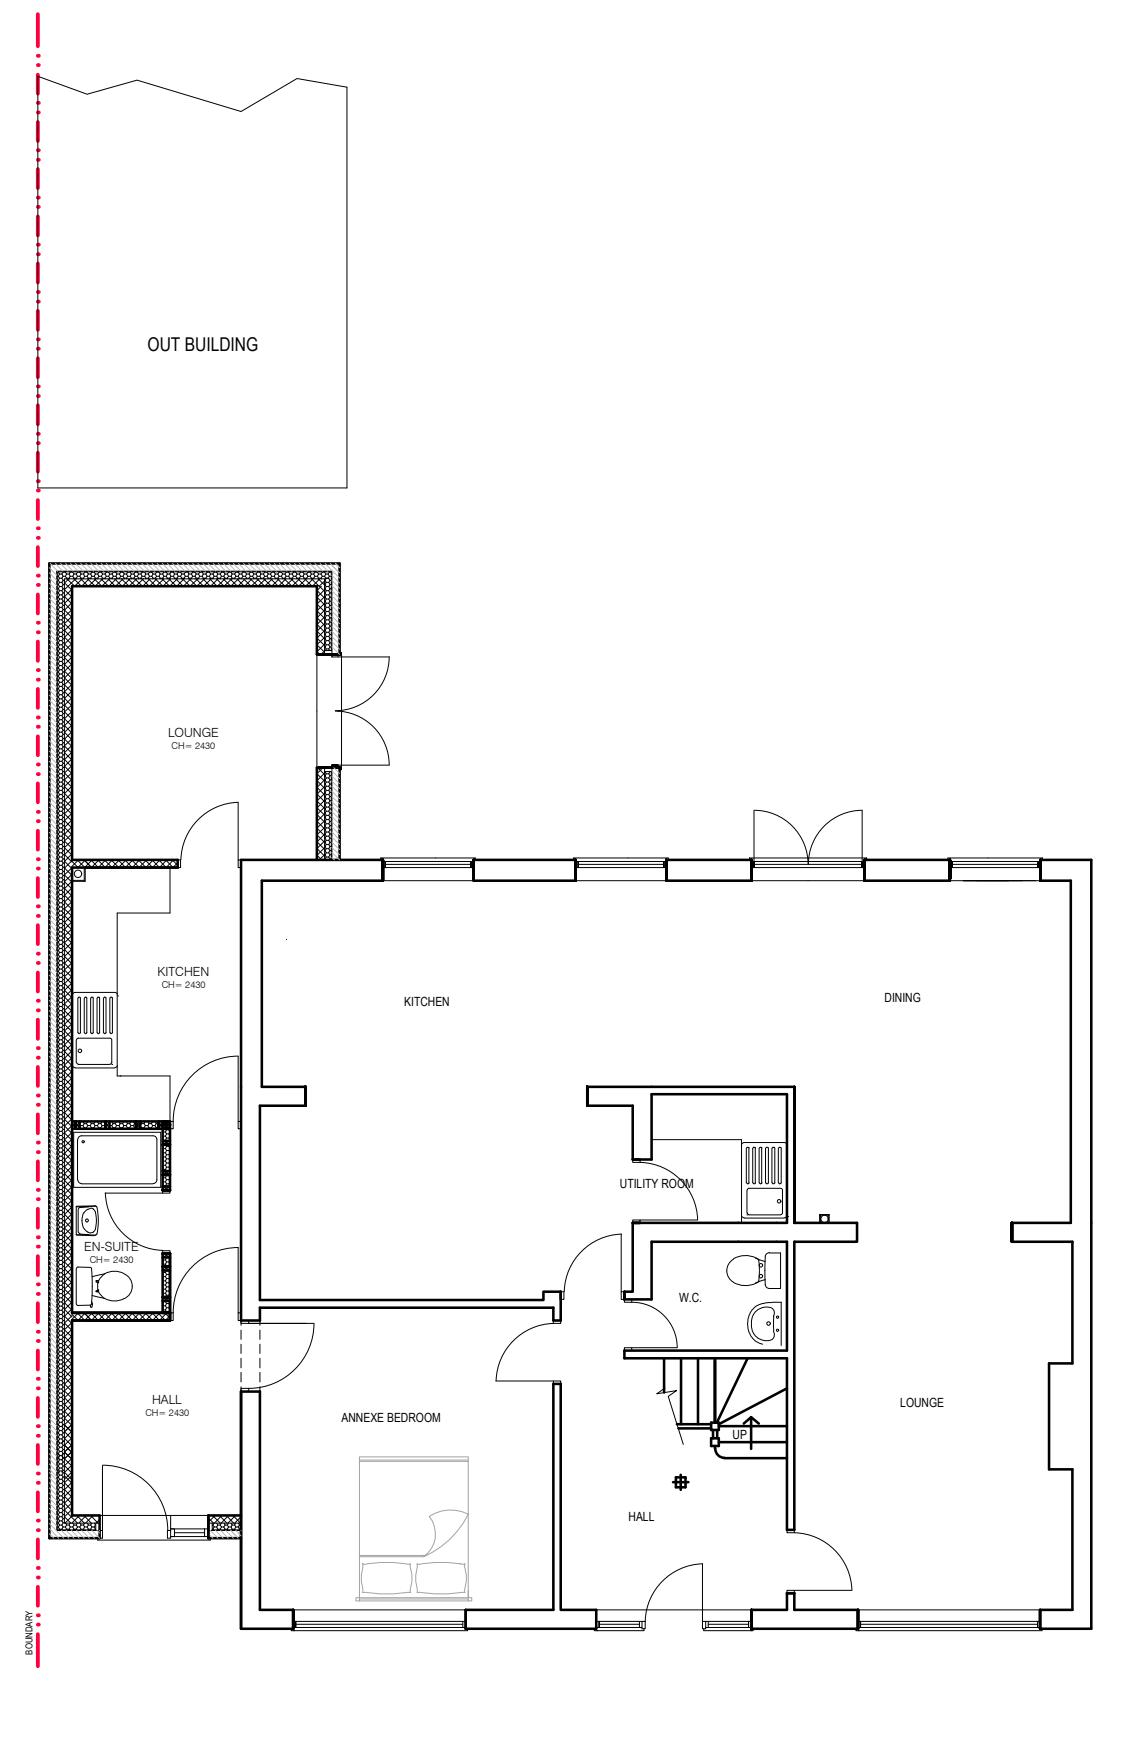

AS BUILT GROUND FLOOR PLAN

0 0.5 1 1.5 2 3 4 5m
SCALE 1:100

PROJECT:
384 LONDON ROAD
EARLEY
READING
RG6 1BA

DRAWING TITLE:
AS BUILT GROUND
FLOOR PLAN



CREATIVE DESIGN
& STRUCTURE

UNIT 1, HENSON HOUSE,
NEWTOWN ROAD
HENLEY-ON-THAMES, RG9 1HG
TEL: 01491411922

DRAWN: E.B
SCALE: 1:100 @ A3
DATE: APRIL 2024
STATUS: PLANNING

DRAWING NO. 31522-12
REV. A