


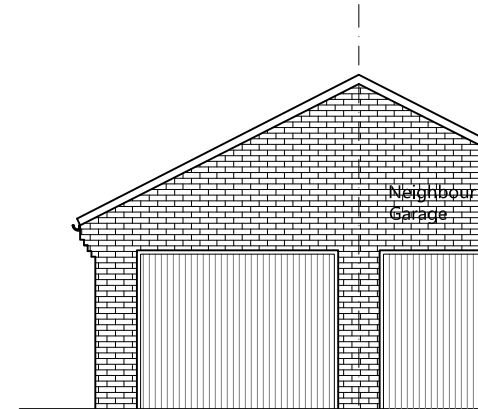


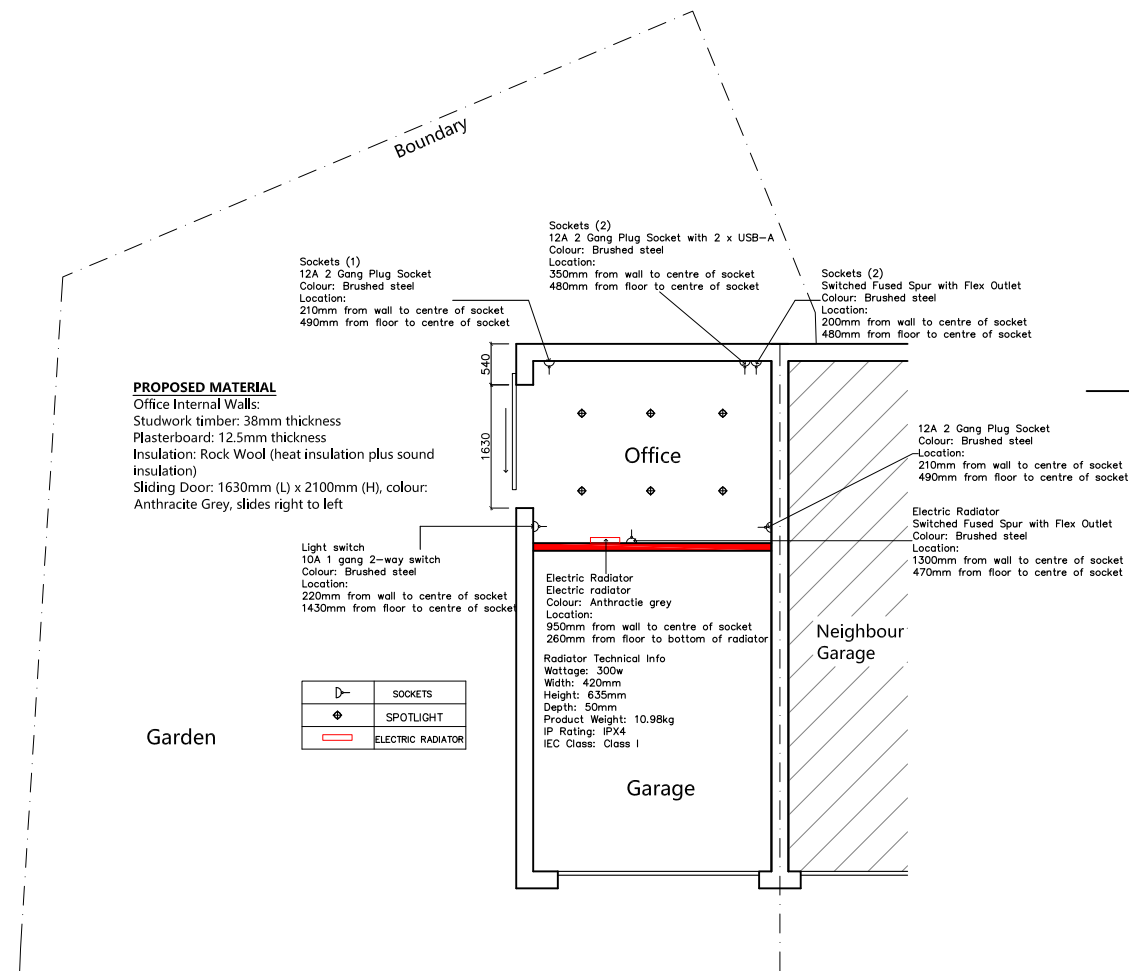


As Built
Front Elevation

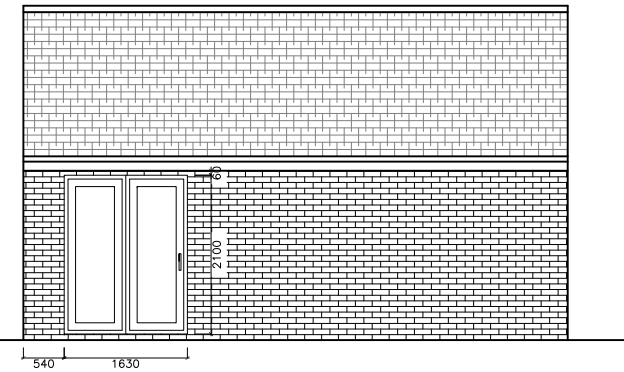

As Built
Side Elevation - A

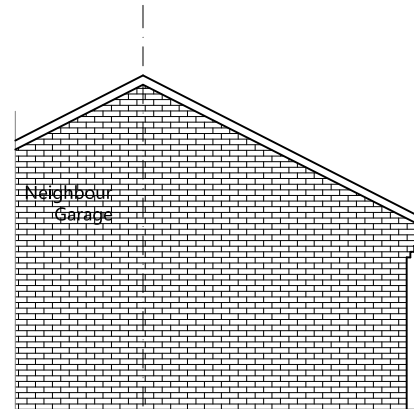

As Built
Rear Elevation

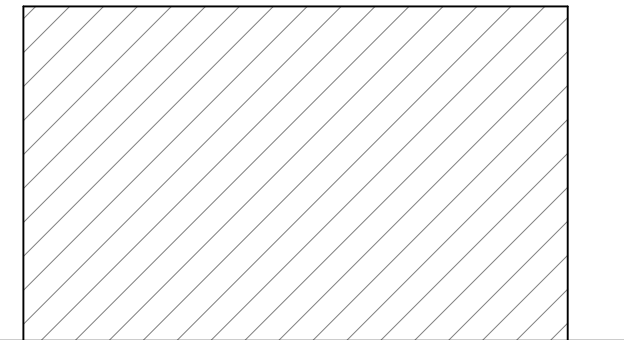

As Built
Side Elevation - B



Project

27 BOLTON DRIVE RG2 9RD

Drawing

AS BUILT PLAN AND ELEVATIONS

Dwg No.

104

Date

JULY 2026

Scale @ A3

1:100

Scale 1:100 0 1 2.5 5 10m