
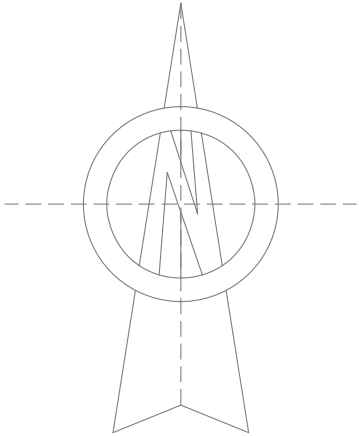


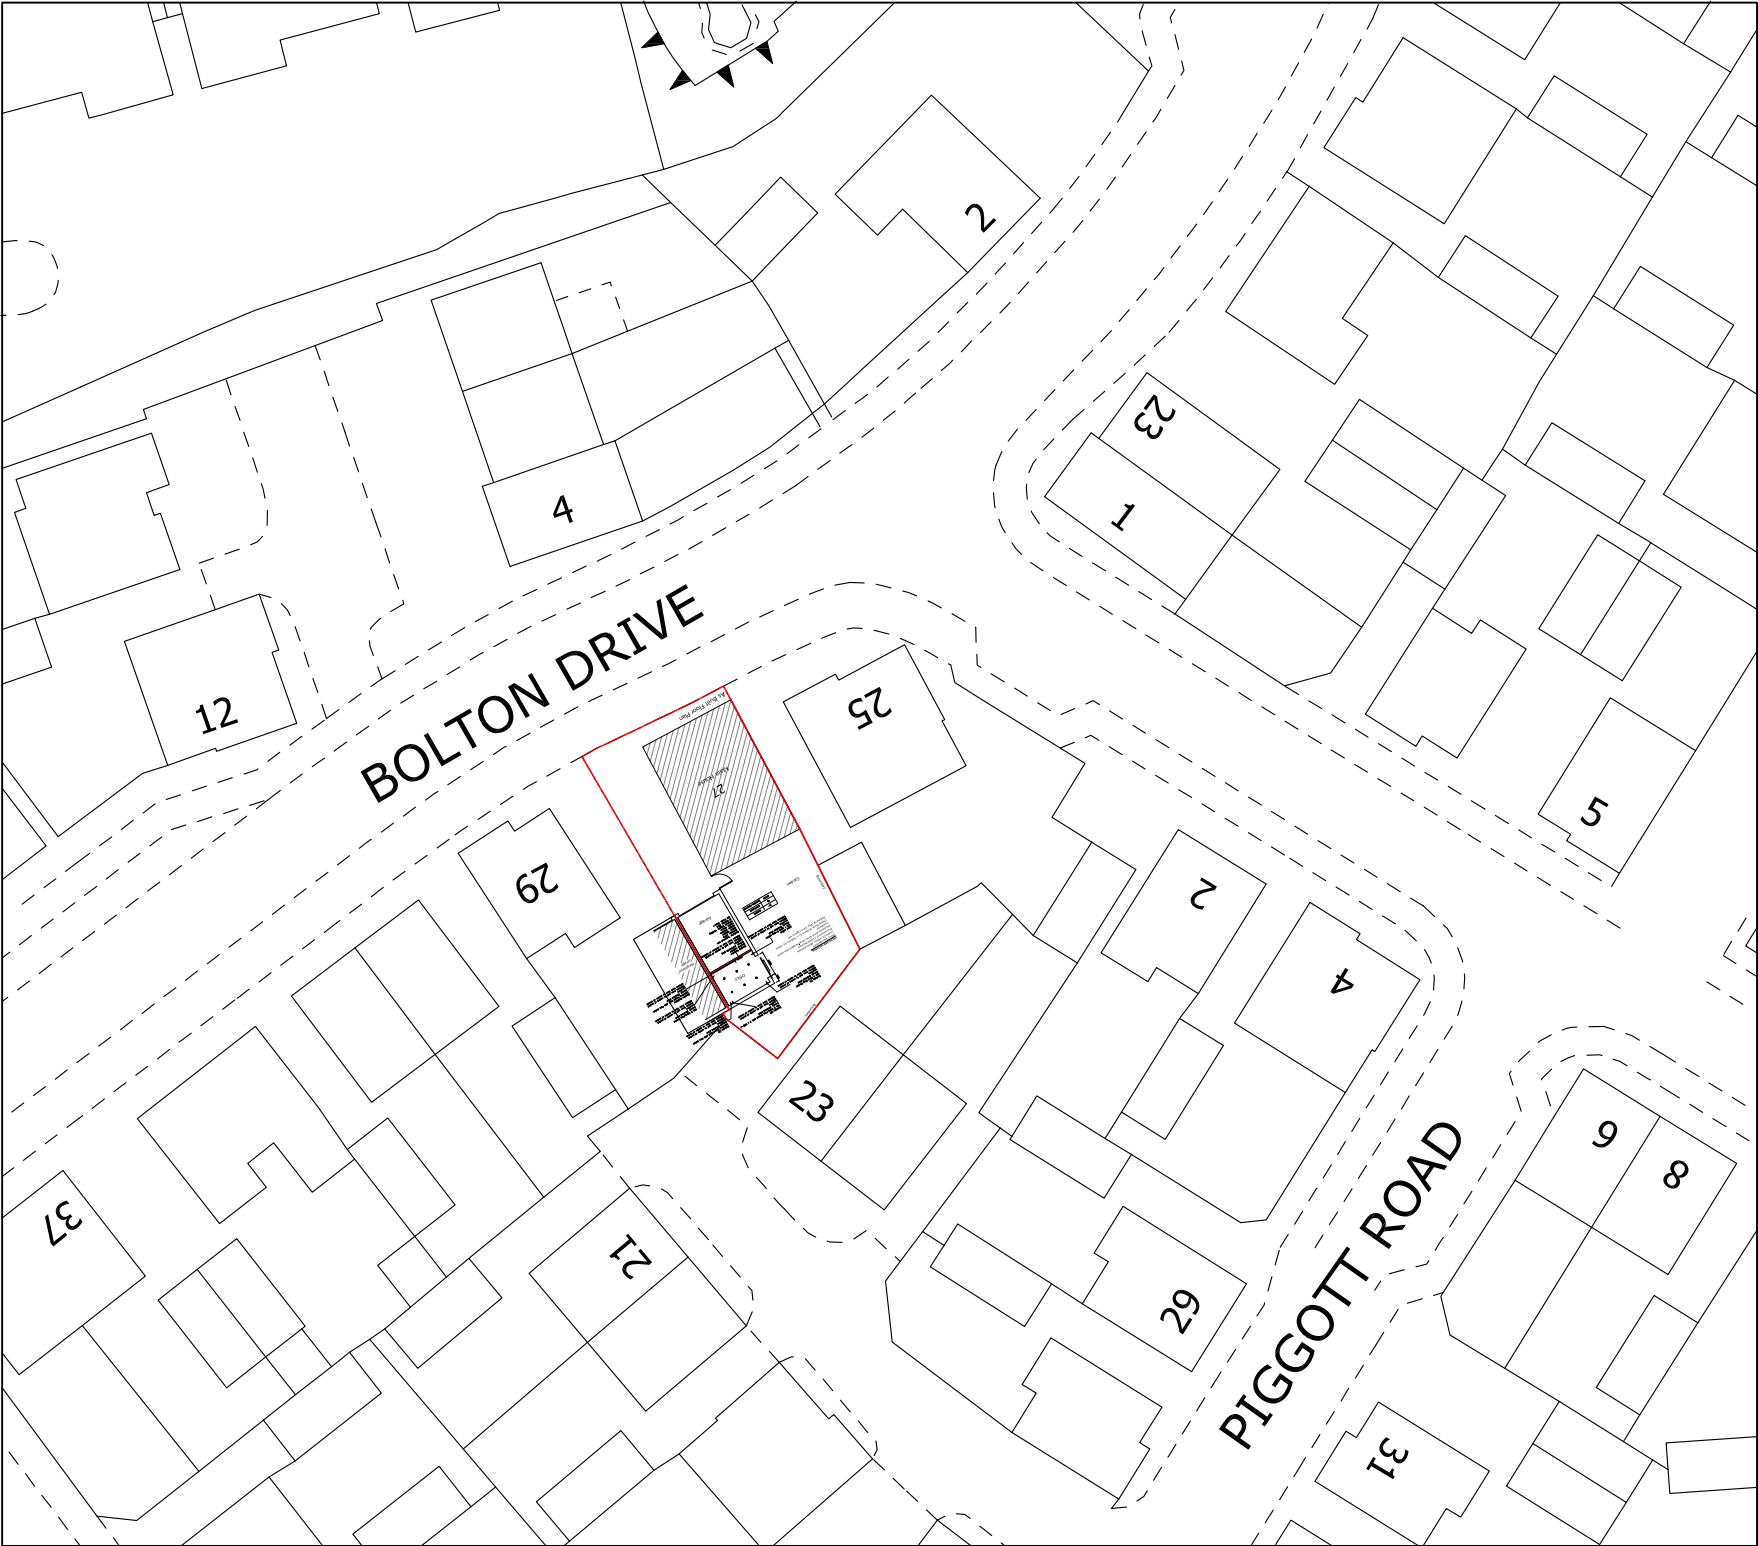

Project
27 BOLTON DRIVE RG2 9RD

Drawing
AS BUILT BLOCK PLAN

Dwg No. 106	Date JULY 2026
-----------------------	--------------------------

Scale @ A3	1:500
-------------------	-------