


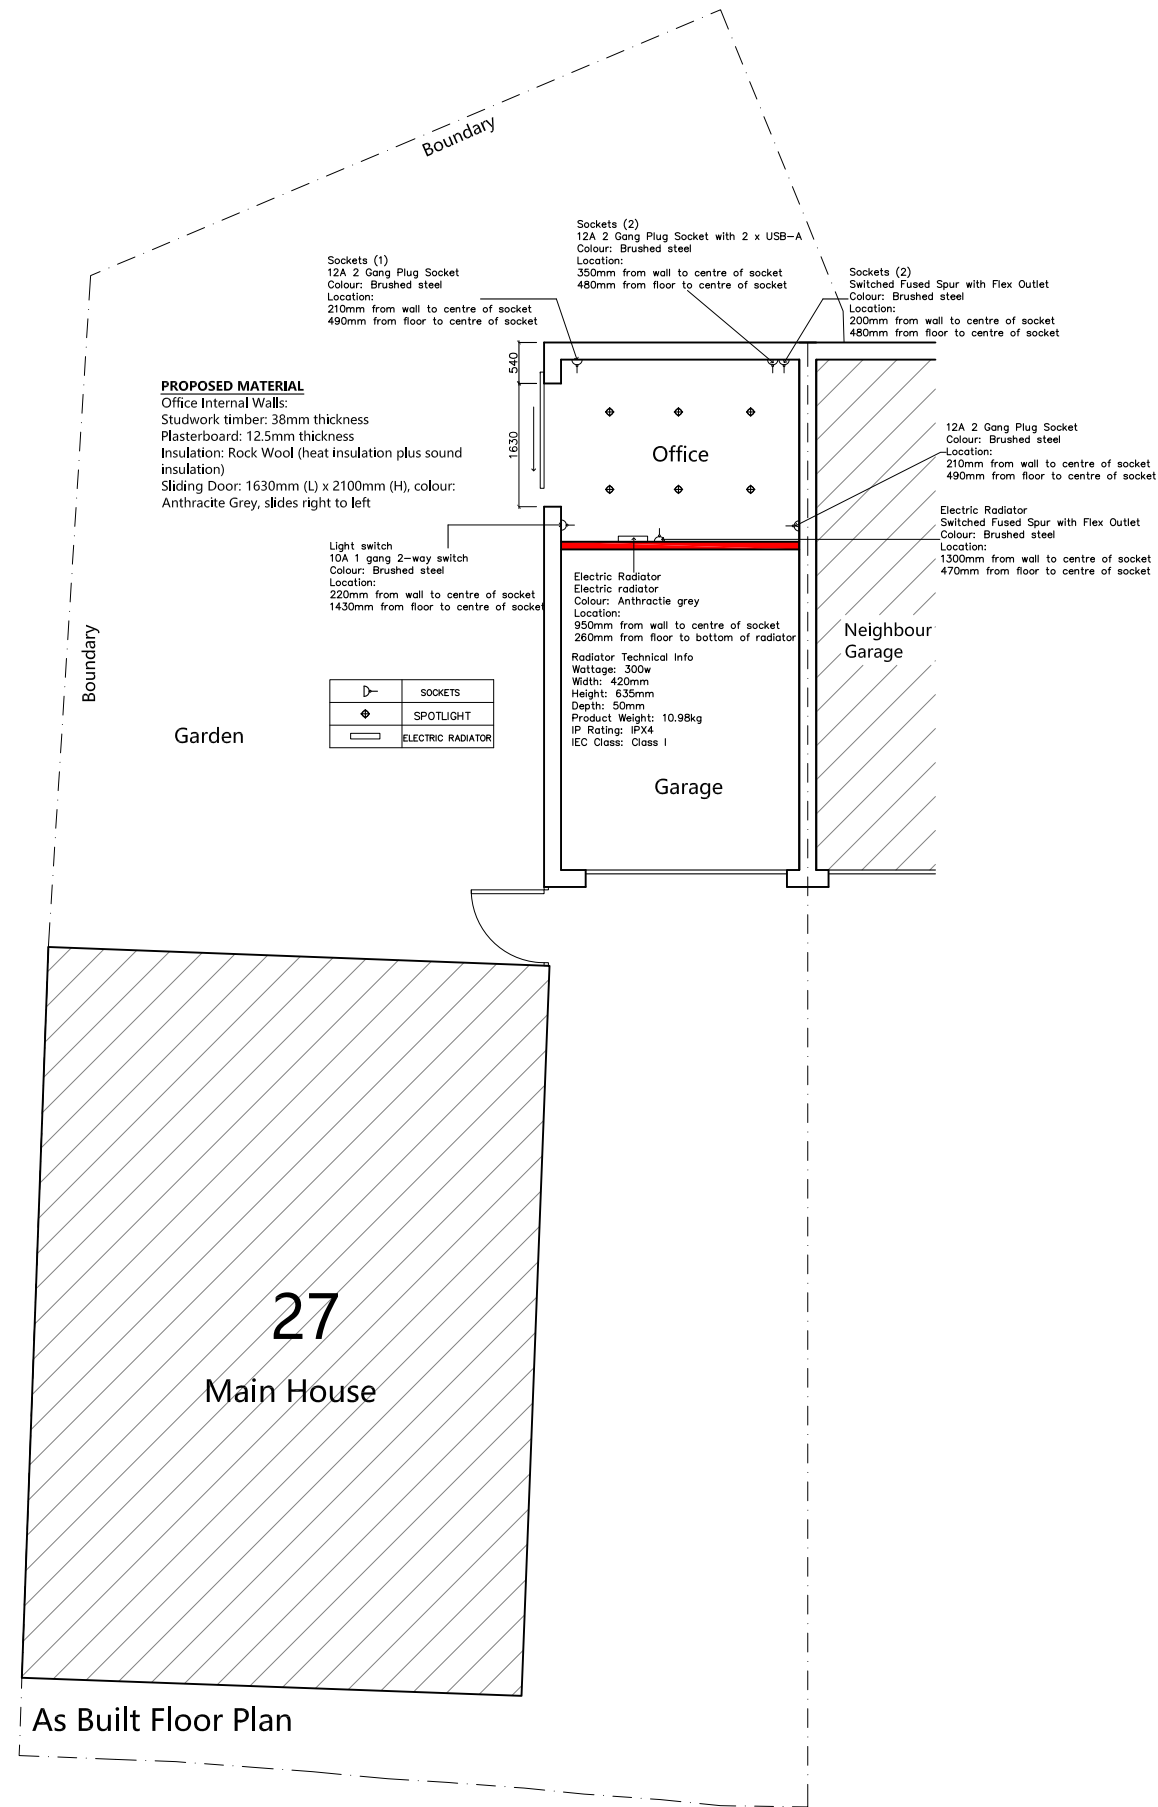

Scale 1:100 0 1 2.5 5 10m



Project 27 BOLTON DRIVE RG2 9RD	
Drawing AS BUILT PLAN	
Dwg No. 103	Date JULY 2026
Scale @ A3 1:100	