

Our Ref: 39048101 Your Ref: 252379

Tuesday, 14 October 2025

Marcia Head
Council Offices Shute End
WOKINGHAM
BRK
RG40 1BN

Dear Marcia Head

Gigaclear Ltd - Asset Network Plans

We acknowledge with thanks your request for information regarding the location of our apparatus.

Please find enclosed plan(s) showing the approximate location known to be in the vicinity of your scheme. Attached are conditions and information regarding the Gigaclear Network. Please ensure these details are made available to any of your operatives carrying out any works on your behalf.

Please note that the accuracy of the Gigaclear network cannot be guaranteed, and it is strongly advised that you undertake hand dug trial holes prior to commencing any of your works.

Please contact us using this email address diversions@gigaclear.com for requests for Diversionary Estimates, or for queries with the data provided.


When requesting Diversionary Works estimates please provide as much information as possible eg, Full site address including postcode, together with plan & section drawings, brief scope of works and contact details. Any damage caused to the Gigaclear apparatus, should be promptly reported to:

Email: noc@gigaclear.com

Tel: 01865 591185

Yours sincerely,

Gigaclear Diversionary Works Team
diversions@gigaclear.com

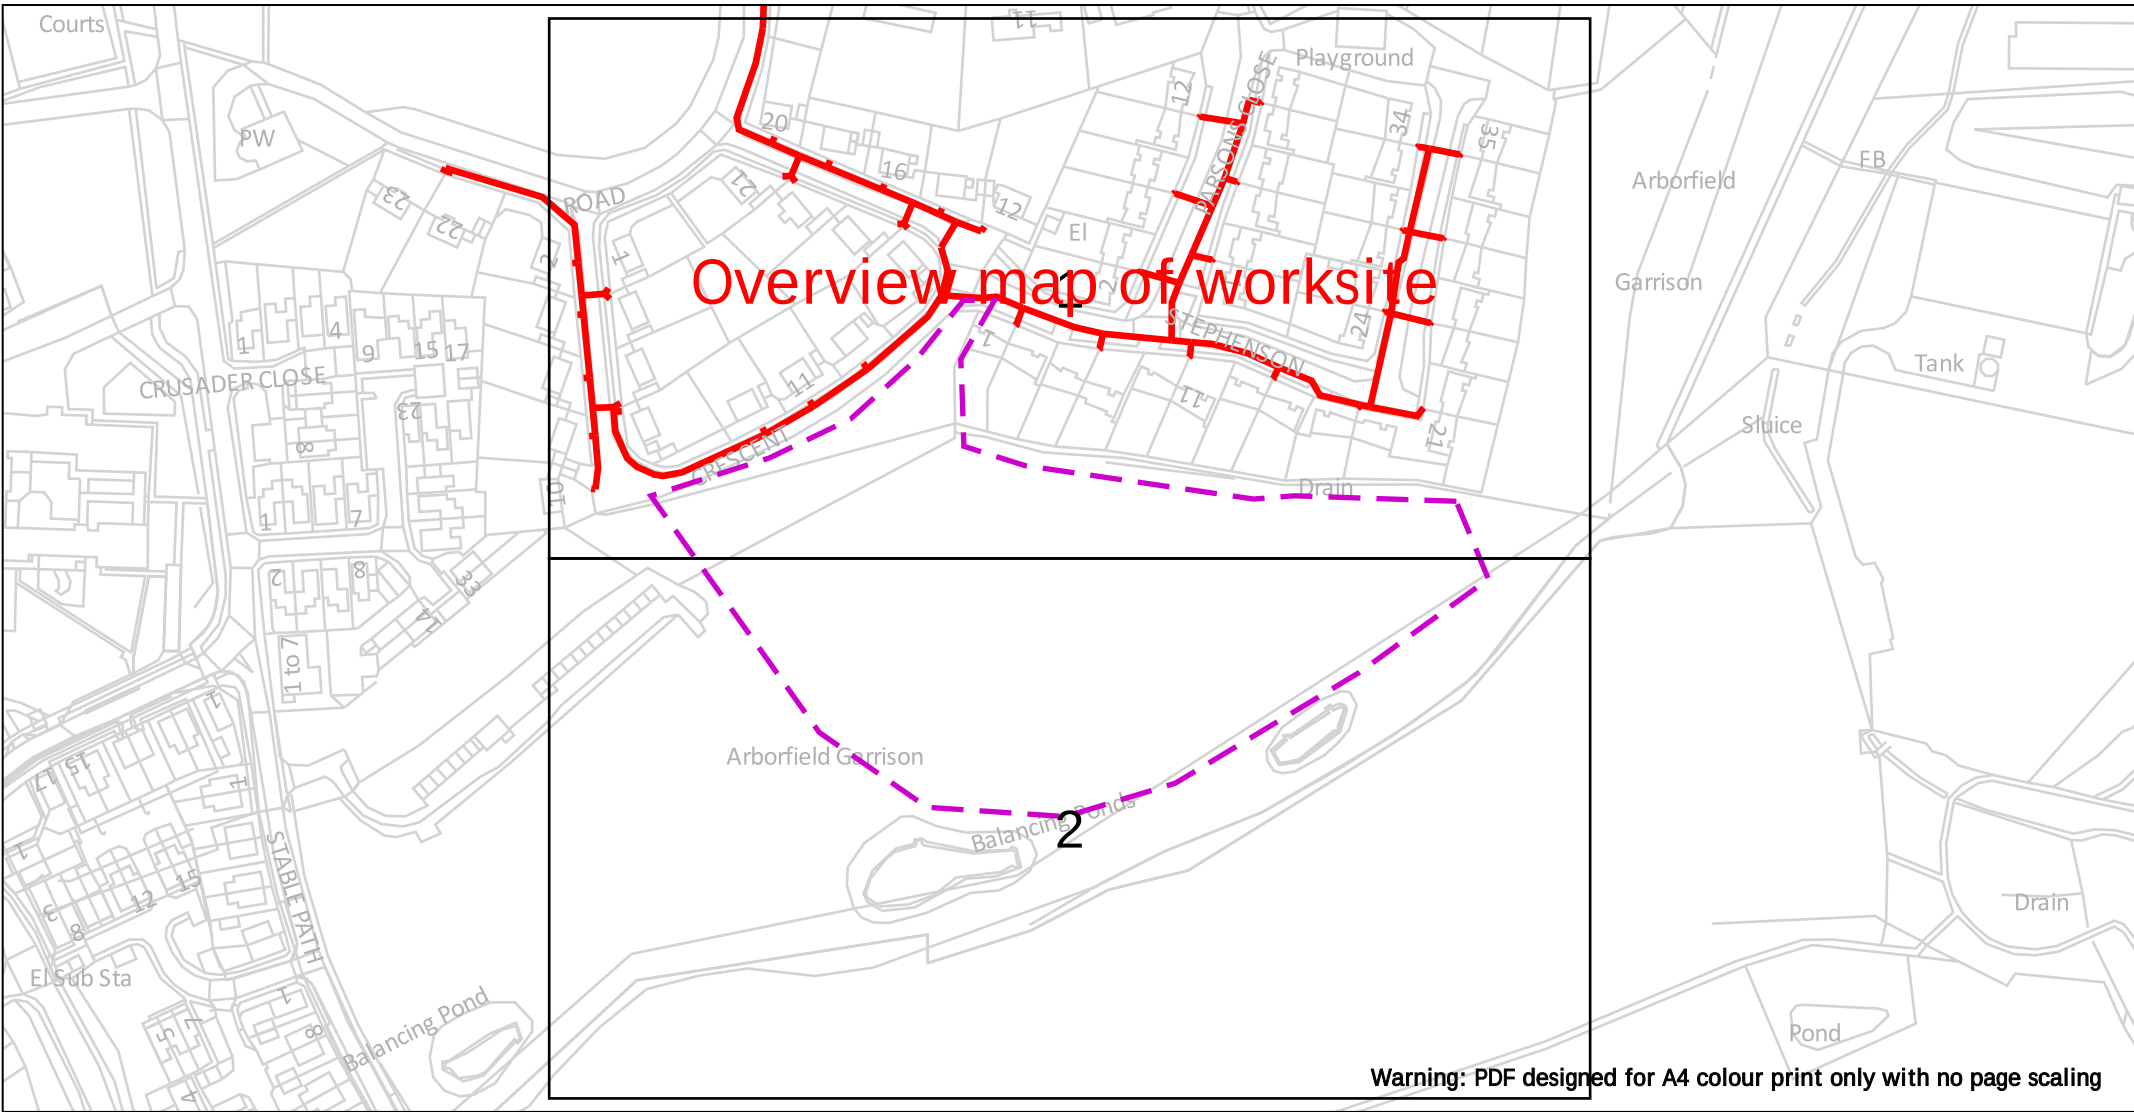

Warning: PDF designed for A4 colour print only with no page scaling

Dig Sites Area:  Line: 

The quality and accuracy of any print will depend on your printer, your computer and its print settings. Measurements scaled from this plan may not match measurements between the same points on the ground.



Date Requested: 14/10/2025
Job Reference: 39048101
Site Location: 476906 165307
Requested by:
Mrs Marcia Head
Your Scheme/Reference:
252379


The information on this document is proprietary and shall not be used, copied, reproduced or disclosed in whole or in part without written consent of Gigaclear Ltd. The location of Gigaclear's apparatus is indicated on the plan for general guidance but the exact location may vary from that shown. Gigaclear Ltd cannot guarantee the accuracy of this document and Safe Digging Practices should always be used to identify the exact location of any utility's plant. Gigaclear Ltd accept no liability for any errors or omissions.

Scale: 1:2563 (When plotted at A4)

 Gigaclear Route


In Emergency Call: 01865 59 11 85

Gigaclear Ltd,
Building 1, Wyndyke Furlong,
Abingdon,
OX14 1UQ
T: 01865 59 11 21
diversions@Gigaclear.com

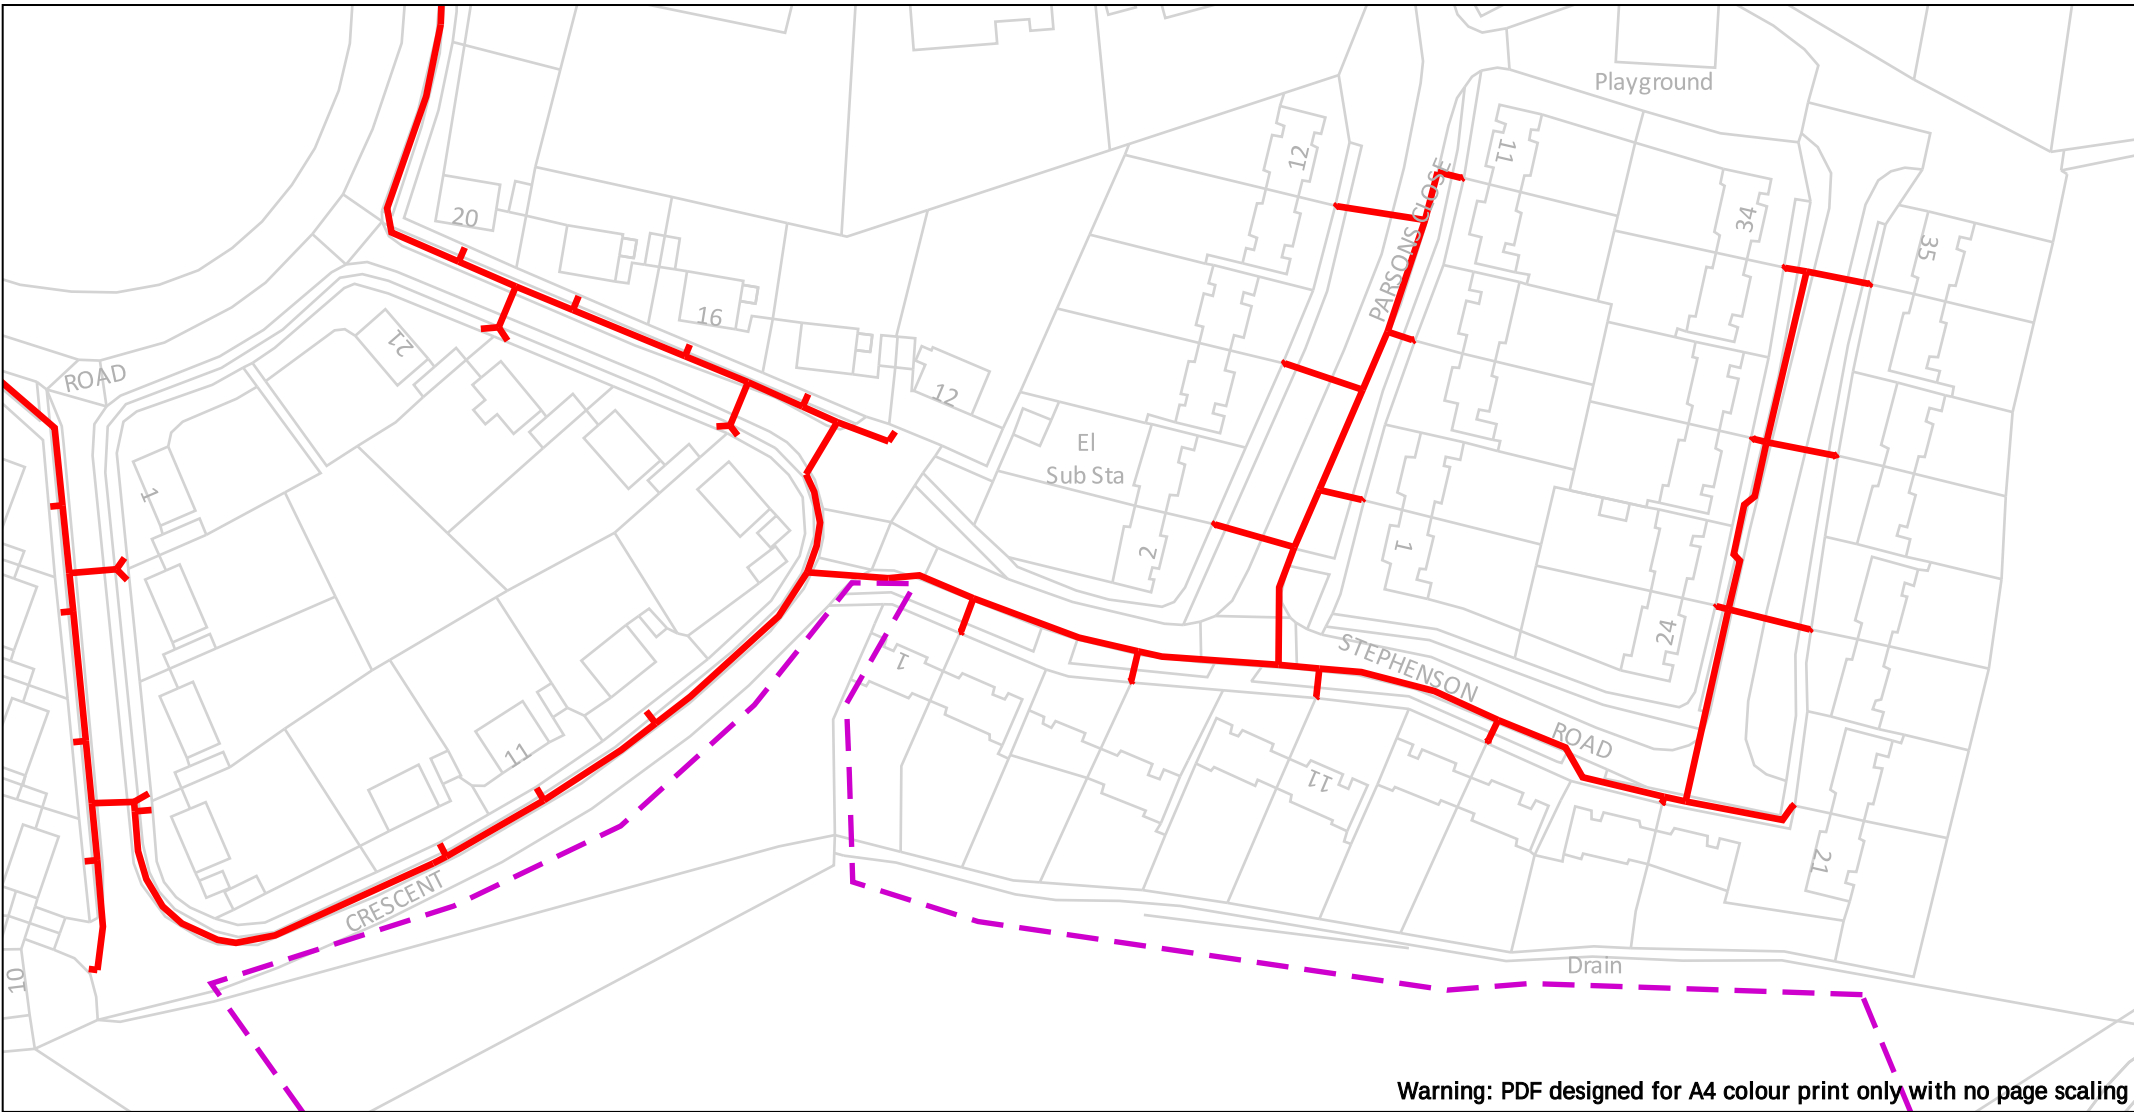

Warning: PDF designed for A4 colour print only with no page scaling

0 50m Dig Sites Area: Line:		The quality and accuracy of any print will depend on your printer, your computer and its print settings. Measurements scaled from this plan may not match measurements between the same points on the ground.			
Date Requested: 14/10/2025 Job Reference: 39048101 Site Location: 476906 165307 Requested by: Mrs Marcia Head Your Scheme/Reference: 252379		The information on this document is proprietary and shall not be used, copied, reproduced or disclosed in whole or in part without written consent of Gigaclear Ltd. The location of Gigaclear's apparatus is indicated on the plan for general guidance but the exact location may vary from that shown. Gigaclear Ltd cannot guarantee the accuracy of this document and Safe Digging Practices should always be used to identify the exact location of any utility's plant. Gigaclear Ltd accept no liability for any errors or omissions.		Gigaclear Ltd, Building 1, Wyndyke Furlong, Abingdon, OX14 1UQ T: 01865 59 11 21 diversions@Gigaclear.com	
Scale: 1:1250 (When plotted at A4)		Gigaclear Route		In Emergency Call: 01865 59 11 85	

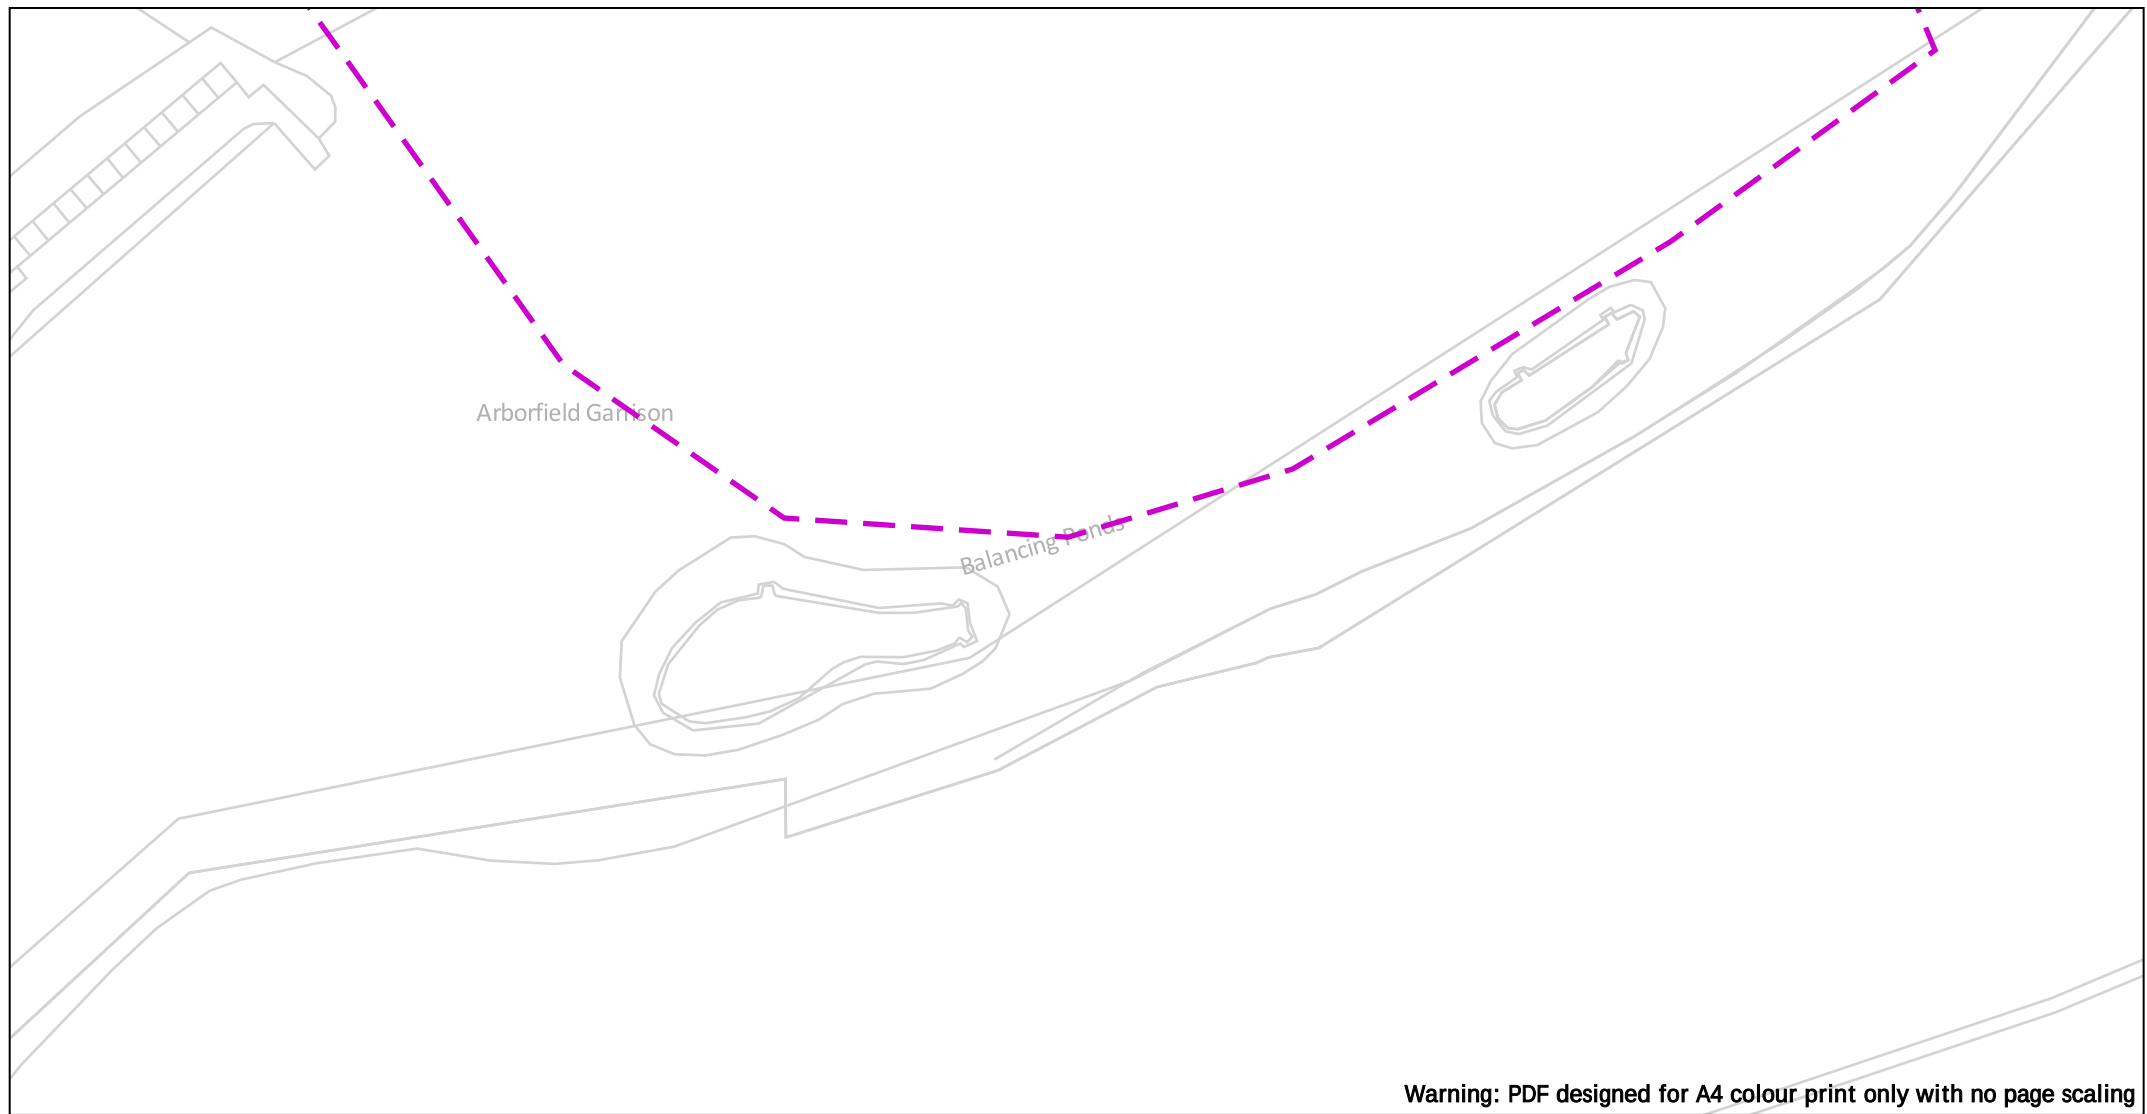

0 50m

Dig Sites Area:  Line: 

The quality and accuracy of any print will depend on your printer, your computer and its print settings. Measurements scaled from this plan may not match measurements between the same points on the ground.



Date Requested: 14/10/2025
Job Reference: 39048101
Site Location: 476906 165307
Requested by:
Mrs Marcia Head
Your Scheme/Reference:
252379

The information on this document is proprietary and shall not be used, copied, reproduced or disclosed in whole or in part without written consent of Gigaclear Ltd. The location of Gigaclear's apparatus is indicated on the plan for general guidance but the exact location may vary from that shown. Gigaclear Ltd cannot guarantee the accuracy of this document and Safe Digging Practices should always be used to identify the exact location of any utility's plant. Gigaclear Ltd accept no liability for any errors or omissions.

Scale: 1:1250 (When plotted at A4)

 Gigaclear Route

In Emergency Call: 01865 59 11 85

Gigaclear Ltd,
Building 1, Wyndyke Furlong,
Abingdon,
OX14 1UQ
T: 01865 59 11 21
diversions@Gigaclear.com