





FRONT ELEVATION




SIDE ELEVATION

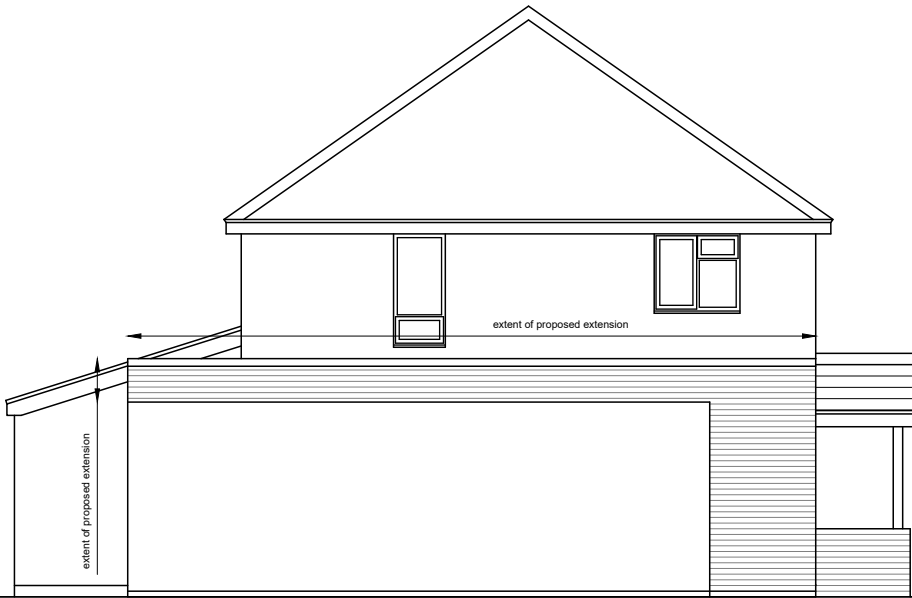


REAR ELEVATION

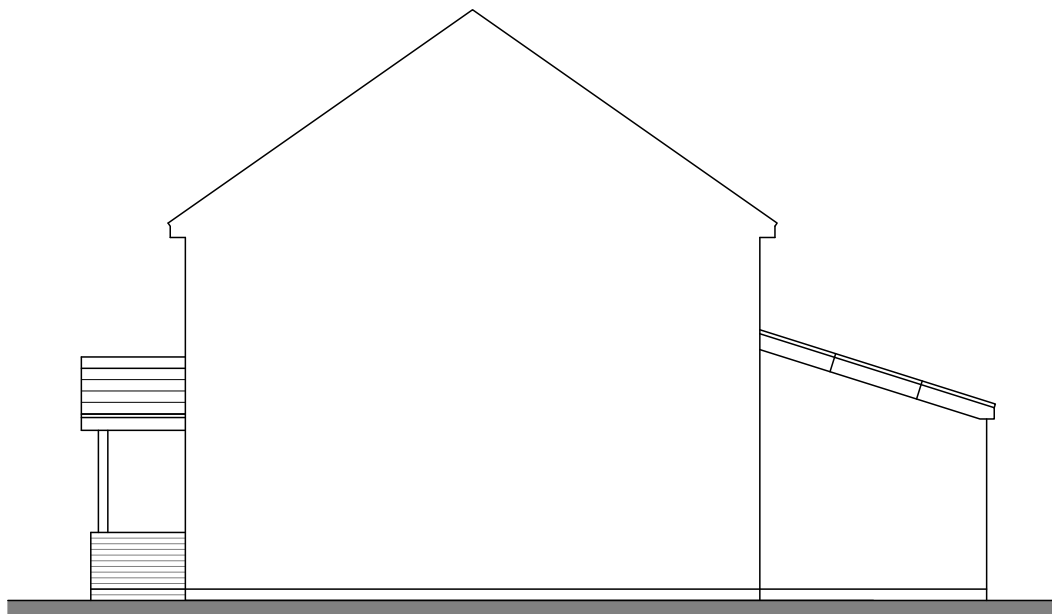

SIDE ELEVATION

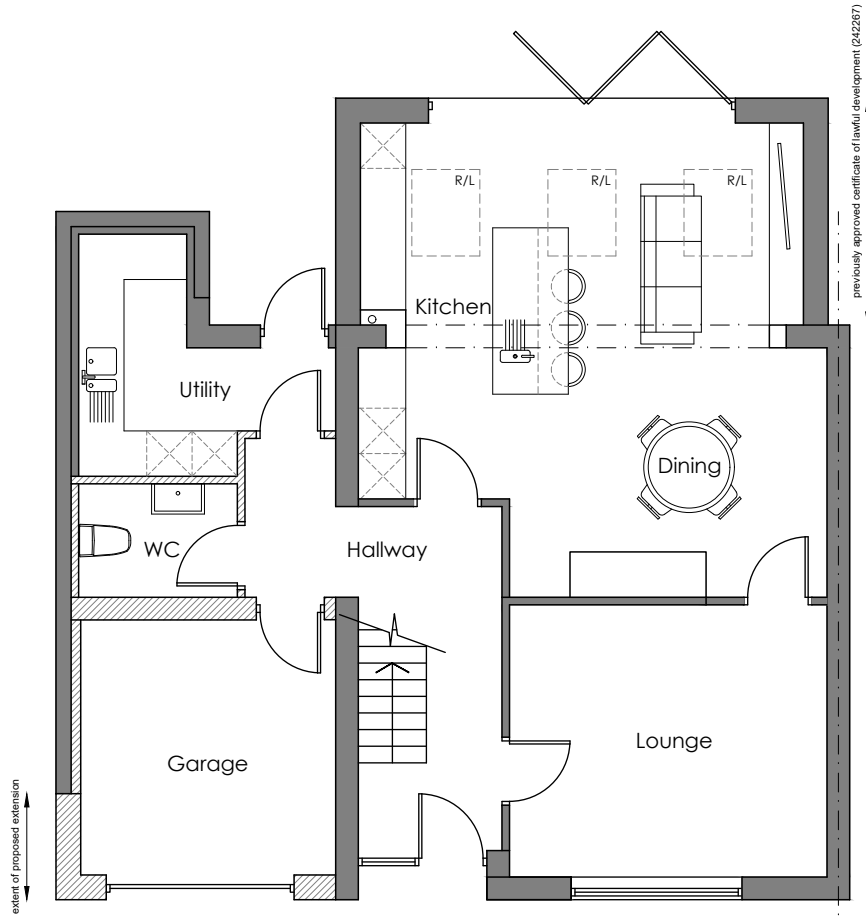

GROUND FLOOR PLAN

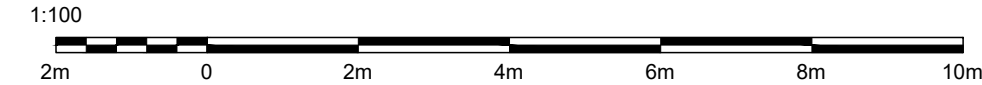

Proposed walls

- D 28.04.26 As built drawing
C 02.03.26 As built drawing
B 14.10.25 Garage door replaced with window and access door
A 06.03.25 Front door moved forward in line with front elevation

CLIENT:
Mr Hatson

PROJECT:
8 Westview Drive
Twyford
Reading
RG10 9BP

DRAWING TITLE:
Proposed Plans and Elevations

PLANNING DRAWING

SCALE 1:100	SHEET A3
DATE September 2024	

DRAWING.NO 03	REV. D
------------------	-----------