



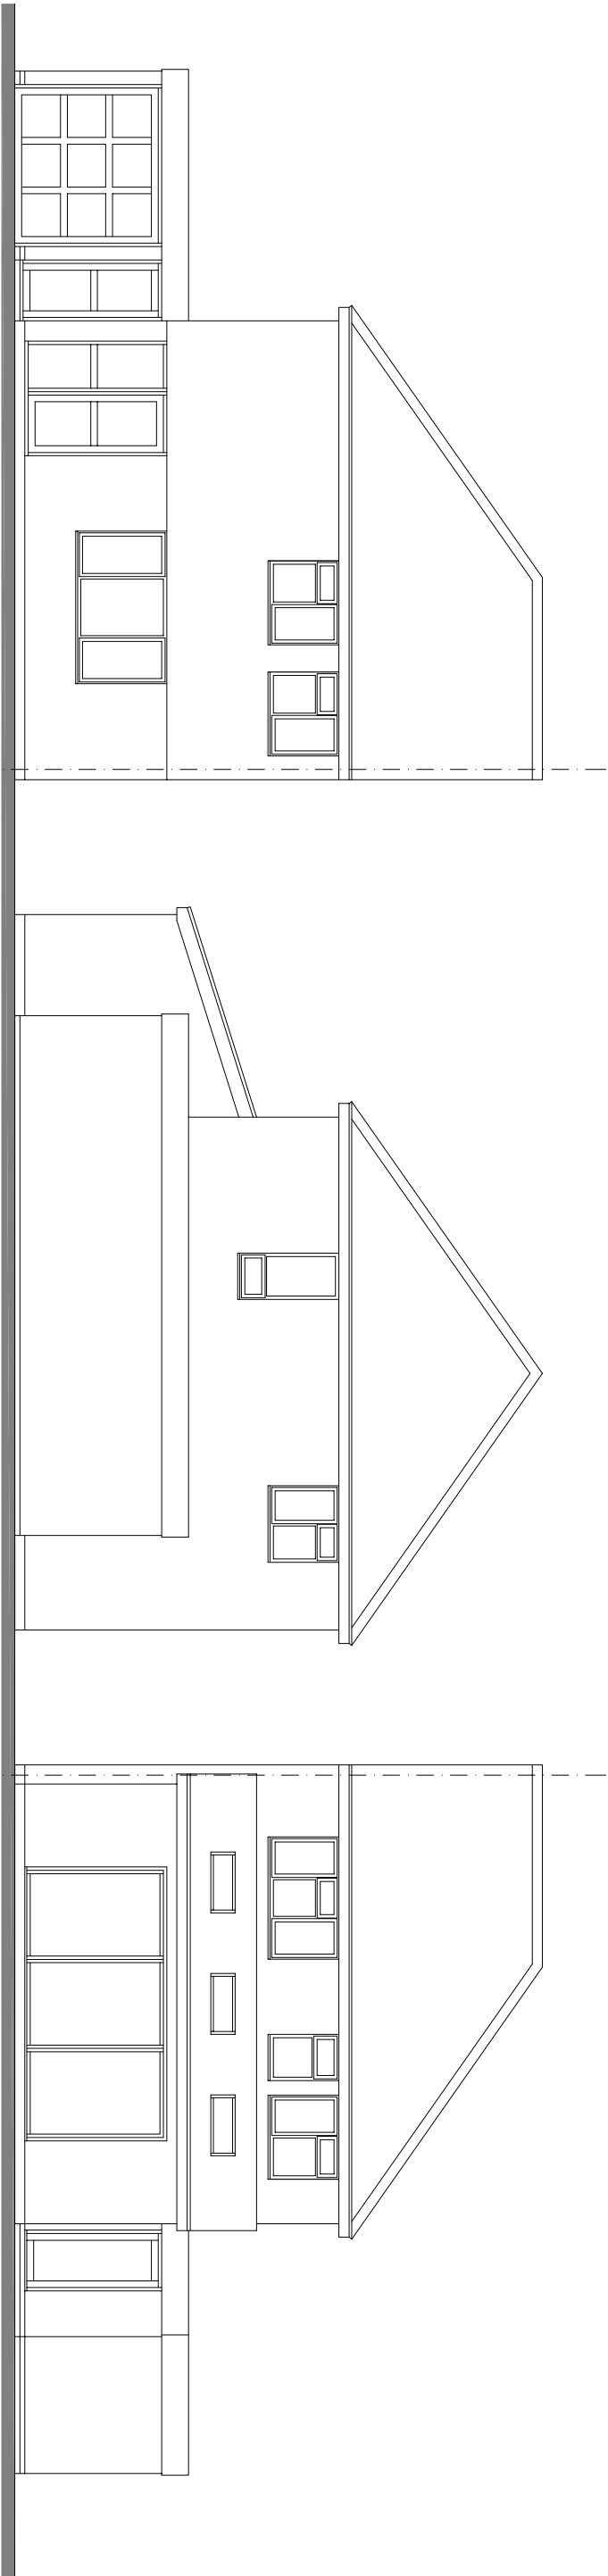


FRONT ELEVATION

SIDE ELEVATION


REAR ELEVATION

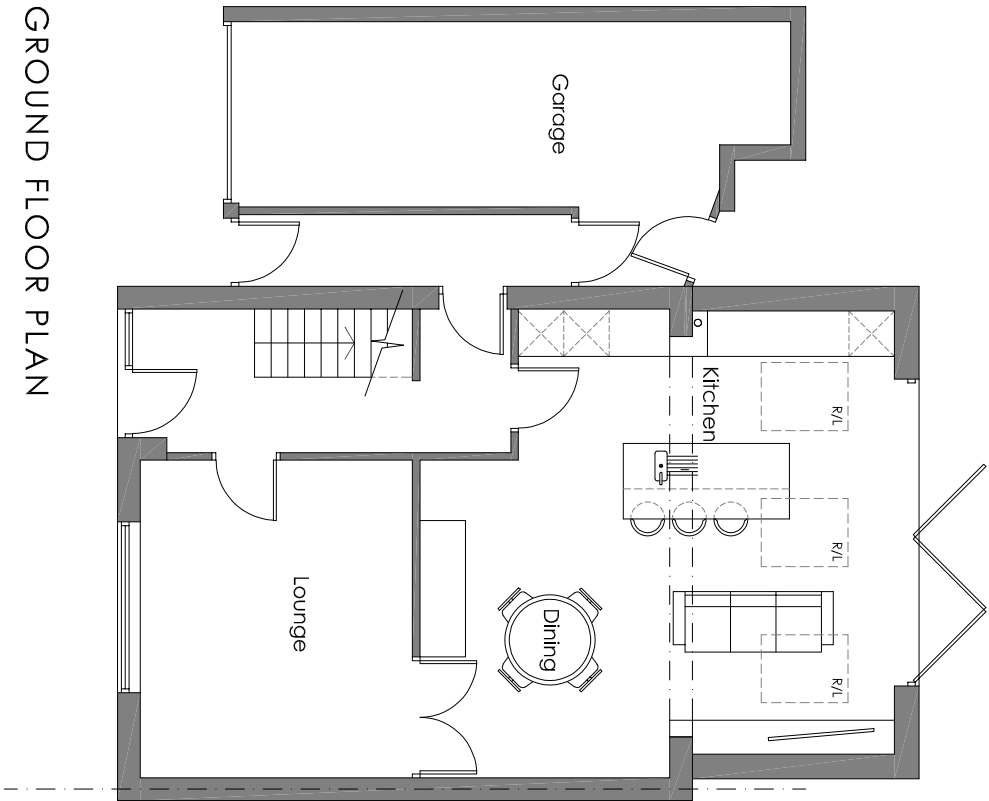

GROUND FLOOR PLAN

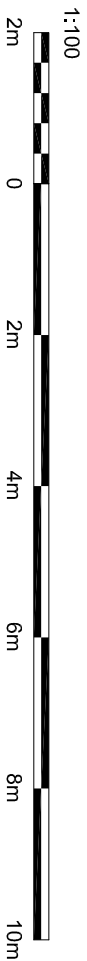

SIDE ELEVATION

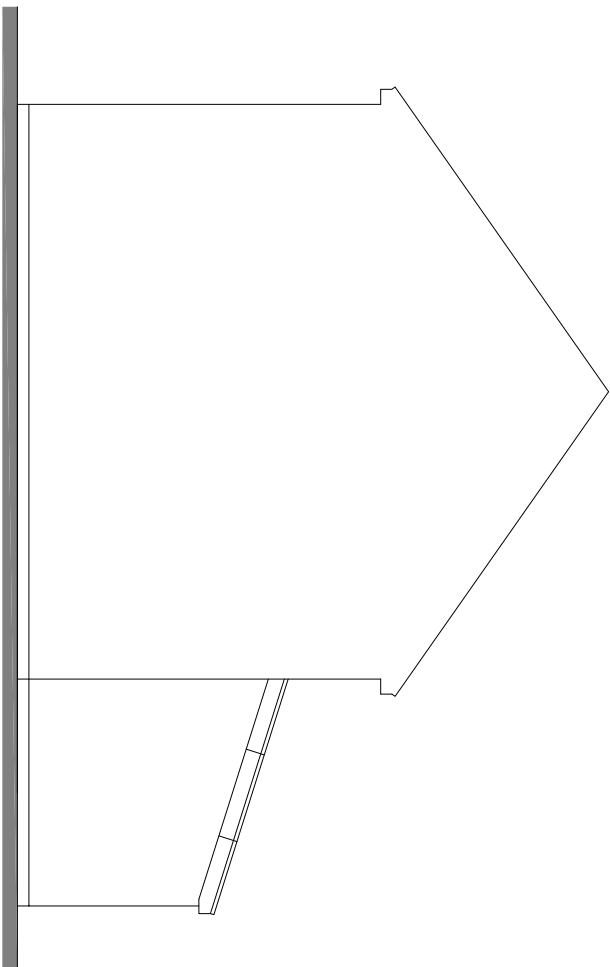

A 28.04.26 As built

CLIENT:
Mr Hobson

PROJECT:
8 Westview Drive
Twyford
Reading
RG10 7BP

DRAWING TITLE:
Existing Plans and Elevations

PLANNING DRAWING

SCALE	SHEET
1:100	A3
DATE	
September 2024	

DRAWING NO	REV.
02	A