


BIMcloud: la-london - BIMcloud Software as a Service/LA London/1177 Project Conway - Riverside Pavilion 03/09/2026 10:49

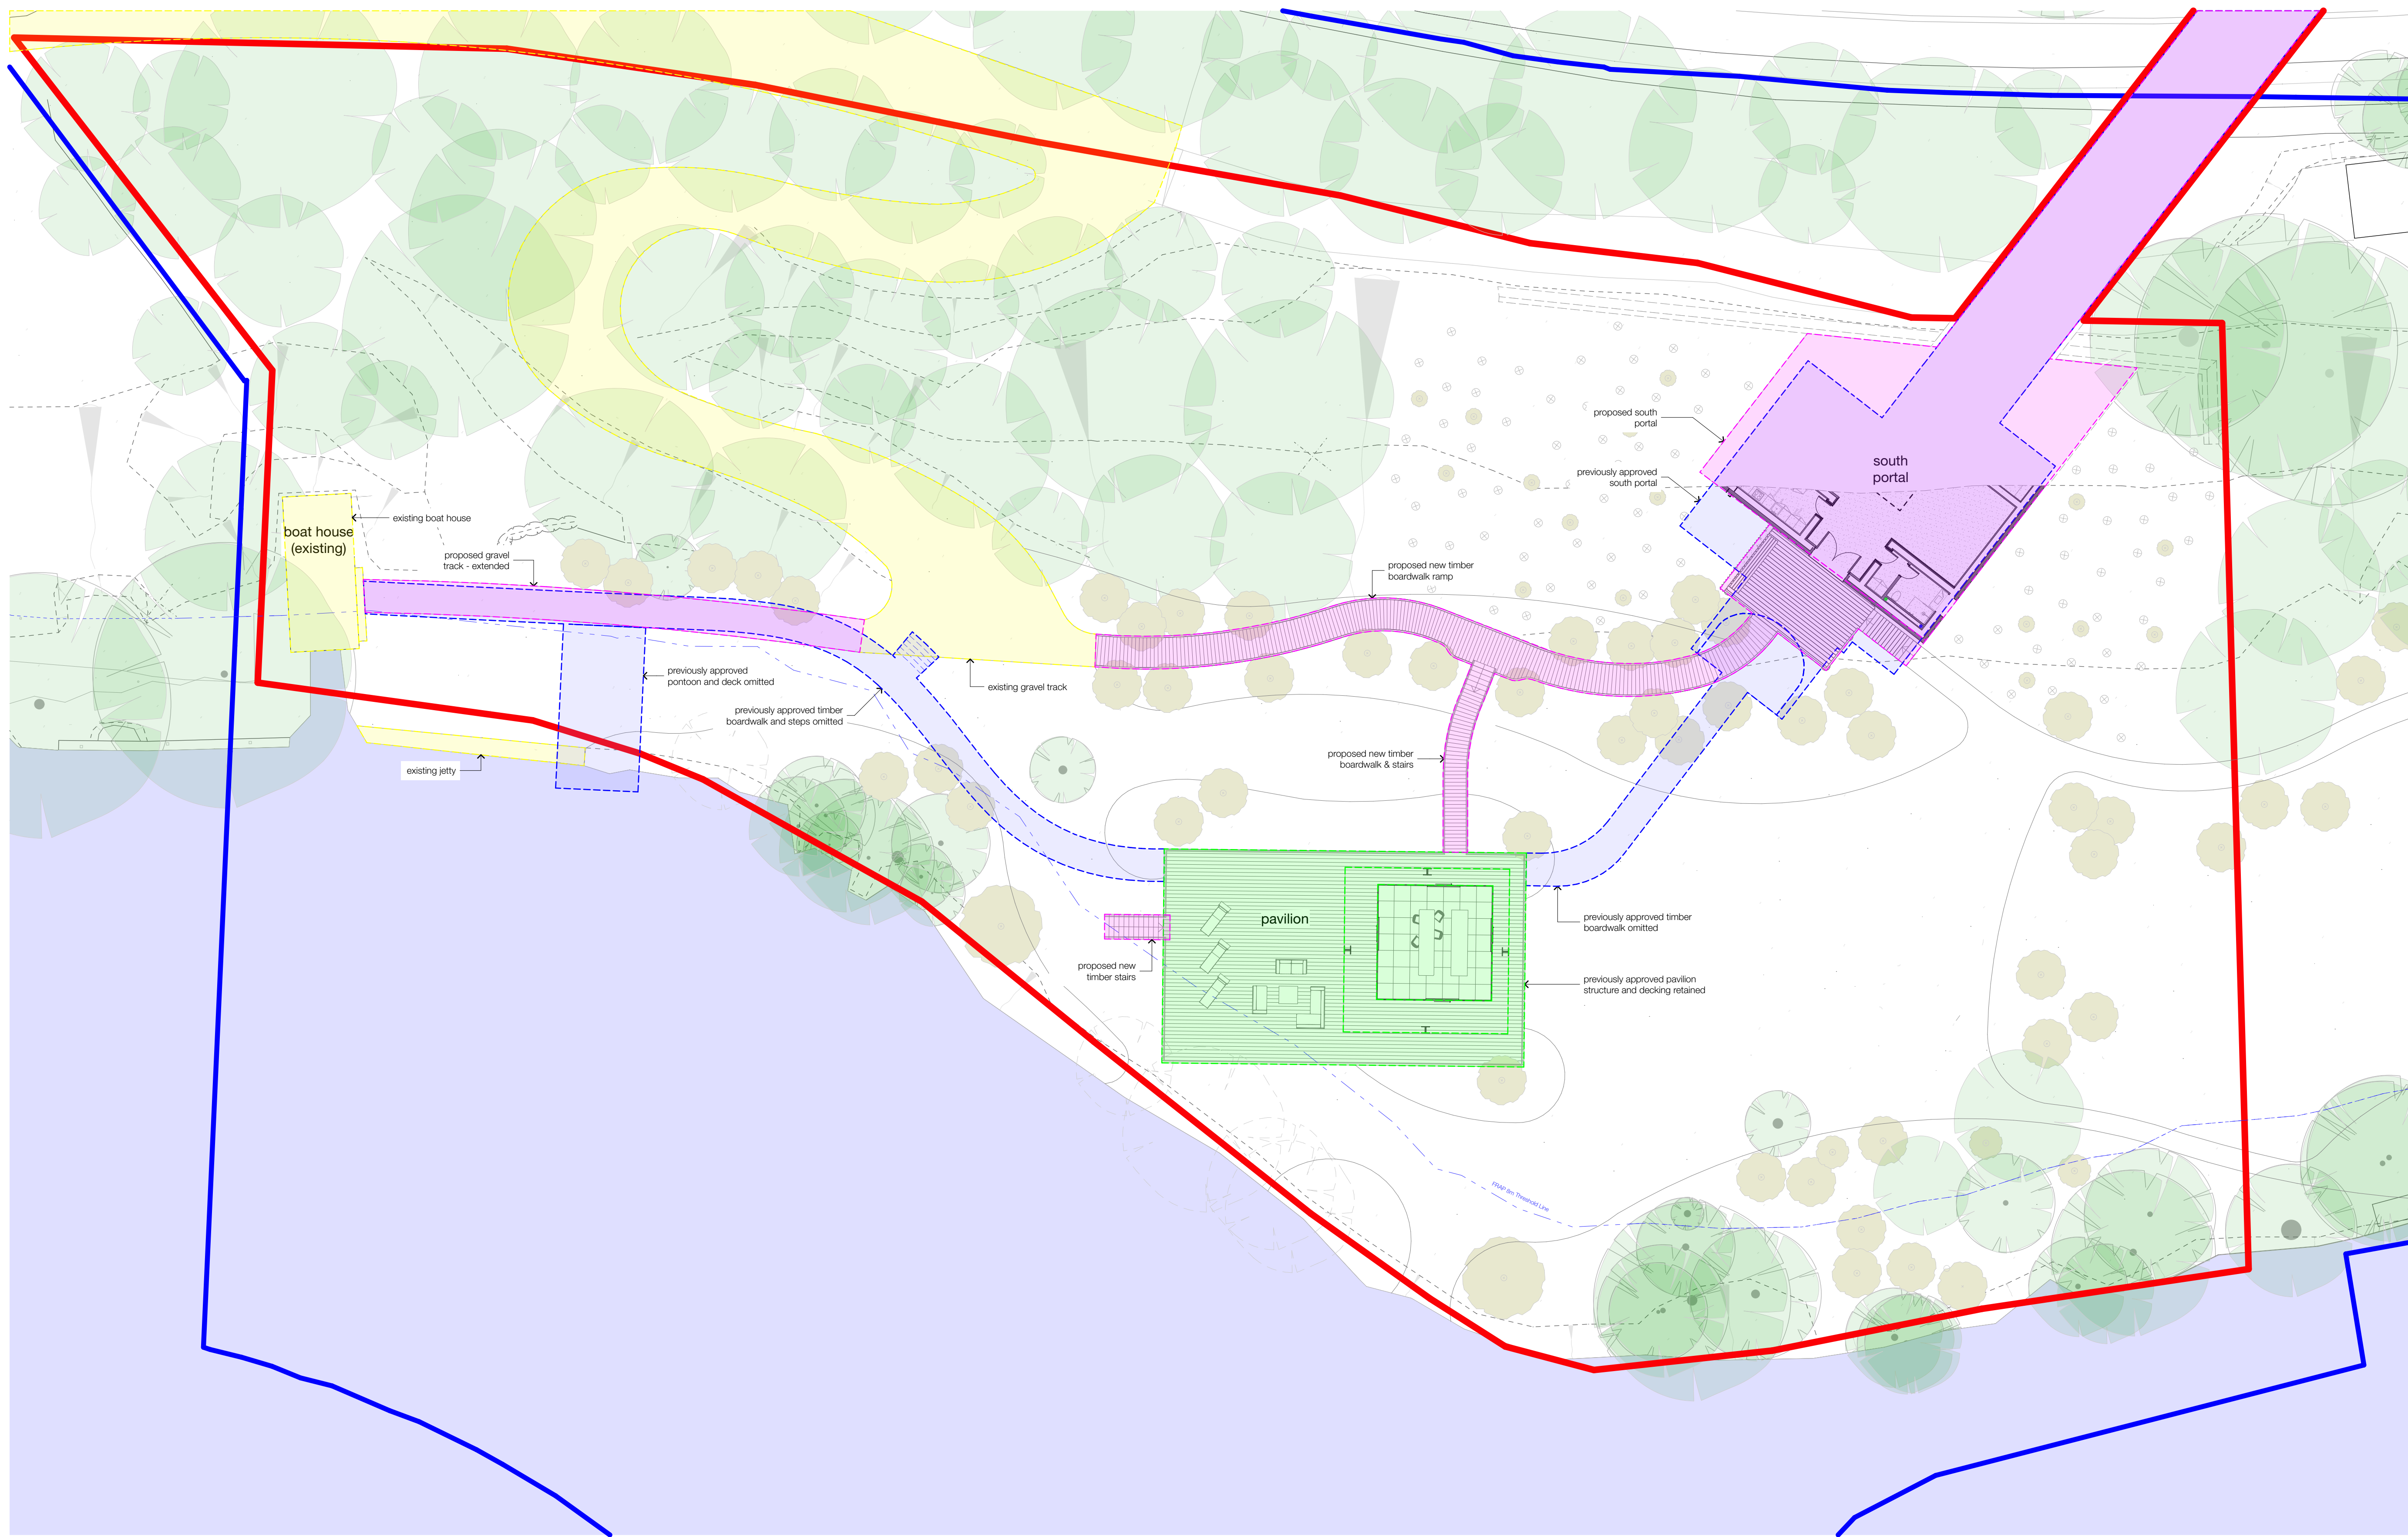

LEGEND

- Ownership Site Boundary
- 2024 Approved Planning Application 240832 Boundary

- Existing Trees
- Proposed Replacement Trees
- Proposed whip trees, mature ht. approx. 10-24m

EXISTING vs PROPOSED

- Existing Elements
- Previously Approved & Retained
- Previously Approved & Omitted
- Proposed New Elements

SCALE 1:200

0 4 8 12 16 20m

© LA London Architects LLP. Do not reproduce the drawing without written permission. Do not scale from this drawing. Use figured dimensions only. **IF IN DOUBT ASK.**

Verify all dimensions on site before commencing any work or shop drawings. Inform the architects before any work starts if this drawing exceeds the quantities in any way.

This drawing to be read in conjunction with all relevant drawings / specification / schedules etc. which relate to this project.

Any aspects of these drawings/specifications that include elements that relate to, or could be interpreted as relating to, basement waterproofing or basement structure are provided for **information only** and are either (1) taken directly from the relevant client-appointed specialist's design information requirements and/or (2) state the minimum performance standards required for the contractor to comply with and take responsibility for as a Contractor's Design Portion element under the building contract.

Any aspects of these drawings/specifications that include elements that relate to, or could be interpreted as relating to, fire safety under statutory regulations are provided for **information only** and are either (1) taken directly from relevant client-appointed specialist's design information requirements and/or (2) state the minimum regulatory performance standards required for the contractor to comply with and take responsibility for as a Contractor's Design Portion element under the building contract.

P04	03/09/2026	For Planning
P03	10/07/2026	For Planning
P02	13/05/2026	For Planning
P01	06/11/2025	For Planning
REV	DATE	DESCRIPTION

SH	AJP
SH	AJP
SH	AJP
SH	MS
ISSUED	APPROVED



LA LONDON | ARCHITECTS

Lancaster House
38 Southwark Street
London SE1 1UN
+44 (0)20 7403 1000
info@la.london
www.la.london

PROJECT

Project Conway - Riverside Pavilion

New Build

Confidential

CLIENT

Confidential

SCALE

1:200

ORIGINAL PAPER SIZE

A1

LA PROJECT REF

1177

DRAWING

Approved/Proposed Comparative Plan - Site (Mark Up)

PURPOSE

For Planning

REVISION DESCRIPTION

PRELIMINARY

DRAWN BY

SH

STATUS

S2

REVISION

P04

CLIENT APPROVAL

- A - approved
- B - approved with comments
- C - do not use

PROJECT	ORIGINATOR	ZONE	LEVEL	TYPE	ROLE	NUMBER
PCY	LAL	RP	00	DR	A	P0004