


PLOT SCHEDULE


PLOT NO.	HOUSE TYPE	HANDING	TENURE
159	HT 7	AS	Social Rent
160	HT 8	AS	Social Rent




FRONT ELEVATION

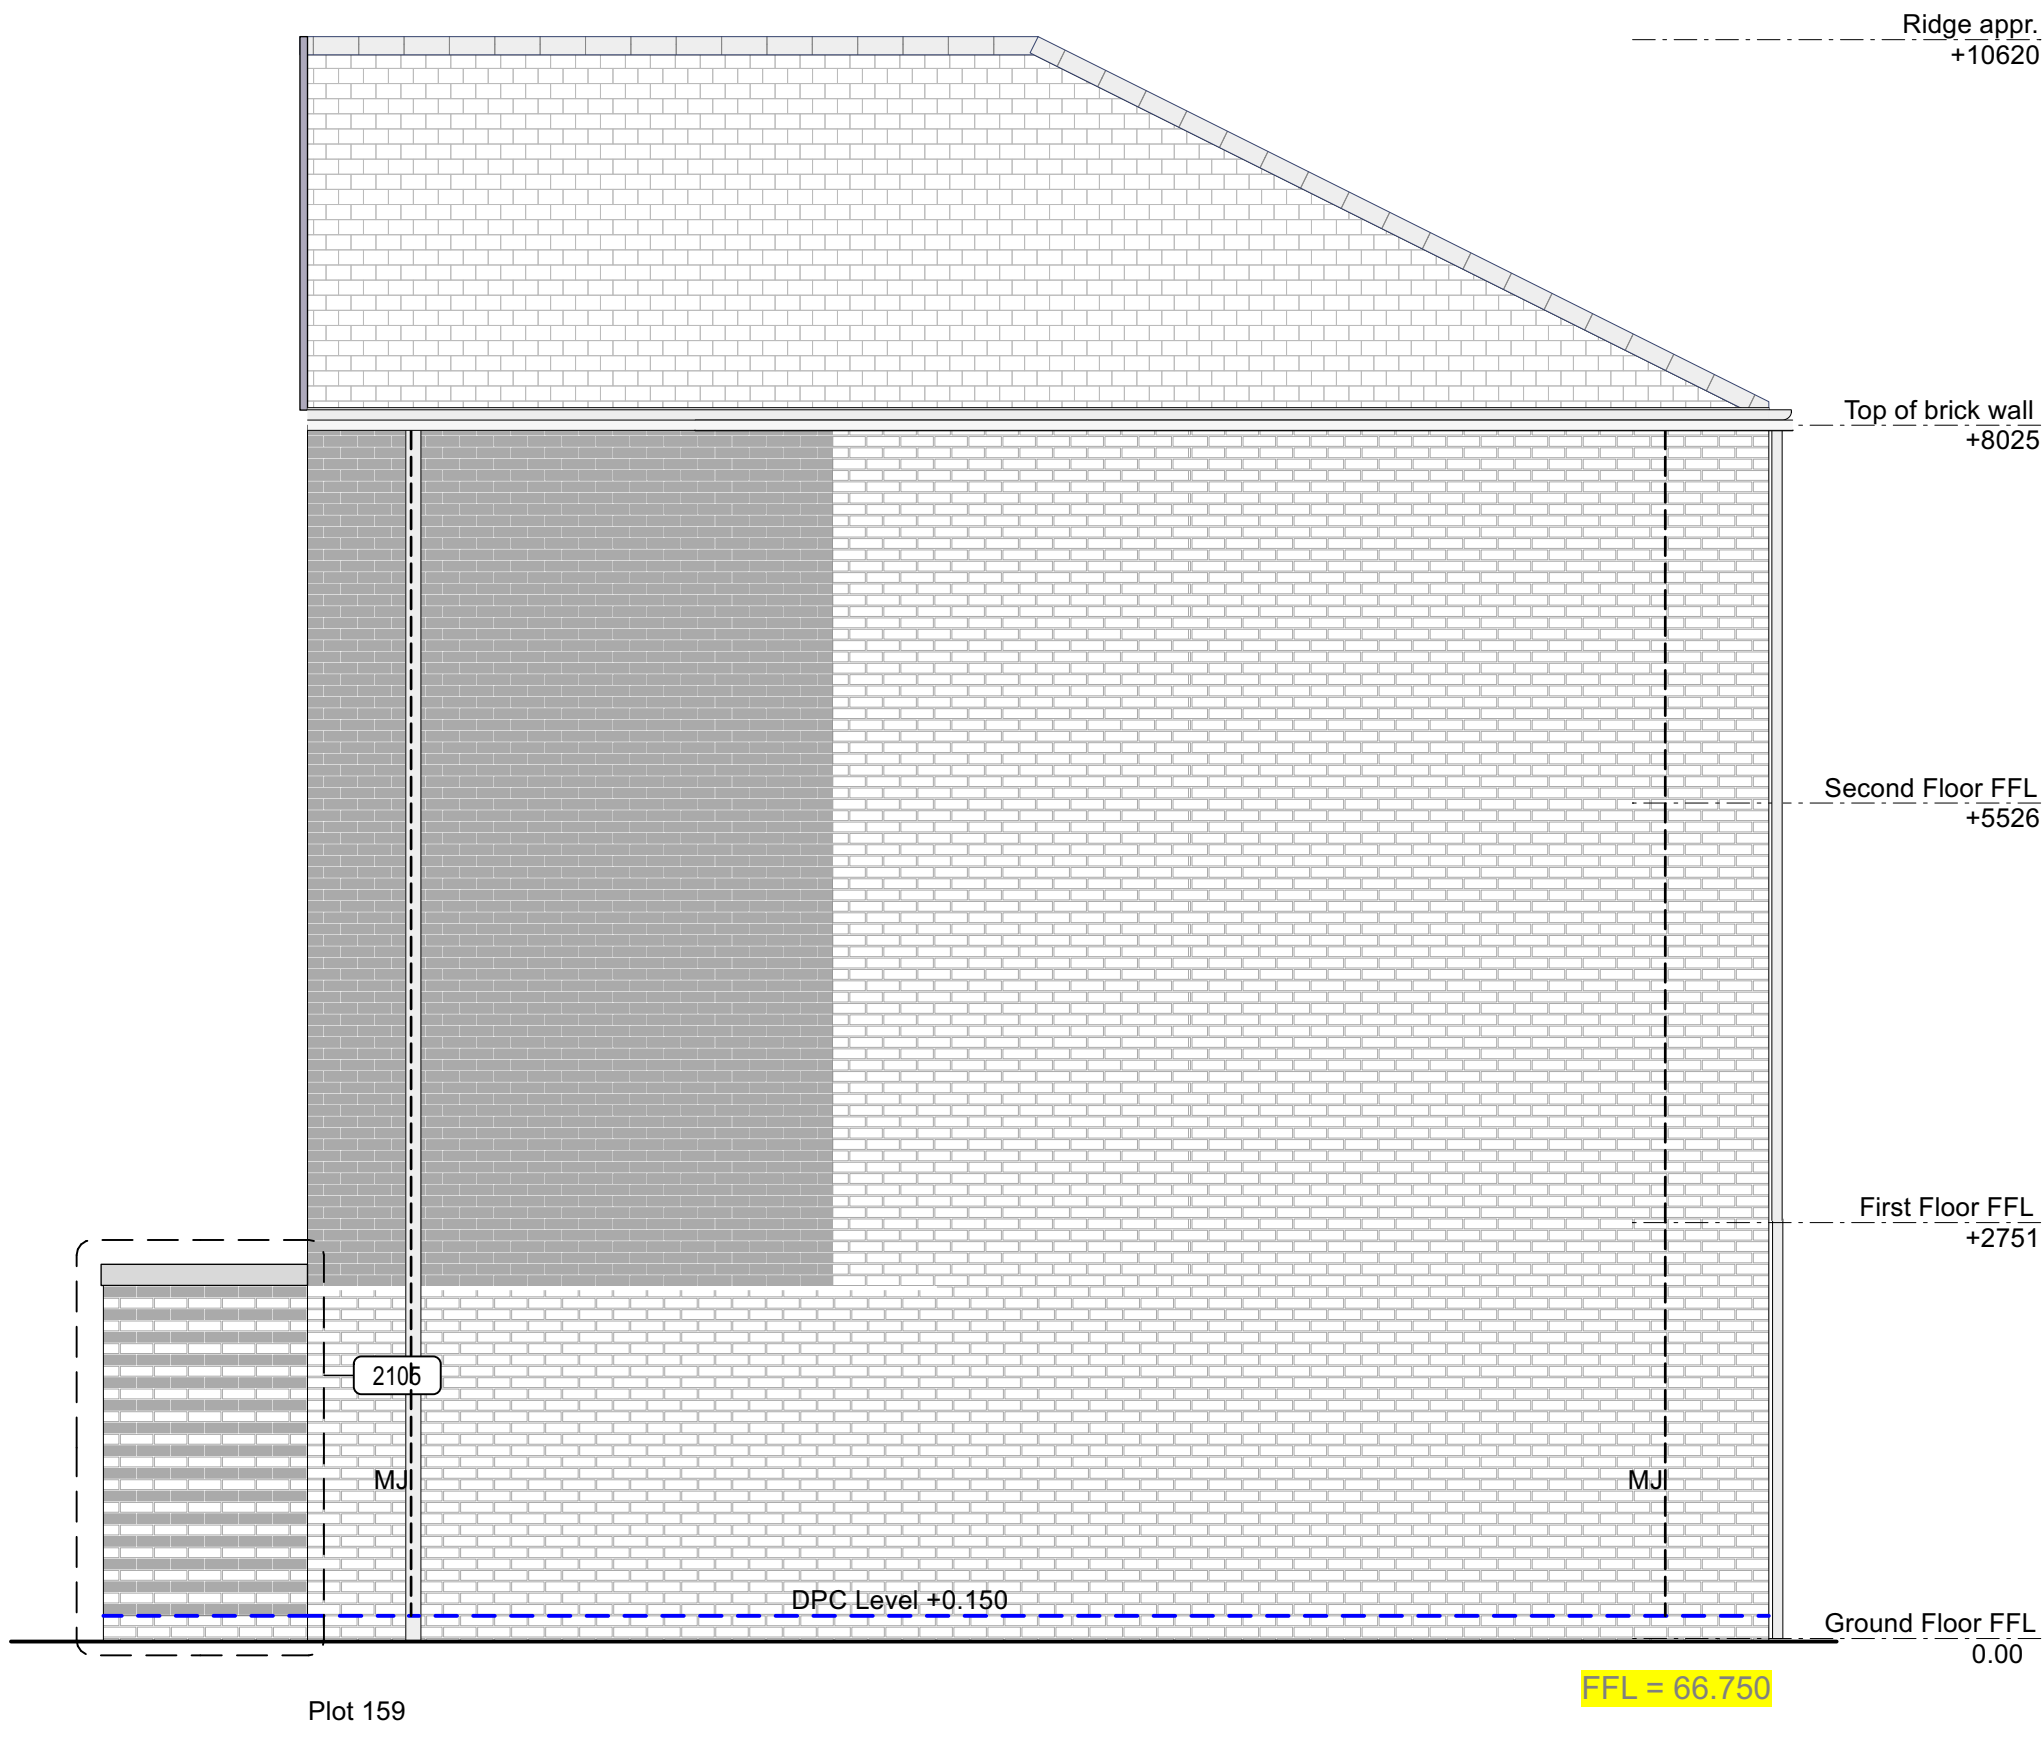


Side Elevation 1 (HT 7)

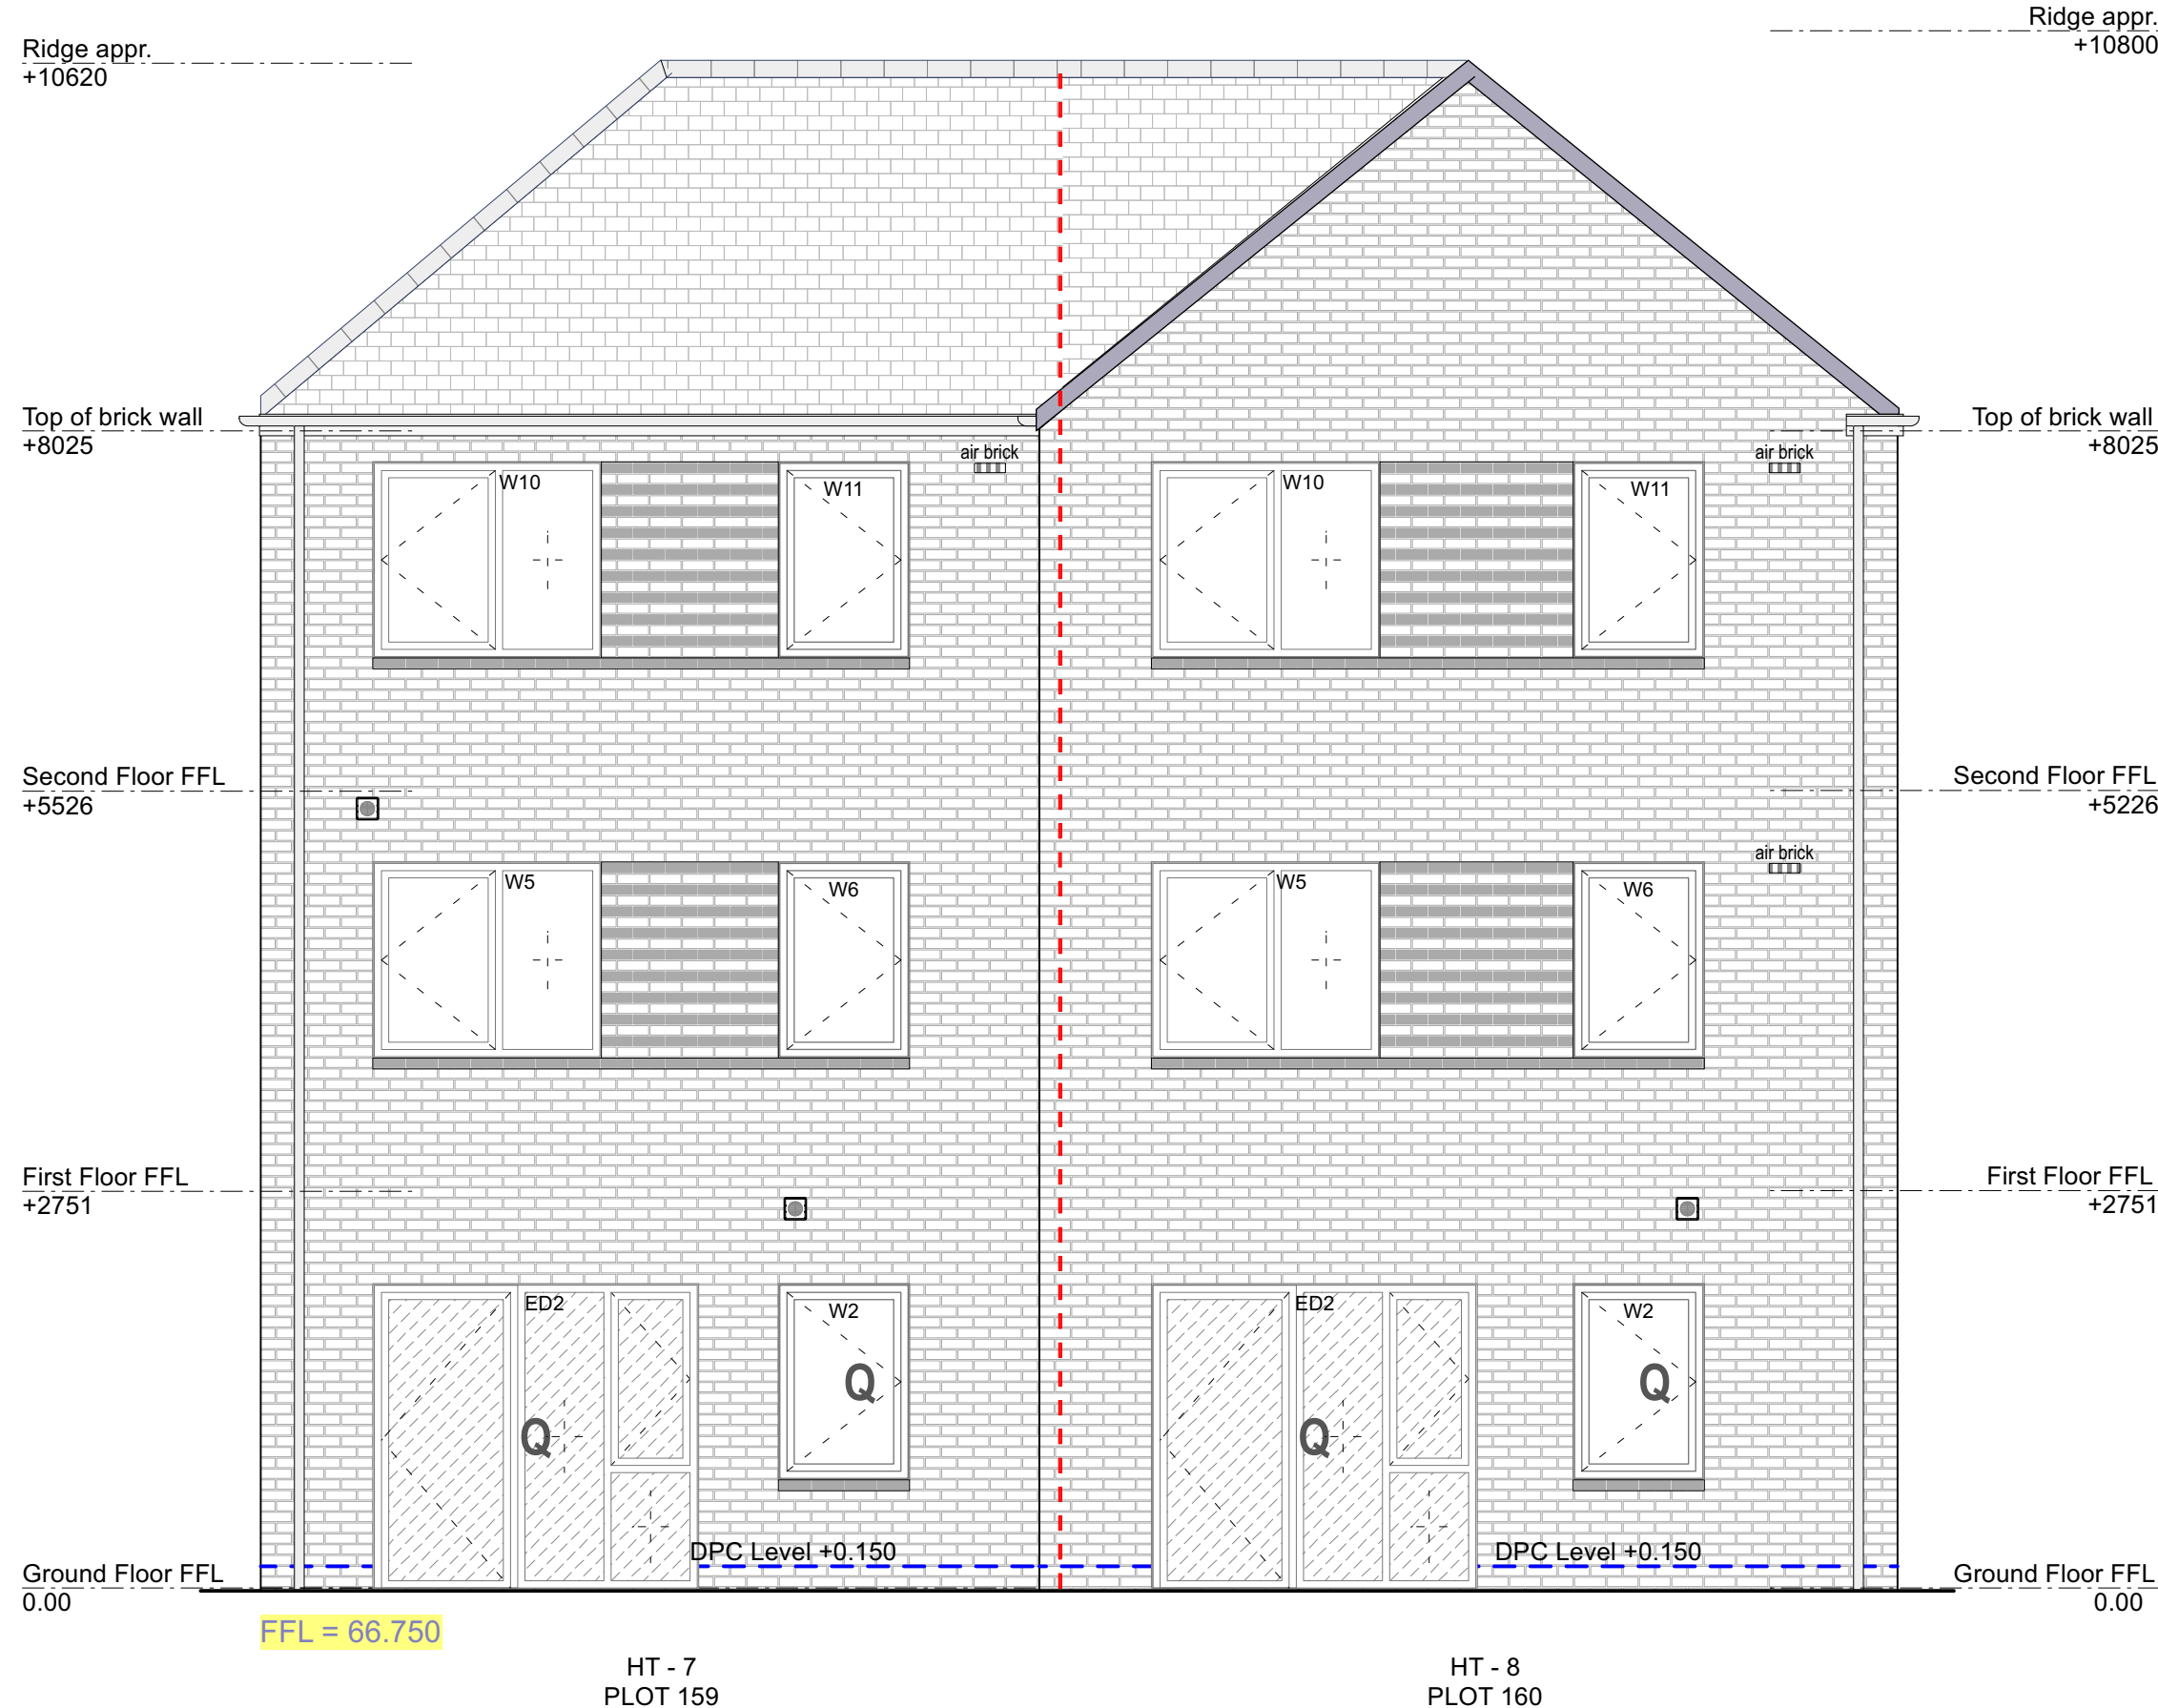

BACK ELEVATION

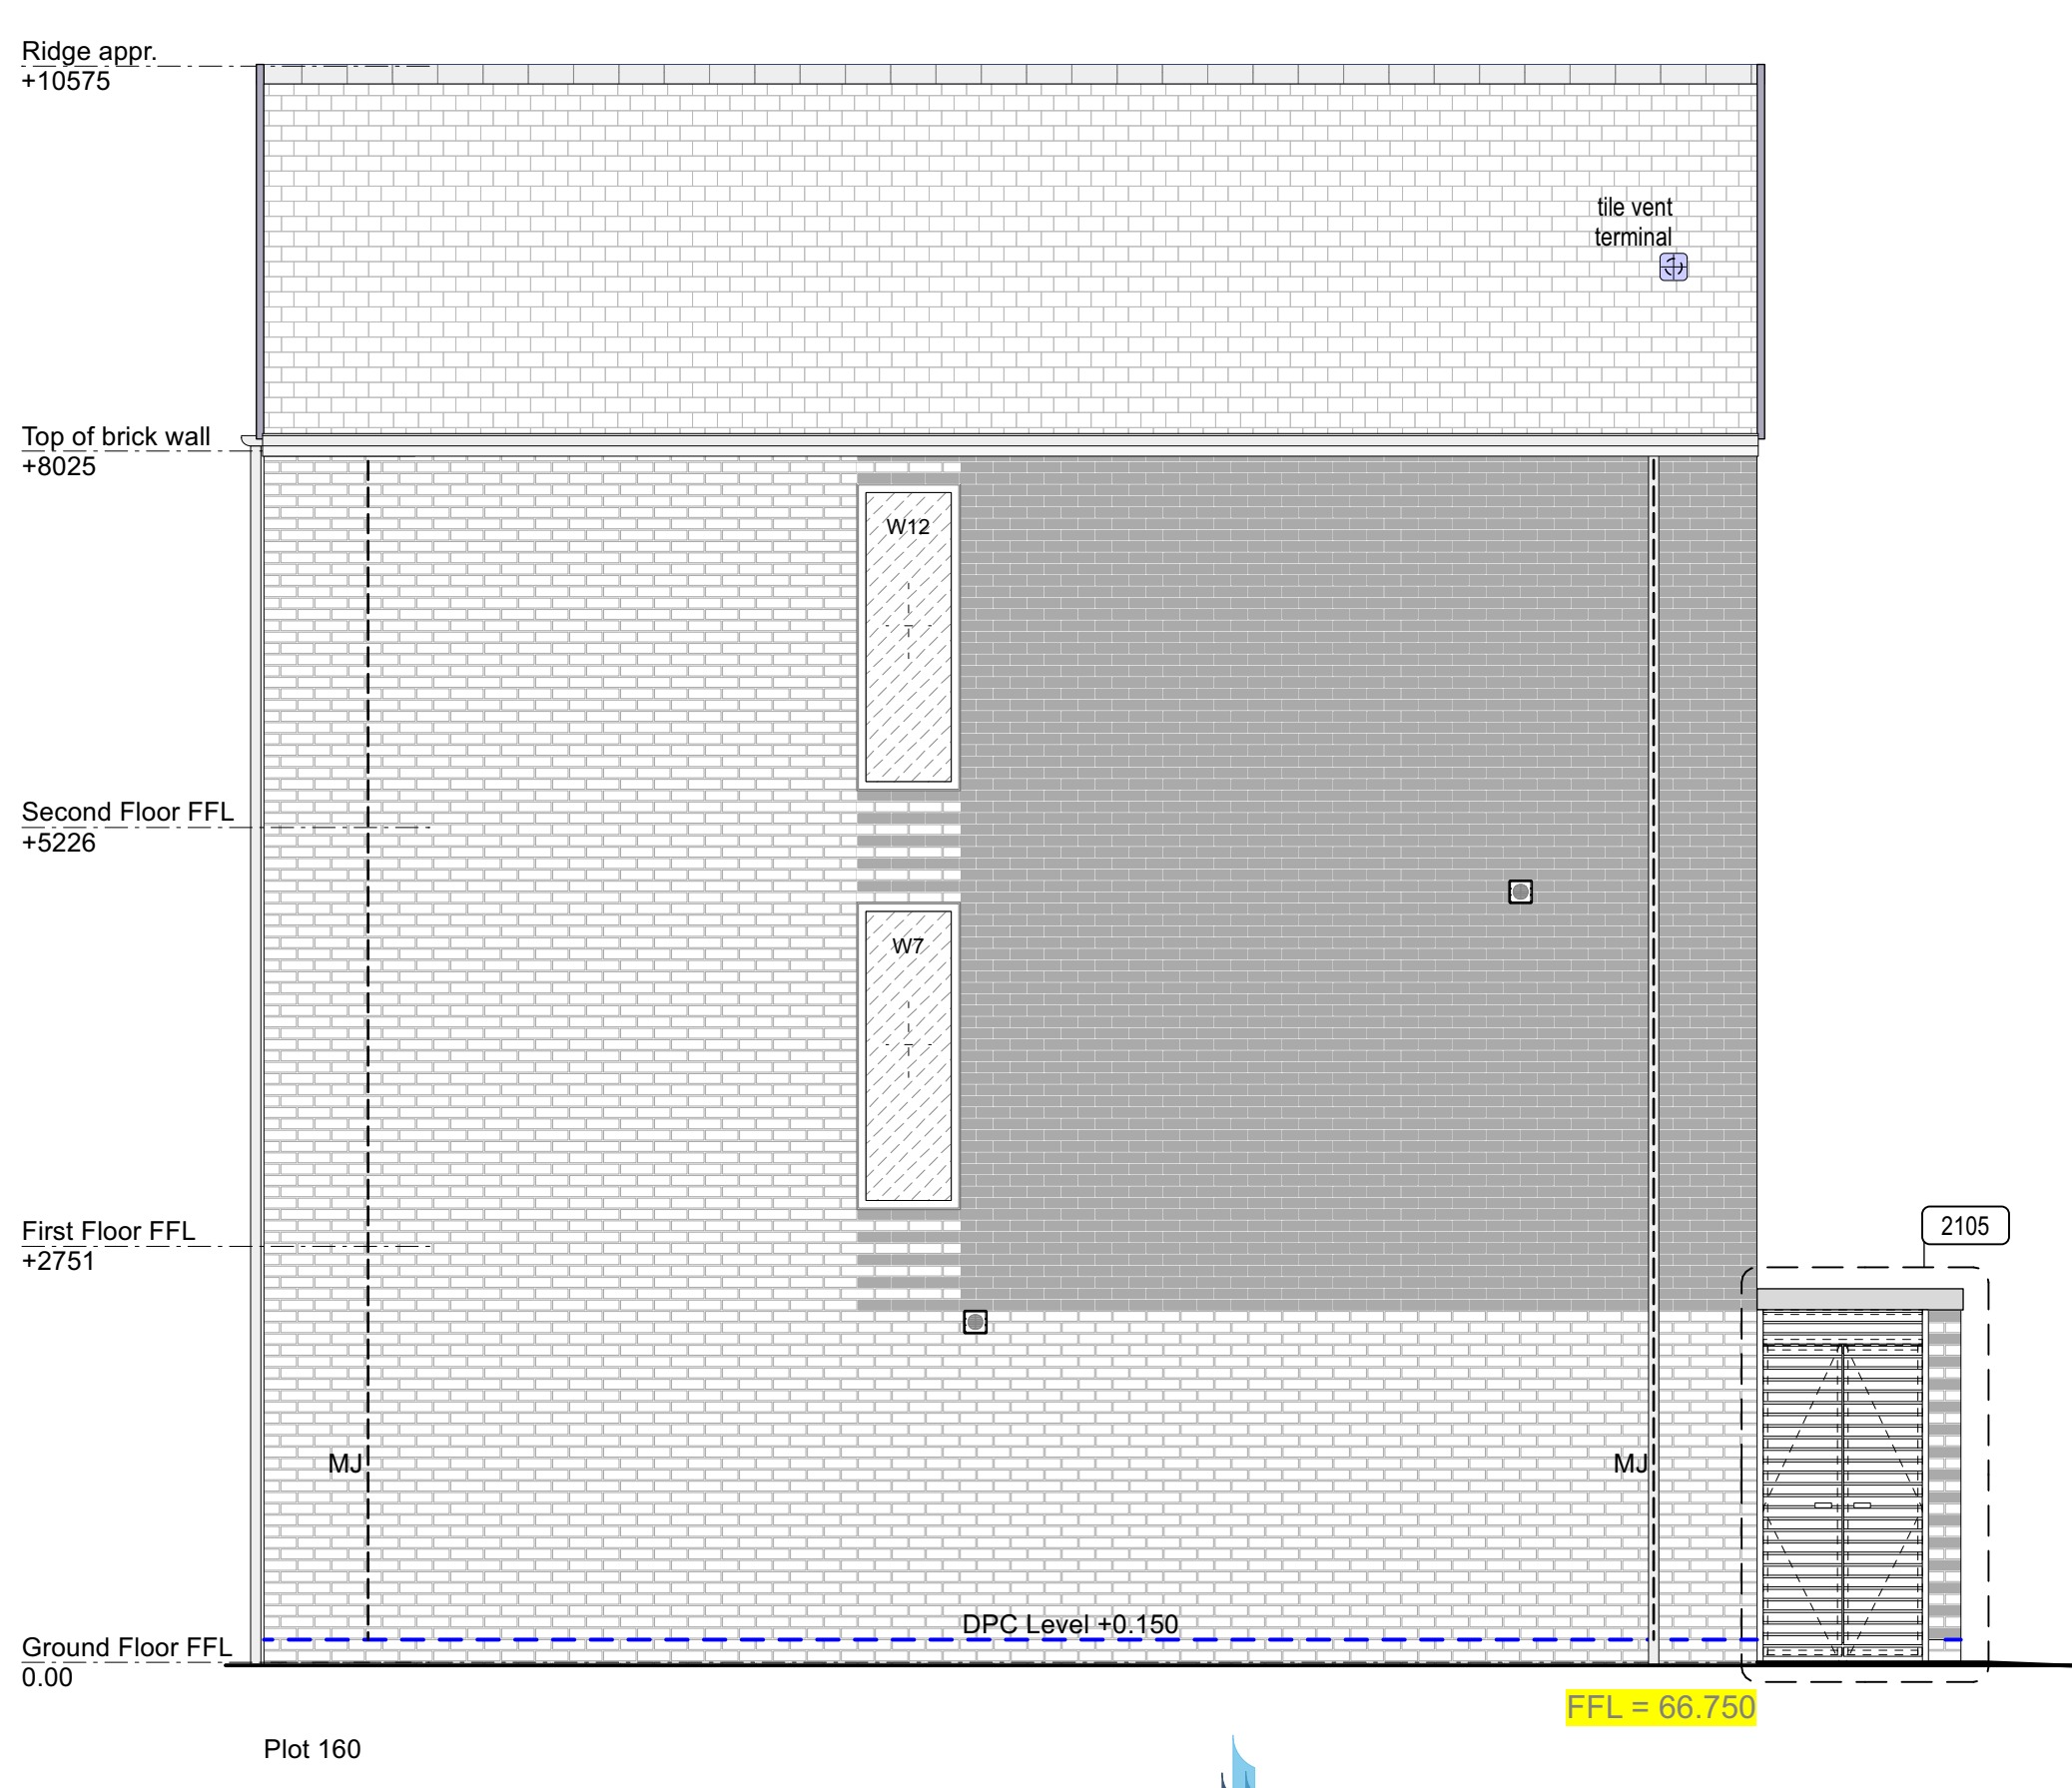


Side Elevation 2 (HT 8)

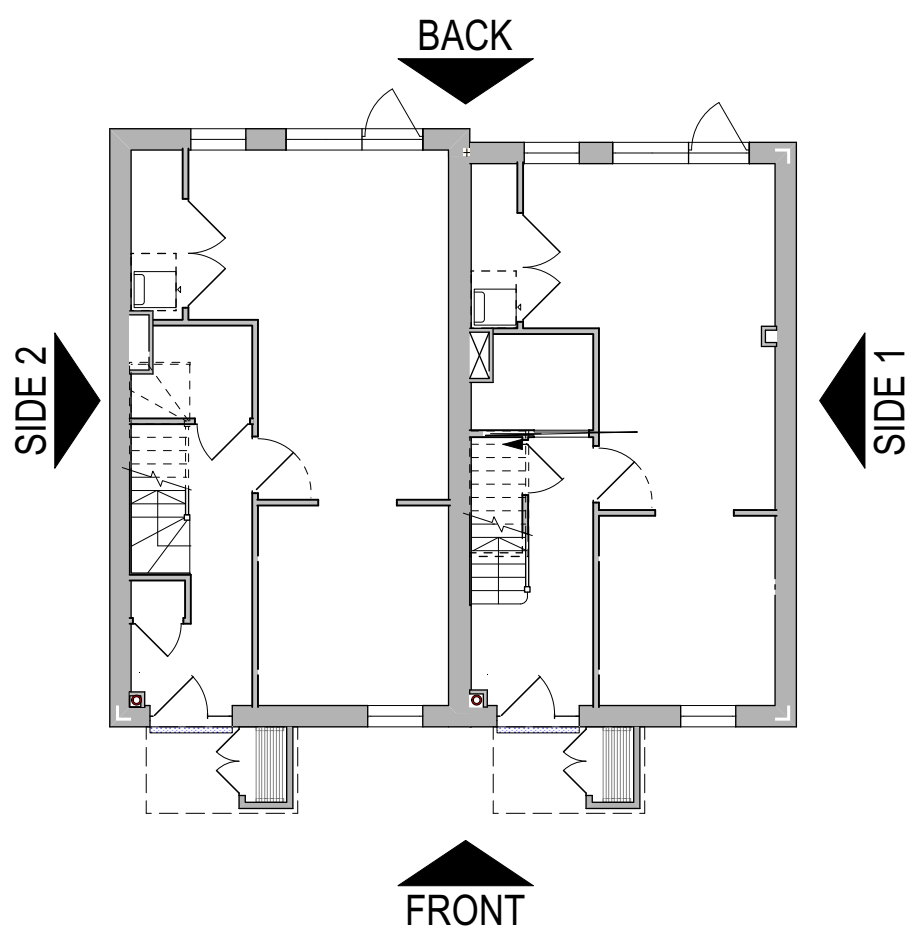

ROOF/RIDGE + EAVES HEIGHT REDUCED BY 225MM

GF REAR WINDOW/DOOR REDUCED TO 1922.5mm & TOP + RIGHT WINDOWS SHIFT 327.5mm TO THE LEFT

PROPOSED APPLICATION

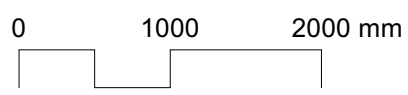

Chartered Architects
Chartered Building Surveyors
Interior Designers
CDM Services

Client: Wates / Wokingham Borough Council
Scale: 1:50
Paper Size: ISO A1
Filename: 220123-Sec-Elev_Houses-Stage 4 PROPOSED.vwx
Copyright: Do not scale this drawing

Project: Gorse Ride - S73
Drawing Title: HT 7+8 - Elevations PROPOSED
Drawing Number: 250237-KKL-CP-0524

Rev: 01
Date: 13/01/2026
By: EP
Note: Continuous terrace split into two semi-detached blocks and roof lowered by 225mm. Plot 159 (HT7) windows omitted.
Purpose/Status: AS BUILT
Revision: P01