DATE [redacted]

For Scanning

SCANNING INFORMATION SHEET

OTHER DOCUMENTS PLANS

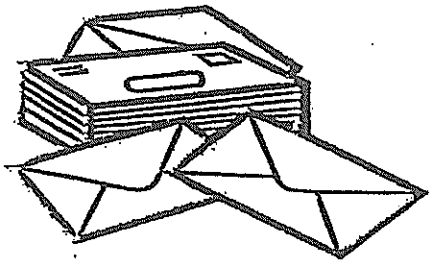

F/2000/3047

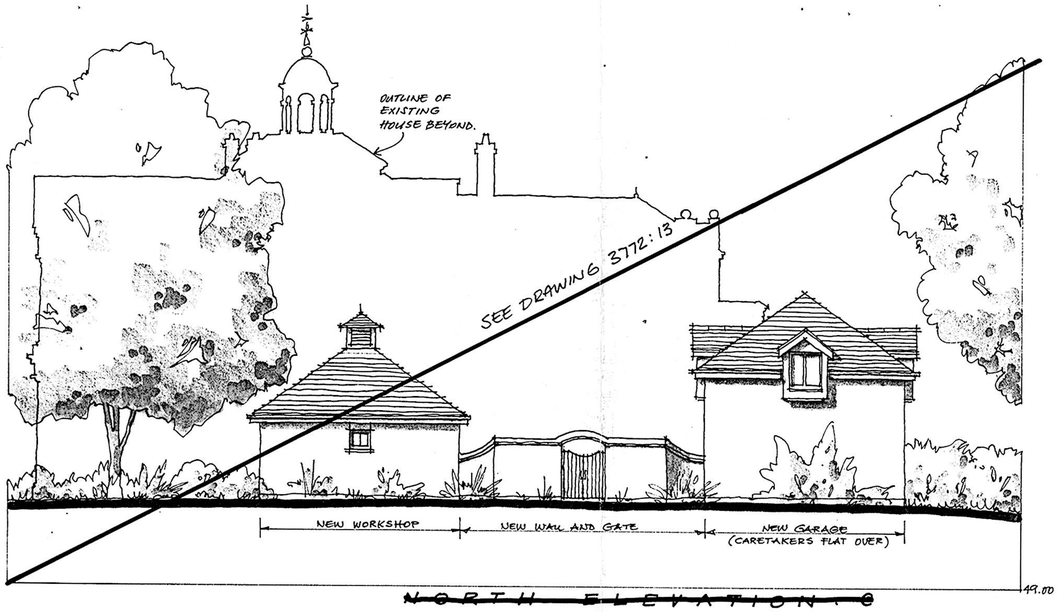

~~NORTH ELEVATION : C~~

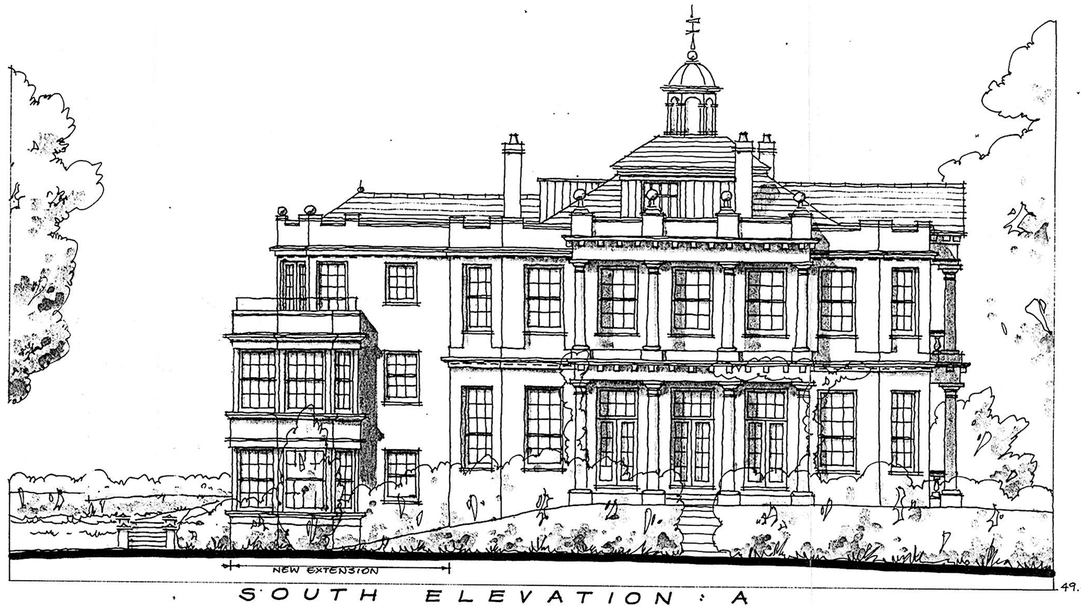

SOUTH ELEVATION : A

MATERIALS: ALL TO MATCH EXISTING

PAINTED STUCCO TO MAIN HOUSE,
PAINTED BRICKWORK TO GARAGE,
WHITE FRAMED WINDOWS, DOORS, BALCONIES
SLATED ROOFS.

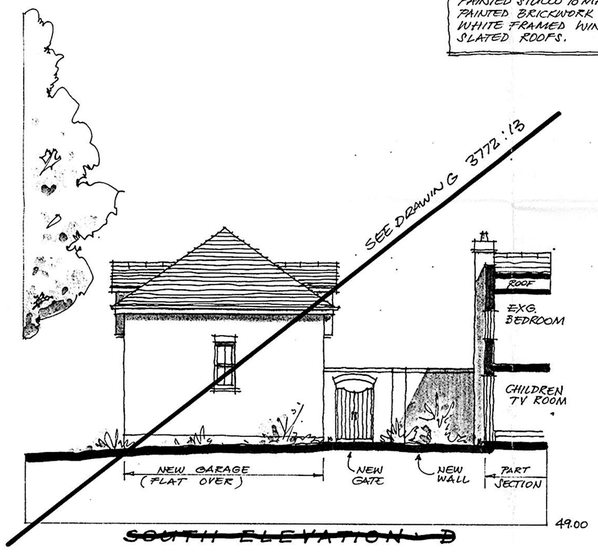

~~SOUTH ELEVATION : D~~



WEST ELEVATION : B

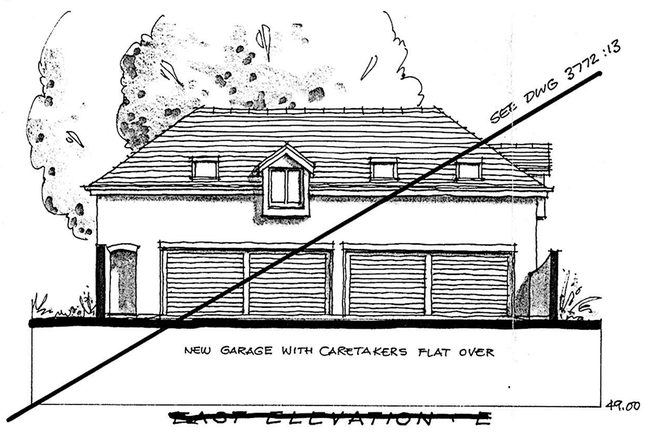

~~EAST ELEVATION : E~~

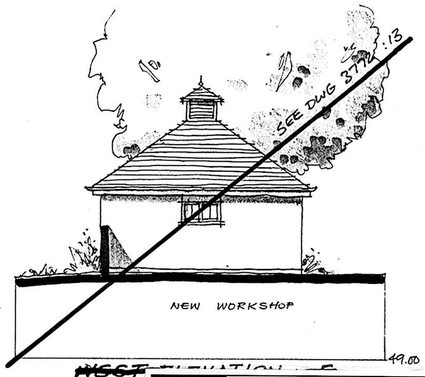

~~WEST ELEVATION : F~~

NEW ELEVATION.
LEAN-TO REMOVED.
FRENCH DOORS & WINDOWS CHANGED

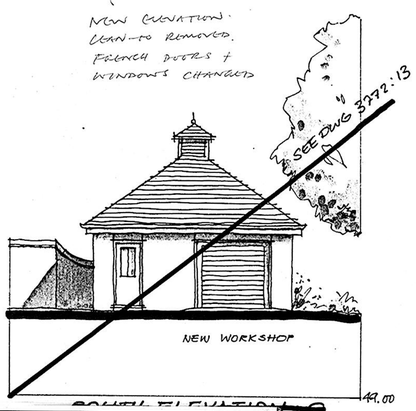

~~SOUTH ELEVATION : G~~

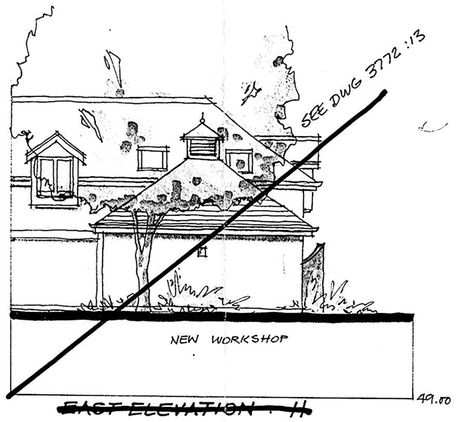

~~EAST ELEVATION : H~~

DO NOT SCALE

½mm 10 20mm 30 40 50 60 70 80 90 100 110 120 130 140 150

ORIGINAL SIZE OF DRAWING A1

PRINTS AND REVISIONS

14	PLANNING: 6, LISTED B: 5, CLIENT: 1 RE: 1, FILE: 1	9.8.00
1	QS	5.9.00
1	CLIENT	10.11.00
A	REVISION	
	SEE DRAWING 3772/13	19.12.00
	FOR GARAGE & CARETAKERS FLAT	
12	PLANNING & LB.	19.12.00
1	CLIENT	"

NOTES

ALL DIMENSIONS MUST BE CHECKED ON SITE AND NOT SCALED FROM DRAWING. ERRORS AND OMISSIONS TO BE REPORTED TO THE ARCHITECTS

KEY: 15 DEC 2000 3044

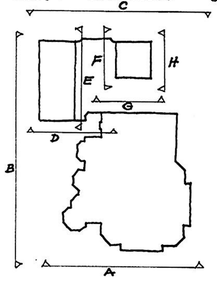

EDGINGTON SPINK·HYNE
CHARTERED ARCHITECTS

RIDING COURT, RIDING COURT ROAD, DATCHET, BERKS. SL3 9LE
TEL: WINDSOR 01753 580033 FAX: 01753 580633
WEB: www.edgingtons.co.uk EMAIL: mail@edgingtons.co.uk

SUMMERFIELD HOUSE
CRAZIES HILL, BERKSHIRE

ELEVATIONS

SCALE 1:100
DATE August 2000 DRAWN Hugo
JOB No. 3772 DWG No. 10 A