


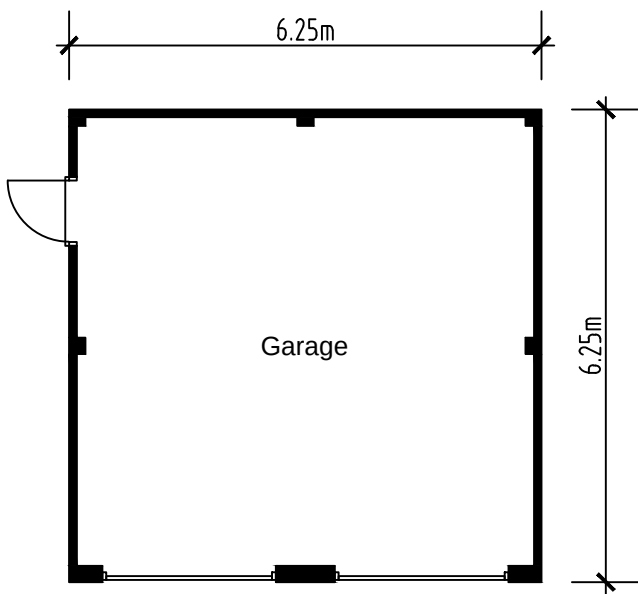
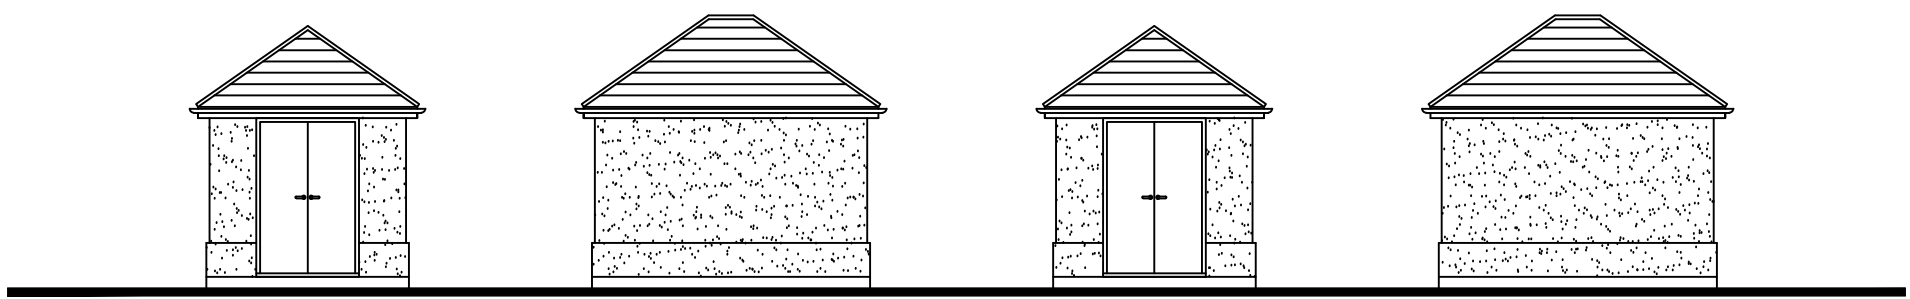


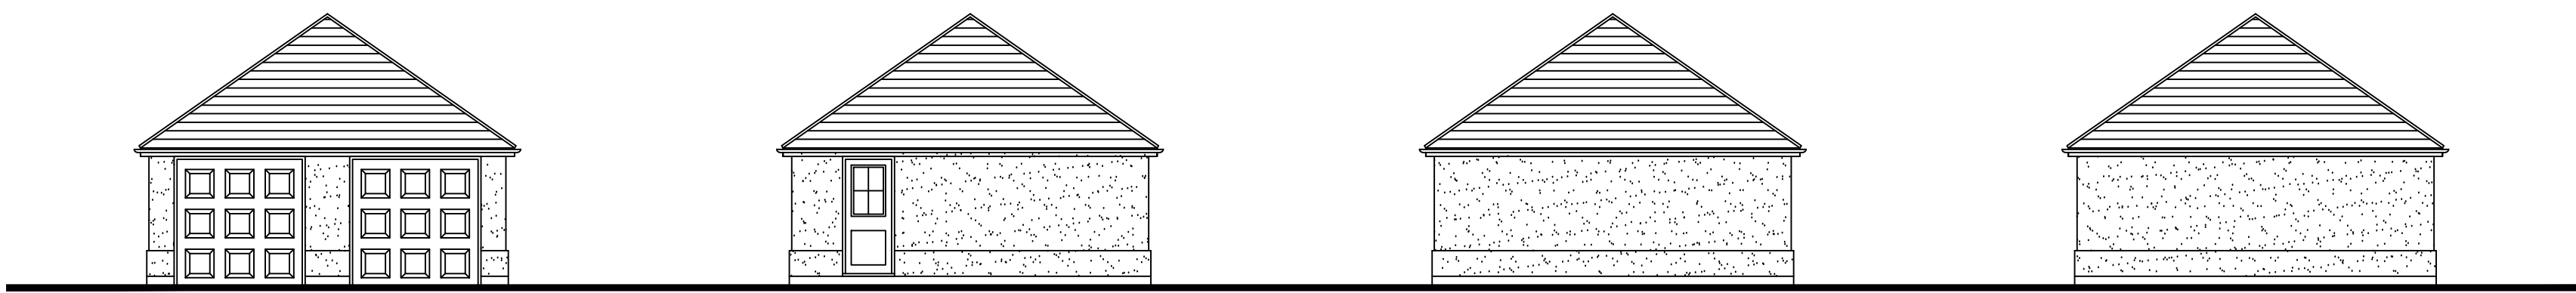


Proposed Double Garage
1:100 scale

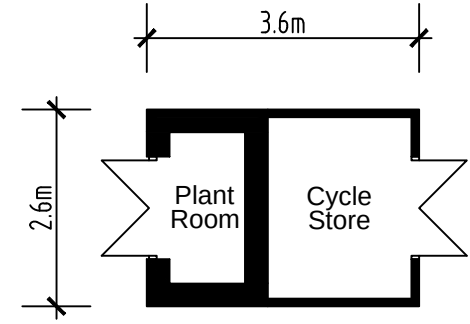

Proposed Plant Room/Bicycle Store
1:100 scale

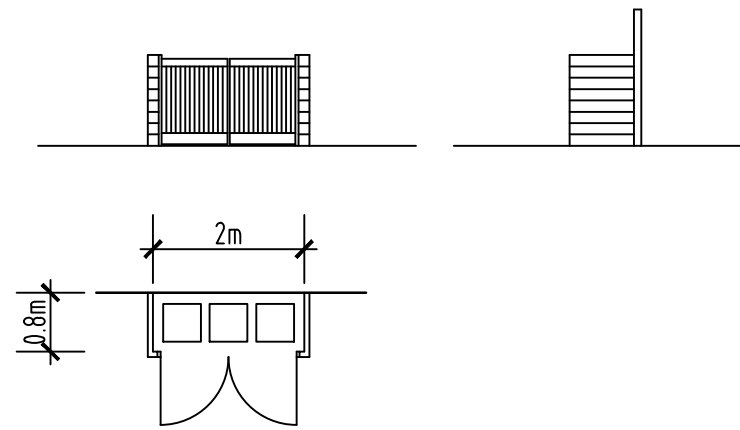

Proposed Bin Store
1:100 scale

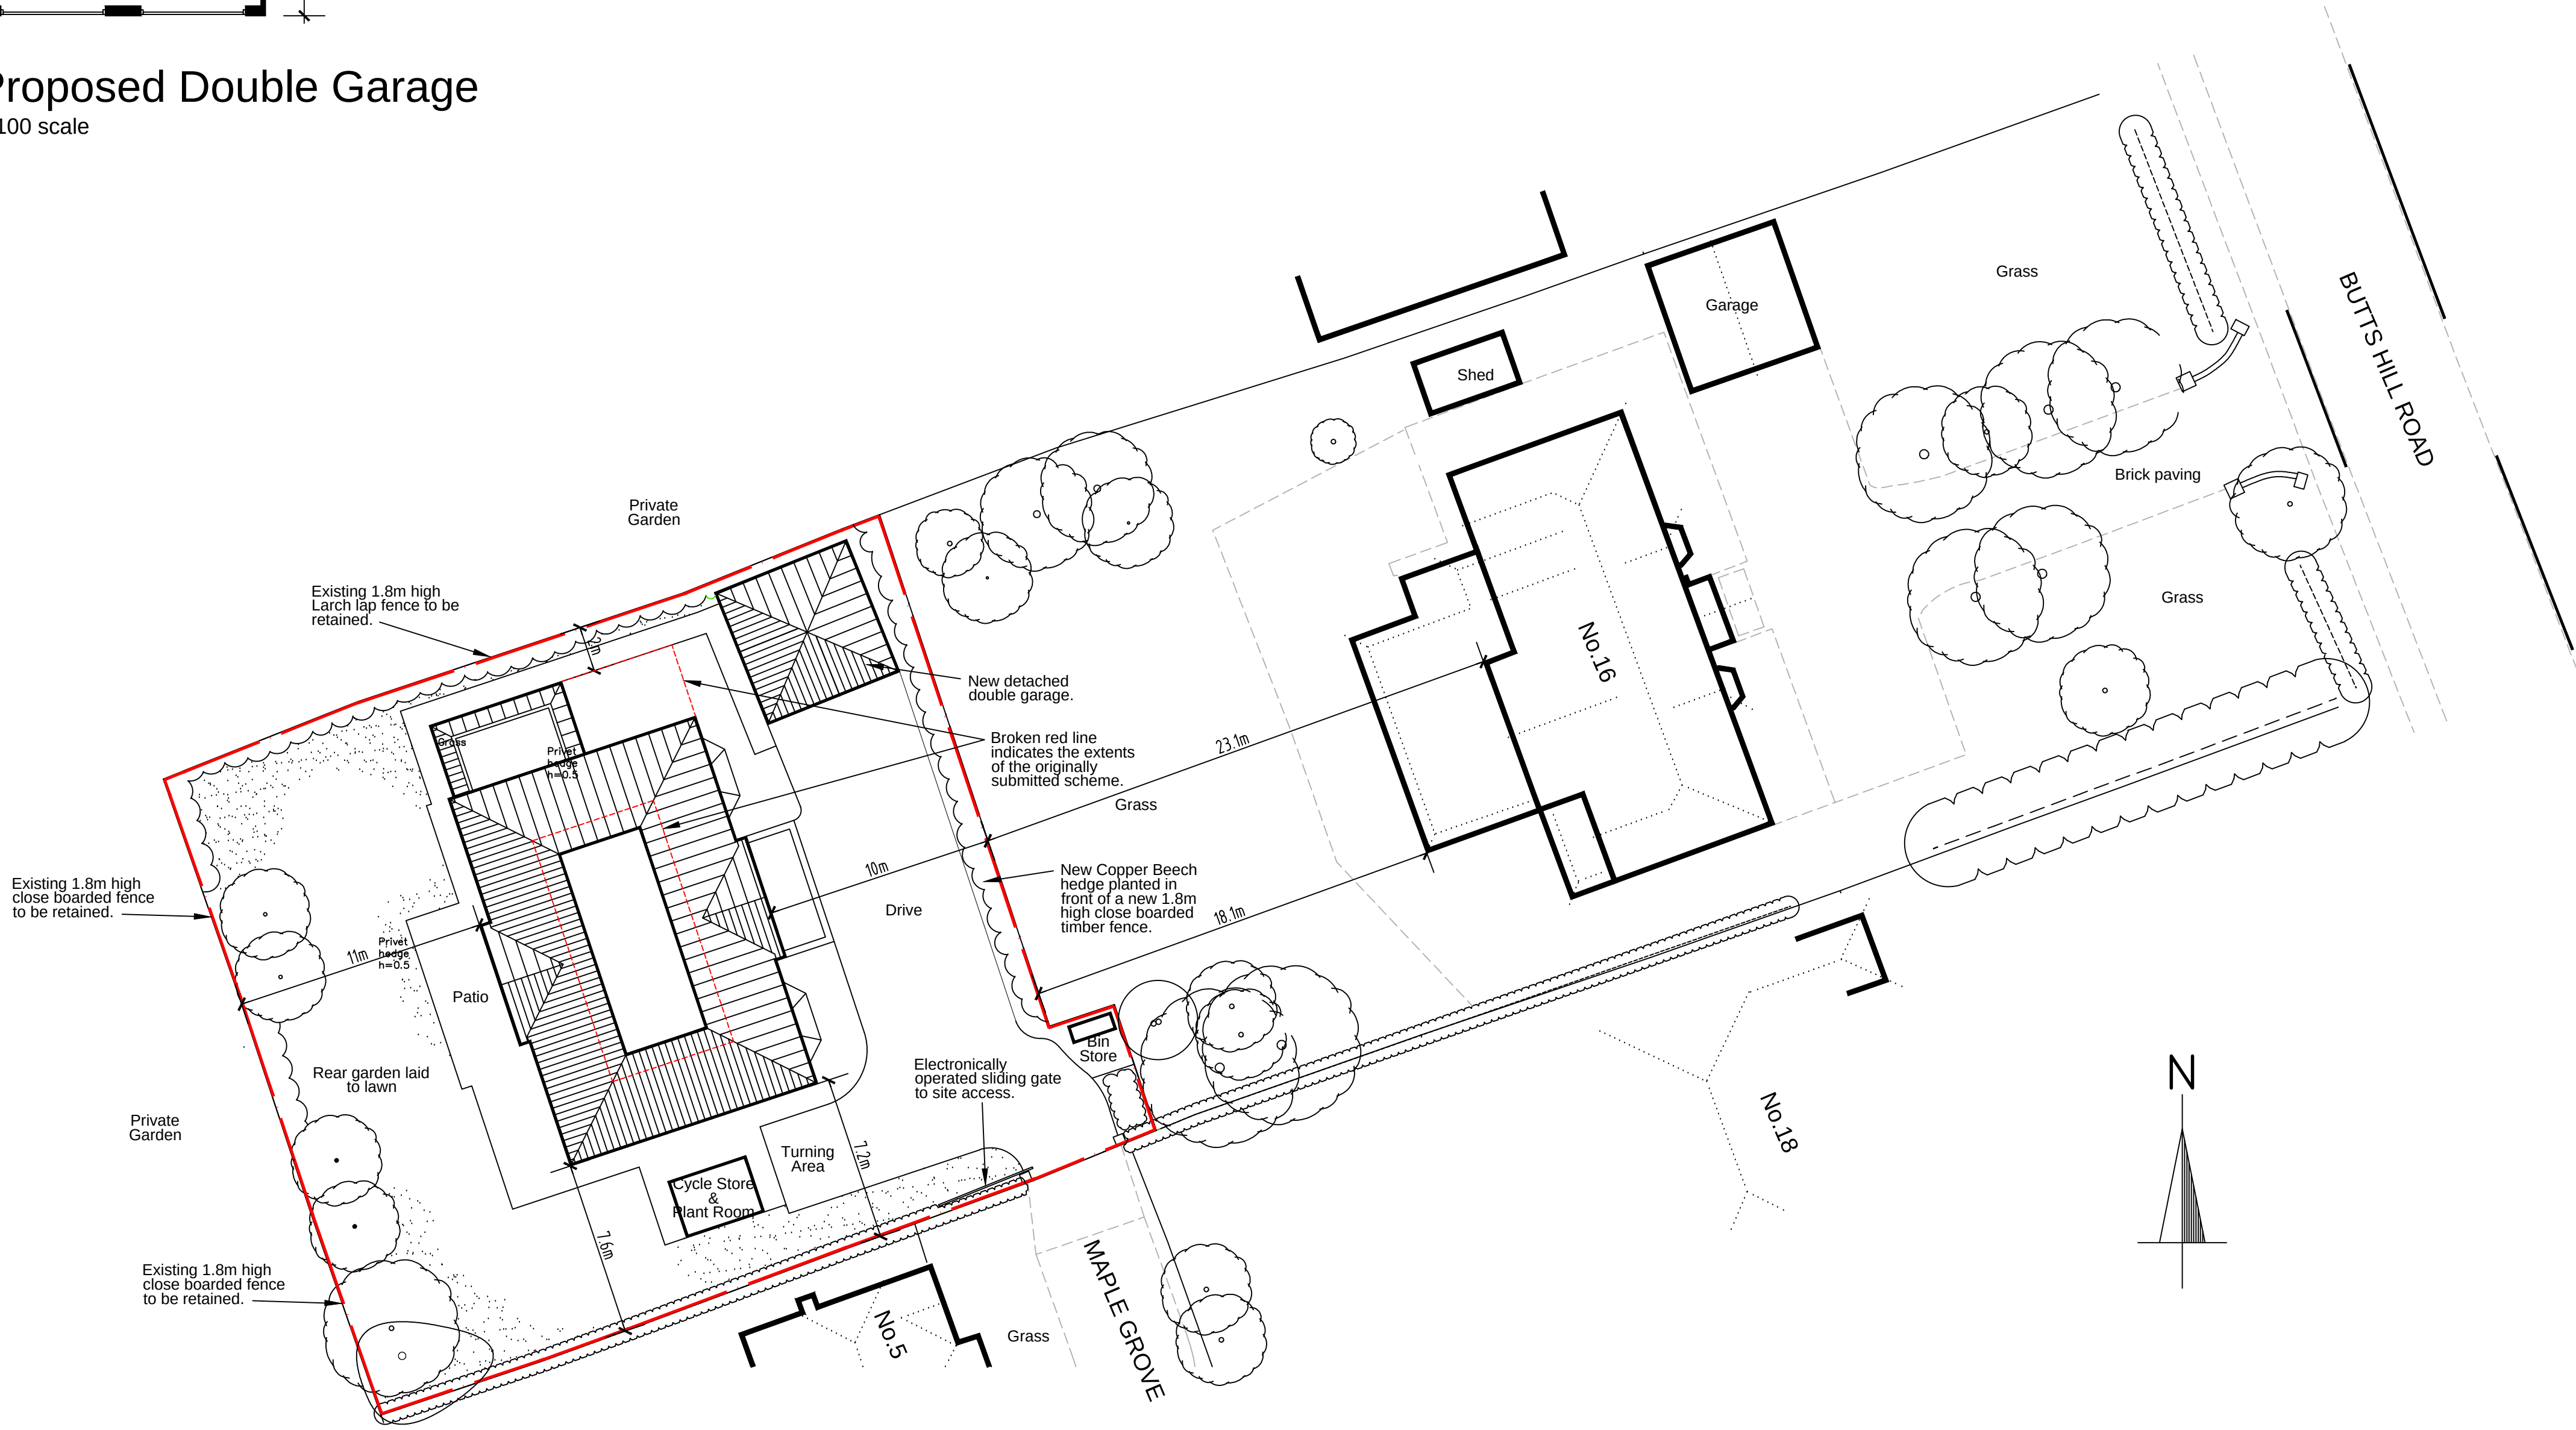

Proposed Site Plan
1:200 scale

Revision A - 21.10.22 - Proposals modified/reduced to overcome planning officers concerns. Extent of originally submitted proposals shown with a broken red line.

Proposed New Detached Dwelling at Land to Rear of
16 Butts Hill Road, Woodley

Client	Description
Mr H. Butt c/o MBP Ltd	Proposed Site Plan and Plans and Elevations of Double Garage, Plant Room/Bicycle Store and Bin Store

All dimensions to be checked on site. Any discrepancy between this drawing and other information is to be referred to the Planning Consultant. This drawing is copyright.

MARTIN BUTLER PARTNERSHIP LIMITED

28 Broad Street Wokingham Berkshire RG40 1AB Tel/Fax: 0118 989 0990	Scale 1:200 1:100	Project 22112-2	Drawing No. 01	Revision A
Date 23/11/21 Drawn MB				

