

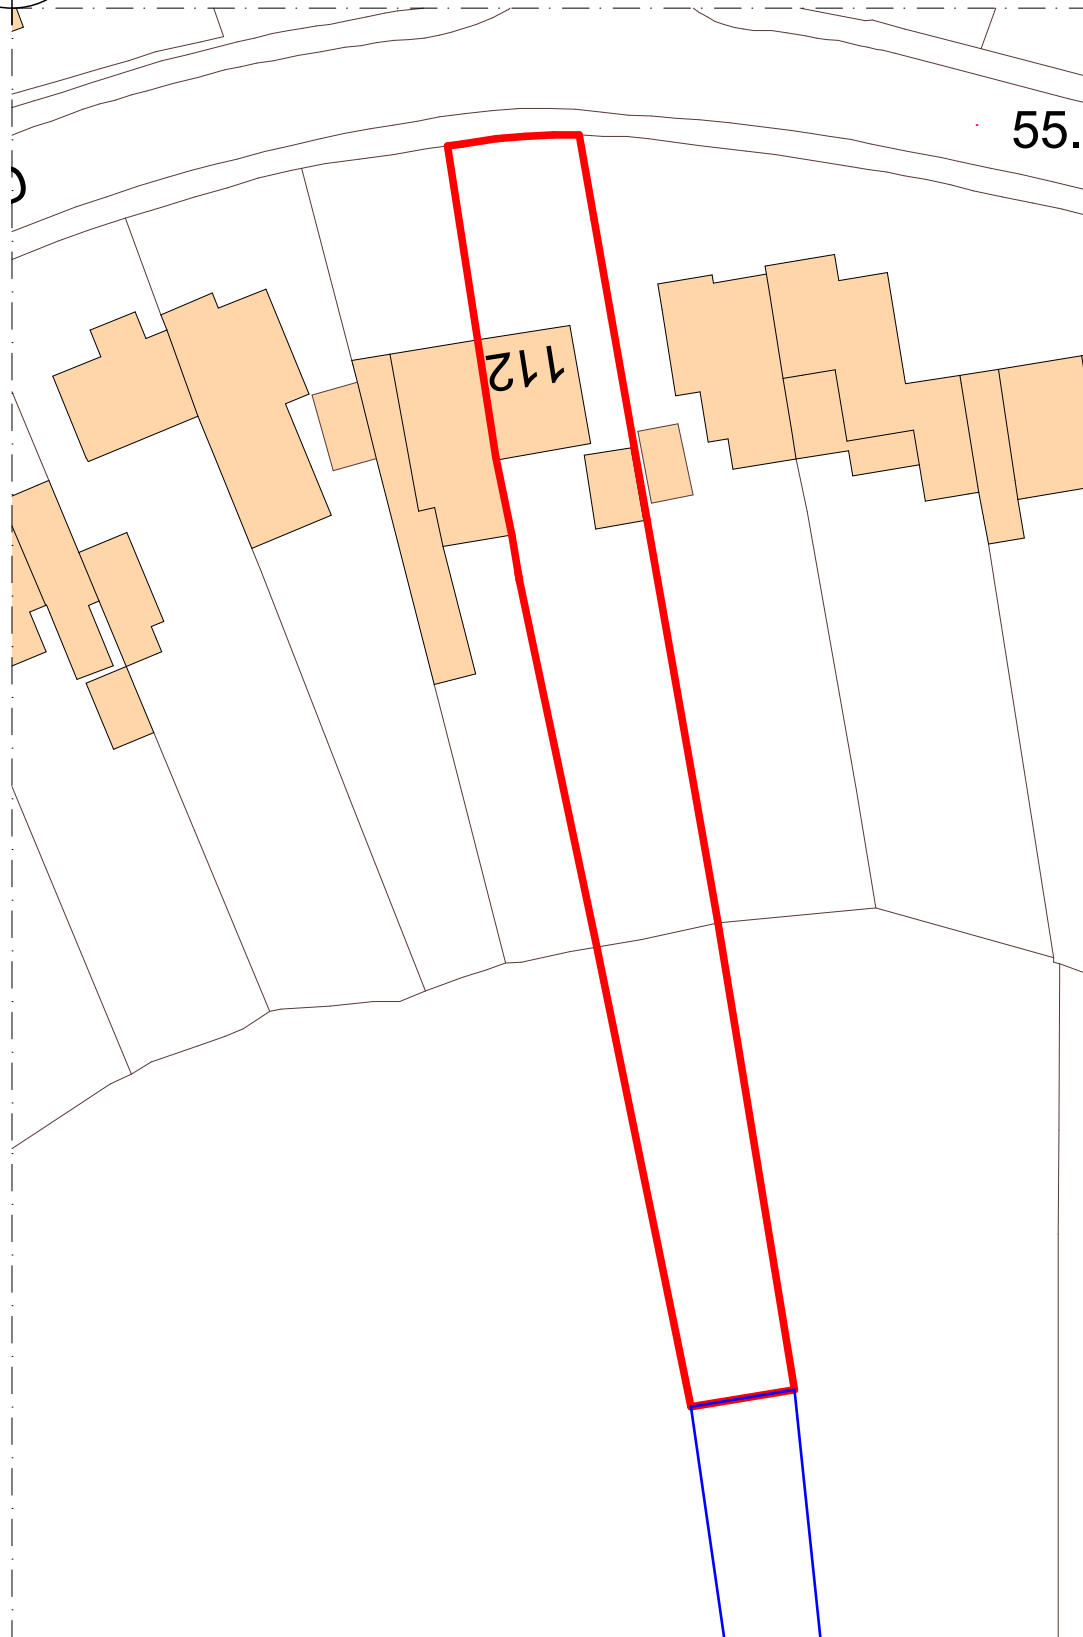


N

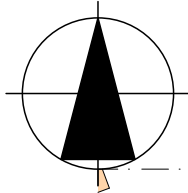

1:500

Existing Block PLAN

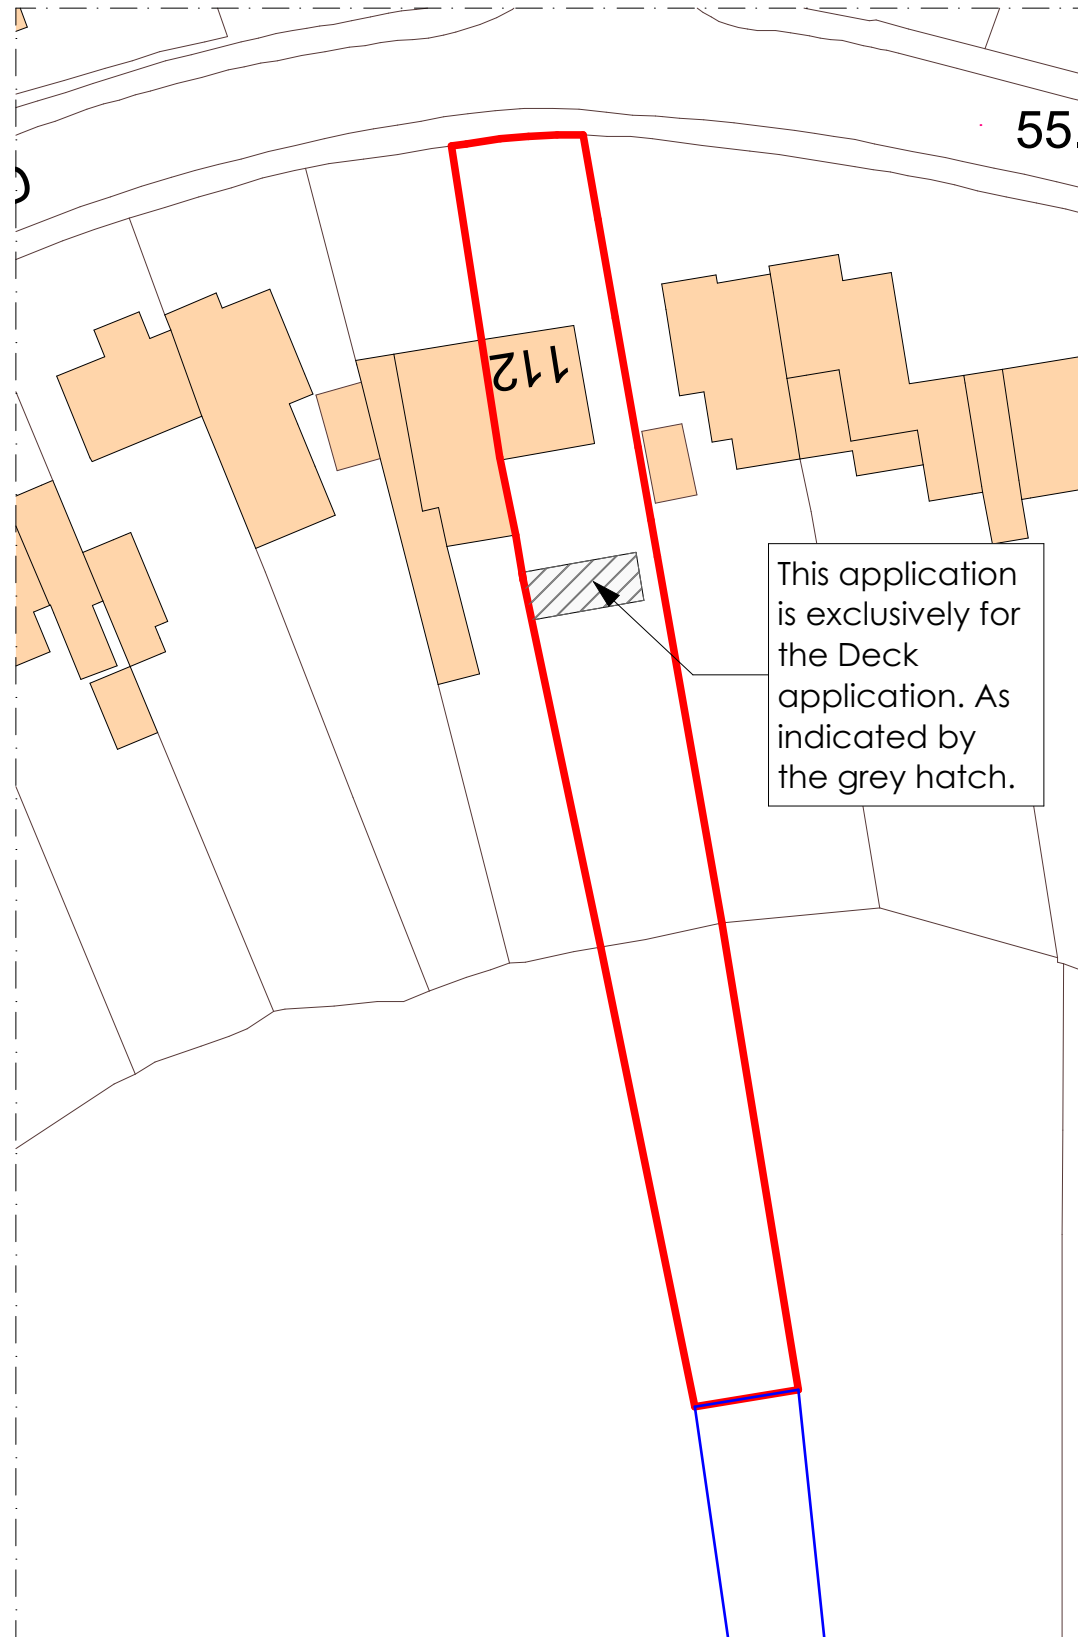

1:500

Proposed Block PLAN


This application is exclusively for the Deck application. As indicated by the grey hatch.

© This drawing remains the property of The Keen Partnership and shall not be copied without prior written consent.

All dimensions to be checked on site and any discrepancies to be reported before work commences.

Notes:

| Date | Rev | Comments | By | Chk'd |
|------|-----|----------|----|-------|
|      |     |          |    |       |

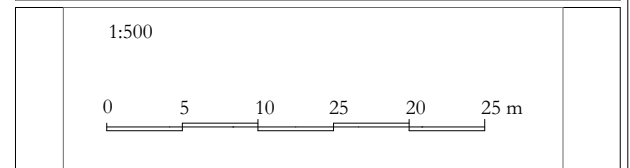

**THE KEEN PARTNERSHIP**

The Courtyard  
Edinburgh Road  
Reading RG30 2UA  
Tel: 0118 9510 855  
Fax: 0118 9510 866  
chris@keenpartnership.co.uk  
www.keenpartnership.co.uk

**cabe**  
chartered association  
of building engineers

**RICS**

Client:

**Mr Zahir Butt**

Job Title:

**112 Silverdale Road, Earley,  
READING, Berkshire, RG6 7LU**

Drawing Title:

**AS BUILT Extension Existing Block  
& Proposed Block Plan REV 07**

|                   |                            |
|-------------------|----------------------------|
| Drawing Date:     | Status:                    |
| -                 | <b>Decking Application</b> |
| Issue Date:       | Drawn By:                  |
| <b>21/06/2024</b> | <b>CM</b>                  |
|                   | Scale:                     |
|                   | <b>@A3</b>                 |

|                                  |               |
|----------------------------------|---------------|
| Drawing No:                      | Rev:          |
| <b>- 9126 - 221380<br/>- 101</b> | <b>REV 07</b> |